

LA-UR-04-6061

Approved for public release;  
distribution is unlimited.

Title: Upgrades to TA-33-87, -88, & -89

Author(s): Garcia, Kari L. M., Ellen D. McGehee, John Ronquillo, and John Isaacson

Submitted to: New Mexico State Historic Preservation Office in Compliance with the National Historic Preservation Act of 1966 (As Amended)



Los Alamos National Laboratory, an affirmative action/equal opportunity employer, is operated by the University of California for the U.S. Department of Energy under contract W-7405-ENG-36. By acceptance of this article, the publisher recognizes that the U.S. Government retains a nonexclusive, royalty-free license to publish or reproduce the published form of this contribution, or to allow others to do so, for U.S. Government purposes. Los Alamos National Laboratory requests that the publisher identify this article as work performed under the auspices of the U.S. Department of Energy. Los Alamos National Laboratory strongly supports academic freedom and a researcher's right to publish; as an institution, however, the Laboratory does not endorse the viewpoint of a publication or guarantee its technical correctness.

Form 836 (8/00)



LA-UR-04-6061

**Upgrades to TA-33-87, -88, and -89**

Historic Building Survey Report No. 230

**Los Alamos National Laboratory**

**August 27, 2004**

**Survey No. 944**

Prepared for the Department of Energy,  
National Nuclear Security Administration,  
Los Alamos Site Office

prepared by

**Kari L. M. Garcia and Ellen D. McGehee**, Heritage Resource Managers,  
LANL Ecology Group (RRES-ECO)  
**John Ronquillo**, Consulting Engineer, Sigma Science, Inc.  
**John Isaacson**, HREPC Team Leader, LANL Ecology Group (RRES-ECO)

RRES-ECO Heritage Resources and Environmental Policy Compliance (HREPC) Team  
Risk Reduction and Environmental Stewardship Division  
LOS ALAMOS NATIONAL LABORATORY

## Introduction

The Department of Energy, National Nuclear Security Administration, Los Alamos Site Office proposes to upgrade a complex of three historic Los Alamos National Laboratory (LANL) properties located on Department of Energy land at Technical Area (TA) 33: buildings TA-33-87, TA-33-88, and TA-33-89.

The following information has been prepared as part of a notification of potential adverse effect to buildings TA-33-87, TA-33-88, and TA-33-89, located at the East Site/Area 1 firing site. The proposed modifications described below are upgrades to Laboratory facilities in support of LANL's ongoing scientific mission. The upgrades will adversely affect the attributes that make this small complex of buildings eligible for the National Register of Historic Places (Register). Work processes carried out at TA-33 supported Cold War weapon component testing activities from 1948 to 1972.

This report contains a description of the proposed action, historical background information, a description of the East Site/Area 1 firing site, property descriptions, building integrity information, and recommendations for Register eligibility. LANL historic building survey forms, photographs, and building drawings are contained in Appendix A.

The State Historic Preservation Officer (SHPO) is requested to concur with the eligibility determinations contained in this report and also to concur that the proposed upgrades will adversely affect buildings TA-33-87, TA-33-88, and TA-33-89.

## Project Description

TA-33-87, TA-33-88, and TA-33-89 are scheduled for upgrades as part of the revitalization of TA-33. Planned interior upgrades include the refurbishment of electrical, plumbing, lighting, and HVAC systems for all three buildings. Although the exterior concrete surfaces of buildings TA-33-87, TA-33-88, and TA-33-89 will be refinished as necessary, the most significant exterior upgrades will involve building TA-33-87 and its immediate vicinity. A steel-frame Butler building will be added to the front of building TA-33-87 for use as an electronics laboratory. A new concrete apron will be added on the east side of the building and concrete retaining walls will be added on the building's north and south sides. Additionally, a concrete transformer pad and a small prefabricated metal storage building will be installed to the north of TA-33-87.

In 2003 and 2004, a historic building survey was conducted by Kari Garcia and Ellen McGehee, Risk Reduction and Environmental Stewardship Division, Ecology Group (RRES-ECO), LANL, and John Ronquillo, consulting engineer, Sigma Science, Inc. The building survey was accomplished by first conducting a field visit to TA-33. LANL historic building survey forms were completed and photographs were taken (Appendix A). Records research at LANL was also carried out, and existing drawings were compiled for the buildings (Appendix A).

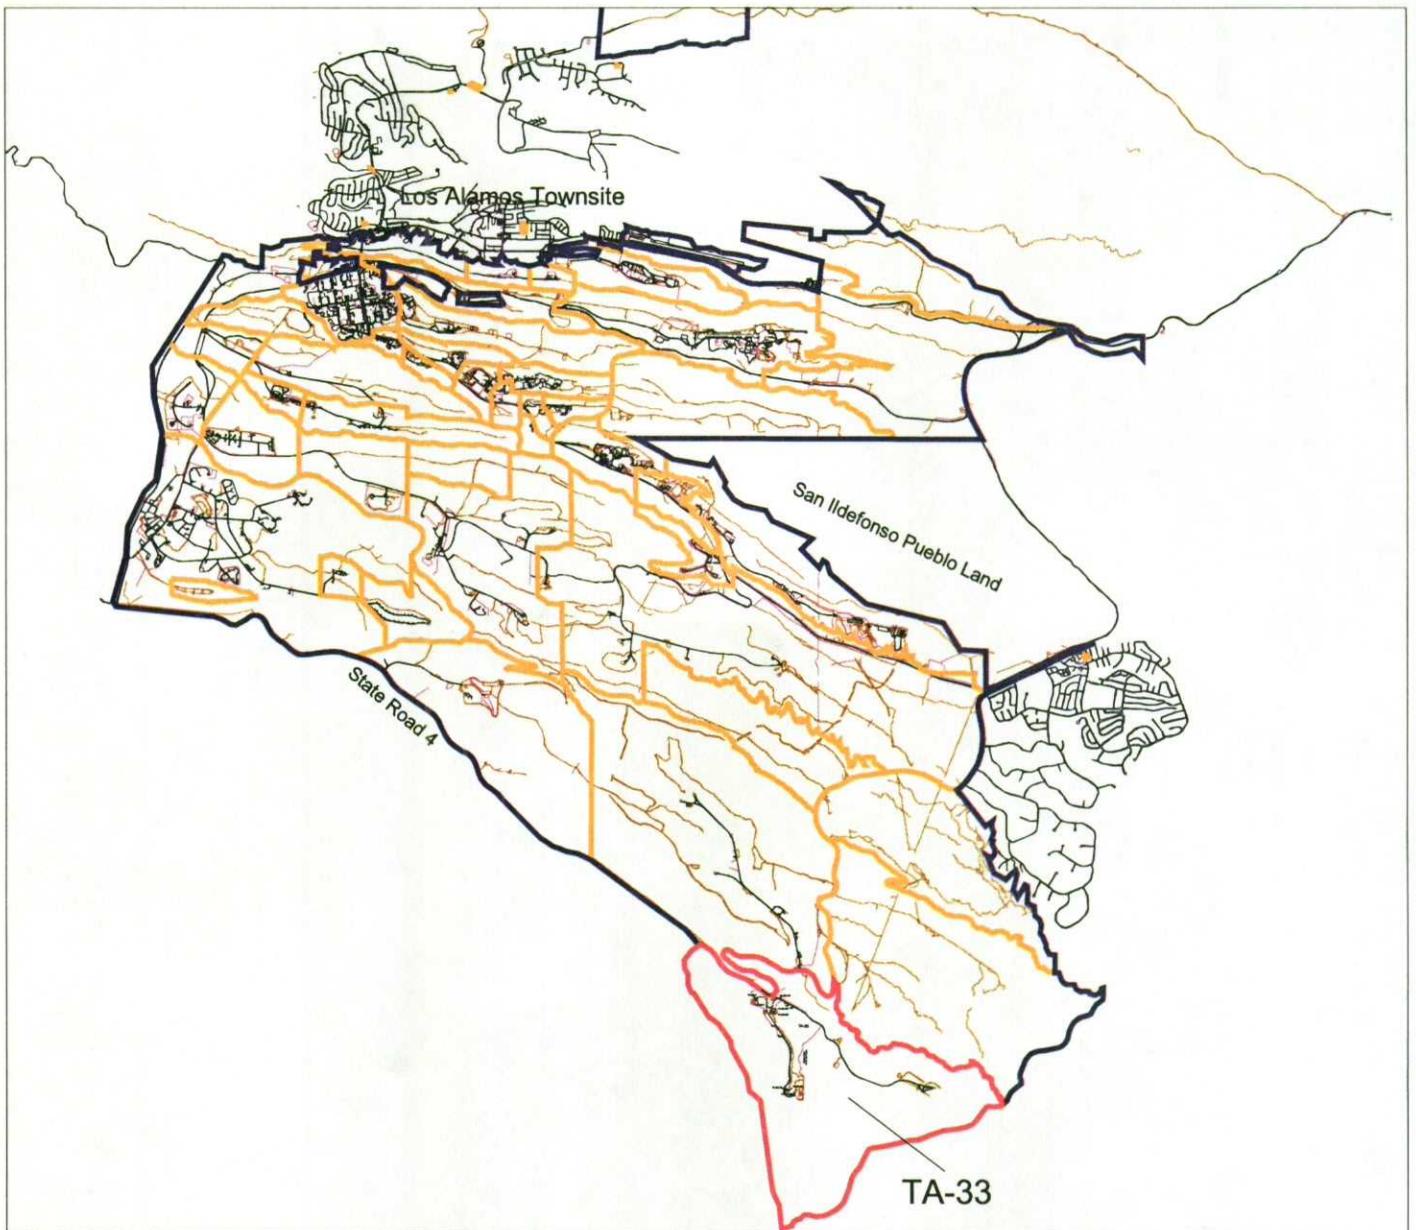


Fig. 1. Technical Area (TA) 33, Hot Point (HP) Site

### Historical Background

TA-33 is an isolated technical area located in the southeastern corner of the Laboratory. Situated near Bandelier National Monument, this technical area was historically known as Hot Point (HP) Site (Map 1).

TA-33 was established in 1947 and has functioned primarily as a test site for weapons components called initiators. Nuclear weapons rely on initiator devices to supply a source of neutrons that will quickly enhance the chain reaction at exactly the right moment. Over the years, weapon component tests have been conducted at various locations within TA-33 and have included underground and surface experiments, many using large guns that fire experimental projectiles into bermed areas. Firing tests were discontinued at TA-33 in 1972. Other significant facilities at TA-33 include a high-pressure tritium facility, which was operated at TA-33 from the mid 1950s until late 1990, and an antenna of the National Radio Astronomy Observatory Very Long Baseline Array radiotelescope, which was sited at TA-33 in 1985 and is still in operation (Los Alamos National Laboratory 1992). TA-33 includes five main sites: East Site/Area 1 (the eastern firing site), Area 6 (the western firing site), South Site (the southern firing site), Main Site (the central administrative area), and the NRAO Site (the radiotelescope site) (Maps 2 and 3).



# Los Alamos National Laboratory

*Heritage Resources and  
Environmental Policy Compliance Team  
RRES-ECO Ecology Group*

1:110000

7000 0 7000 14000 Feet




2000 0 2000 4000 Meters



TA-33



- Tech Area 33
- LANL Boundary
- LANL Technical Areas
- Roads
- Road dirt
- Park pave
- Park dirt
- Fences

Map 1

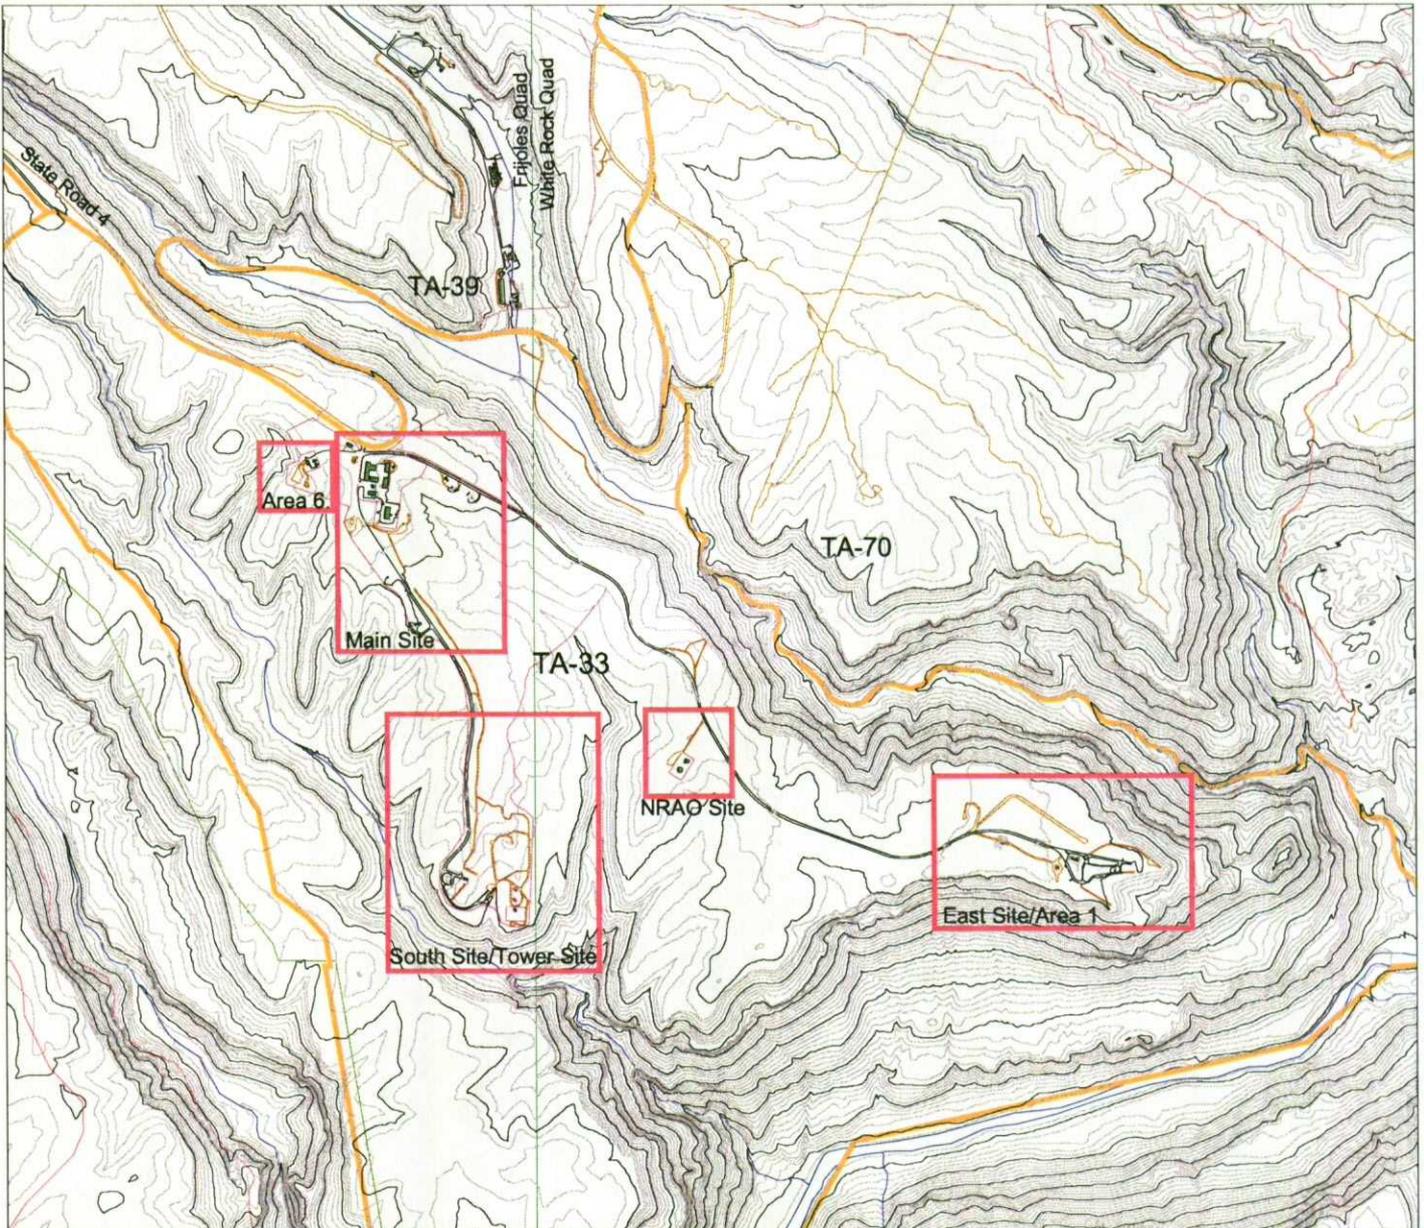

**Los Alamos  
National Laboratory**  
Heritage Resources and  
Environmental Policy Compliance Team  
RRES-ECO Ecology Group


1:24000

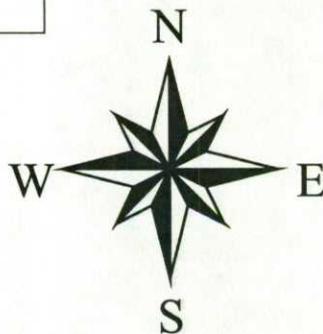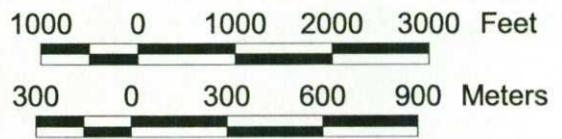

**TA-33  
Site Areas**

- 20 Foot Contours
- 100 Foot Contours
- Techarea
- Drainage
- Township, Section, Range
- USGS 7.5 Minute Quad
- Trails
- Road/dirt
- Park/pave
- Park/dirt
- Fences
- Buildings/Structures

Map 2

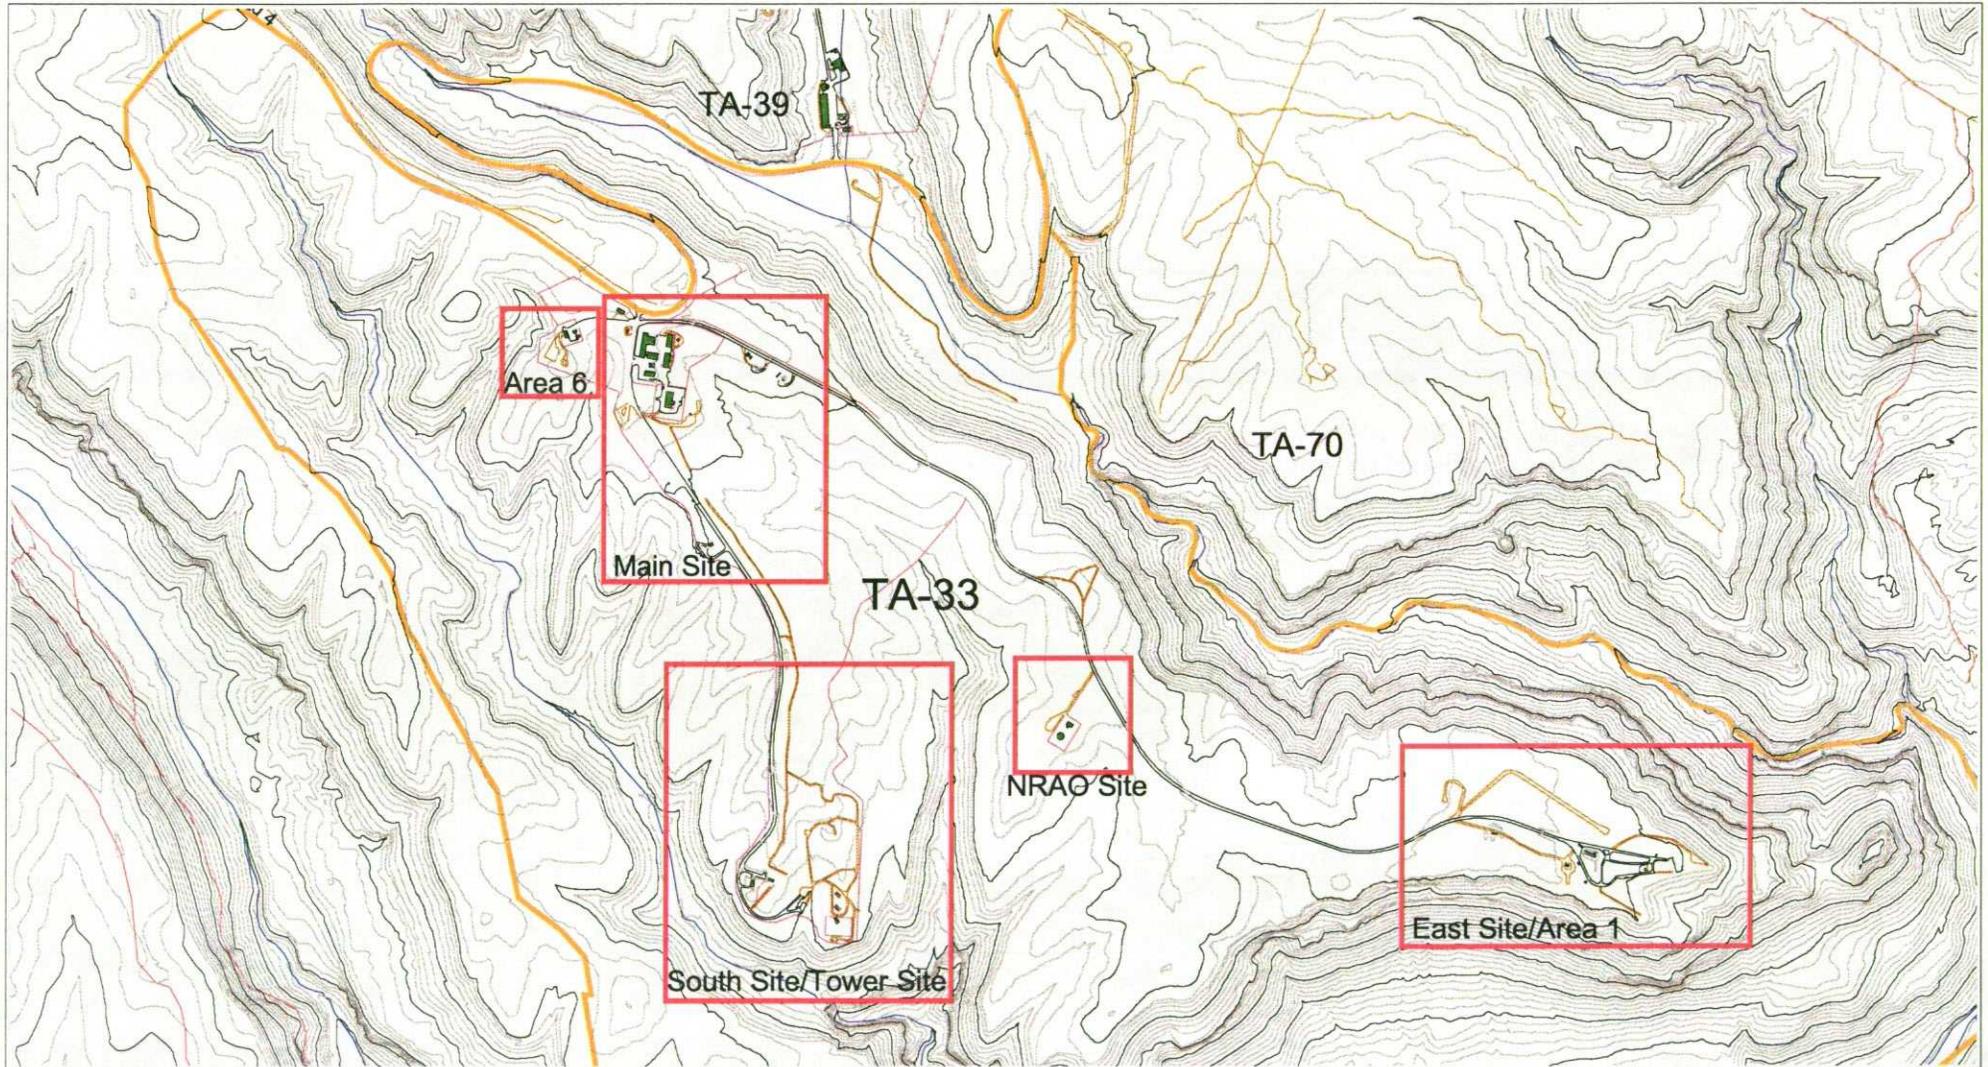

**Los Alamos  
National Laboratory**  
Heritage Resources and  
Environmental Policy Compliance Team  
RRES-ECO (Ecology Group)

**TA-33  
Site Areas**



Map 3

- 20 Foot Contours
- 100 Foot Contours
- Techarea
- Drainage
- Trails
- Roads
- Roaddirt
- Parkpave
- Parkdirt
- Fences
- Buildings/Structures

1:18000

600 0 600 1200 1800 2400 Feet

200 0 200 400 600 Meters



Figure 2. Area 6

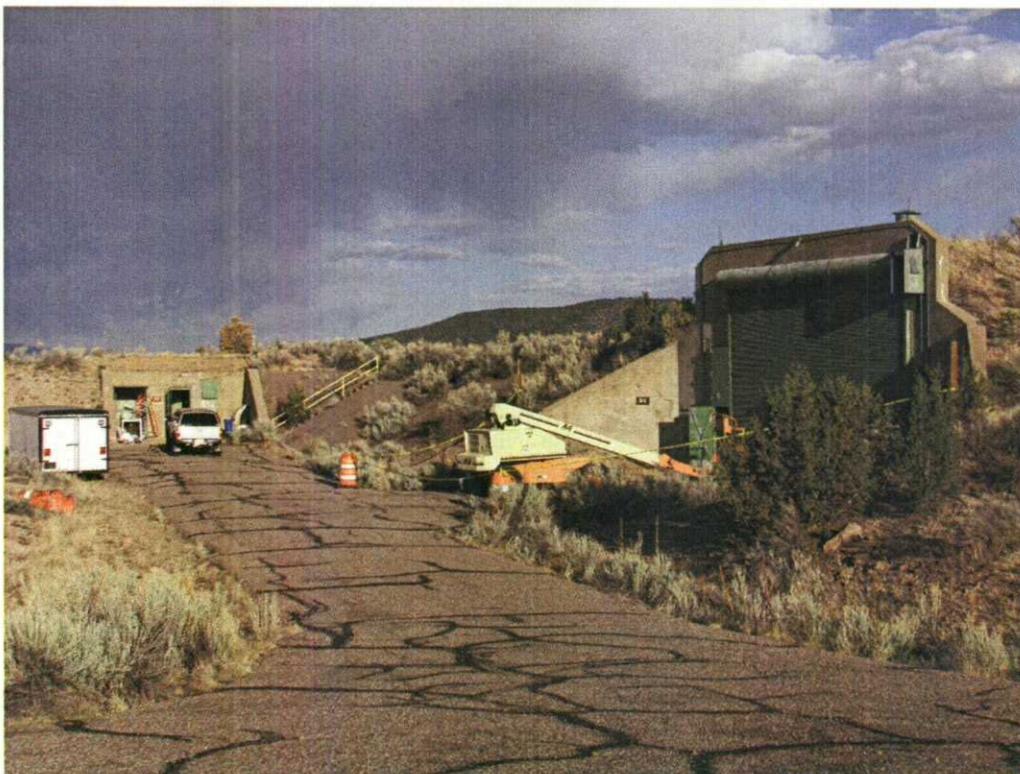


Fig. 3. South Site

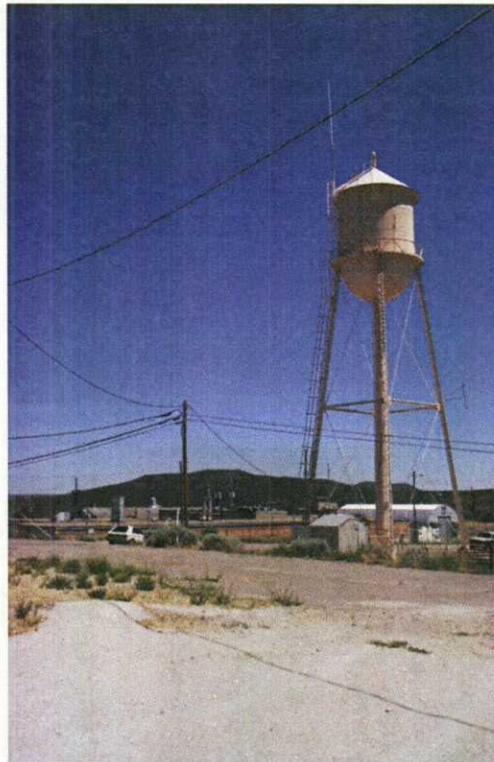


Fig. 4. Main Site

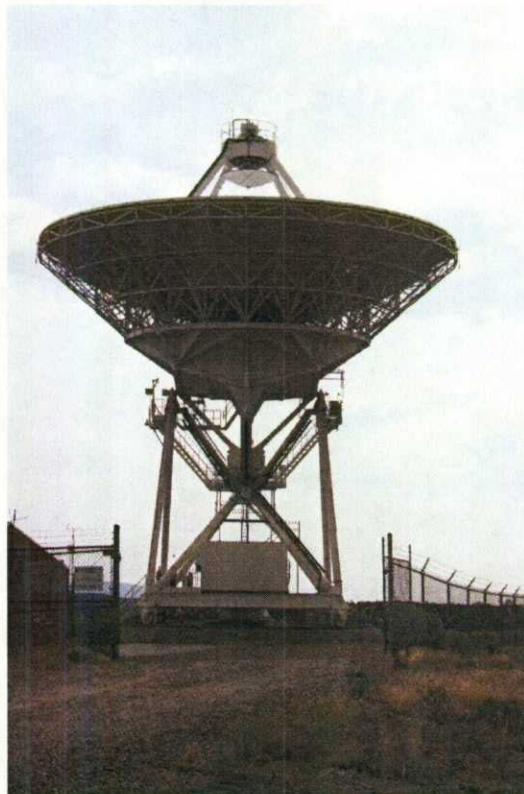


Fig. 5. NRAO Site

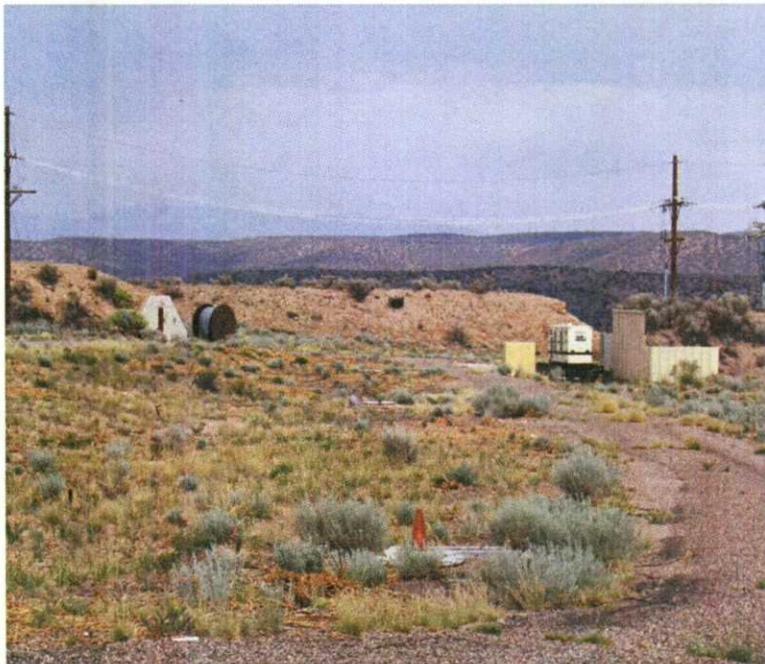


Fig. 6. East Site (looking east toward TA-33-88)

### East Site/Area 1

East Site (formerly known as Area 1) is a firing site located at the easternmost point of a mesa overlooking the Rio Grande (Los Alamos National Laboratory 1992). After the end of WWII, two bomb designs were being developed for use in the United States stockpile: a plutonium “implosion” device and a uranium “gun-type” device. The implosion design used shaped high explosives to compress a subcritical mass of plutonium-239 and cause a critical reaction (Los Alamos National Laboratory 1995). “Area 1” was developed in the late 1940s as a test site for underground tests on implosion-type initiators.

#### Area 1 (1948-1955)

Underground test chamber work was carried out at Area 1 in 1948 after post-war initiator tests at Trinity Site in southern New Mexico were discontinued. The underground tests were one-time events, and a new pit facility was dug for each test. Typically, an octagonal pit structure and its associated entrance shaft were constructed underground. Neutron counters and the initiator experimental apparatus were placed in the reinforced concrete pit or “chamber,” and electronic cables were routed from the pit structure to a distant control room. A portable elevator building was placed over the shaft until just before the test was conducted. Instrumentation in the control room received the completed test data via electronic cables (Los Alamos National Laboratory Archives; U.S. Department of Energy 1986).

The construction of Chamber #1 was completed January 21, 1948, and tested April 14, 1948. Another underground chamber (Chamber #2) was completed October 8, 1948, and tested in December of the same year. Both underground test chambers were located approximately 30 ft below grade and had 4 ft by 6 ft elevator shafts. Chamber 2, larger in size and situated deeper

than the first test chamber, was not completely destroyed as a result of the 1948 experiment. The damaged chamber was retested and ultimately destroyed in 1952 as part of a high-explosives experiment. Mothballed after the end of underground chamber testing, Area 1 was reactivated for the testing of gun-type initiators in 1955 (Los Alamos National Laboratory 1992; Los Alamos National Laboratory Archives; U.S. Department of Energy 1986).

#### East Site (1955 to 1972)


Beginning in 1955, the new “East Site” (formerly Area 1) grew to include a number of firing areas used for a variety of experiments relating to gun-type weapons. In one series of experiments, neutrons were measured in a large, doughnut-shaped, liquid scintillation counter. In another series, projectiles were X-rayed as they were shot past a recording setup. Uranium projectiles containing beryllium and polonium-210 or cobalt-60 were used in gun tests. The projectiles were not detonated: some were shot into berms and others were shot into catcher boxes for recovery and later sectioning (Los Alamos National Laboratory 1992; U.S. Department of Energy 1986).

#### Facilities at East Site

The first permanent buildings at East Site were completed by June of 1955. Other East Site facilities included two adjacent crescent-shaped berms, each 10 ft high and 200 ft across the face, with concrete shot pads located in the center of each crescent. Reinforced concrete gun mounts were located at the west end of the firing area. An X-ray shack, building TA-33-151, was located near the two shot pads (Los Alamos National Laboratory 1992; Hoard 1991) (Map 4).

TA-33-87 was completed in 1955 to support shot testing at East Site. The building was primarily used as a control room and had a darkroom for film processing (Ahlquist 1983; Los Alamos National Laboratory 1992). TA-33-89, “the X-unit vault,” was built as a storage building for X-units used to set off the test shots at East Site (an X-unit is an electronic firing unit used to fire detonators) (U.S. Department of Energy 1986).

A cable tunnel connected the control room (TA-33-87) to an instrumentation building located further to the east (TA-33-88). Cabling also extended to the X-unit vault (TA-33-89) and to the X-ray shack discussed above. The cables were housed in a 36-inch diameter corrugated metal pipe running along the length of the 6 ft 10 in high tunnel. The cable tunnel was designed to be accessed through a series of manholes (Fig. 7). According to a former site worker, the tunnel is big enough to walk through (Hoard 1991).

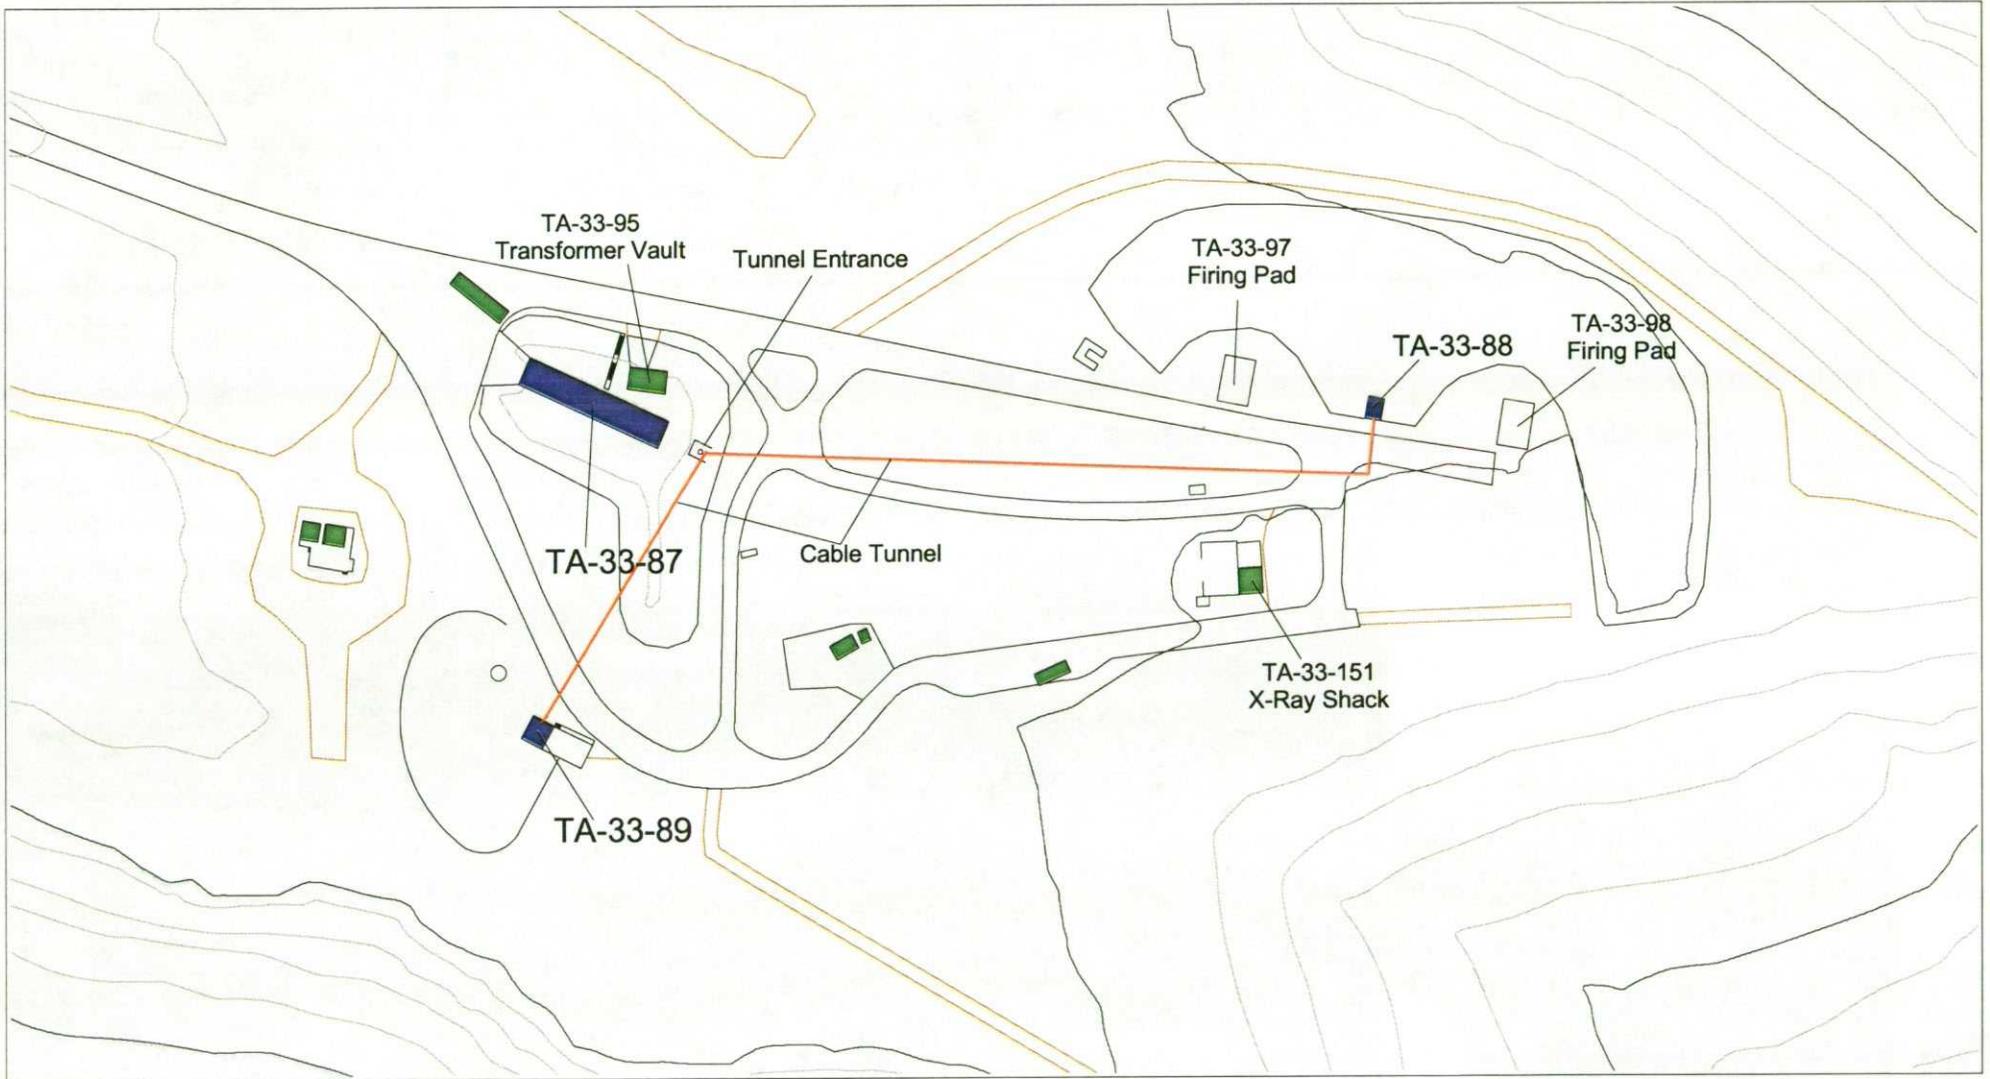


**Los Alamos National Laboratory**  
 Heritage Resources and Environmental Policy Compliance Team  
 RRES-ECO (Ecology Group)

**TA-33  
 East Site/Area 1  
 Buildings 87, 88, and 89**



- Cable Tunnel
- Buildings/Structures
- 20 Foot Contours
- 100 Foot Contours
- Techarea
- Drainage
- Township, Section, Range
- USGS 7.5 Minute Quad
- Trails
- Roads
- Roaddirt
- Parkpave
- Parkdirt
- Fences

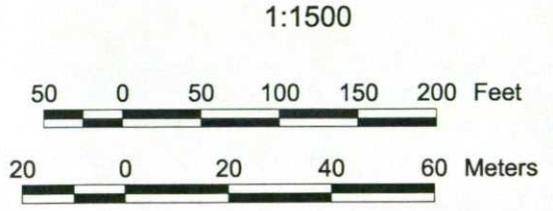

Map 4

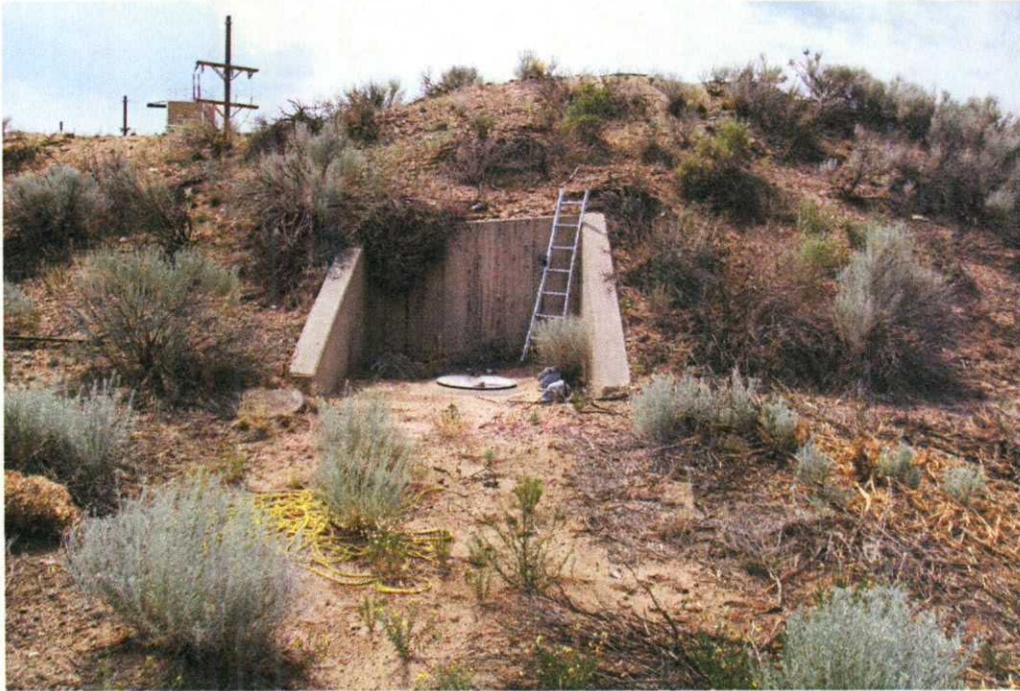


Fig. 7. Cable Tunnel Entrance with Manhole, Near TA-33-87

A berm-covered transformer vault, TA-33-95, is also located at East Site. The vault was constructed to withstand explosive blast effects in order to protect the power transformer (LANL 1992).



Fig. 8. Transformer Vault, TA-33-95

## Property Descriptions

(Complete architectural descriptions are contained in the historic building survey forms located in Appendix A.)

### Building Identification and Numbering

The buildings discussed in this report are identified using the current LANL system of placing the TA prefix before each building number. Historically, however, the “HP” prefix (for Hot Point Site) was used before each building number and some of the drawings included in this report may use the old system of building identification. For example, TA-33-87 is the same building as HP-87.

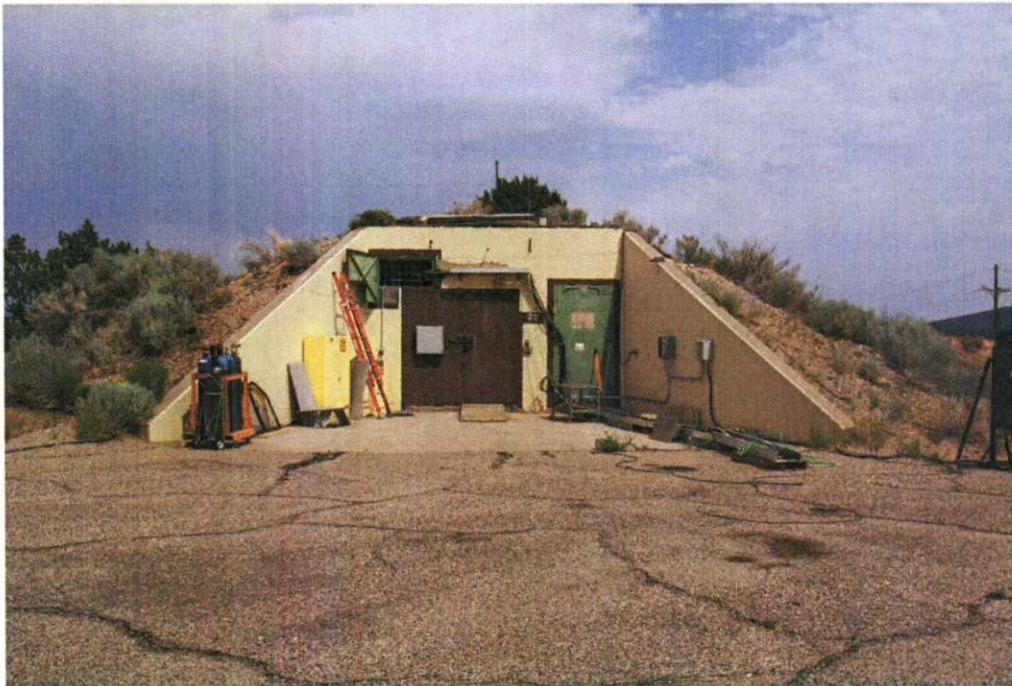


Fig. 9. TA-33-87

### TA-33-87 (HP-87), Control Building

TA-33-87 is a one-story rectangular building measuring 92 ft 5 in by 21 ft. The building contains 1584 ft<sup>2</sup> of useable floor space and is approximately 15 ft in height. The interior of the building is divided into five rooms: one large main “control” room, and four small rooms including a bathroom, darkroom, and two utility rooms. The floors in the main room have built-in trenches for running electrical cables.

Building 87 is constructed with a reinforced concrete foundation and floor slab and has reinforced concrete walls and a flat roof. The west concrete headwall is constructed with angled wing walls that serve as a retaining system for the compacted earthen berm covering the remaining three sides and roof. This western elevation, the only exposed exterior wall, has a painted concrete finish. A pair of heavy-duty metal doors, a single heavy-duty metal door, and a grated ventilation duct are set within the headwall on this elevation, and provide the only access

into the building. The pair of doors seen today replaced a single reinforced metal strap hinged door sometime after 1984. A building identification sign and electrical conduit and control boxes are located on the exterior surface of the wing walls.

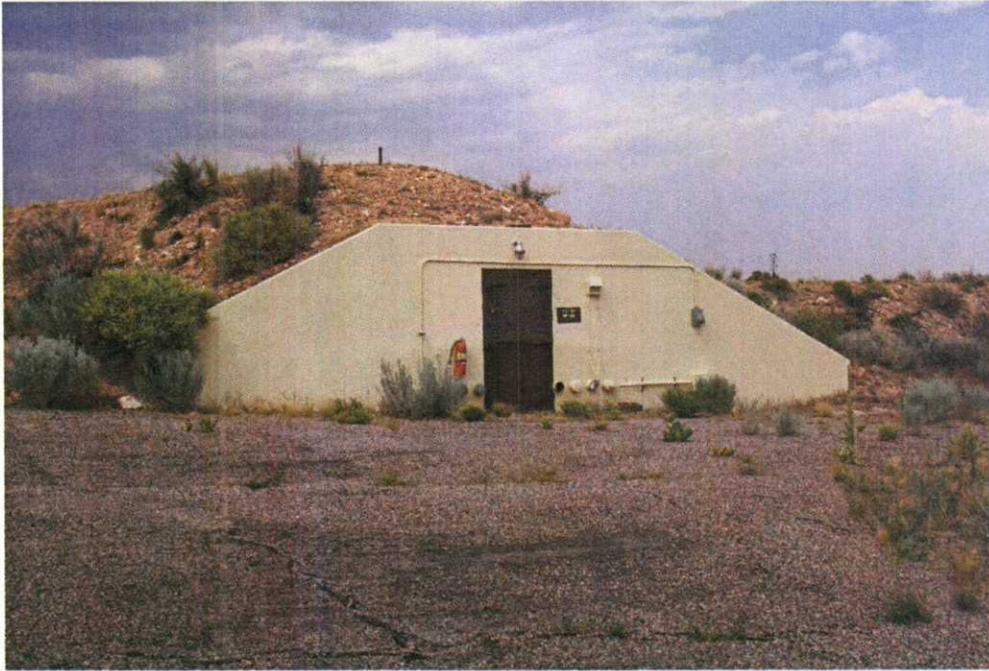


Fig. 10. TA-33-88

#### TA-33-88 (HP-88), Cable or Instrumentation Building

TA-33-88 is a one-story single room building measuring 17 ft 8 in by 14 ft with 192 ft<sup>2</sup> of useable floor space and an 8 ft interior ceiling height. The building is constructed with a reinforced concrete foundation and floor slab. It has reinforced concrete walls and a flat roof. The south exposed concrete headwall is constructed with wing walls that serve as a retaining system for the compacted earthen berm covering the remaining three sides and roof. This exposed wall has a painted concrete finish. A single reinforced metal door is set within the headwall, providing the only access into the building.

A fire extinguisher, security light, electrical conduit and control box, capped pipe sleeve openings, and building identification sign are located on the exterior face of the building.



Fig. 11. TA-33-89

#### TA-33-89 (HP-89), X-Unit Vault

TA-33-89 is a one-story single room building measuring 13 ft by 16 ft (excluding the protruding wing walls). The interior measures 70 ft<sup>2</sup> with an approximate 7 ft interior ceiling height. The structure is constructed with a reinforced concrete foundation and floor slab and has reinforced concrete walls and a flat roof. The east exposed concrete headwall is constructed with wing walls that are continuations of the sidewalls of the structure. These wing walls serve as a retaining system for the compacted earthen berm covering the remaining three sides and roof. This exposed portion of the building is unpainted concrete.

A single reinforced metal door with heavy-duty strap hinges and a steel lever door handle is set within the headwall and provides the only access into the building. There is a concrete ramp leading down from the surrounding ground surface to the building entry level. Additionally, there is a set of metal stairs and landing leading down from the surrounding ground surface to the building entry level along the north sidewall.

A fire extinguisher, security light, building identification sign, and metal safety-railing are located on the exterior face of the building and wing walls. A metal pipe sleeve with elbow and cap is also extruding from the roof of the building.

#### Integrity Issues

##### Integrity

The LANL Heritage Resources and Environmental Policy Compliance Team has developed four integrity codes to assess potentially eligible properties. The integrity requirements for properties eligible under Criterion A are less stringent than for those properties eligible under Criterion C.

A historically significant property with a level 3 integrity could still be eligible, especially if an element of historical uniqueness is involved. Properties eligible under Criterion C should have no lower than a level 2 integrity. Level 4 integrity properties are not eligible for the Register.

1. Excellent Integrity - the property is still closely associated with its primary context and retains integrity of location, design, setting, workmanship, materials, feeling, and association. Little or no remodeling has occurred to the property and all remodeling is in keeping with its associated historic context/significant use period.
2. Good Integrity - the property's interior and exterior retain historic feeling and character but some of the original significant equipment may be gone. The property may have had minor remodeling.
3. Fair Integrity - a property in this category should retain original location, setting, association, and exterior design. All associated interior machinery/equipment may be absent but the essential question is "Is this property still recognizable to a contemporary of the building's historic period?"
4. Poor Integrity - the property has no connection with the historically significant setting, feeling, and context. Major changes to the property have occurred. The property would be unrecognizable to a contemporary.

It appears that all of the original equipment has been removed from the three buildings discussed in this report. Other than this loss of interior integrity, the buildings have not been significantly modified since their period of significance. TA-33-87, TA-33-88, and TA-33-89 are all in good physical condition with some deterioration due to the passage of time and lack of upkeep. The buildings would be immediately recognizable to someone who worked at TA-33 between 1955 and 1972. For these reasons, the three buildings have level 3 integrity.

### **National Register Eligibility Recommendations**

Based on the information gathered during this building survey, TA-33-87, TA-33-88, and TA-33-89 are eligible for nomination to the National Register of Historic Places under Criterion A. The activities conducted in these buildings directly contributed to Cold War weapons research and development at Los Alamos. Specifically, all three buildings supported the initiator testing program at TA-33. Although these three buildings do not possess a high level of interior integrity, they still maintain significant exterior integrity. TA-33-87, TA-33-88, and TA-33-89 retain the key elements of original location, setting, association, feeling, and design.

The SHPO is requested to concur with the eligibility determinations contained in this report and to concur that the proposed upgrades to TA-33-87, TA-33-88, and TA-33-89 will adversely affect this small complex of historic buildings. As a result of this historic building survey, this project complies with the National Historic Preservation Act of 1966 (as amended).

## References Cited

Ahlquist, A. J.

- 1983 "Conversations with Harlow Russ Regarding TA-33, 10/27/83," LANL Memorandum HSE-8/83-733 to HSE-8 file from A. J. Ahlquist (HSE-8), Los Alamos, New Mexico.

Hoard, Dorothy

- 1991 "Conversations with Harlow Russ, December 14, 1990," LANL Memorandum CLS-1/91-304-DH to CLS-1 file from D. Hoard (CLS-1), Los Alamos, New Mexico.

Los Alamos National Laboratory

- 1992 *RFI Work Plan for Operable Unit 1122: Environmental Restoration Program*, LA-UR-92925, Los Alamos National Laboratory, Los Alamos, New Mexico.
- 1995 *Dateline: Los Alamos, Special Issue, LALP-95-2-6&7*. Los Alamos National Laboratory, Los Alamos, New Mexico.

Los Alamos National Laboratory Archives

Information acquired from the LANL Archives, TA-21-1001, Roger Meade, LANL Archivist. Files accessed include "Group M-3 and Group W-3 Monthly Progress Reports" and other general LANL organizational chart information on file at the archives.

U.S. Department of Energy

- 1986 *Phase 1: Installation Assessment, Los Alamos National Laboratory, Comprehensive Environmental Assessment and Response Program [CEARP] (Working Draft)*. Albuquerque Operations Office, Albuquerque, New Mexico. On file at RRES-ECO, Los Alamos National Laboratory, Los Alamos, New Mexico.

**Appendix A**  
**LANL Historic Building Survey Forms, Photographs, and Drawings**

LANL TA- Building # 33-0087

Camera 984244

Frame #s DCP\_1708, 1709, 1716,

Surveyor(s) K. Garcia, J. Ronquillo

Date 07/14/2003

Los Alamos National Laboratory CRMT Historic Building Survey Form

Building Name Control Building UTM's easting 388699 northing 3959221 zone 13

Legal Description: Map White Rock Quad 1984 tns range sec

Current Use/ Function Storage Original Use/ Function Control Building

Date (estimated) Date (actual) 1955 Property Type Laboratory/Processing

Type of Construction

Pre-fabricated Metal Steel Frame Wood Frame CMU Reinforced Concrete

Other Type of Construction # of Stories 1

Foundation Reinforced Concrete

Exterior CMU-Exterior Reinforced Concrete-Exterior Steel (galvanized) Steel (corrugated) Wood Siding Asbestos Shingles-Exterior In-Fill Panels Other-Exterior Earthen Berm

Exterior Treatment (painted, stuccoed, etc) Painted concrete

Exterior Features (docks, speakers, lights, signs, etc) Wall mounted electrical conduit and control boxes.

Addition CMU-Addition Reinforced Concrete-Addition Steel (galvanized)- Addition Wood Steel (corrugated)-Addition Asbestos Shingles-Addition Other- Addition

Exterior Treatment-Addition

Exterior Features-Addition

Roof Form Slanted/Shed Gable Other Roof Type Flat with earthen berm.

Degree of Pitch/ Slope Slight

Roof Materials Corrugated Metal Rolled Asphalt Asbestos Shingles 4-Ply Built Up Other Roof Materials Reinforced concrete roof covered with an earthen berm.

Window Type Casement Single Hung Sash Double Hung Sash Fixed Window Other Window Type

# of Each Window Type/ Comments N/A

Glass Type Clear Wire Glass Opaque Painted Glass Glass Block

Light Pattern

Door Type Personnel Door Types Exterior Fire Door Single Double Roll-up Sliding

		Hollow Metal <input checked="" type="checkbox"/>	Solid Wood <input type="checkbox"/>	1/2 Glazed <input type="checkbox"/>	Paneled <input type="checkbox"/>	
		Louvered <input type="checkbox"/>	Painted <input checked="" type="checkbox"/>			
	Interior	Fire Door <input type="checkbox"/>	Single <input checked="" type="checkbox"/>	Double <input type="checkbox"/>	Roll-up <input type="checkbox"/>	Sliding <input type="checkbox"/>
		Hollow Metal <input checked="" type="checkbox"/>	Solid Wood <input type="checkbox"/>	1/2 Glazed <input type="checkbox"/>	Paneled <input type="checkbox"/>	
		Louvered <input type="checkbox"/>	Painted <input type="checkbox"/>			
Equipment Door Types	Exterior	Fire Door <input type="checkbox"/>	Single <input type="checkbox"/>	Double <input type="checkbox"/>	Roll-up <input type="checkbox"/>	Sliding <input type="checkbox"/>
		Hollow Metal <input type="checkbox"/>	Solid Wood <input type="checkbox"/>	1/2 Glazed <input type="checkbox"/>	Paneled <input type="checkbox"/>	
		Louvered <input type="checkbox"/>	Painted <input type="checkbox"/>			
	Interior	Fire Door <input type="checkbox"/>	Single <input type="checkbox"/>	Double <input type="checkbox"/>	Roll-up <input type="checkbox"/>	Sliding <input type="checkbox"/>
		Hollow Metal <input type="checkbox"/>	Solid Metal <input type="checkbox"/>	1/2 Glazed <input type="checkbox"/>	Paneled <input type="checkbox"/>	
		Louvered <input type="checkbox"/>	Painted <input type="checkbox"/>			

# of Each Door Type/Comments:

**Interior Wall** Gypsum Board  Reinforced Concrete- Interior

CMU- Interior  Plywood  Other- Interior

In-Wall Electrical Wiring  On-Wall Electrical Wiring

**Ceiling** Drop Ceiling

Interior Comments (Equipment, etc)

**Degree of Remodeling**

**Condition** Excellent  Good  Fair  Deteriorating  Contaminated  Burned

**Associated Building**

If yes, list building names and #s:

**Integrity**

**Significance**

**Eligible Under Criterion** A  B  C  D  Not Eligible

**DOE Themes**

Nuclear Weapon Components and Assembly  Nuclear Weapon Design and Testing  Nuclear Propulsion

Peaceful Uses: Plowshare, Nuclear Medicine, Nuclear Energy, Nuclear Science  Energy and Environment: Research Design Projects

**LANL Themes**

Weapons Research and Design, Testing, and Stockpile Support  Super Computing

Reactor Technology  Biomedical/Health Physics  Strategic and Supporting Research

Environment/Waste Management  Administration and Social History  Architectural History

**Recommendations/ Additional Comments**

**Architectural Features (elevations)**

West Elevation: Entrance into Control Building. Sometime after 1984 the front entrance was modified. The original single personnel door (a reinforced metal door with heavy duty strap hinges) located in the center of the west elevation, was replaced with a pair of heavy-duty metal doors. When these doors were installed the ventilation duct opening and covering were also modified. North, east, and south elevations are covered by a surrounding earthen berm as is the roof of the building.

A utility tunnel connects buildings TA-33-87, -88, & -89. This 5' X 6'10" tunnel holds a 36" conduit that carries the cables connecting electronic experimental equipment in each of the buildings.

Total sq ft

1584

Architect/ Builder

A/E is Max Flatow - Jason Moore, Builder R.E. McKee

Alterations

**List of Drawings (Cntrl + Enter for para break)**

ENG-C 10509  
TA-33, Bldg 87 (HP-87)  
Recovery Box Installation  
Civil - Plot Plan  
November 9, 1956  
Revised to as built status June 25, 1957

ENG-SK 2306  
Sheet 9 of 18  
TA-33  
Extension of TA-33 Facilities  
Plot Plan - Area B  
March 4, 1953

ENG-C 3305  
Sheet 4 of 66  
TA-33  
Additional Facilities, TA-33  
Profile & Details 36" Conduit  
April 19, 1954

ENG-SK 2307  
Sheet 10 of 18  
TA-33  
Extension of TA-33 Facilities  
Plan & Sections  
Building HP-87  
March 4, 1953

ENG-C 3321  
Sheet 20 of 66  
TA-33, Bldg 87 (Bldg HP-87)  
Additional Facilities  
Structural Plan and Details  
April 19, 1954

ENG-C 3322  
Sheet 21 of 66  
TA-33, Bldg 87 (Bldg HP-87)  
Additional Facilities  
Structural Details  
April 19, 1954

ENG-C 3324  
Sheet 23 of 66  
TA-33, Bldg 87 (Bldg HP-87)  
Additional Facilities  
Floor Plan and Elevation  
April 19, 1954

Continued from previous page

ENG-R 3036


TA-33, Bldg 87 (Bldg HP-87)

Control Building


Floor Plan

March 21, 1963

Revised to status of June 8, 1984


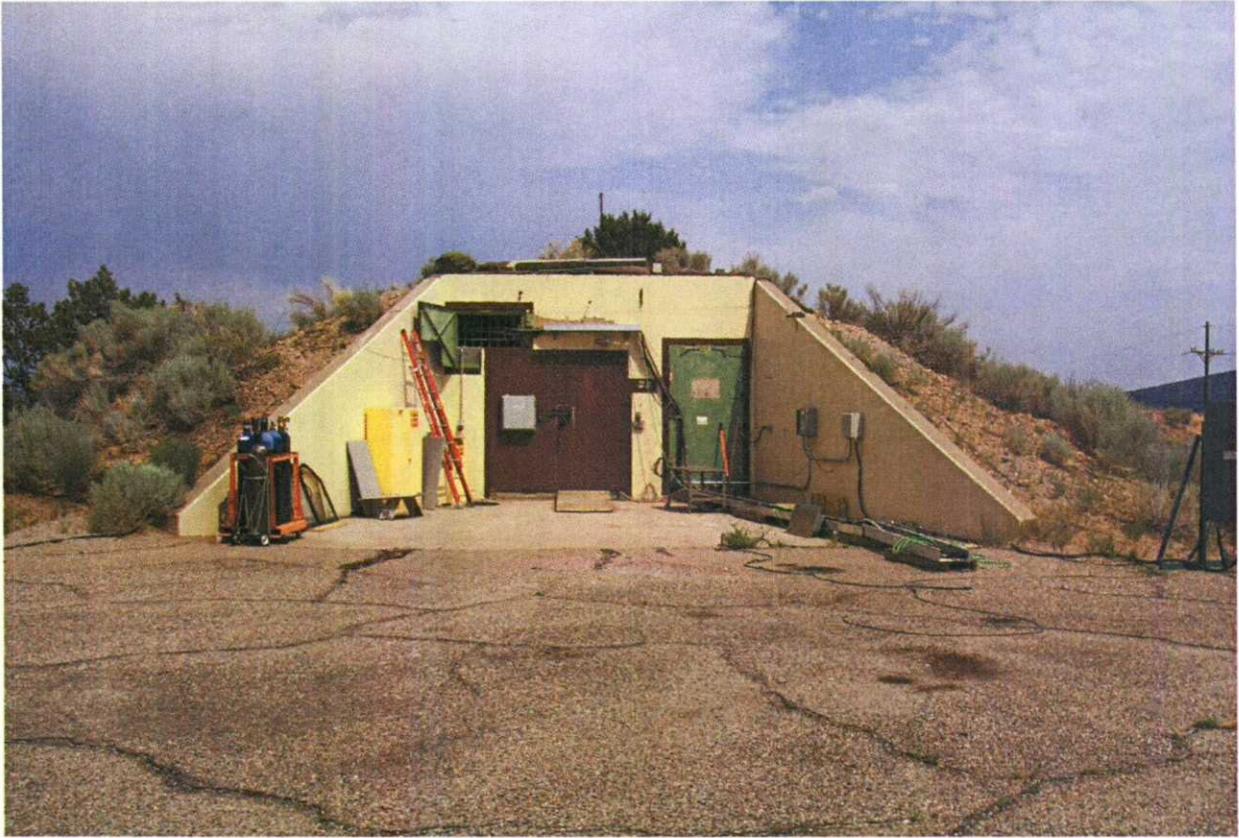


TA-33-87, West side, facing east

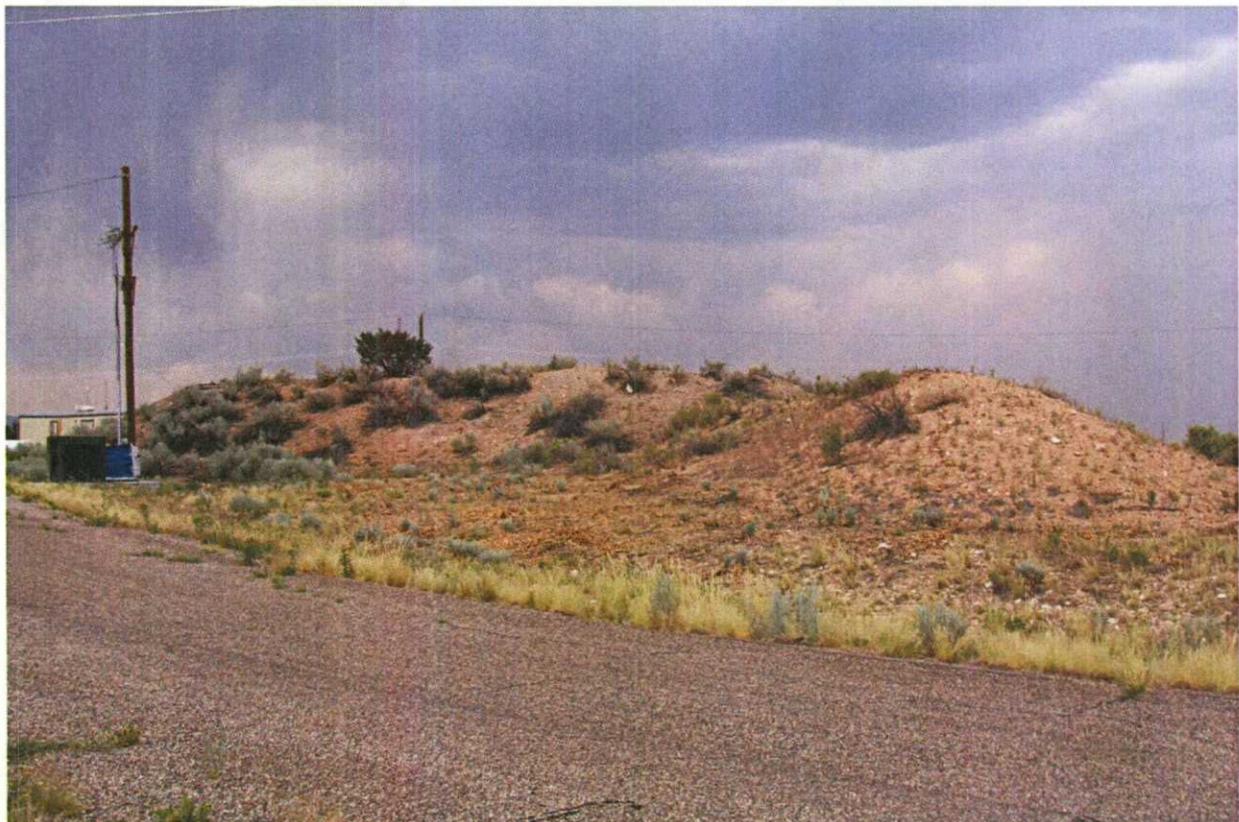

TA-33-87, South side, facing northwest

OFFICIAL USE ONLY

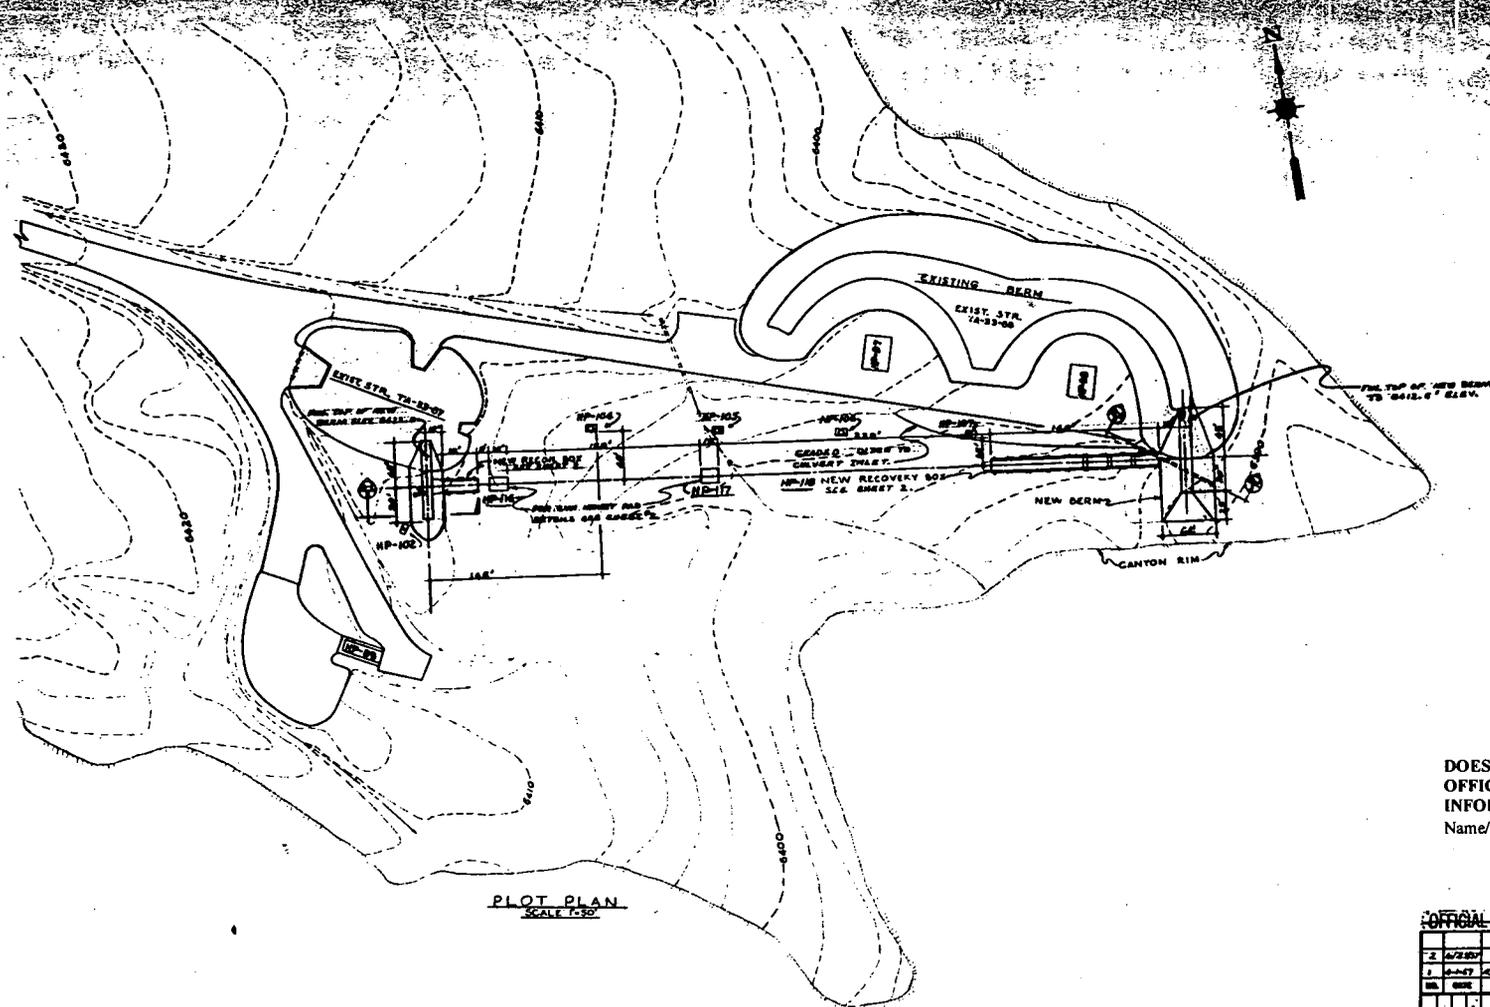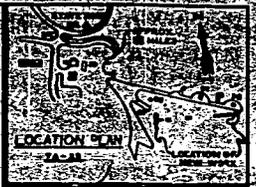


PLOT PLAN  
SCALE 1"=30'

DOES NOT CONTAIN  
OFFICIAL USE ONLY  
INFORMATION  
Name/Org.: Jill Hefele/S-7 Date: 6/23/04

THIS SHEET MUST BE APPROVED  
AND ANY CHANGES APPROVED  
BY THE ENGINEER, PHONE 9-4188

OFFICIAL USE ONLY			
2	REVISED TO AS BUILT STATUS	ZLC	
1	ADD'D STATION MARKS		
NO.	DATE	REVISIONS	BY
LOS ALAMOS SCIENTIFIC LABORATORY ENGINEERING DEPARTMENT UNIVERSITY OF CALIFORNIA - LOS ALAMOS, NEW MEXICO			
RECOVERY BOX INSTALLATION CIVIL - PLOT PLAN			
8196, NP-87		7A-33	
CHECKED	Trank	DATE	11-9-96
DESIGNED	W. M. E.	SCALE	NOTED
ENG-C 10509			


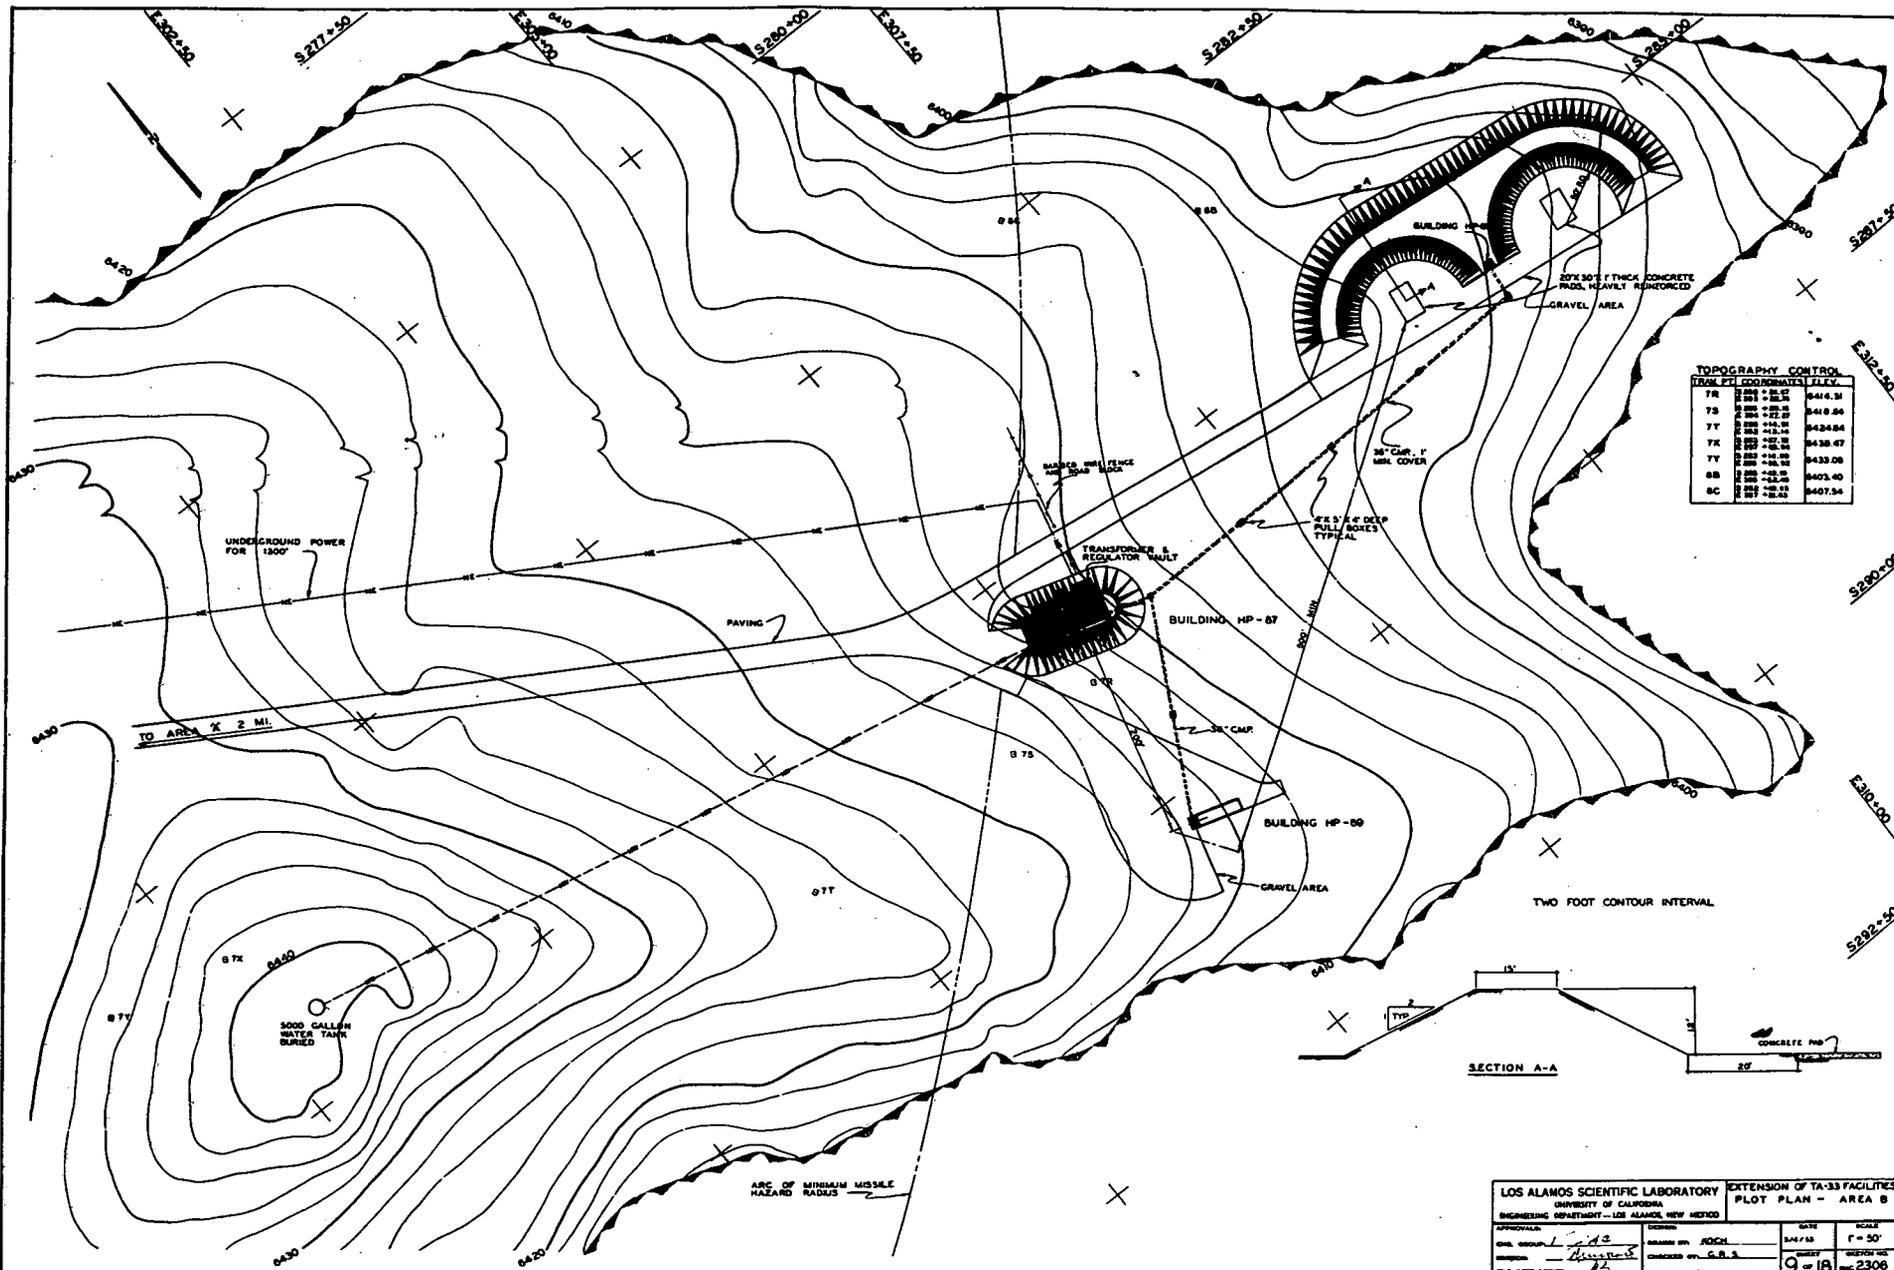






LOS ALAMOS SCIENTIFIC LABORATORY  
UNIVERSITY OF CALIFORNIA  
ENGINEERING DEPARTMENT - LOS ALAMOS, NEW MEXICO

EXTENSION OF TA-33 FACILITIES  
PLOT PLAN - AREA B

APPROVAL: \_\_\_\_\_ DATE: \_\_\_\_\_ SCALE: \_\_\_\_\_  
 DESIGNED BY: ROCHL. DRAWN BY: \_\_\_\_\_  
 CHECKED BY: G.R.A. DATE: 9-18-50  
 ENG. DEPT. OFFICE: \_\_\_\_\_

FIG. NO. 2306

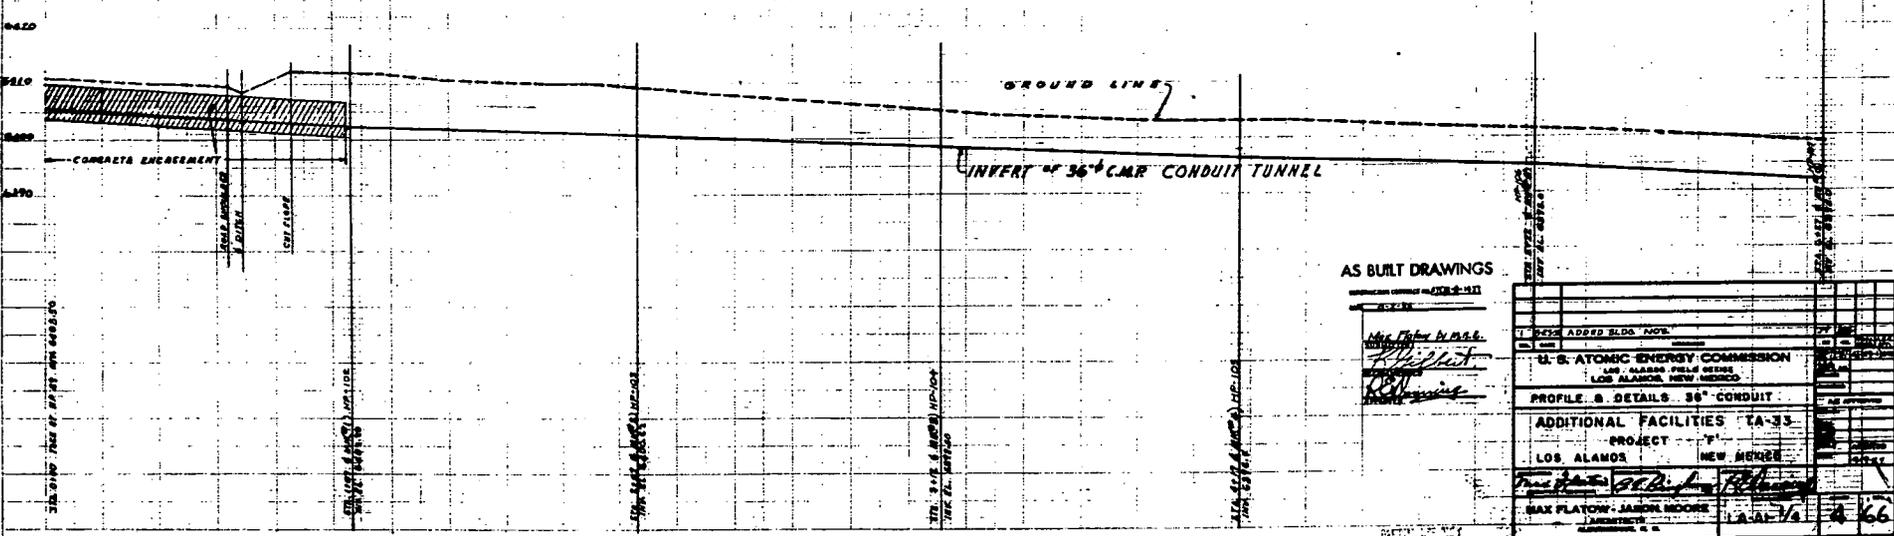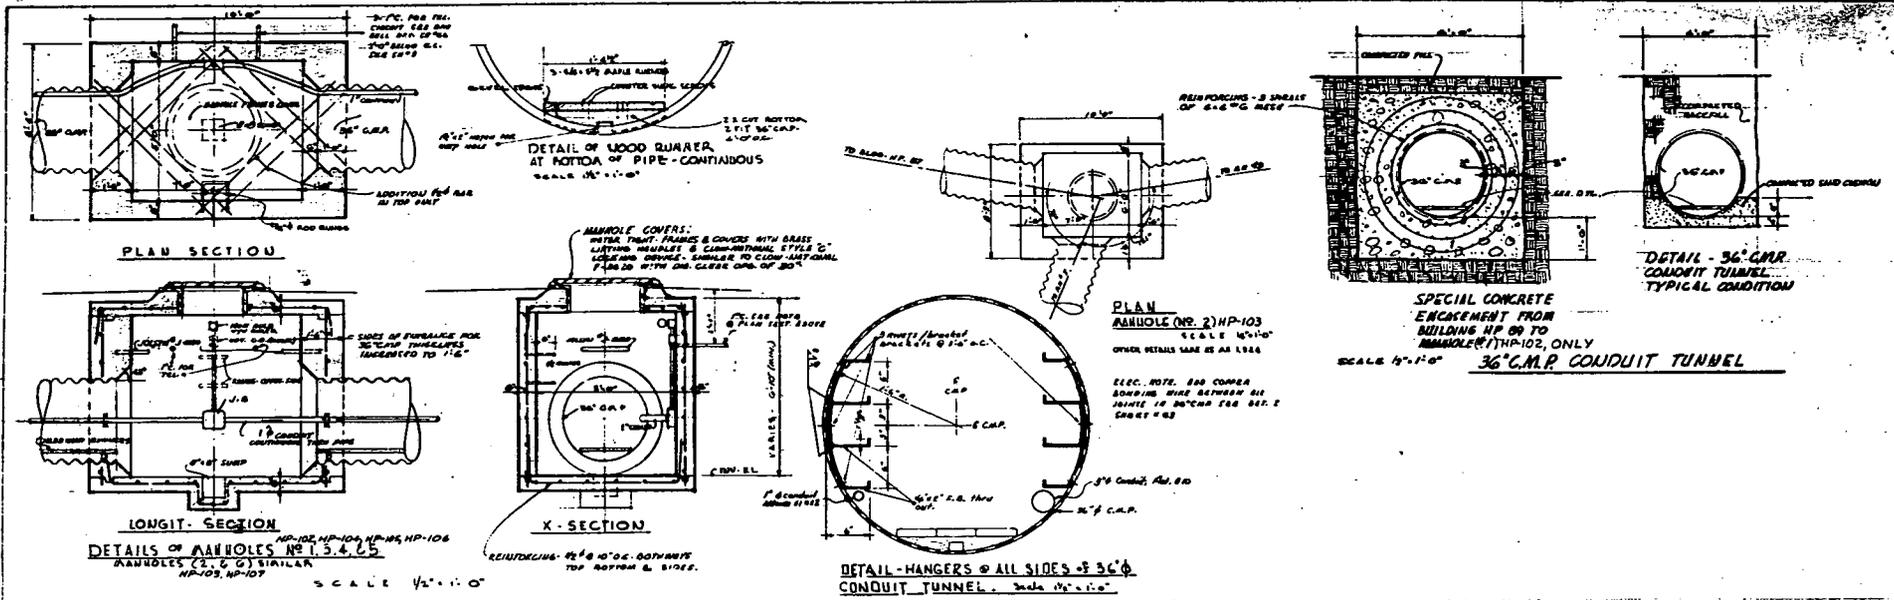

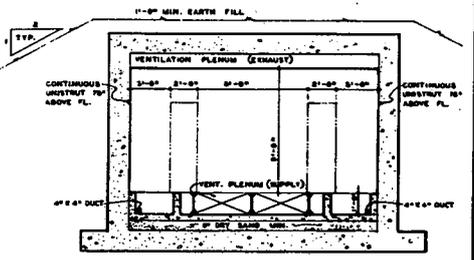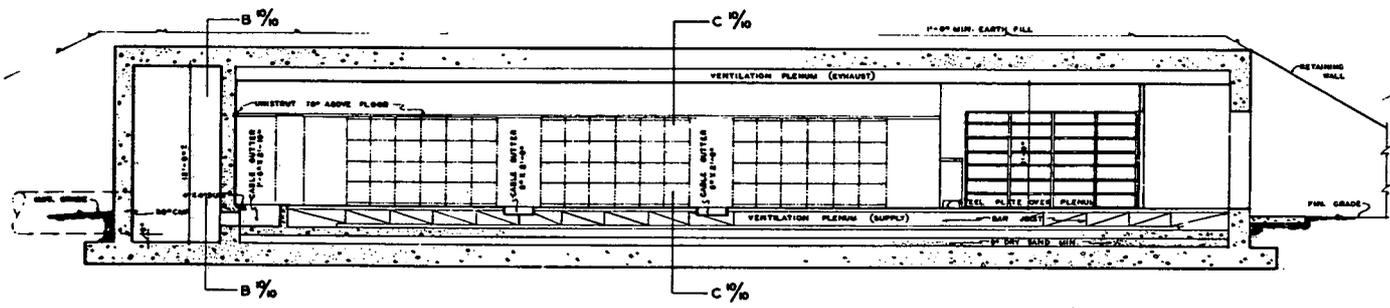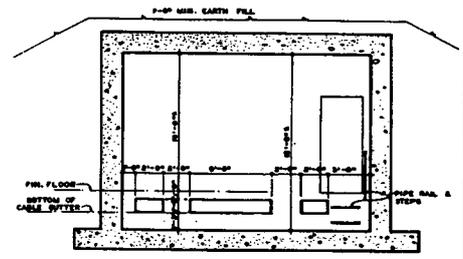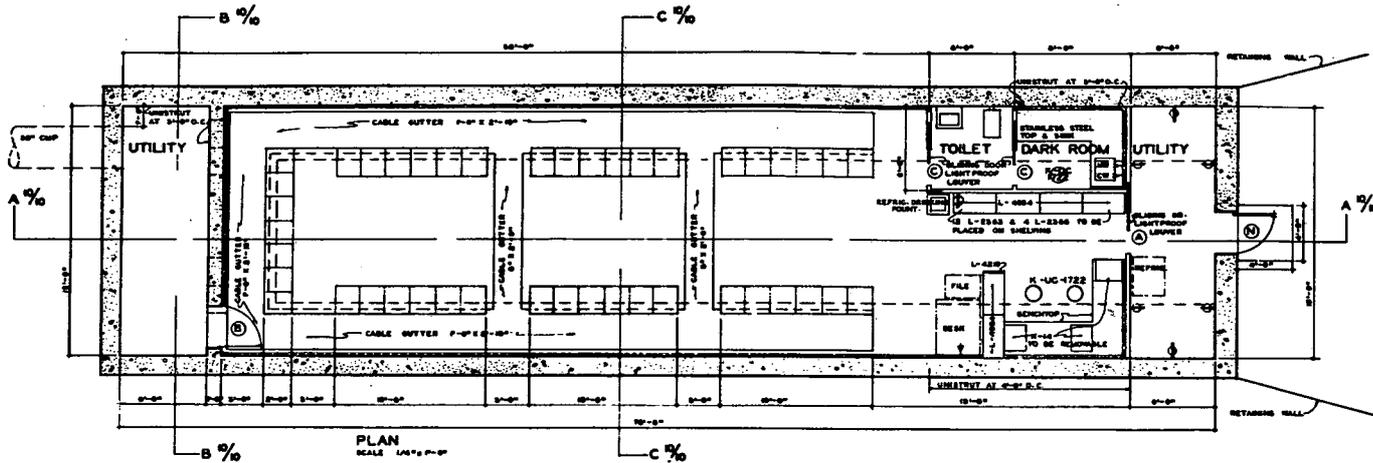


**LEGEND**



- R- INDICATES REMAINE LABORATORY FURNITURE.
- L- INDICATES LEADS METAL PRODUCTS.
- OUTLINES INDICATES EQUIP. NOT FURNISHED IN CONTRACT.
- INDICATES DOOR TYPE (SEE SA. NO. 13)
- STANDARD RECEIPT
- 3/4" NAT'L. ORG. SURFACE DUCT WITH HUBBEL OUTLET NO. 3266 AT 9'-0" CTS. - 45° ABOVE FL. 3/4" NAT'L. ORG. SURFACE TRUSS LOCK RECVY. WITH RECESSES AT 8'-0" C.C.
- COLD WATER
- HOT WATER
- TELEPHONE



LOS ALAMOS SCIENTIFIC LABORATORY		EXTENSION OF TA-35 FACILITIES	
UNIVERSITY OF CALIFORNIA		PLAN & SECTIONS	
ENGINEERING DEPARTMENT - LOS ALAMOS, NEW MEXICO		BUILDING NO. 18-87	
APPROVAL:	DESIGN:	DATE:	SCALE:
DRW. GROUP: <i>[Signature]</i>	DRAWN BY: S.S.B.	5/26/53	1/4" = 1'-0"
ENGINEER:	CHECKED BY: S.C.H.	SHEET:	SECTION NO.
ENCL. ENGR. OFFICE:		10 OF 18	ENC. 2307



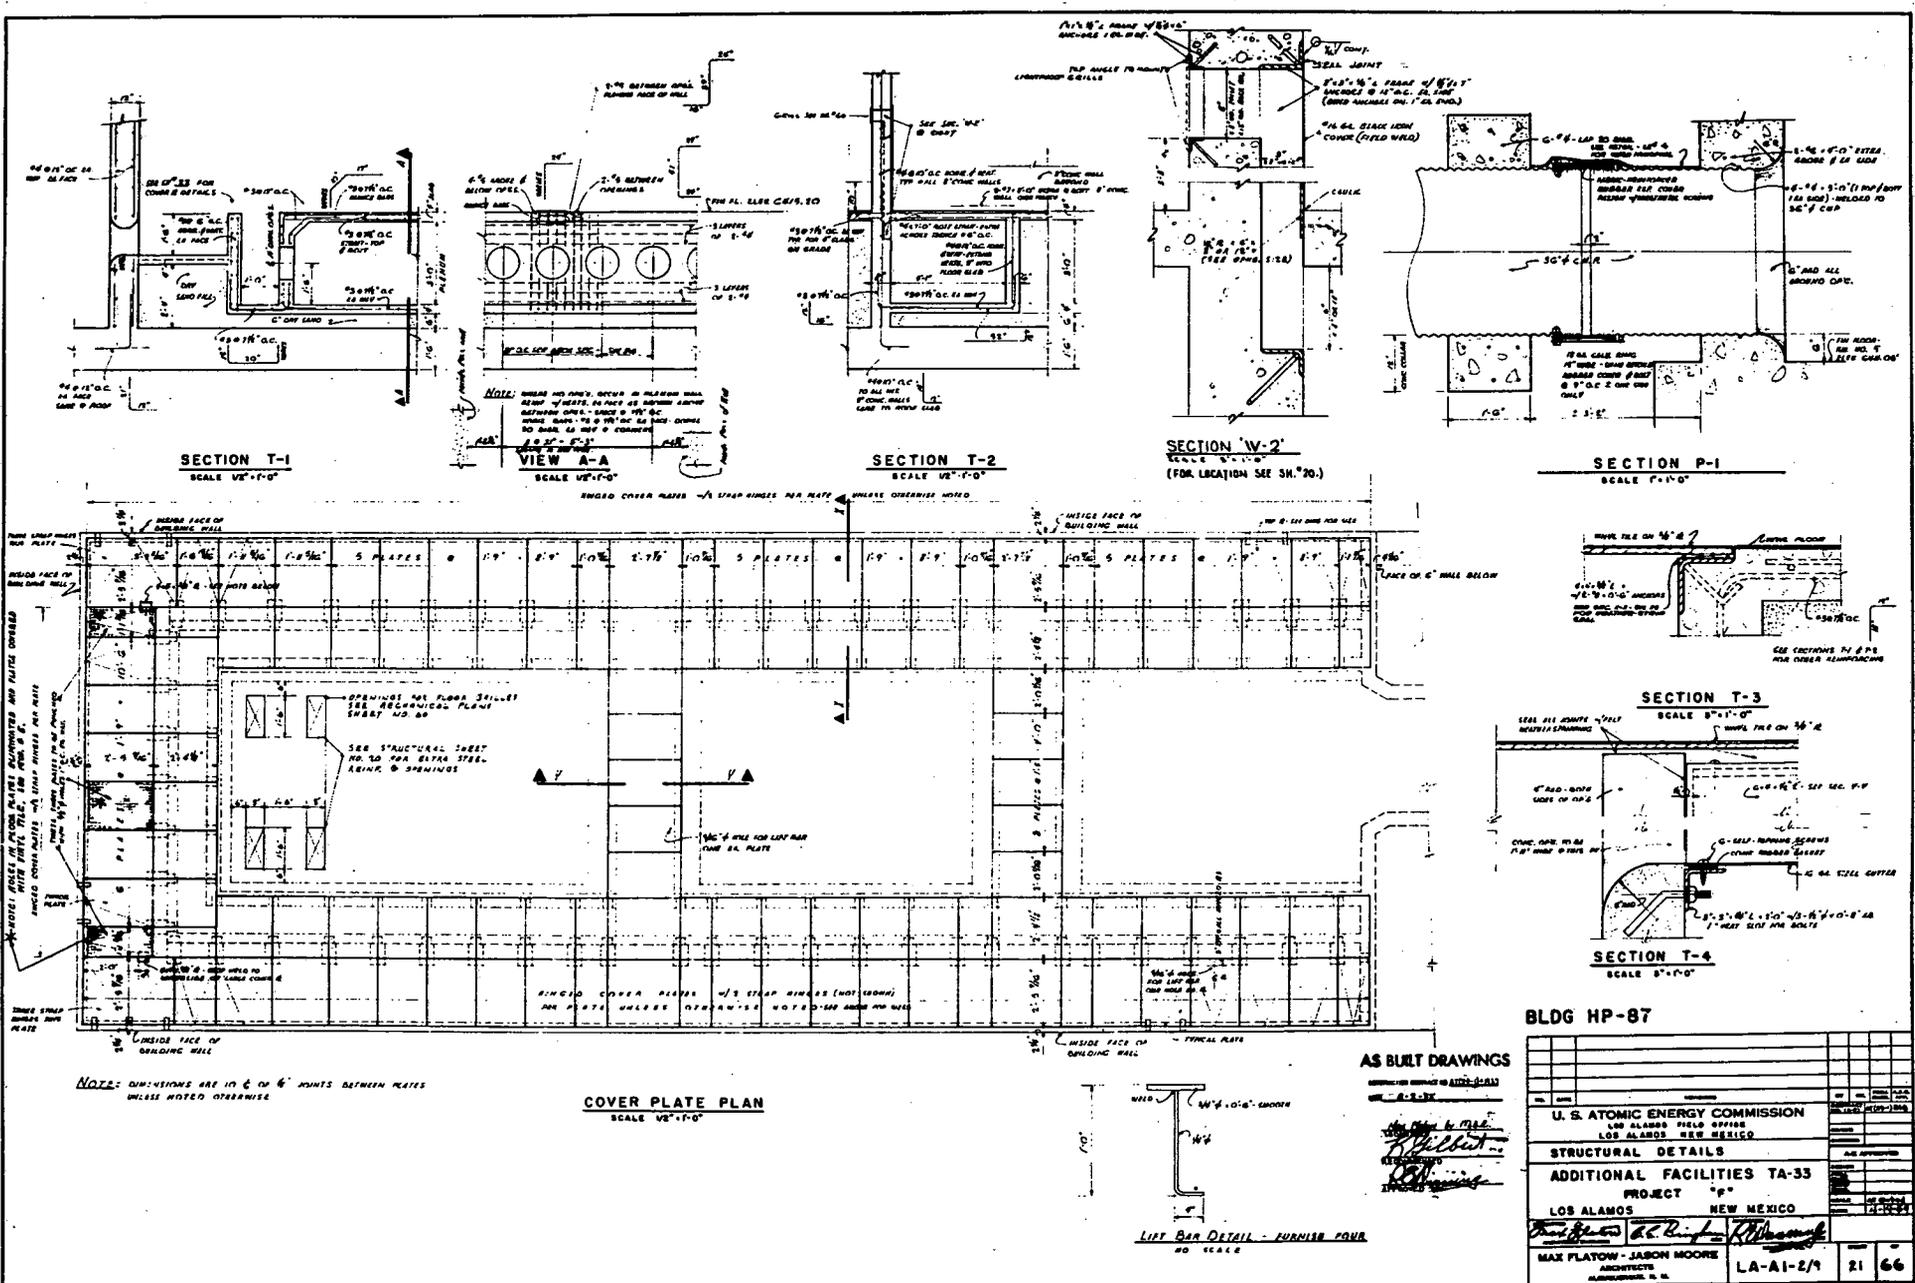

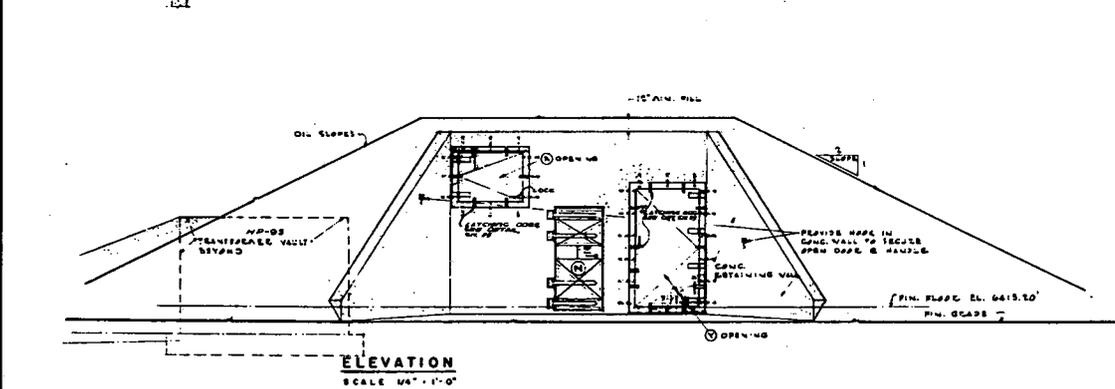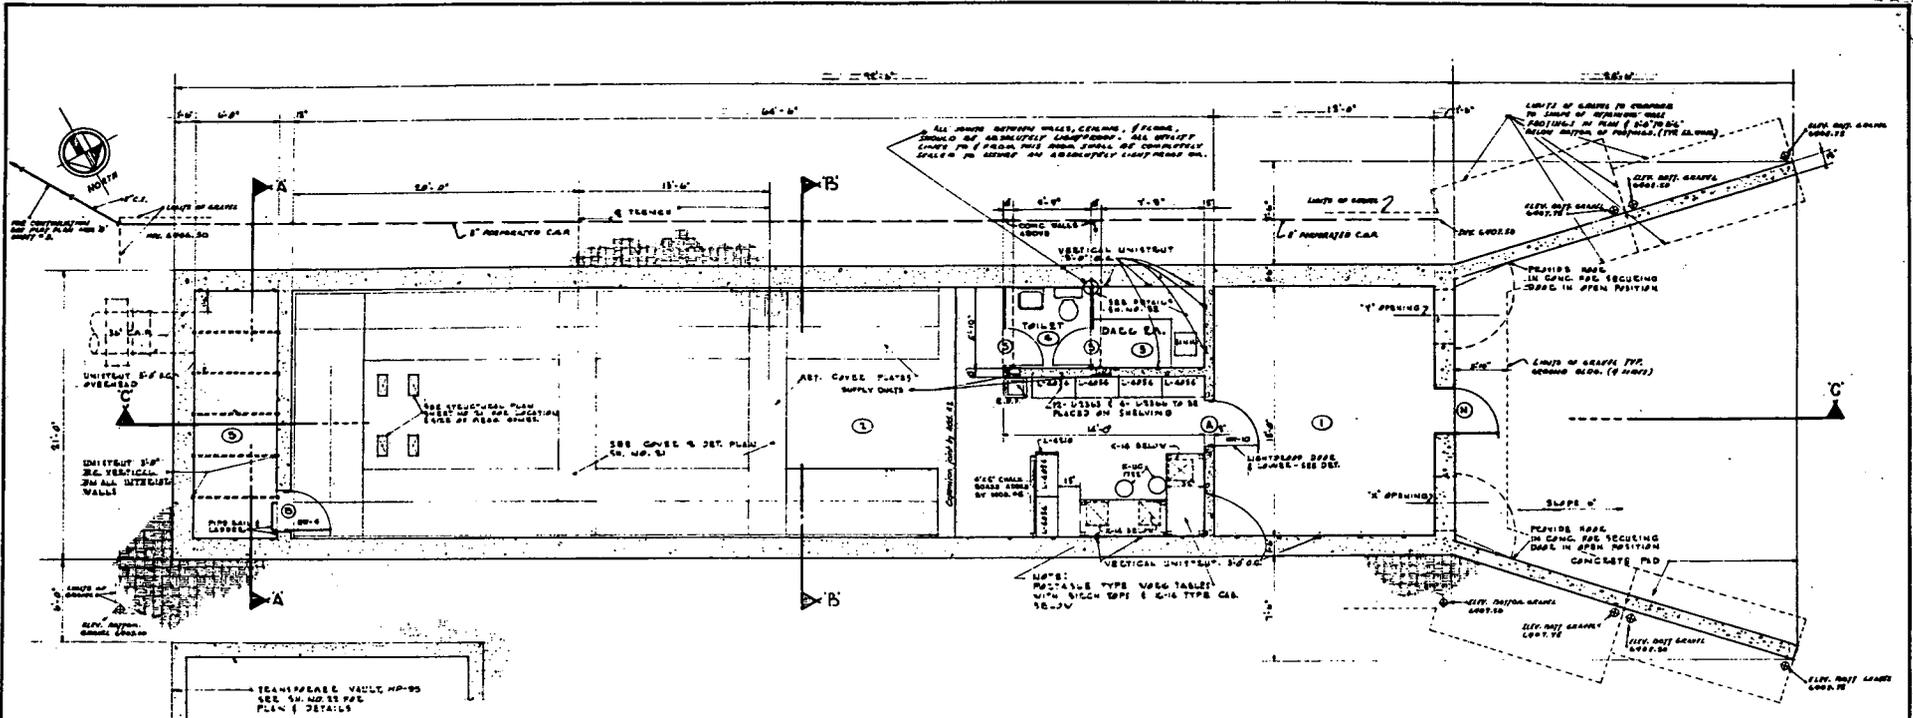

**LEGEND**

CONCRETE

MULLION SET PART. BY 1/4" OF DEPTH.

**NOTES:**

1. SEE SH. NO. HP-87 SCHEDULES & SH. 31 THRU 53 FOR JOIST DETAILS.

**ROOF FINISH SCHEDULE**

ROOF NO.	FLOOR	WALLS	CEILING	BASE	BEARDS
1	0	0	0	0	0
2	0	0	0	0	0
3	0	0	0	0	0
4	0	0	0	0	0
5	0	0	0	0	0

**AS BUILT DRAWINGS**

DATE: 11-2-57

*Max Flatow*  
*Jason Moore*

DOES NOT CONTAIN OFFICIAL USE ONLY INFORMATION


Name/Org.: Jill Hefele/S-7 Date: 6/23/04

**BLDG. HP-87**

NO.	DATE	BY	CHKD.	APP. BY
U. S. ATOMIC ENERGY COMMISSION LOS ALAMOS FIELD OFFICE LOS ALAMOS NEW MEXICO				
FLOOR PLAN & ELEVATION				
ADDITIONAL FACILITIES TA-33 PROJECT				
LOS ALAMOS NEW MEXICO				
MAX FLATOW - JASON MOORE		LA-AI-84		
ARCHITECTS		25 66		

L.A.S.L. DWG. NO. ENG-C 3324

NO.	DATE	REVISION	BY CHD	GRP ENG
1	8-19-66	REVISED TO STATUS OF 8-16-66	MFN	W. T. H. A.

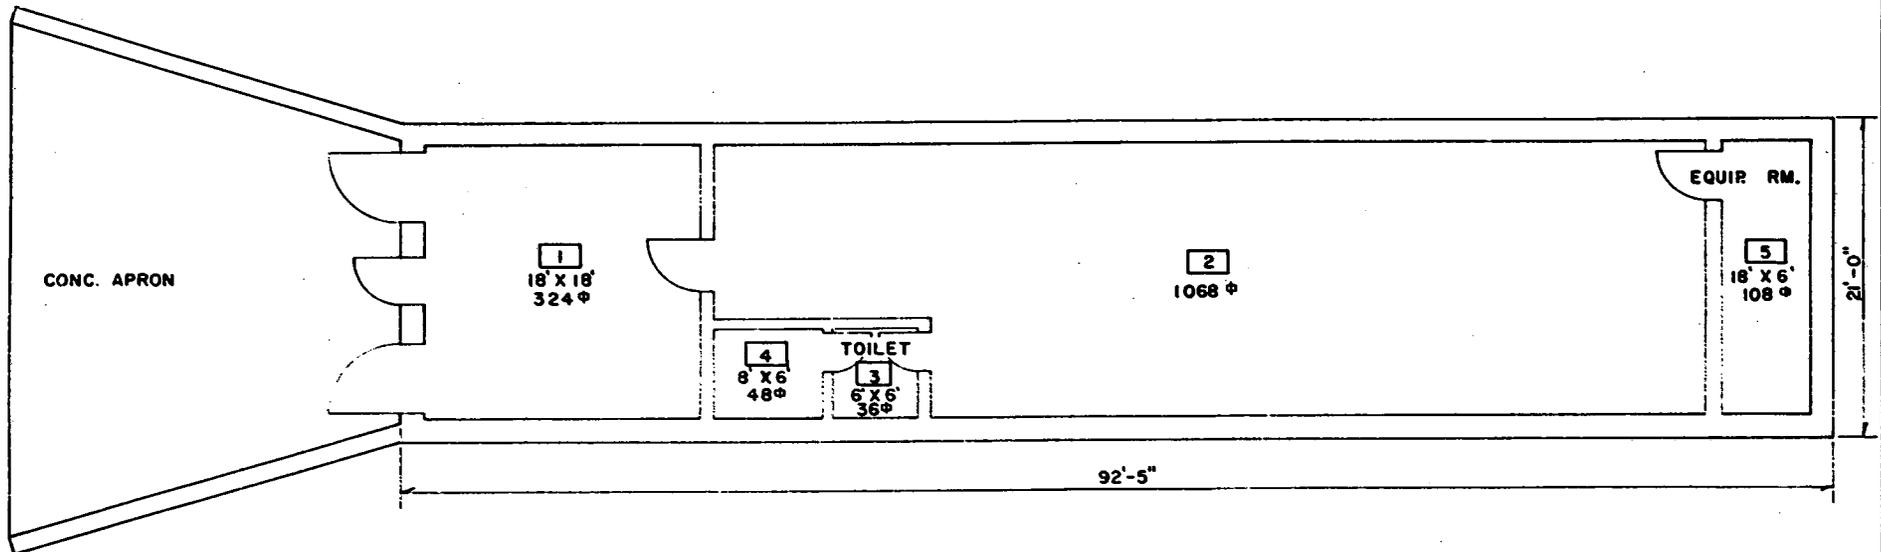

TOTAL SQ. FT. 1584

REV.	DATE	REVISION	BY	CHD	APP.
2	6-8-84	REVISED TO STATUS OF 6-8-84	HGN	T	DP

UNIVERSITY OF CALIFORNIA  
**Los Alamos** Los Alamos National Laboratory  
 Los Alamos, New Mexico 87545

FACILITIES ENGINEERING DIVISION

**CONTROL BUILDING**  
**FLOOR PLAN**

BLDG. HP-87 TA-33

SEC. CLASSIFICATION  
 CLASS. *U*  
 REVIEWER *W. T. H. A.*  
 DATE *6-11-84*

SUBMITTED *E. Trussello* RECOMMENDED *Dominic Trussello* APPROVED *W. T. H. A.*

DRAWN **LEMON** DATE **3-21-63** SHEET NO. **1** OF **1** DRAWING NO. **ENG-R3036**

CHECKED *Humble* HLN

REVISIONS TO VERTICALS

LANL TA- Building # 33-0088

Camera 984244

Frame #s DCP\_1713

Surveyor(s) K. Garcia, J. Ronquillo

Date 07/14/2003

Los Alamos National Laboratory CRMT Historic Building Survey Form

Building Name Cable Building/Instrumentation Building UTMs easting 388851 northing 3959218 zone 13

Legal Description: Map White Rock Quad 1984 tnspl range sec

Current Use/ Function Storage Original Use/ Function Cable Building

Date (estimated) Date (actual) 1955 Property Type Laboratory/Processing

Type of Construction

Pre-Fabricated Metal Steel Frame Wood Frame CMU Reinforced Concrete

Other Type of Construction # of Stories 1

Foundation Reinforced Concrete

Exterior CMU-Exterior Reinforced Concrete-Exterior Steel (galvanized) Steel (corrugated) Wood Siding Asbestos Shingles-Exterior In-Fill Panels Other-Exterior Earthen berm

Exterior Treatment (painted, stuccoed, etc) Painted concrete

Exterior Features (docks, speakers, lights, signs, etc) Wall mounted fire extinguisher, electrical conduit and control box, pipe sleeve openings and caps, and security light.

Addition CMU-Addition Reinforced Concrete-Addition Steel (galvanized)- Addition Wood Steel (corrugated)-Addition Asbestos Shingles-Addition Other- Addition

Exterior Treatment-Addition

Exterior Features-Addition

Roof Form Slanted/Shed Gable Other Roof Type Flat with earthen berm.

Degree of Pitch/ Slope Slight

Roof Materials Corrugated Metal Rolled Asphalt Asbestos Shingles 4-Ply Built Up Other Roof Materials Reinforced concrete roof covered with an earthen berm.

Window Type Casement Single Hung Sash Double Hung Sash Fixed Window Other Window Type

# of Each Window Type/ Comments N/A

Glass Type Clear Wire Glass Opaque Painted Glass Glass Block

Light Pattern

**Door Type**

**Personnel Door Types**

Exterior Fire Door  Single  Double  Roll-up  Sliding   
 Hollow Metal  Solid Wood  1/2 Glazed  Paneled   
 Louvered  Painted

Interior Fire Door  Single  Double  Roll-up  Sliding   
 Hollow Metal  Solid Wood  1/2 Glazed  Paneled   
 Louvered  Painted

**Equipment Door Types**

Exterior Fire Door  Single  Double  Roll-up  Sliding   
 Hollow Metal  Solid Wood  1/2 Glazed  Paneled   
 Louvered  Painted

Interior Fire Door  Single  Double  Roll-up  Sliding   
 Hollow Metal  Solid Metal  1/2 Glazed  Paneled   
 Louvered  Painted

# of Each Door Type/Comments:

**Interior Wall**

Gypsum Board  Reinforced Concrete- Interior

CMU- Interior  Plywood  Other- Interior

In-Wall Electrical Wiring  On-Wall Electrical Wiring

**Ceiling** Drop Ceiling

Interior Comments (Equipment, etc)

**Degree of Remodeling**

**Condition** Excellent  Good  Fair  Deteriorating  Contaminated  Burned

**Associated Building**

If yes, list building names and #s:

**Integrity**

**Significance**

**Eligible Under Criterion** A  B  C  D  Not Eligible

**DOE Themes**

Nuclear Weapon Components and Assembly  Nuclear Weapon Design and Testing  Nuclear Propulsion

Peaceful Uses: Plowshare, Nuclear Medicine, Nuclear Energy, Nuclear Science  Energy and Environment: Research Design Projects

**LANL Themes**

Weapons Research and Design, Testing, and Stockpile Support  Super Computing   
 Reactor Technology  Biomedical/Health Physics  Strategic and Supporting Research   
 Environment/Waste Management  Administration and Social History  Architectural History

**Recommendations/ Additional Comments**

**Architectural Features (elevations)**

South Elevation: Entrance into Cable Building. North, east, and west elevations are covered by a surrounding earthen berm as is the roof of the building.

A utility tunnel connects buildings TA-33-87, -88, & -89. This 5' X 6'10" tunnel holds a 36" conduit that carries the cables connecting electronic experimental equipment in each of the buildings.

Total sq ft 192

Architect/ Builder

A/E is Max Flatow - Jason Moore, Builder R. E. McKee

Alterations

**List of Drawings (Cntrl + Enter for para break)**

ENG-C 10509  
TA-33  
Recovery Box Installation  
Civil - Plot Plan  
November 9, 1956  
Revised to as built status June 25, 1957


ENG-SK 2306  
TA-33  
Sheet 9 of 18  
Extension of TA-33 Facilities  
Plot Plan - Area B  
March 4, 1953

ENG-C 3305  
Sheet 4 of 66  
TA-33  
Additional Facilities, TA-33  
Profile & Details 36" Conduit  
April 19, 1954

ENG-SK 2308  
Sheet 11 of 18  
TA-33, Buildings 88 & 89 (Buildings HP-88 & HP-89)  
Extension of TA-33 Facilities  
Plan, Elevation, & Section  
March 4, 1953


ENG-C 3327  
Sheet 26 of 66  
TA-33, Building 88 (Building HP-88)  
Additional Facilities TA-33  
Structural Plan & Details  
April 19, 1954

ENG-R 3037  
TA-33, Bldg HP-88  
Cable Building  
Floor Plan  
June 16, 1964  
Revised to status of June 8, 1984

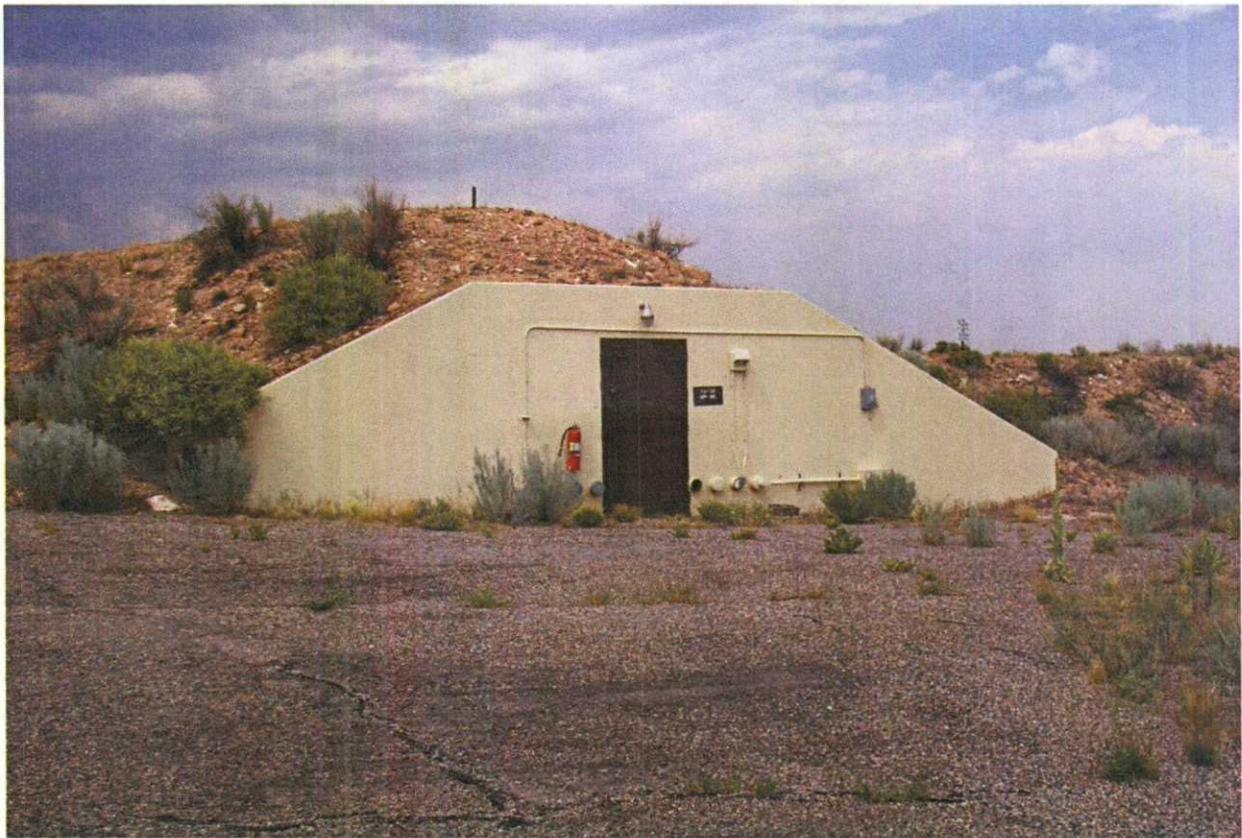

TA-33-88, South side, facing north

OFFICIAL USE ONLY

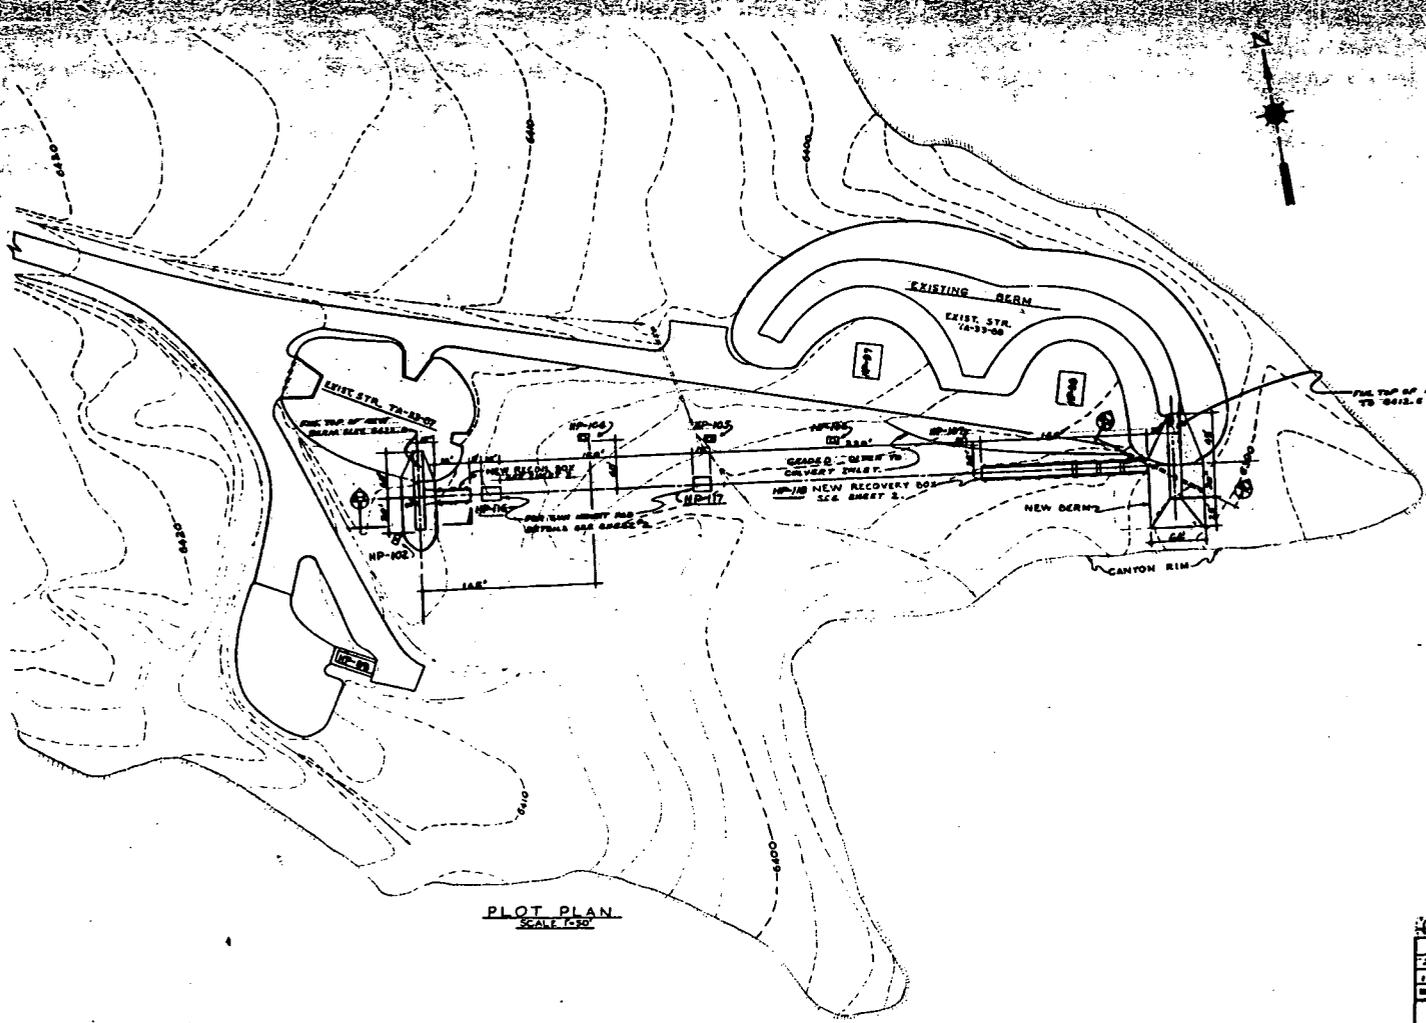


PLOT PLAN  
SCALE: 1"=50'

DOES NOT CONTAIN  
OFFICIAL USE ONLY  
INFORMATION  
Name/Org.: Jill Hefe/S-7 Date: 6/23/04


THIS JOB MUST BE INSPECTED  
AND ANY CHANGES APPROVED  
BY BRIG. STALLINGS FROM 7-1181

OFFICIAL USE ONLY

2	6/23/04	REVISED TO AS BUILT STATUS.	J.C.H.
1	6-23-04	Approved & Draw. No. 1	J.C.H.
DR	DATE	REVISIONS	BY
<b>LOS ALAMOS SCIENTIFIC LABORATORY</b>			
ENGINEERING DEPARTMENT UNIVERSITY OF CALIFORNIA - LOS ALAMOS, NEW MEXICO			
<b>RECOVERY BOX INSTALLATION CIVIL - PLOT PLAN</b>			
8296. NP-07		TA-33	
DESIGNED BY	TRAC	CHECKED BY	J.C.H.
DRAWN BY	J.C.H.	DATE	11-9-56
SCALE	1" = 50'	NOTED	ENG-C 10509

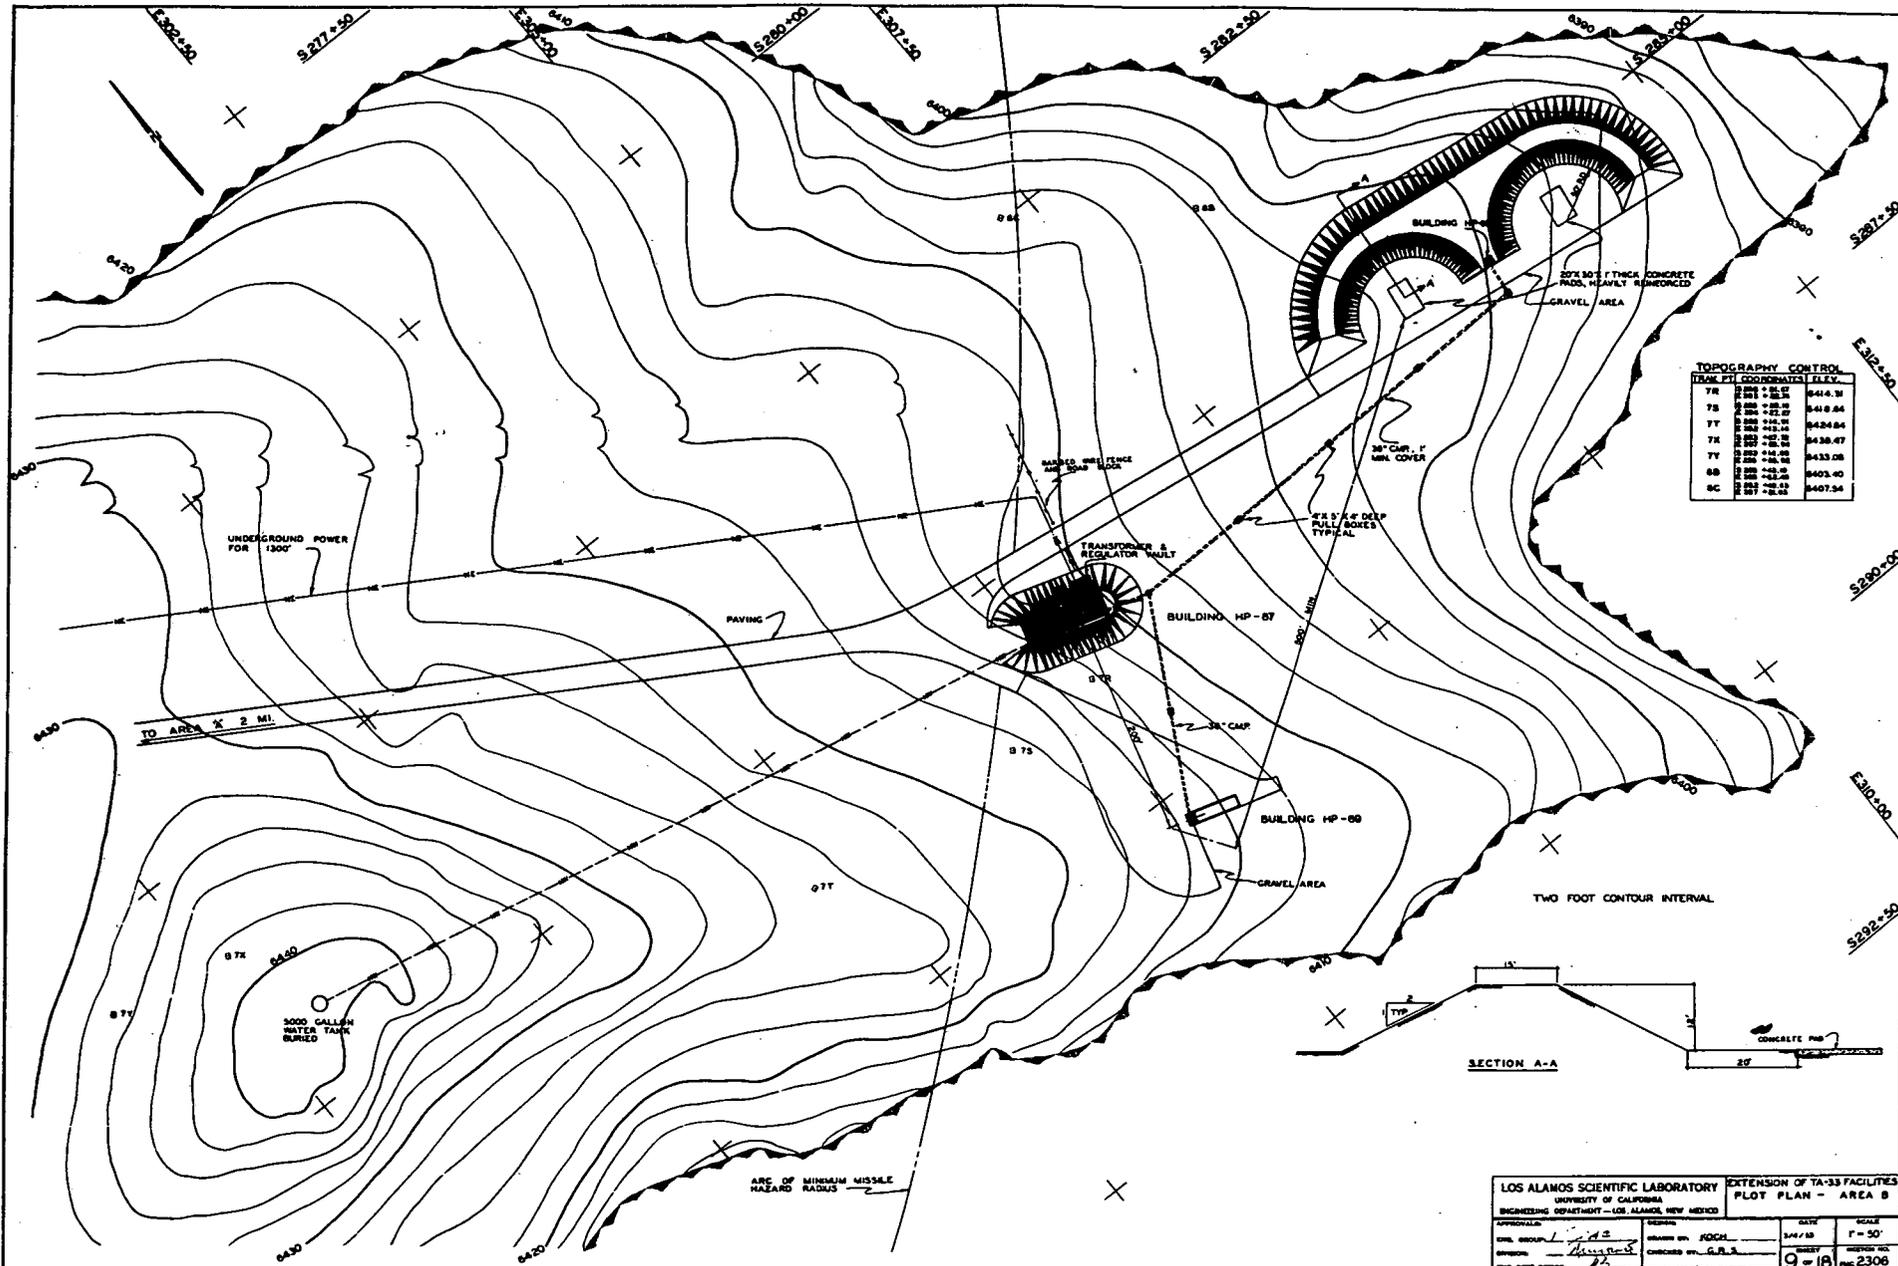



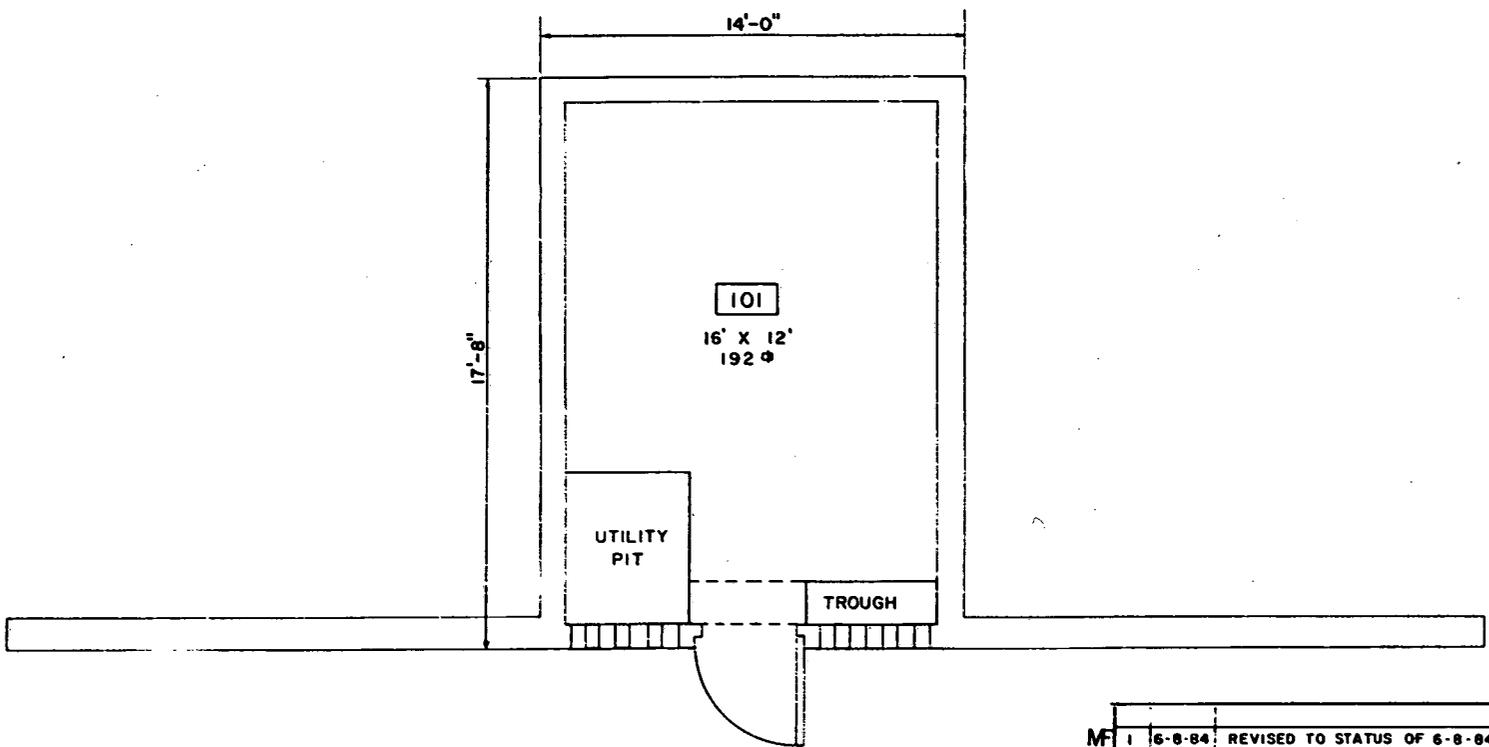

(1/4"=1'-0")





GRAPHIC SCALE

TOTAL SQ. FT. 192



REV.	DATE	REVISION	BY	CHK.	APP.
M	6-8-64	REVISED TO STATUS OF 6-8-64	HBN		
UNIVERSITY OF CALIFORNIA					
<b>Los Alamos</b>		Los Alamos National Laboratory Los Alamos, New Mexico 87545			
FACILITIES ENGINEERING DIVISION					
<b>CABLE BUILDING</b>				SEC. CLASSIFICATION	
<b>FLOOR PLAN</b>				CLASS. <i>U</i>	
BLOG. HP-88				TA-33	
DATE <i>6-16-64</i>				DATE <i>6-16-64</i>	
SUBMITTED <i>E. Bremer</i>		RECOMMENDED <i>Daniel Papp</i>		APPROVED <i>W.T. Elmer</i>	
DRAWN	BREMER	DATE	SHEET NO.	DRAWING NO.	
CHECKED	<i>Frank HEN</i>	6-16-64	1 OF 1	ENG-R3037	

*7/1/64*

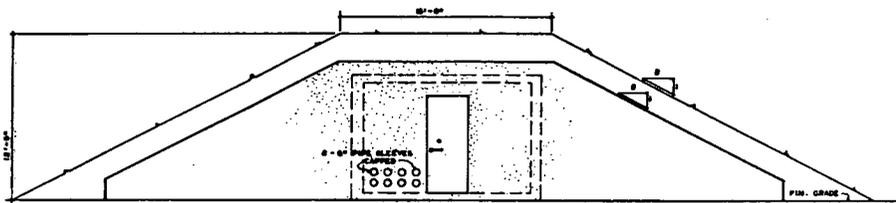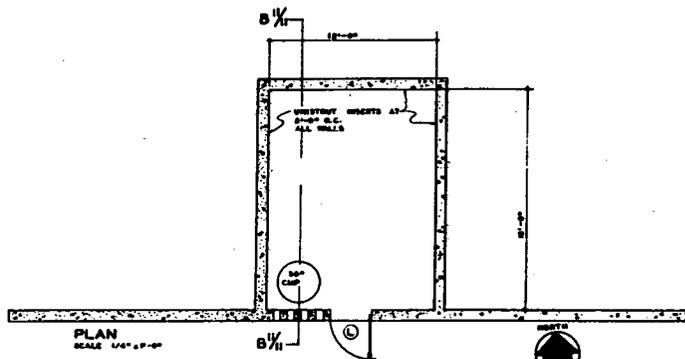

SECTION B-Y  
SCALE 1/4" = 1'-0"


BUILDING HP-88

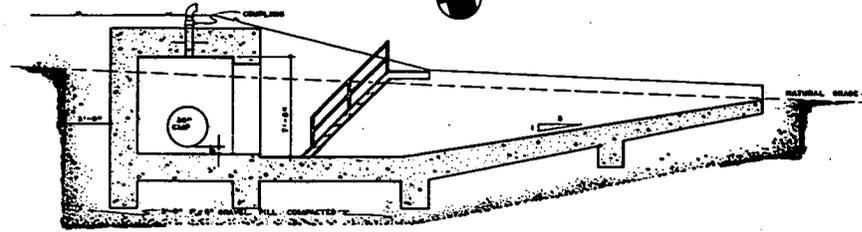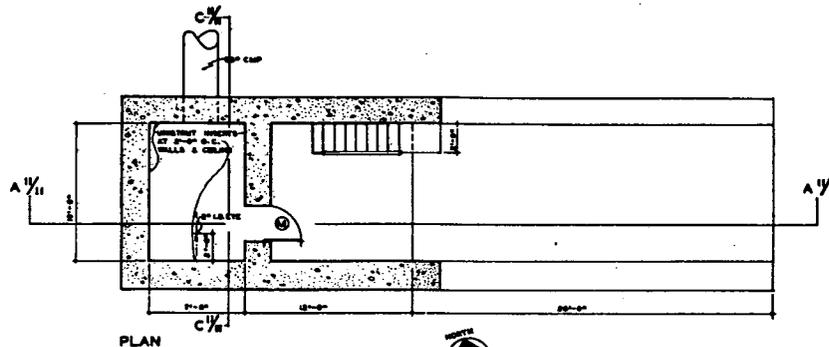


SECTION C-Y  
SCALE 1/4" = 1'-0"

BUILDING HP-89


LOS ALAMOS SCIENTIFIC LABORATORY		UNIVERSITY OF CALIFORNIA	
ENGINEERING DEPARTMENT - LOS ALAMOS, NEW MEXICO		EXTENSION OF TA-85 FACILITIES	
PLAN, ELEVATION & SECTION		BUILDINGS HP-88 & HP-89	
APPROVAL	DESIGN	DATE	SCALE
DRG. GROUP: <i>230</i>	DRG. NO. <i>S.B.S.</i>	1/1/45	1/4" = 1'-0"
DESIGNED BY: <i>W.C.H.</i>	CHECKED BY: <i>W.C.H.</i>	11-18	2308
THIS DEPT. OFFICE: <i>3</i>			

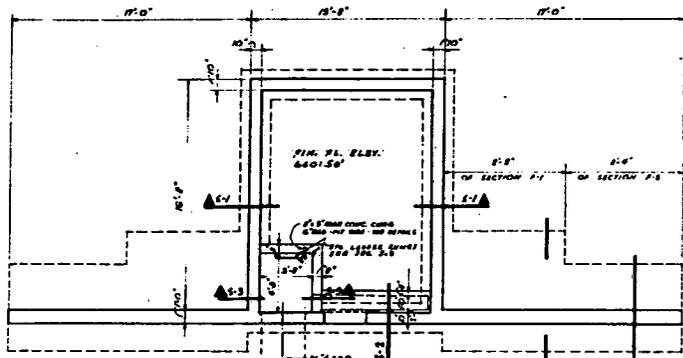

PLAN - BLDG. HP-88  
SCALE 1/4" = 1'-0"

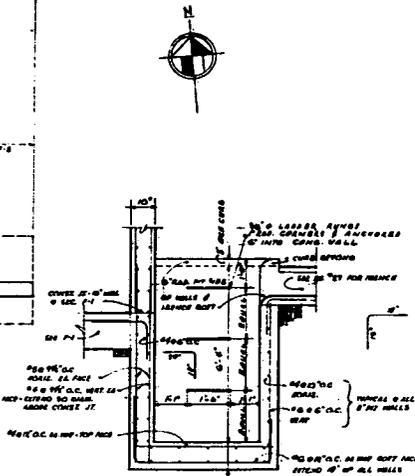


SECTION S-3  
SCALE 1/4" = 1'-0"

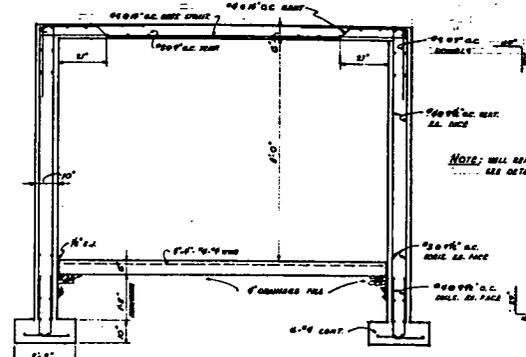


SECTION S-1  
SCALE 1/4" = 1'-0"

NOTE: WALL REINFT. TYPICAL ALL WALLS  
SEE DETAILS FOR SPECIAL CONDITIONS

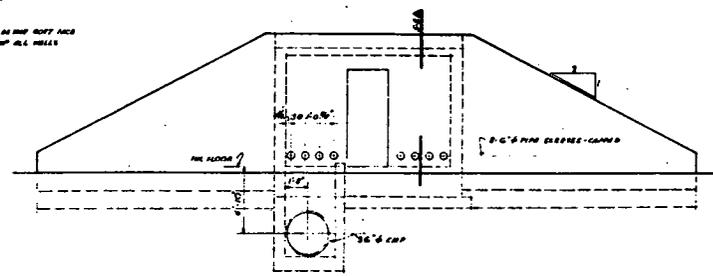


FRONT ELEVATION  
SCALE 1/4" = 1'-0"


AS BUILT DRAWINGS  
DATE: 8-1-58  
*[Signatures]*

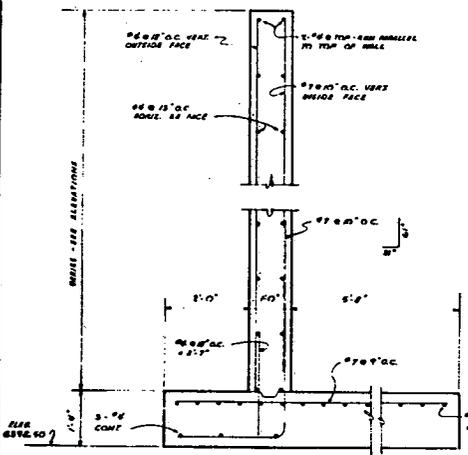

SECTION F-1  
SCALE 3/8" = 1'-0"

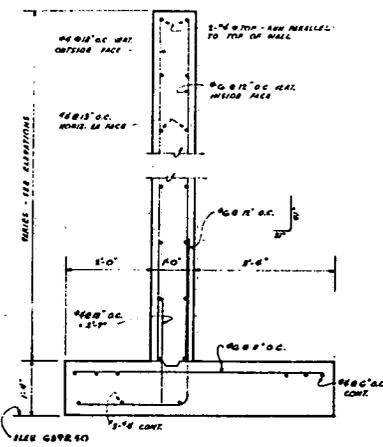

SECTION F-2  
SCALE 3/8" = 1'-0"

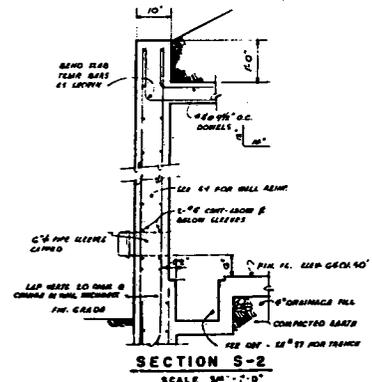

SECTION S-2  
SCALE 3/8" = 1'-0"

DOES NOT CONTAIN  
OFFICIAL USE ONLY  
INFORMATION  
Name/Org.: Jill Hefele/S-7 Date: 6/23/04

BLDG. HP-88

U. S. ATOMIC ENERGY COMMISSION		DATE	SCALE
LOS ALAMOS FIELD OFFICE		PROJECT	NO.
LOS ALAMOS, NEW MEXICO		APPROVED	
STRUCTURAL PLAN & DETAILS		DATE	
ADDITIONAL FACILITIES TA-33		SCALE	
PROJECT "P"		NO.	
LOS ALAMOS NEW MEXICO		DATE	
<i>[Signature]</i>		SCALE	
MAX PLATOW - JASON MOORE		NO.	
ARCHITECTS		DATE	
ALBANY, N. Y.		SCALE	
LA-AI-2/M		NO.	66

LANL TA- Building # 33-0089

Camera 984244

Frame #s DCP\_1714, 1715

Surveyor(s) K. Garcia, J. Ronquillo

Date 07/14/2003

Los Alamos National Laboratory CRMT  
Historic Building Survey Form

Building Name X-Unit Vault UTM's easting 388687 northing 3959157 zone 13

Legal Description: Map White Rock Quad 1984 tns range sec

Current Use/ Function Storage Original Use/ Function X-Unit Vault

Date (estimated) Date (actual) 1955 Property Type Laboratory/Processing

Type of Construction

Pre-Fabricated Metal  Steel Frame  Wood Frame  CMU  Reinforced Concrete

Other Type of Construction # of Stories 1

Foundation Reinforced Concrete

Exterior CMU-Exterior  Reinforced Concrete-Exterior  Steel (galvanized)  Steel (corrugated)

Wood Siding  Asbestos Shingles-Exterior  In-Fill Panels  Other-Exterior Earthen berm

Exterior Treatment (painted, stuccoed, etc) Exposed unpainted concrete.

Exterior Features (docks, speakers, lights, signs, etc) There is a wall mounted security light and fire extinguisher attached to the head wall and a metal set of stairs attached to the side wing wall. In addition a safety-railing is attached to the exterior perimeter wall.

Addition CMU-Addition  Reinforced Concrete-Addition  Steel (galvanized)- Addition  Wood

Steel (corrugated)-Addition  Asbestos Shingles-Addition  Other- Addition

Exterior Treatment-Addition

Exterior Features-Addition

Roof Form Slanted/Shed  Gable  Other Roof Type Flat with earthen berm.

Degree of Pitch/ Slope Slight

Roof Materials Corrugated Metal  Rolled Asphalt  Asbestos Shingles  4-Ply Built Up

Other Roof Materials Reinforced concrete roof covered with an earthen berm.

Window Type Casement  Single Hung Sash  Double Hung Sash  Fixed Window

Other Window Type

# of Each Window Type/ Comments N/A

Glass Type Clear  Wire Glass  Opaque  Painted Glass  Glass Block

Light Pattern

- Door Type**
- Personnel Door Types
- Exterior Fire Door  Single  Double  Roll-up  Sliding   
 Hollow Metal  Solid Wood  1/2 Glazed  Paneled   
 Louvered  Painted
- Interior Fire Door  Single  Double  Roll-up  Sliding   
 Hollow Metal  Solid Wood  1/2 Glazed  Paneled   
 Louvered  Painted
- Equipment Door Types
- Exterior Fire Door  Single  Double  Roll-up  Sliding   
 Hollow Metal  Solid Wood  1/2 Glazed  Paneled   
 Louvered  Painted
- Interior Fire Door  Single  Double  Roll-up  Sliding   
 Hollow Metal  Solid Metal  1/2 Glazed  Paneled   
 Louvered  Painted

# of Each Door Type/Comments:

- Interior Wall**
- Gypsum Board  Reinforced Concrete- Interior
- CMU- Interior  Plywood  Other- Interior
- In-Wall Electrical Wiring  On-Wall Electrical Wiring

**Ceiling** Drop Ceiling

Interior Comments (Equipment, etc)

**Degree of Remodeling**

- Condition** Excellent  Good  Fair  Deteriorating  Contaminated  Burned

**Associated Building**

If yes, list building names and #s:

**Integrity**

**Significance**

- Eligible Under Criterion** A  B  C  D  Not Eligible

**DOE Themes**

- Nuclear Weapon Components and Assembly  Nuclear Weapon Design and Testing  Nuclear Propulsion
- Peaceful Uses: Plowshare, Nuclear Medicine, Nuclear Energy, Nuclear Science  Energy and Environment: Research Design Projects

**LANL Themes**

- Weapons Research and Design, Testing, and Stockpile Support  Super Computing
- Reactor Technology  Biomedical/Health Physics  Strategic and Supporting Research
- Environment/Waste Management  Administration and Social History  Architectural History

**Recommendations/ Additional Comments**

[Empty box]

**Architectural Features (elevations)**

East Elevation: Entrance into X-unit Vault. North, west, and south elevations are covered by a surrounding earthen berm as is the roof of the building.

A utility tunnel connects buildings TA-33-87, -88, & -89. This 5' X 6'10" tunnel holds a 36" conduit that carries the cables connecting electronic experimental equipment in each of the buildings.

**Total sq ft**

70

**Architect/ Builder**

A/E is Max Flatow - Jason Moore, Builder R. E. McKee

**Alterations**

[Empty box]

**List of Drawings (Cntrl + Enter for para break)**

ENG-C 10509  
TA-33  
Recovery Box Installation  
Civil - Plot Plan  
November 9, 1956  
Revised to as built status June 25, 1957

ENG-SK 2306  
Sheet 9 of 18  
TA-33  
Extension of TA-33 Facilities  
Plot Plan - Area B  
March 4, 1953

ENG-C 3305  
Sheet 4 of 66  
TA-33  
Additional Facilities, TA-33  
Profile & Details 36" Conduit  
April 19, 1954

ENG-SK 2308  
Sheet 11 of 18  
TA-33, Buildings 88 & 89 (Buildings HP-88 & HP-89)  
Extension of TA-33 Facilities  
Plan, Elevation, & Section  
March 4, 1953

ENG-C 3329  
Sheet 28 of 66  
TA-33, Building 89 (Building HP-89)  
Additional Facilities TA-33  
Structural Plan & Details  
April 19, 1954


ENG-c 3330  
Sheet 29 of 66  
TA-33, Building 89 (Building HP-89)  
Additional Facilities TA-33  
Architectural Plan & Details  
April 19, 1954

ENG-R 3038  
TA-33, Bldg 89 (Bldg HP-89)  
X-Unit Vault  
Floor Plan  
June 29, 1964  
Revised as to status of June 8, 1984



TA-33-89, East side, facing west

OFFICIAL USE ONLY


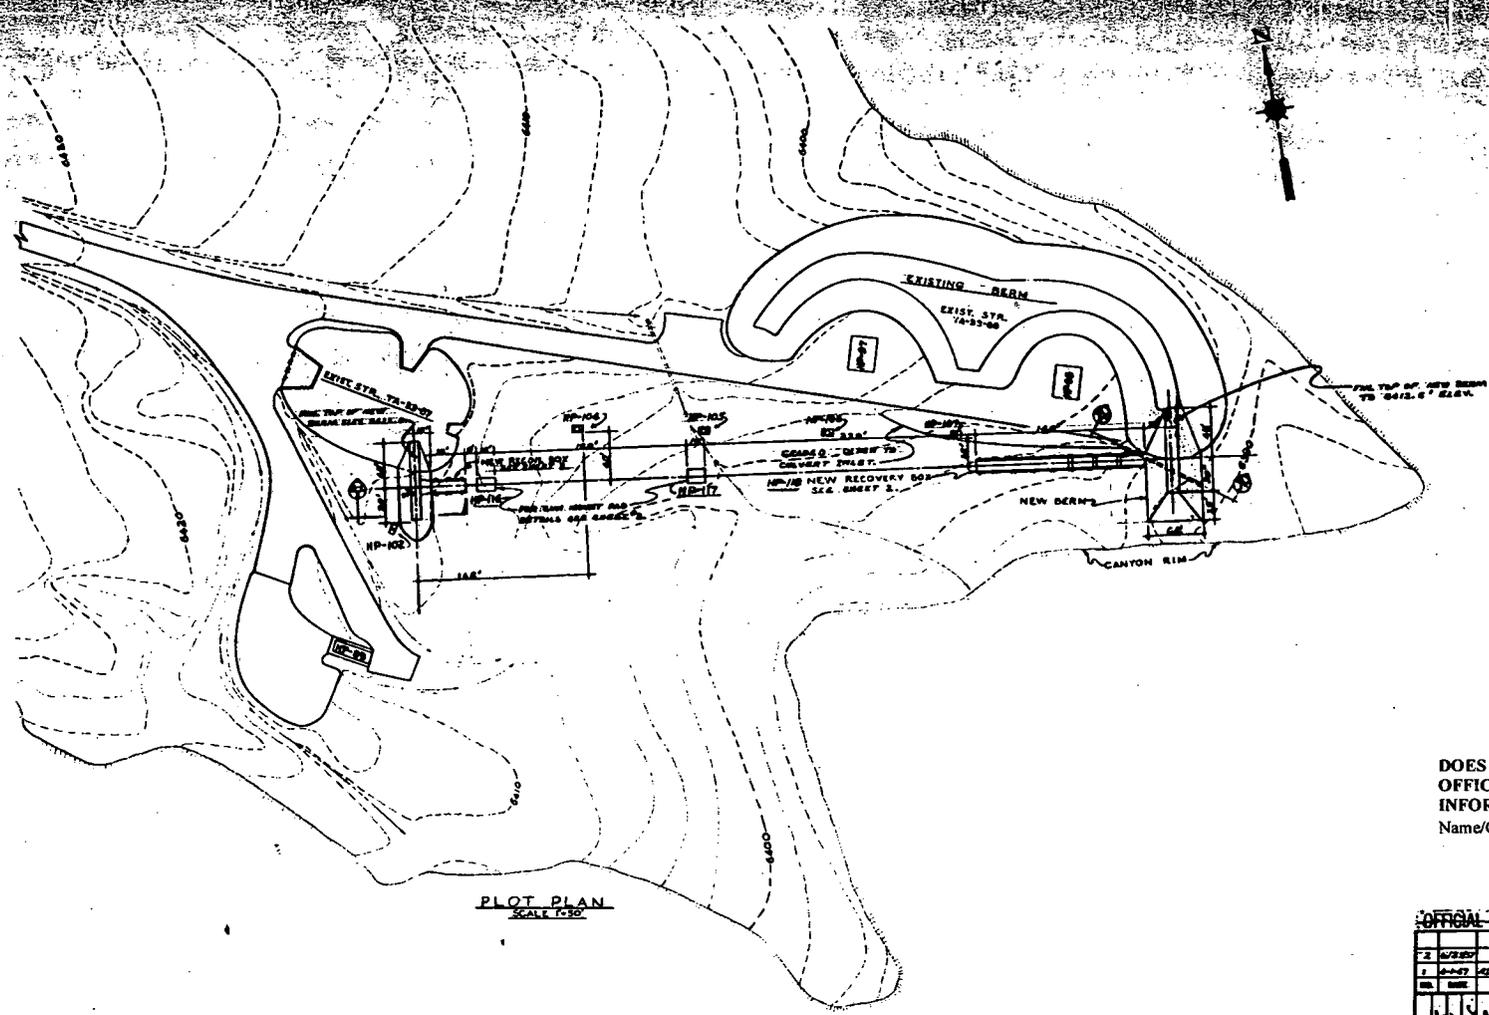


PLOT PLAN  
SCALE 1"=30'

DOES NOT CONTAIN  
OFFICIAL USE ONLY  
INFORMATION  
Name/Org.: Jill Hefele/S-7 Date: 6/23/04

THIS HAS BEEN RE-INSPECTED  
AND ANY CHANGES APPROVED  
BY STALLINGS FROM 9-11-04

OFFICIAL USE ONLY			
2	REVISED	REVISED TO AS BUILT STATUS	ZC
1	10-07	APPROVED BY: JH	DATE
NO.	DATE	DESCRIPTION	BY: JH
LOS ALAMOS SCIENTIFIC LABORATORY			
ENGINEERING DEPARTMENT			
UNIVERSITY OF CALIFORNIA - LOS ALAMOS, NEW MEXICO			
RECOVERY BOX INSTALLATION			
CIVIL - PLOT PLAN			
BLDG. NO. 87		TA-33	
DESIGNED BY	DATE	SCALE	NOTED
11-9-96	11-9-96	1" = 30'	1 OF 2
ENG-C 10509			

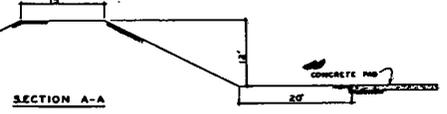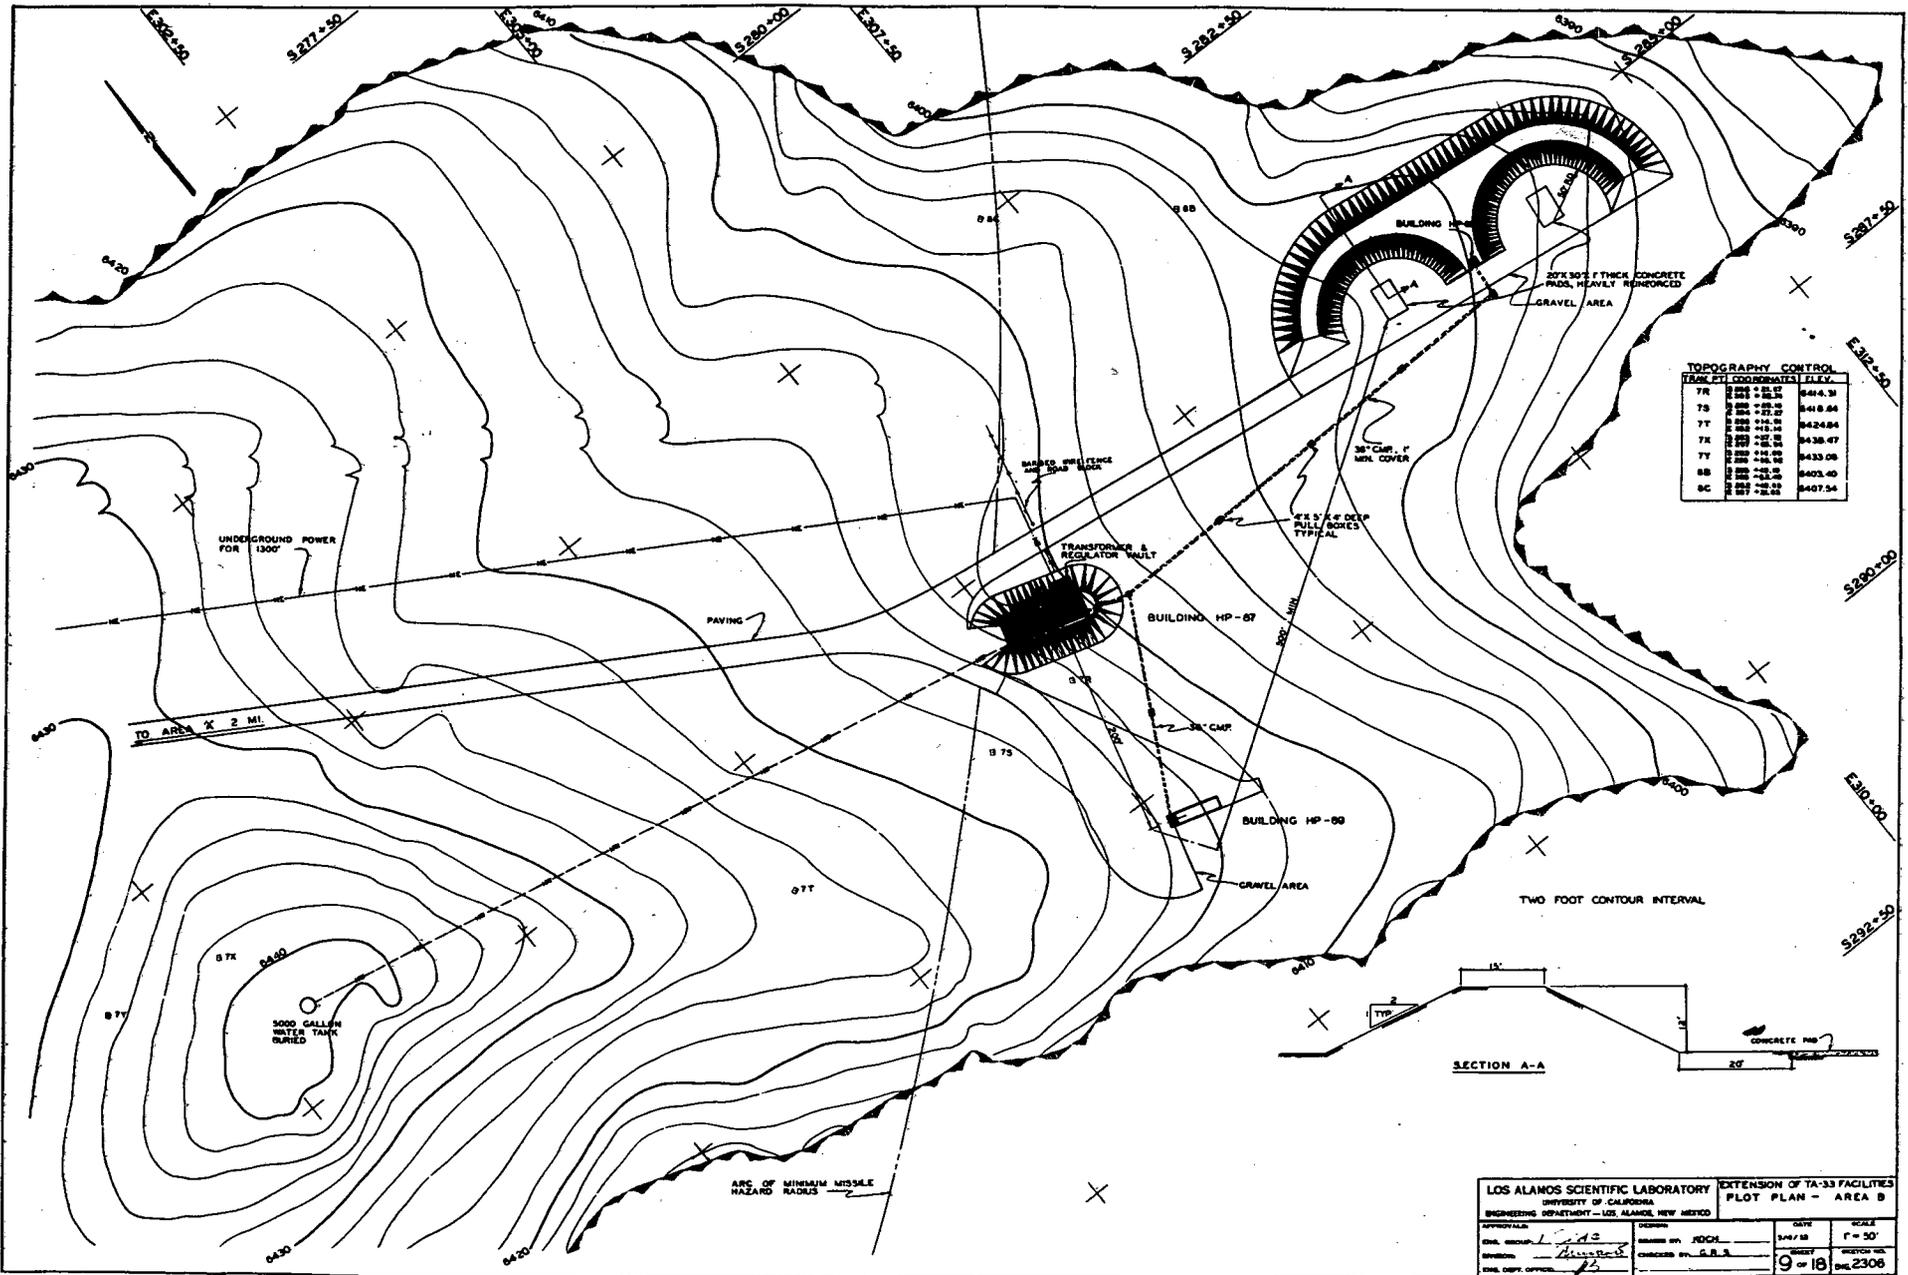


LOS ALAMOS SCIENTIFIC LABORATORY  
UNIVERSITY OF CALIFORNIA  
ENGINEERING DEPARTMENT - LOS ALAMOS, NEW MEXICO


EXTENSION OF TA-33 FACILITIES  
PLOT PLAN - AREA B

APPROVAL:	DESIGN:	DATE:	SCALE:
CHG. GROUP: <i>L. J. G.</i>	DRAWN BY: JOCK	3/27/58	1" = 50'
REVISION:	CHECKED BY: G. B. A.		
DATE: 3/27/58			


9 of 18 SHEET NO. 2306

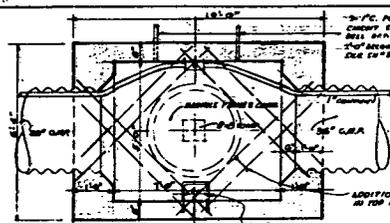



PLAN SECTION

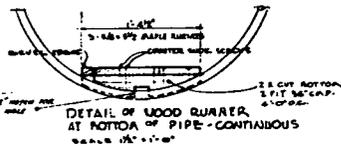

DETAIL OF WOOD RUNNER AT BOTTOM OF PIPE - CONTINUOUS

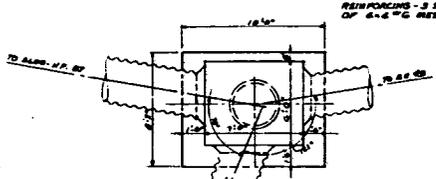


PLAN MANHOLE (NO. 2) HP-103 SCALE 1/2"=1'-0"

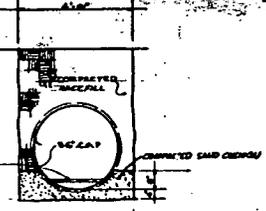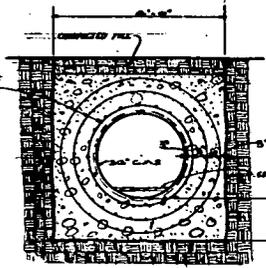


DETAIL - 36" C.M.P. CONDUIT TUNNEL TYPICAL CONDITION


SPECIAL CONCRETE ENCASUREMENT FROM EXISTING HP ON TO MANHOLE (HP-102, ONLY) SCALE 1/2"=1'-0" 36" C.M.P. CONDUIT TUNNEL

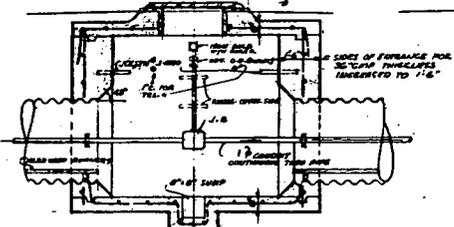

LONGIT. SECTION

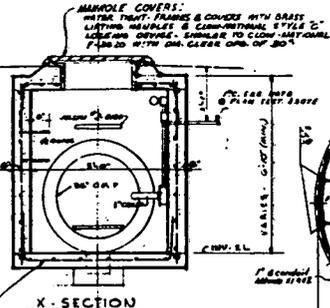


X-SECTION

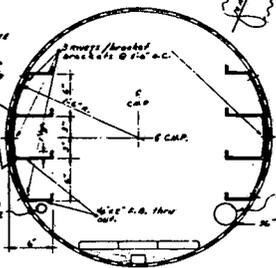


DETAIL - HANGERS @ ALL SIDES OF 36" CONDUIT TUNNEL

DETAILS OF MANHOLES NO. 1, 3, 4, 5, 6 MANHOLES (S. & G.) SIMILAR HP-103, HP-107 SCALE 1/2"=1'-0"

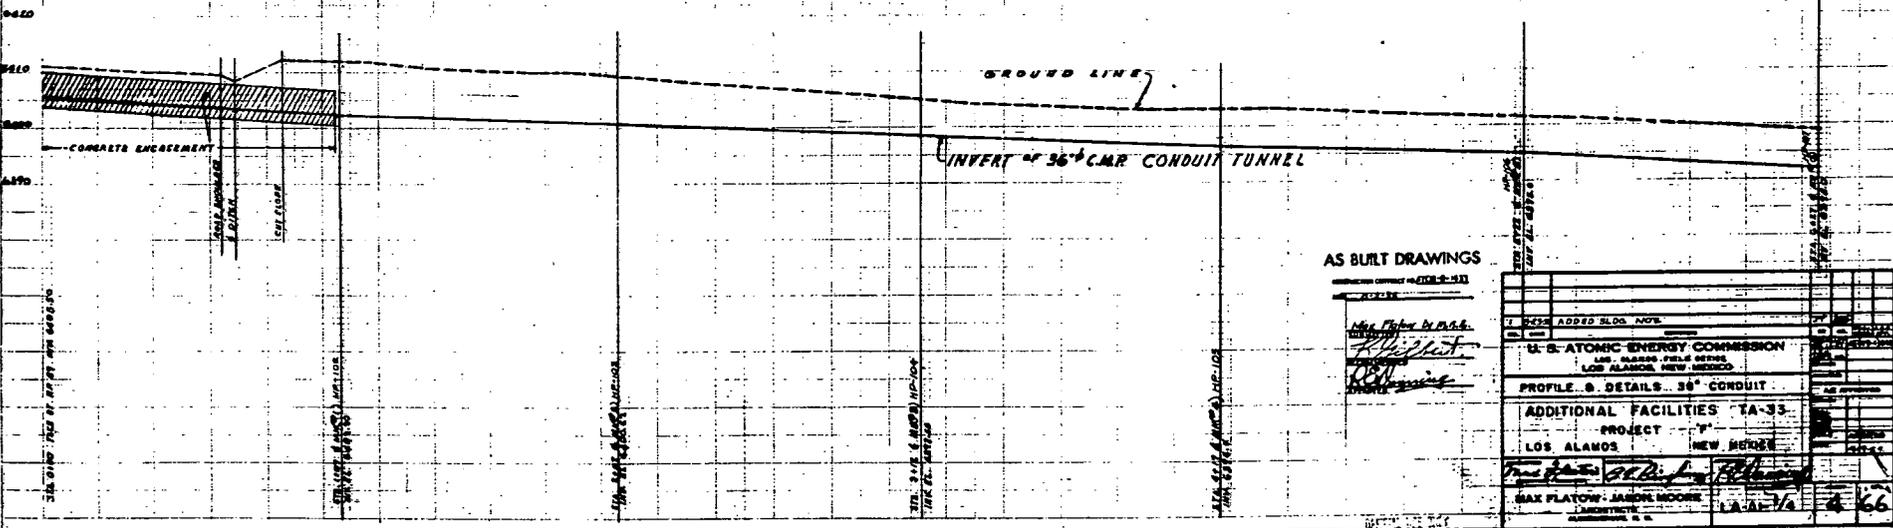


AS BUILT DRAWINGS

DATE ADDED SLDG. NO.	
U. S. ATOMIC ENERGY COMMISSION	
LOS ALAMOS FIELD OFFICE	
LOS ALAMOS, NEW MEXICO	
PROFILE & DETAILS - 36" CONDUIT	
ADDITIONAL FACILITIES - TA-33	
PROJECT - 'P'	
LOS ALAMOS NEW MEXICO	
MAX PLATTEN - JAMES MOORE	
DATE - 1-1-66	66

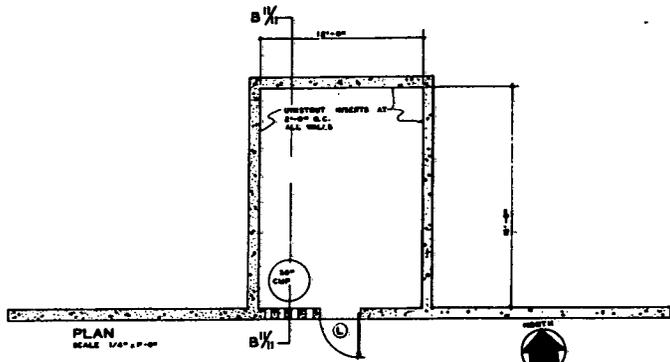


PLAN  
SCALE 1/4" = 1'-0"

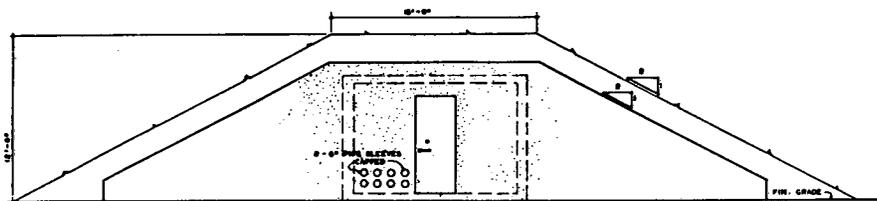


ELEVATION  
SCALE 1/4" = 1'-0"

SECTION B 1/2"  
SCALE 1/4" = 1'-0"


BUILDING HP-88

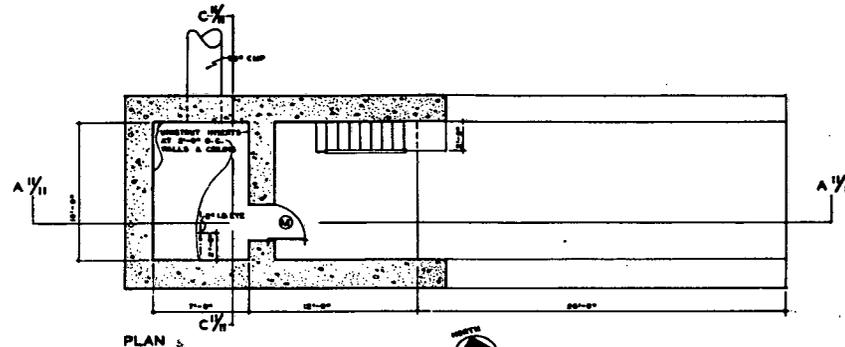

PLAN  
SCALE 1/4" = 1'-0"

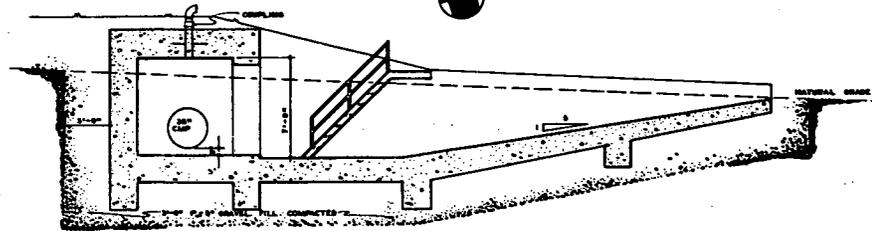


SECTION A 1/2"  
SCALE 1/4" = 1'-0"

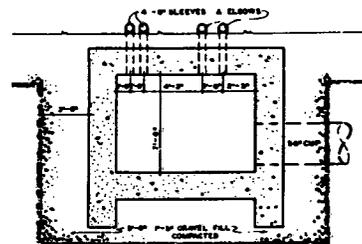


SECTION C 1/2"  
SCALE 1/4" = 1'-0"

BUILDING HP-89


LOS ALAMOS SCIENTIFIC LABORATORY UNIVERSITY OF CALIFORNIA		EXTENSION OF YA-33 FACILITIES PLAN, ELEVATION & SECTION BUILDINGS HP-88 & HP-89	
APPROVALS	DESIGNER	DATE	SCALE
DRG. NO. <i>L-230</i>	DRG. BY: <i>S.S.S.</i>	DATE	1/4" = 1'-0"
REVISION: <i>Amended</i>	CHECKED BY: <i>S.S.S.</i>	DATE	1/18
DRG. DEPT. OFFICE: <i>15</i>			2308

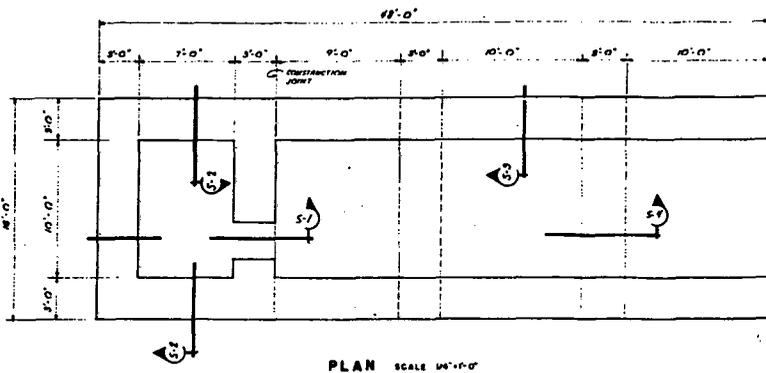


PLAN SCALE 1/4" = 1'-0"

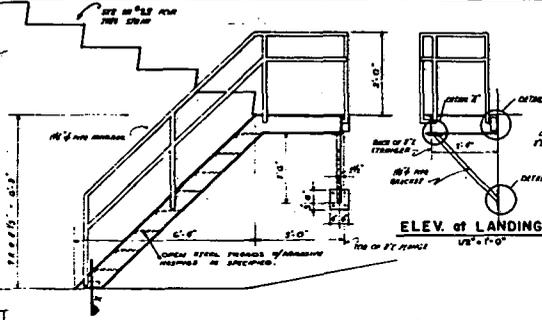


STAIR ELEVATION 1/8" = 1'-0"

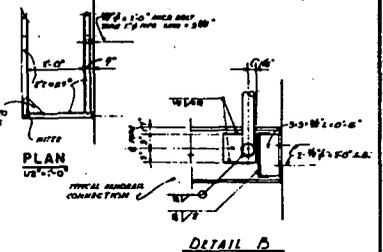


DETAIL B

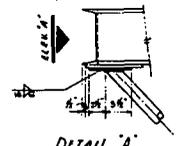

DETAIL A

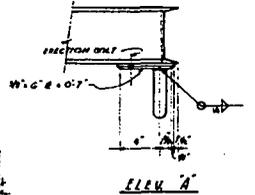


ELEV. A

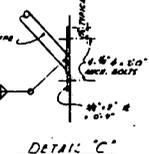


DETAIL C

NOTE: SCALE ALL STAIR DETAILS 1/8" = 1'-0"

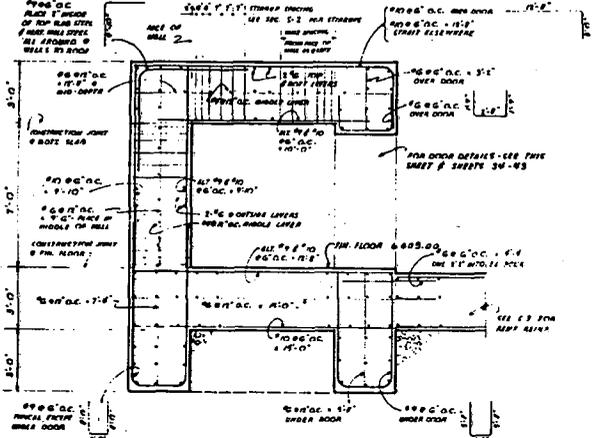


SECTION S-1 SCALE 3/8" = 1'-0"


NOTE: WEIGHTS SHOWN (KNOWN IN SECTION) 1/2" x 1/2" O.C. EA. LAYER EXCEPT IN ROOF SLAB @ WALLS ABOVE 1st FLOOR STRAPUPS IN FAIR @ WALLS SHALL HAVE SPACING AS IN ROOF SLAB MEASURED FROM CONSTRUCTION JOINTS

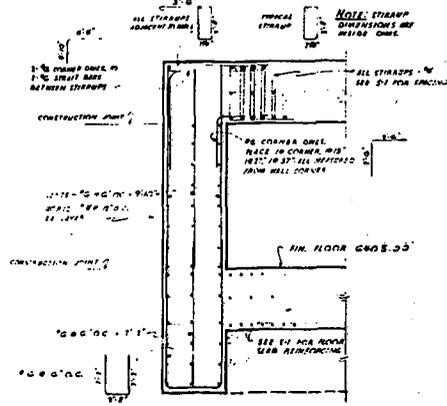

SECTION S-2 3/8" = 1'-0"

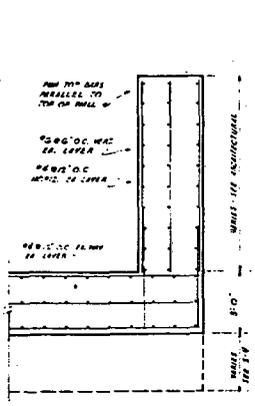

SECTION S-3 3/8" = 1'-0"

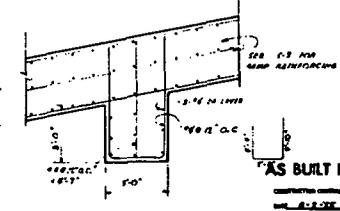


SECTION S-4 3/8" = 1'-0"


AS BUILT DRAWINGS

CONTRACT NO. 100-1-100

DATE: 8-2-77  
 J. H. B. B. B.  
 J. H. B. B. B.  
 J. H. B. B. B.  
 J. H. B. B. B.

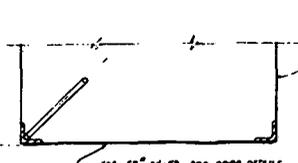

HEAD

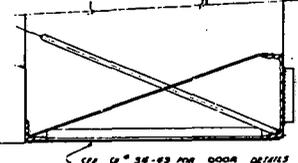

JAMB








FRAME DETAILS AT DOOR TYPE "M" 1/8" = 1'-0"

NOTE: Door frame to be poured in place

DOES NOT CONTAIN OFFICIAL USE ONLY INFORMATION  
 Name/Org.: Jill Hefele/S-7 Date: 6/23/04

BLDG. HP-89

NO.	DATE	BY	CHKD.	APP.
U. S. ATOMIC ENERGY COMMISSION LOS ALAMOS FIELD OFFICE LOS ALAMOS, NEW MEXICO				
STRUCTURAL PLAN & DETAILS ADDITIONAL FACILITIES TA-33 PROJECT "Y"				
LOS ALAMOS, NEW MEXICO				
MAX PLATOW - JASON MOORE ARCHITECTS		LA-AI-2/G		
28		66		

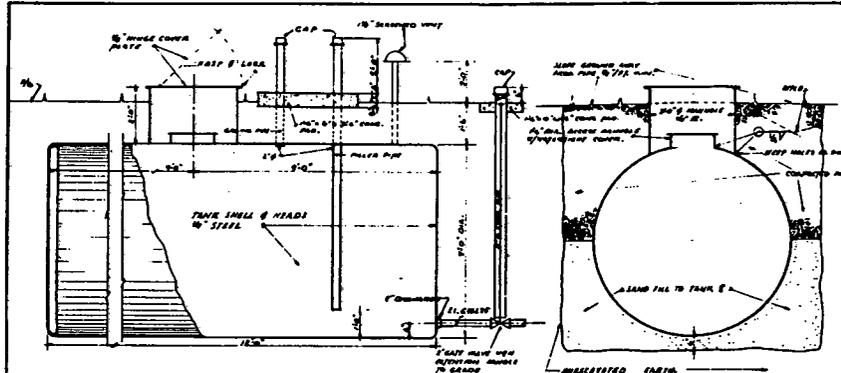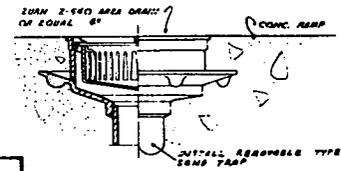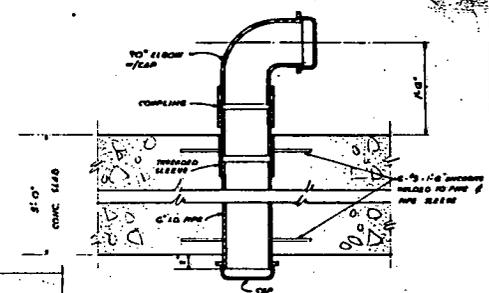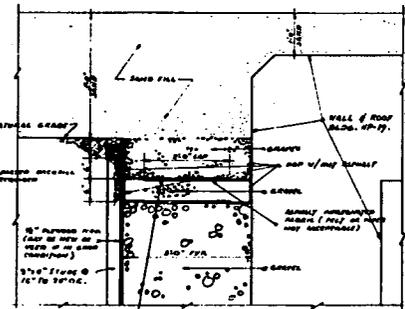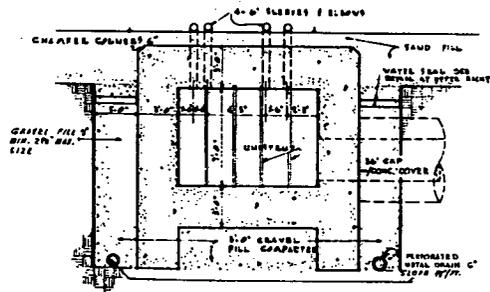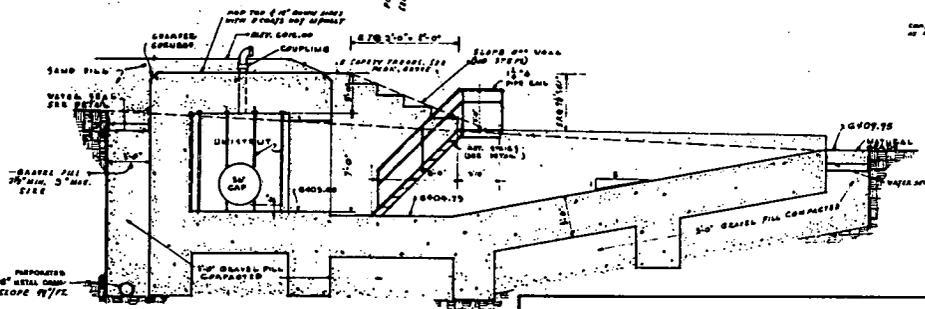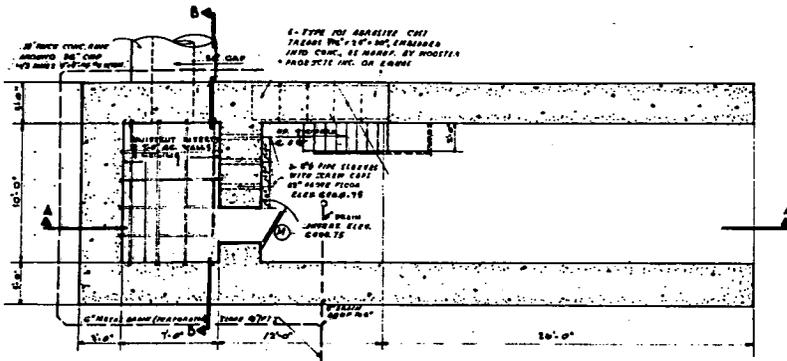


AS BUILT DRAWINGS  
NO SCALE  
REVISIONS LISTED ON 4000-A-030  
DATE: 8-2-77  
*R. H. H. M.D.*  
*R. H. H. M.D.*  
*R. H. H. M.D.*  
BY: *R. H. H. M.D.*  
CHECKED: *R. H. H. M.D.*  
DATE: 8-2-77

BLDG. HP-89.

APPROVED BLDG. NO'S.	BY	DATE
U. S. ATOMIC ENERGY COMMISSION LOS ALAMOS FIELD OFFICE LOS ALAMOS, NEW MEXICO.	TEAM	DATE
ARCHITECTURAL PLAN & DETAILS ADDITIONAL FACILITIES TA-33 PROJECT "A" LOS ALAMOS, NEW MEXICO	DATE	BY
MAX PLATOW - JASON MOORE ARCHITECTS ALBUQUERQUE, N. M.	LA-AI-1/77	29 66

DOES NOT CONTAIN  
OFFICIAL USE ONLY  
INFORMATION  
Name/Org.: Jill Hefe/S-7 Date: 6/23/08

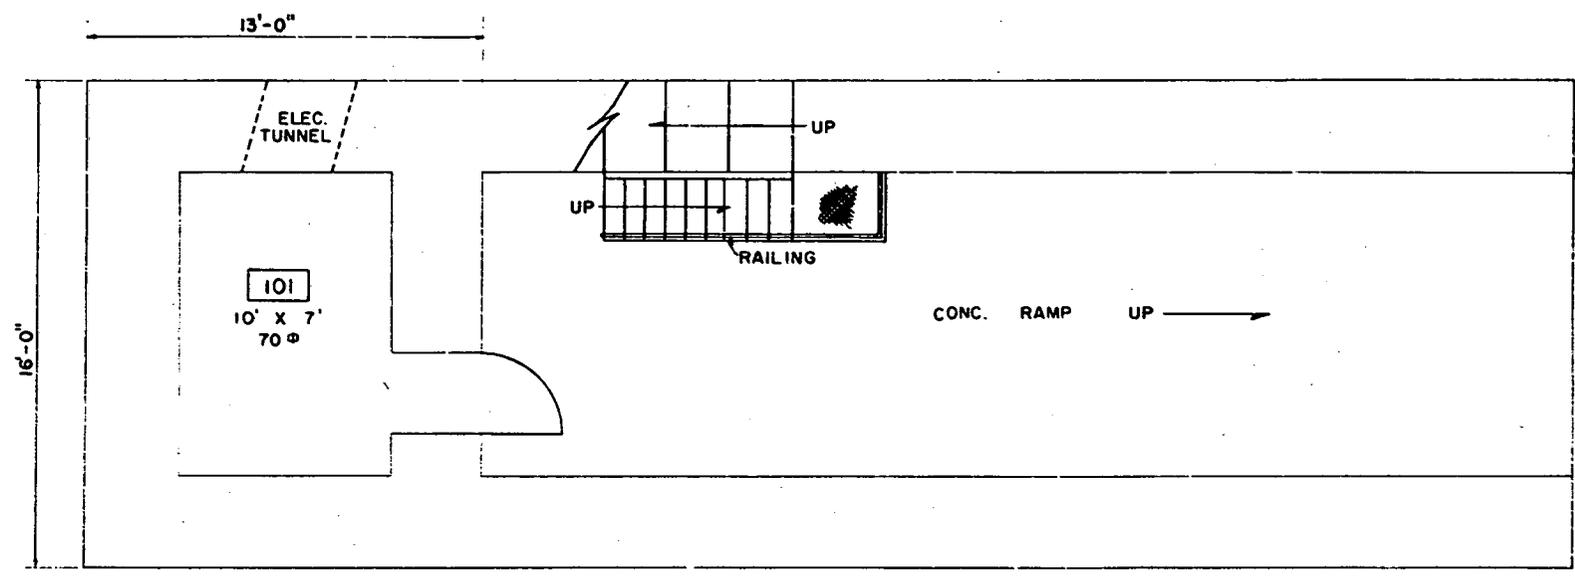

(1/4" = 1'-0")



TOTAL SQ. FT. 70

REV.	DATE	REVISION	BY	CHKD.	APP.
1	6-8-84	REVISED TO STATUS OF 6-8-84			
UNIVERSITY OF CALIFORNIA					
<b>Los Alamos</b>		Los Alamos National Laboratory Los Alamos, New Mexico 87545			
FACILITIES ENGINEERING DIVISION					
X-UNIT VAULT FLOOR PLAN					
BLDG. HP-89				TA-33	
SUBMITTED <i>S. Trujillo</i>		RECOMMENDED <i>Daniel Ross</i>		APPROVED <i>W.T. Elmer</i>	
DRAWN	DATE	SHEET NO.	DRAWING NO.		
BREMER	6-29-64	1 OF 1	ENG-R3038		
CHECKED					
<i>Franklin WEN</i>					

7/1/84