

LA-UR-23-20661

Approved for public release; distribution is unlimited.

Title: Historical Documentation of Buildings 0460 and 0463 at Technical Area
16

Author(s): Lovato, Victoria Maria Ester
Schultz, Elliot Merle
Garcia, Kari L. M

Intended for: Report
Environmental Regulatory Document

Issued: 2023-03-30 (rev.2)



Los Alamos National Laboratory, an affirmative action/equal opportunity employer, is operated by Triad National Security, LLC for the National Nuclear Security Administration of U.S. Department of Energy under contract 89233218CNA000001. By approving this article, the publisher recognizes that the U.S. Government retains nonexclusive, royalty-free license to publish or reproduce the published form of this contribution, or to allow others to do so, for U.S. Government purposes. Los Alamos National Laboratory requests that the publisher identify this article as work performed under the auspices of the U.S. Department of Energy. Los Alamos National Laboratory strongly supports academic freedom and a researcher's right to publish; as an institution, however, the Laboratory does not endorse the viewpoint of a publication or guarantee its technical correctness.

LA-UR-23-20661
February 2023

Historical Documentation of Buildings 0460 and 0463 at Technical Area 16

Volume 1

Los Alamos National Laboratory

LANL Fiscal Year 2022 Footprint Reduction

Historic Building Report No. 405

Survey No. 1242

NMCRIS Activity No. 151891

Prepared for: U.S. Department of Energy/National Nuclear Security Administration,
Los Alamos Field Office

Prepared by: Victoria M. Lovato, Cultural Resources Staff
LANL Environmental Stewardship (EPC-ES)

Elliot M. Schultz, Cultural Resources Manager, Historian of Science
LANL Environmental Stewardship (EPC-ES)

Kari L. M. Garcia, Cultural Resources Manager, Archaeologist/Historian
LANL Environmental Stewardship (EPC-ES)

Editing and Layout by: Tamara A. Hawman, Communications Specialist
Technical Editing and Communications (CEA-TEC)

Gayle Geis-O'Dowd, Communications Specialist
Technical Editing and Communications (CEA-TEC)



Los Alamos National Laboratory, an affirmative action/equal opportunity employer, is managed by Triad National Security, LLC, for the National Nuclear Security Administration of the U.S. Department of Energy, under contract 89233218CNA000001. By acceptance of this article, the publisher recognizes that the U.S. Government retains a nonexclusive, royalty-free license to publish or reproduce the published form of this contribution, or to allow others to do so, for U.S. Government purposes. Los Alamos National Laboratory requests that the publisher identify this article as work performed under the auspices of the U.S. Department of Energy. Los Alamos National Laboratory strongly supports academic freedom and a researcher's right to publish; as an institution, however, the Laboratory does not endorse the viewpoint of a publication or guarantee its technical correctness.



CONTENTS

Executive Summary	v
Acronyms and Abbreviations	vii
1 Introduction	1
Eligibility Determinations	6
Demolition and Adverse Effects	6
2 Historical Overview	7
Early Cold War Era (1946–1956)	7
Late Cold War Era (1956–1990)	8
The Cold War Ends	8
3 Technical Area Description	9
TA-16 Historical Background	9
The Ramón Vigil Grant	9
The Buckman’s S-Site and Railway Station	9
World War II and the Los Alamos Laboratory “Project Y”	10
Cold War Laboratory Expansion	12
TA-16 Historical Themes	13
Reduction, Consolidation, and Stockpile Stewardship at the Laboratory	13
Processing and Testing High Explosives	14
Strategic and Supporting Research	15
Earth and Environmental Sciences	15
Materials Science	16
Analytical Chemistry at TA-16-0460	16
4 Description of Buildings TA-16-0460 and TA-16-0463	19
Early Laboratory Architecture Style	19
Building TA-16-0460	20
Architectural Description	21
Building TA-16-0463	22
Architectural Description	22
5 Conclusion	25
6 References Cited	27

Figures

Figure 1. TA-16-0460 Complex	2
Figure 2. LANL Boundary and Technical Area 16	3
Figure 3. TA-16 Evaluated Buildings and TA-16-460 Complex	4
Figure 4. TA-16-460 Complex	5
Figure 5. Logging activities directly west of S-Site	9
Figure 6. 1944 document (page 1) establishing the new explosives division	11
Figure 7. Project Y high explosives facilities at S-Site	12
Figure 8. Cold War Era S-Site (TA-16), 1991	13
Figure 9. S-Site (TA-16), TA-16-0460 Complex (foreground), 1991	15
Figure 10. TA-16-0460, facing northeast	20
Figure 11. TA-16-0463, facing northeast	22

This page intentionally left blank



EXECUTIVE SUMMARY

The U. S. Department of Energy, National Nuclear Security Administration, Los Alamos Field Office (Field Office) has prepared the final documentation for the resolution of adverse effects to Buildings 0460 and 0463 in Technical Area (TA) 16 at Los Alamos National Laboratory (LANL or Laboratory). This documentation is being submitted to the New Mexico State Historic Preservation Officer (SHPO). TA-16-0460, a laboratory/processing building, and TA-16-0463, a rest house/support building, were determined eligible for listing in the National Register of Historic Places (Register) in the report *TA-16 Heating System Replacement* (McGehee 1995) (LA-CP-95-180). The eligibility of TA-16-0460 was reaffirmed in 2003 in the *ESA Division's Five-Year Plan: Consolidation and Revitalization at Technical Areas 3, 8, 11, and 16* (LA-UR-02-6841).

Buildings TA-16-0460 and TA-16-0463 were deemed Register eligible under Criterion A for their association with high explosives research during the Cold War. Additionally, the buildings were also deemed Register eligible under Criterion C, and Criterion Consideration G. In addition to its register evaluation, the report also identified TA-16-0460 and TA-16-0463 as excess property to be ultimately demolished by the LANL Footprint Reduction Program in Fiscal Year 2022. Determination of these findings, and corresponding adverse effects, were transmitted by the Field Office to the SHPO correspondence April 17, 2019. SHPO concurrence on both determination of adverse effects and the use of the standard mitigation practices was received May 9, 2019.

In the correspondence addressed to the SHPO the Field Office proposed mitigation of these adverse effects in compliance with Section 106 of the National Historic Preservation Act of 1966, as amended, and with the *Programmatic Agreement among the U.S. Department of Energy, National Nuclear Security Administration, Los Alamos Field Office, the New Mexico State Historic Preservation Office, and the Advisory Council on Historic Preservation Concerning Management of Historic Properties of Los Alamos National Laboratory, Los Alamos, New Mexico* (PA), dated December 23, 2015. The PA states in Appendix D.2.A. that adverse effects to Register-eligible buildings and structures will be resolved according to the procedures defined in *A Plan for the Management of the Cultural Heritage at Los Alamos National Laboratory, New Mexico* (CRMP) (LA-UR-19-21590, formerly LA-UR-15-26624) and within the PA, itself.

Under the CRMP, development of a formal three-party memorandum of agreement (MOA) is required to resolve adverse effects to exceptionally significant properties. The Advisory Council on Historic Preservation (ACHP) has chosen not to participate in routine MOAs related to the demolition of historic buildings. The PA stipulates in Section 10.D.6 that if adverse effect resolution only includes the Field Office and the New Mexico SHPO, no MOA is required, and the Field Office should consult with the SHPO in writing to resolve the adverse effects. As stated above the standard documentation measures identified in the CRMP were invoked for mitigation of the adverse effects of the demolition of these two register eligible properties, TA-16-0460 and TA-16-463.

This document fulfills the plan for mitigation. Standard reporting measures for TA-16-0460 and TA-16-0463 include archival quality photographs of the interior and exterior of the building and its landscape; the identification and documentation of historically significant equipment and artifacts; a comprehensive listing of LANL architectural drawings; 11 in. × 17 in. copies of key original and as-built drawings; updated LANL historic building survey forms; a series of construction-history maps of the TA, including a map of the eligible and ineligible buildings; and a detailed use history of the building and technical divisions associated with its operation.

This page intentionally left blank



ACRONYMS AND ABBREVIATIONS

Acronym	Definition
ACHP	Advisory Council on Historic Preservation
ARMCO	American Rolling Mill Company
CMUs	concrete-masonry units
CRMP	A Plan for the Management of the Cultural Heritage at Los Alamos National Laboratory, New Mexico
DOE	Department of Energy
DTA	differential thermal analysis
ESCA	electron spectrometry for chemical analysis
Field Office	U.S. Department of Energy, National Nuclear Security Administration, Los Alamos Field Office
GMX	Explosive Systems and Implosion Dynamics (Laboratory Division)
HMX	high-melting (-point) explosive
LANL	Los Alamos National Laboratory
LASL	Los Alamos Scientific Laboratory
MOA	Memorandum of Agreement
NHPA	National Historic Preservation Act
NNSA	National Nuclear Security Administration
NRHP	National Register of Historic Places
NSWC	Naval Surface Warfare Center
PA	Programmatic Agreement among the U.S. Department of Energy, National Nuclear Security Administration, Los Alamos Field Office, the New Mexico State Historic Preservation Office, and the Advisory Council on Historic Preservation Concerning Management of Historic Properties of Los Alamos National Laboratory, Los Alamos, New Mexico
PBX	plastic-bonded explosive
RDX	Royal Demolition eXplosive
Register	National Register of Historic Places
SHPO	State Historic Preservation Office
S-Site	Sawmill Site
START	Strategic Arms Reduction Treaty
TA	Technical Area
TNT	trinitrotoluene
WWII	World War II

This page intentionally left blank



1 INTRODUCTION

The U.S. Department of Energy, National Nuclear Security Administration, Los Alamos Field Office (Field Office) submits this supplemental cultural resource documentation to the New Mexico State Historic Preservation Officer (SHPO) to resolve the adverse effects from demolishing Building 0460 in Technical Area (TA) 16 and Building 0463 in TA-16 (Figure 1) at Los Alamos National Laboratory (LANL or the Laboratory). The demolition of these buildings occurred in fiscal year 2022. The construction of these buildings was completed in 1952 and 1966 to support analytical chemistry research at the Laboratory.

In an effort to adhere to the LANL Footprint Reduction Program and to be compliant with the National Historic Preservation Act of 1966, as amended (NHPA), buildings TA-16-0460 and TA-16-0463 were evaluated for listing in the National Register of Historic Places (Register) for their association to exceptional significant Cold War events or scientific developments (McGehee et al. 2003). The eligibility of these buildings was concurred upon by the New Mexico State Historic Preservation Office (SHPO). In addition to the eligibility evaluations, it was determined that permanent retention of the historic buildings was not possible, many of the Complex's buildings contained legacy radioactive and chemical contamination making them inoperable. As a result, the Complex was demolished in fiscal year 2022. (Figures 2, 3, and 4).

This report provides documentation as a standard mitigation measure to the adverse effects that occurred by the demolition of these historic properties. To mitigate the adverse effects, LANL has followed Section 106 process contained in 36 CFR 800.6, resolution of adverse effects. In addition to these regulations and within this report, LANL has implemented the standards for documenting and reporting in accordance with the *A Plan for the Management of the Cultural Heritage at Los Alamos National Laboratory, New Mexico* (CRMP), LA-UR-19-21590, formerly LA-UR-15-27624. These standard reporting measures include archival-quality digital photographs of the building's interior, exterior, outside landscape; updating LANL historic building survey forms including 11 in. x 17 in. copies (in a reduced scale) of key original and as-built drawings; identification and documentation of historically significant equipment and artifacts; a comprehensive list of LANL architectural drawings; construction-history maps of TA-16 including current Register Eligible and Ineligible Buildings; and a detailed use history of the building and technical division associated with its operation.

The set of indexed archival photographs is included in Volume 2. Under the CRMP, development of a formal three-party Memorandum of Agreement (MOA) is required to resolve adverse effects to historic properties (i.e., exceptionally significant properties). The Advisory Council on Historic Preservation (ACHP) has chosen not to participate in routine MOAs related to the demolition of historic buildings. The *Programmatic Agreement among the U.S. Department of Energy, National Nuclear Security Administration, Los Alamos Field Office, the New Mexico State Historic Preservation Office, and the Advisory Council on Historic Preservation Concerning Management of Historic Properties of Los Alamos National Laboratory, Los Alamos, New Mexico* Programmatic Agreement (PA) stipulates in Section 10.D.6 that if adverse effect resolution only includes the Field Office and the New Mexico State Preservation Office (SHPO), no MOA is required. However, the Field Office should consult with SHPO in writing to resolve the adverse effects. This report is the result of this resolution to document and record the historic buildings of the Complex.



Figure 1. TA-16-0460 Complex

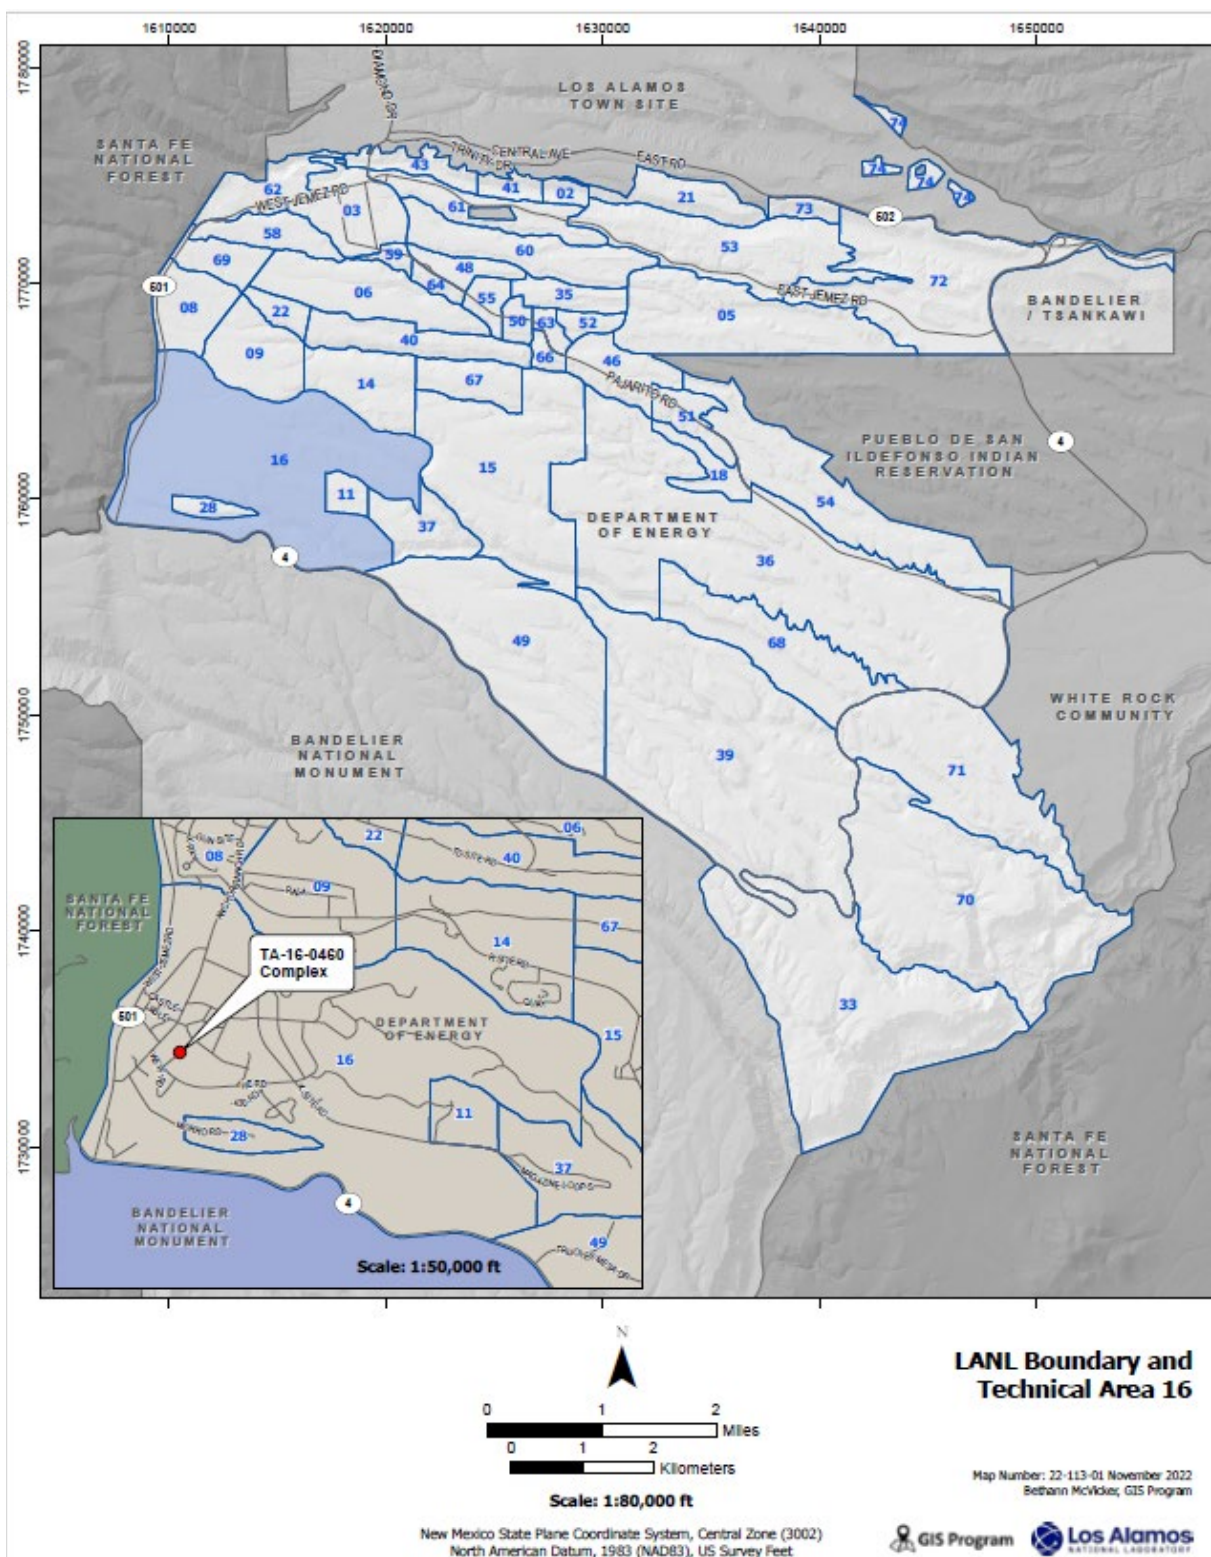


Figure 2. LANL Boundary and Technical Area 16

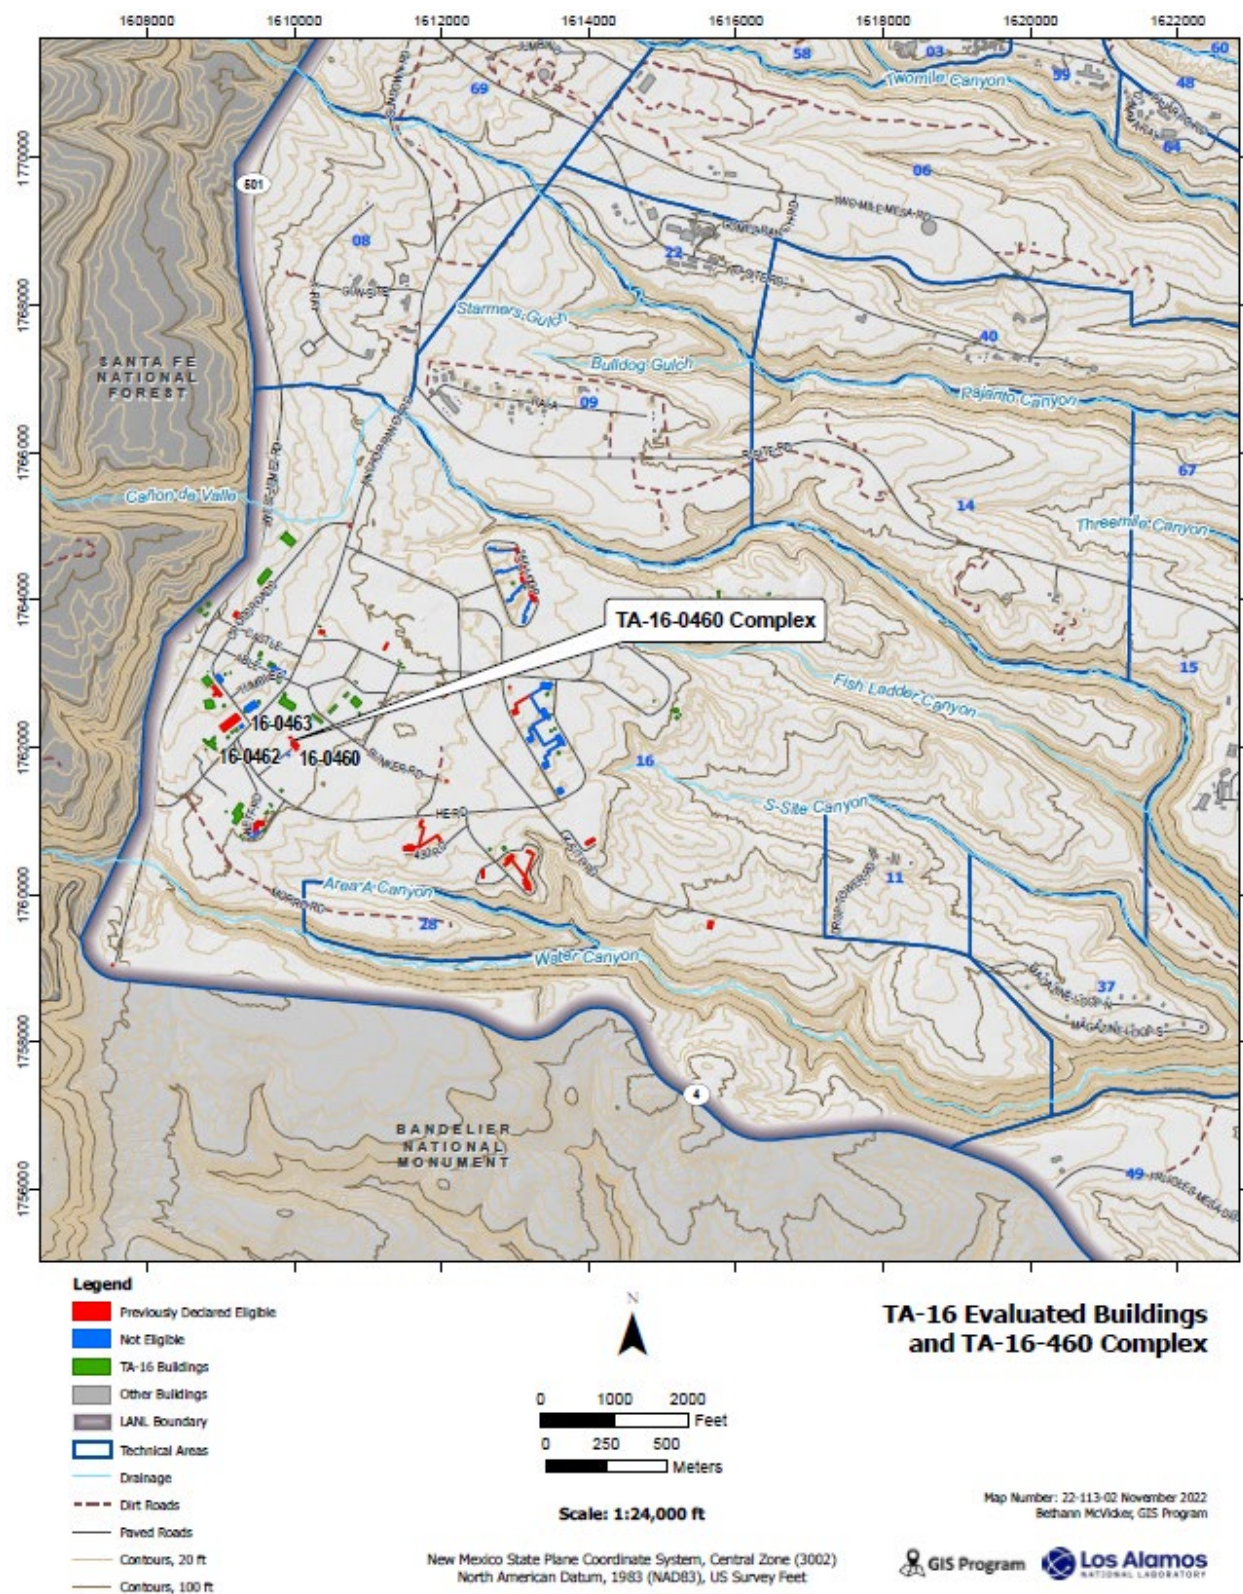


Figure 3. TA-16 Evaluated Buildings and TA-16-460 Complex

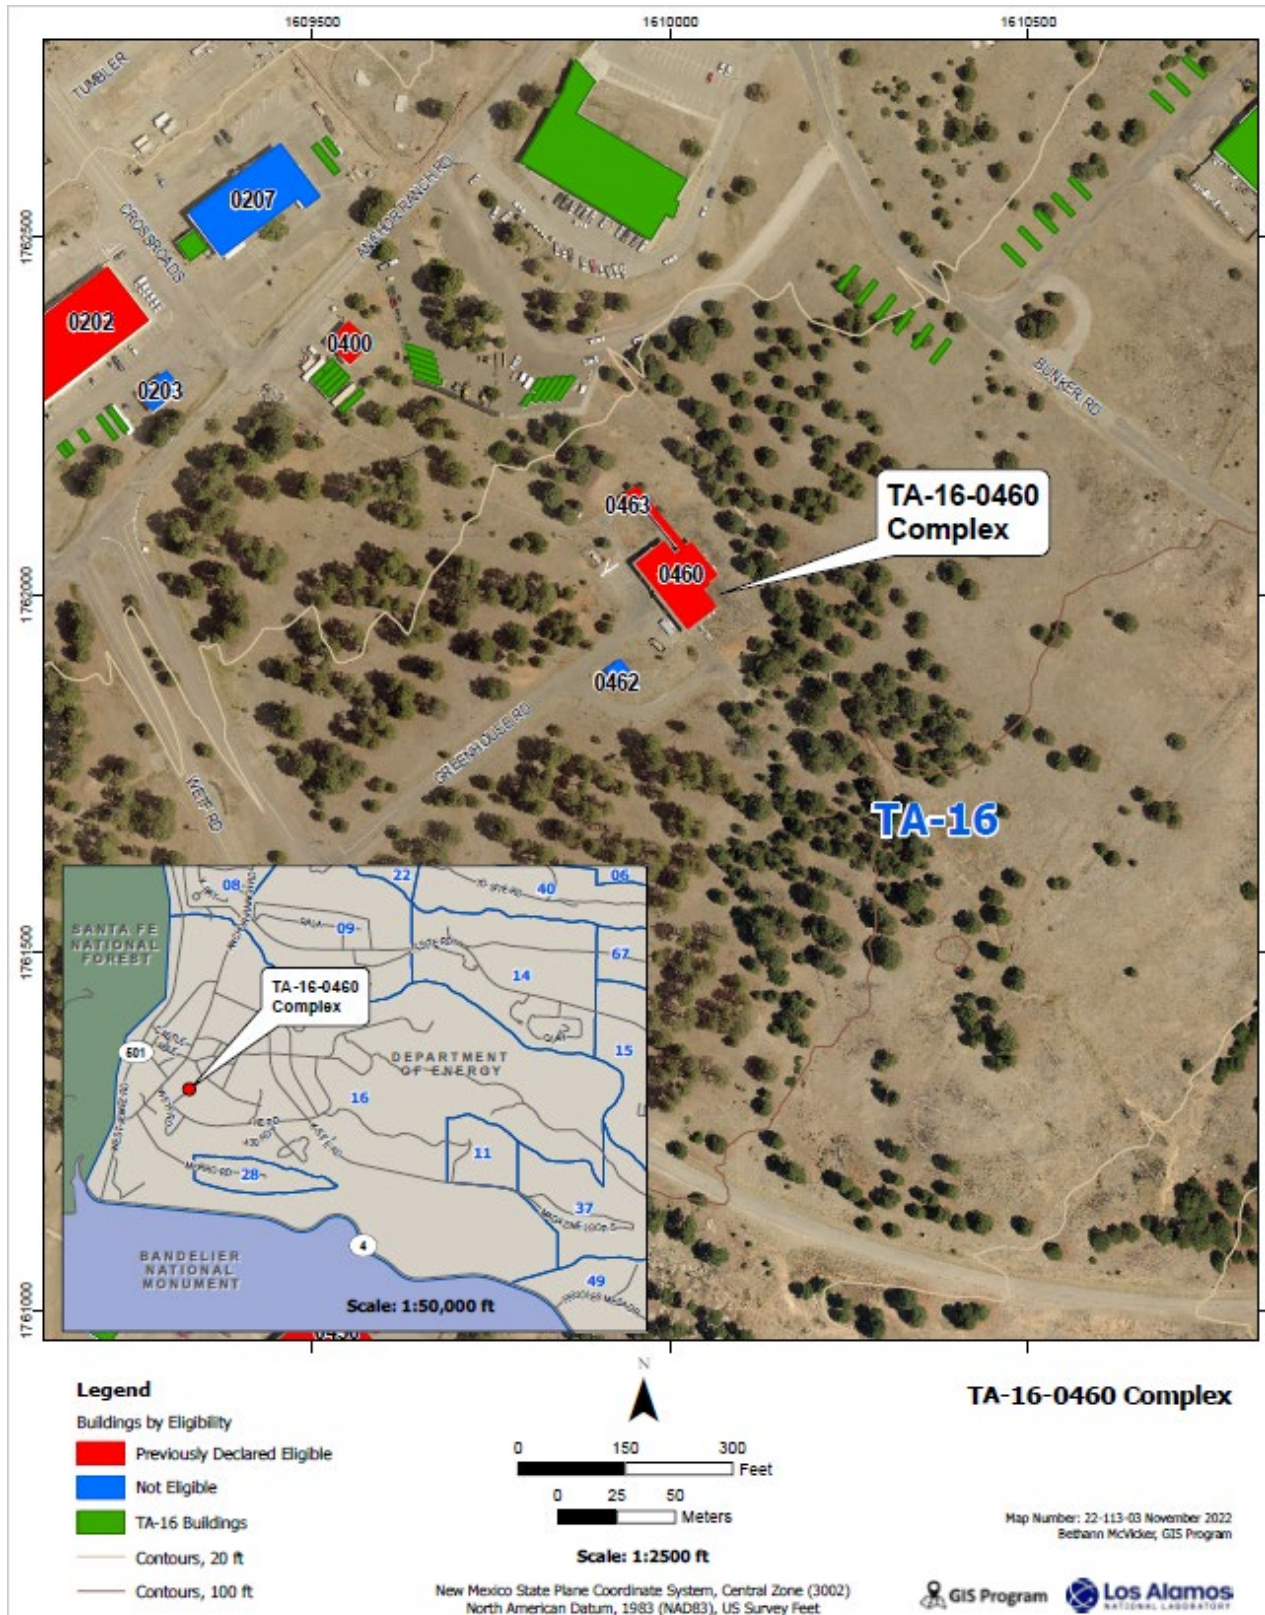


Figure 4. TA-16-460 Complex

Eligibility Determinations

In 1995, the SHPO concurred that Buildings TA-16-0460 and TA-16-0463 were eligible for listing in the Register. This determination was documented in a 1995 report titled *TA-16 Heating System Replacement* (McGehee 1995). Buildings TA-16-0460 and TA-16-0463 were determined eligible for listing in the Register under Criterion A, Criteria Consideration G under Criterion C. Criterion A is defined by properties "...associated with events that have made a significant contribution to the broad patterns of our history" (LANL 2017). Criterion C is defined by properties that "...embody the distinctive characteristics of a type, period, method of construction." (LANL 2017). The eligibility of TA-16-0460 was reaffirmed in 2003 in the *ESA Division's Five-Year Plan: Consolidation and Revitalization at Technical Areas 3, 8, 11, and 16 (LA-UR-02-6841)*. In addition, TA-16-0460 and TA-16-0463 were identified as excess property to be ultimately demolished by the LANL Footprint Reduction Program in fiscal year 2022. Determination of these findings, and corresponding adverse effects, were transmitted by the Field Office to the SHPO in correspondence on April 17, 2019. SHPO's concurrence on both determination of adverse effects and the use of the standard mitigation practices was received May 9, 2019.

Demolition and Adverse Effects

The demolition of these buildings was determined to be an adverse effect under Section 106 of the NHPA.

To mitigate the adverse effects, standard documentation was conducted and includes:

- archival quality digital photographs of the building's interior, exterior, and outside landscape (Volume 2);
- updated LANL historic building survey forms including, in a reduced scale, of 11 in. x 17 in. copies of key original and as-built drawings (Appendix A);
- identification and documentation of historically significant equipment and artifacts (Appendix B);
- a comprehensive list of LANL architectural drawings (Appendix C);
- construction-history maps of TA-16 including current Register Eligible and Ineligible Buildings (Appendix D);
- a detailed use history of the building and technical division associated with its operation and supplemented by oral interviews, when available.



2 HISTORICAL OVERVIEW

Early Cold War Era (1946–1956)

The future of the early Laboratory was in question after the end of World War II (WWII). Many scientists and site workers left Los Alamos and went back to their pre-war lives. Norris Bradbury was appointed director of the Laboratory following J. Robert Oppenheimer's return to his pre-WWII duties. Bradbury felt that the nation needed "a laboratory for research into military applications of nuclear energy" (LANL 1993). In late 1945, General Groves directed Los Alamos personnel to begin stockpiling and developing additional atomic weapons. Post-war weapon assembly work was now tasked to Los Alamos's Z Division, which had been relocated to an air base (now Sandia National Laboratories) in nearby Albuquerque, New Mexico (Gosling 2001).

In 1946, Los Alamos became involved in Operation Crossroads, the first of many atmospheric tests in the Pacific. Later in 1946, the U.S. Atomic Energy Commission was established to act as a civilian steward for the new atomic technology born of WWII. The Commission formally took over the Laboratory in 1947, making a commitment to retain the Laboratory as a permanent weapons facility.

With the beginning of the Cold War in 1947, weapons research once again became a national priority. Weapons research at Los Alamos was spearheaded by Edward Teller and Stanislaw Ulam and focused on the development of the hydrogen bomb, the feasibility of which had been discussed seriously at Los Alamos as early as 1946. The simmering Cold War came to a full boil in late 1949 with the successful test of Joe I, the Soviet Union's first atomic bomb. In January 1950, President Truman approved the development of the hydrogen bomb. Truman's decision led to the remobilization of the country's weapons laboratories and production plants. The year 1950 also marked the initial meeting of Los Alamos's Family Committee, a committee tasked with developing the first two thermonuclear devices (LANL 2001a). In 1951, the Nevada Proving Ground was established and the first Nevada atmospheric test, known as Able, was conducted. In the same year, Laboratory scientists directed Operation Greenhouse in the Pacific and successfully conducted both the first thermonuclear test, known as George, and the first thermonuclear boosted test, Item. In 1952, the first thermonuclear bomb, known as Mike, was detonated at Enewetak Atoll in the Pacific (LANL 1993).¹ The Soviet Union responded with a successful fusion demonstration in August 1953, followed by a test of a hydrogen bomb in 1955. The arms race was on. By 1956, Los Alamos had successfully tested a new generation of high explosives (plastic-bonded explosives) and had begun to make improvements to the primary stage of a nuclear weapon (LANL 2001a).

Although weapons research and development has always played a major role in the history of LANL, between 1942 and 1956 other key research fields were supercomputing advancements, fundamental biomedical and health physics research, high explosives research and development, reactor research and development, pioneering physics research, and the expanding field of high-speed photography (McGehee and Garcia 1999). The Early Cold War era at the Laboratory ended in 1956, a date that marks the completion of all basic nuclear weapons design. Later research at the Laboratory focused on the engineering of nuclear weapons to fit specific delivery systems. The year 1956 was also the last year that Los Alamos was a closed facility—the gates into the Los Alamos townsite came down in 1957.

¹ A better understanding of the Marshall Islands language has permitted a more accurate transliteration of Marshall Island names into English. Enewetak is now the preferred spelling (formerly Eniwetok).

Late Cold War Era (1956–1990)

The Late Cold War era saw the Laboratory's continued support of the atmospheric testing programs in the Pacific and at the Nevada Test Site. In 1957, the first of many underground tests in Nevada was conducted, and in 1963, the Limited Test Ban Treaty was signed, which banned nuclear weapons tests in the atmosphere, oceans, and space (US DOE 2000). Defense mission undertakings during this time included treaty and test ban verification programs such as the satellite detection of nuclear explosions, research and development of space-based weapons, and continued involvement with stockpile stewardship issues. Non-weapons undertakings supported nuclear medicine, genetic studies, National Aeronautics and Space Administration collaborations, superconducting research, contained fusion reaction research, and other types of energy research (McGehee and Garcia 1999).

The Cold War Ends

The Cold War ended in the early 1990s. Its demise was marked by START, the Strategic Arms Reduction Treaty, which was signed by President George H. W. Bush and Soviet President Mikhail Gorbachev, and by President Bush's announcement in September 1991 of a unilateral decision to significantly decrease the U.S. nuclear weapon stockpile. That announcement was followed in June 1992 by an agreement between President Bush and Russian President Boris Yeltsin to reduce each country's nuclear arsenal gradually over the next decade. The arms race that had lasted nearly half a century was over.

The last underground nuclear test conducted by the United States occurred in 1992. Because international treaties and presidential moratoriums restricted the testing of nuclear weapons, Laboratory scientists needed to devise new methods of ensuring the safety and reliability of the nation's nuclear stockpile. Since 1992, the Laboratory has developed sophisticated methods of analyzing the viability of weapons in what is now known as the stockpile stewardship program (Machen et al. 2010).



3 TECHNICAL AREA DESCRIPTION

TA-16 Historical Background

The Ramón Vigil Grant

In 1742, the lands that encompass the present-day Sawmill Site (S-Site) were part of a Spanish land grant given to Pedro Sánchez. These lands remained within the Sánchez family for more than one hundred years (Foxy 2002; Machen et al. 2012). In 1860, the U.S. Congress confirmed the title for most of the original Sánchez Grant site to José Ramón Vigil (Hoard 2006). Between 1860 and 1934, the Ramón Vigil Grant would pass through no fewer than five titleholders before the land was sold to the Soil Conservation Service (Machen et al. 2012).

The Buckman's S-Site and Railway Station

In 1897, the owners of the Ramón Vigil Grant sold their timber rights to H. S. Buckman, who removed lumber from the area until 1903. His contract allowed him to cut all trees greater than eight inches in diameter. To transport lumber from the Pajarito Plateau to the railroad line that ran along the Rio Grande, Buckman not only built a road from the sawmill at S-Site to the river but also built the town of Buckman, which served as the railway station (Foxy 2002). S-Site was named for a large pile of sawdust found in the area during the beginning of the Laboratory's use during the Manhattan Project. This sawdust was the only remnant of a nearby sawmill operation from the late 19th century (Figure 5).

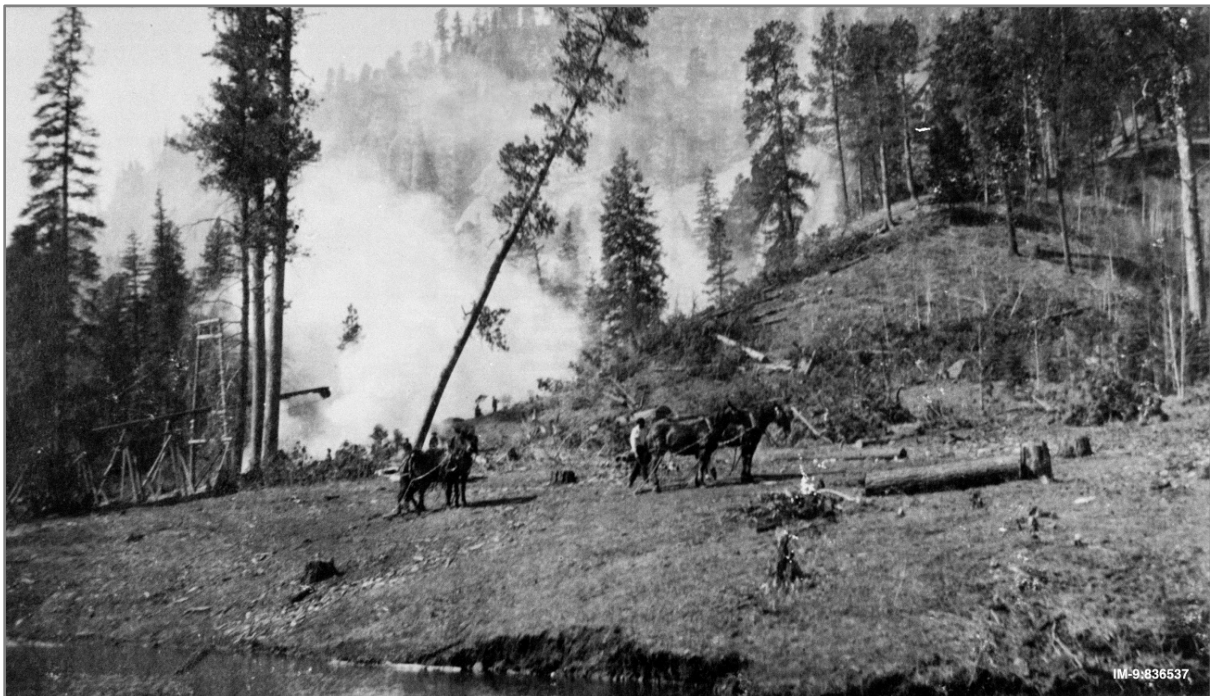


Figure 5. Logging activities directly west of S-Site

World War II and the Los Alamos Laboratory “Project Y”

During World War II (WWII), the Laboratory was also known as “Project Y.” This secret laboratory was established by the Manhattan Project and was operated by University of California. At the height of the Manhattan Project, scientists at the Laboratory realized that plutonium was not suitable for assembly in a gun-type weapon, forcing the development of the implosion detonation concept. With the implosion method eventually used in the “Fat Man” weapon, high explosives were detonated to compress a plutonium “pit.” Though theoretically feasible, the complexities of implosion demanded extensive testing and experimentation in diverse technical fields. Solving the implosion problem not only involved understanding the properties of plutonium but also required solving problems regarding the formulation and casting of high explosives (Hurd and Schaefer 2006).

The Sawmill Site (S-Site) at TA-16 is located along the southwestern corner of Los Alamos National Laboratory. Between December 1943 and May 1944, explosives systems for the implosion bomb were developed and tested there. This technical area, established during the Second World War, supported explosive research and development activities for the “Trinity” device and the “Fat Man” plutonium implosion weapons (Machen et al. 2020; McGehee et al. 2003). S-Site would be the principal location for the manufacture of high explosive castings and lenses necessary to produce a spherical implosion (McGehee et al. 2003). In a letter dated Aug. 14, 1944, the Explosive Division was formally organized and documented. (Figure 6) (LANL 1993). It was at S-Site that many challenging scientific and engineering problems in high explosives were tackled. From laboratories and processing facilities scattered throughout the landscape of S-Site, high explosive components of the implosion design were developed, manufactured, and tested. The fundamental problem was how to achieve a perfectly symmetrical implosion; the shock wave created by detonating high explosives had to compress a sphere of plutonium uniformly. The solution was to use explosives cast in a series of geometric shapes, called lenses, to focus the shock wave uniformly. These lenses would be ignited by a series of detonators fired simultaneously around the entire sphere of high explosives (McGehee et al. 2003).

Another major problem facing the scientists working with high explosives was the lack of existing methods for casting high explosives. The military’s standards for explosives performance were well below what was needed to develop a symmetrical implosion, prompting the scientists of Project Y to develop new high explosive formulations and processing techniques. Thus, the development of high explosives at S-Site became one of Project Y’s most important wartime tasks. Because of the need for hundreds of lenses, both for proof testing and for any combat units, a multi-building casting facility was built at S-Site to produce lenses from a molten slurry of high explosives into precise shapes. Other early S-Site facilities included an office building, a steam plant, storage magazines, and high explosives preparation buildings. Because of construction delays and difficulty procuring equipment, TA-16 operations in May 1944 were limited, and steady operations didn’t start until August of the same year (McGehee et al. 2003).

The development of diverse and complex engineering methods relating to detonator, initiator, and high explosives research was a major accomplishment for the wartime Laboratory. Numerous technical problems experienced during early processing operations were eventually overcome, with facilities at S-Site (Figure 7) producing about 20,000 usable castings over an eighteen-month period. By its wartime peak, S-Site would use over 100,000 pounds of high explosives per month. Several types of explosive materials were used in the casting process, such as Composition B (TNT combined with British-invented Royal Demolition eXplosive [RDX]), torpex, pentolite, baronal, and baratol (LANL 2000; McGehee et al. 2003).

THIS DOCUMENT CONTAINS 2 PAGES
NO. 4 OF 6 COPIES, SERIES A

VERIFIED UNCLASSIFIED
PUBLICLY RELEASABLE
LANL Classification Group
12/1/77 G. B. Kistiakowsky
J. R. Oppenheimer
Organization of Explosives Division

SECRET
August 14, 1944
11/3/85

UNCLASSIFIED CLASSIFICATION CANCELLED
PER DOC REVIEW JAN. 1973

In order to put in writing the results of our discussions of the last few days I would like to formulate as follows the functions of the Explosives Division of which you are assuming the direction.

1. To investigate promising explosives, methods of initiation, boosting, detonation, etc. for implosion.
2. To develop methods for improving the quality of castings.
3. To develop lense systems and methods for fabricating and testing them.
4. To develop a suitable engineering design for the assembly of the explosives and of the initiating systems to be used with them in an actual gadget.
5. To cooperate closely with the Gadget Division in providing the necessary charges for their investigations.

It should be clearly appreciated by you that you are responsible for the specification and the initiation of design of those parts of the final gadget which fall within the directive outlined above, as well of course as for the developmental equipment involved in your program. In so far as such designs involve the final gadget or involve items to be fabricated away from the Site, it is requested that these designs and specifications be checked with the engineering group, E-6, at the earliest possible moment in their development. You are of course free to consult E-6 on any other problems where you may wish to have their help.

The carrying out of the fundamental work on implosion gadgets is the joint responsibility of the explosives division and the gadget division under Dr. Bacher. It is clear that this arrangement can only be successful if it is based upon the most careful collaboration of the two divisions. In particular you will in general find it necessary to share jurisdiction over sites, facilities, equipment and in some cases personnel

UNCLASSIFIED

FINAL DISSEMINATION
UNCLASSIFIED
L. M. Redmon
NOV 18 1980

VERIFIED UNCLASSIFIED
LMR NOV 18 1980
ok *WJR*

SECRET

Information concerning this information affecting the national defense of the United States within the meaning of the espionage laws, Title 18, U.S.C., 793 and 794, the transmission or the revelation of its contents in any manner to an unauthorized person is prohibited by law.

Figure 6. 1944 document (page 1) establishing the new explosives division



Figure 7. Project Y high explosives facilities at S-Site

Cold War Laboratory Expansion

During the Cold War, the Laboratory scientists designed new weapons that were smaller, lighter, and more efficient than the original Fat Man implosion bomb. Between 1945 and 1956, the diameter of a nuclear weapon's primary stage decreased by more than a factor of three and weight decreased by more than a factor of thirty (Machen et al. 2010). The savings in weight and volume in early Cold War nuclear weapons were the result of a remarkable set of improvements that occurred in the physics, design, and engineering of the primary stage. These new weapons were adapted to meet the requirements of new delivery vehicles, such as missiles. Laboratory scientists provided both the theory and the applied science behind the development of explosives for these new designs. To test new high explosives and detonation systems, S-Site greatly increased its staff, capabilities, and capacity (LANL 2006; Mitchell 2003).

The bulk of the postwar U.S. Nuclear Weapon Complex was constructed during the administration of President Harry Truman, with three notable expansions between 1949 and 1952, in response to the growing Cold War arms race between the USSR and the U.S. During this early competition with the USSR, Truman directed the Nuclear Weapon Complexes to pursue the development of a thermonuclear bomb. In response, the largest construction project in peacetime history ensued as wartime national laboratories in Hanford, Oak Ridge, and Los Alamos were expanded to produce special nuclear materials and new nuclear weapons.

During the Cold War era, the task of laboratory scientists and S-Site personnel was to research and develop new weapons designs. To accomplish this task, S-Site employees worked around the clock under a rigorous schedule of three shifts a day, seven days a week. Though operations were carried out under strict postwar safety standards, S-Site suffered its only fatal high explosive accidents during this period. In February 1959, two machinists were killed while machining explosives. Seven months later, in

September, four men died while disposing of high explosives that unexpectedly detonated. As a result of the two accidents in 1959, all operations involving explosives at the Laboratory were shut down for several months until new health and safety regulations could be implemented (Machen 2008a, 2008b; Machen et al. n.d.).

To keep up with the demands of explosives research, the Laboratory continually upgraded its high explosive processing capabilities throughout TA-16. Ultimately, the facilities at TA-16 totaled seventy-eight buildings with over 280,000 square feet of space (Figure 8). With its around-the-clock operations, S-Site supported large-scale formulations of high explosives and their casting, pressing, machining, and assembly; mechanical and safety testing; and an extensive range of quality assurance operations. S-Site also received, stored, packaged, and transported high explosives for the entire laboratory (LANL 2001b).

TA-16 Historical Themes

Reduction, Consolidation, and Stockpile Stewardship at the Laboratory

The rapid expansion by the entire Nuclear Weapon Complex in 1946 began a slow and steady decrease by the 1960s. By 1965, President Johnson had decided to reduce production of plutonium and highly enriched uranium. In 1992, during the waning days of the Cold War, the United States declared a moratorium on further nuclear weapons tests. In response to the unilateral test moratorium, Laboratory scientists turn to alternative methods of assuring that the nation's nuclear weapons will work as designed as they continue to age. Scientists use a blend of physics, chemistry, metallurgy, hydrodynamics, and computer science to simulate the reliability of the weapons. These methods are collectively known as stockpile stewardship (Machen 2008b; Mitchell 2003).



Figure 8. Cold War Era S-Site at TA-16, 1991

While experimentalists and defense customers still need high explosive components for experimental applications and military needs, the end of the Cold War meant that the dispersal of large manufacturing facilities at S-Site were no longer cost effective. Many 1950s-vintage buildings used in high explosive operations have high maintenance costs and were nearing the end of their useful lives. Some facilities have been decommissioned, and major operations have been reconsolidated. Capabilities have been modernized by the integration of new technologies, while floor space has been significantly reduced (LANL 2003). Yet S-Site's role remains unchanged. Its staff continues to support national security by manufacturing high explosives for continuing research into energetic materials and for the Laboratory's stockpile stewardship mission.

Following the end of the Second World War, and throughout the Cold War era, this technical area has supported a wide variety of high explosives operations including casting, pressing, machining, assembly, safety testing, and quality assurance. TA-16 also supports tritium handling, packaging, research, and analysis activities (MacRoberts n.d. and LANL 1993).

Processing and Testing High Explosives

Historically, the Laboratory's high explosives processing operations were conducted in buildings that were physically separated and divided by their functions (Figure 9). Processing activities of high explosive components for nuclear weapons research consists primarily of manufacturing and assembly operations, as well as science-based Stockpile Stewardship Program tests and experiments.

Capabilities at TA-16 include various highly specialized assembly, machining, inspection, and transportation activities. High explosives casting, inert-materials processing, and plastics operations at S-Site are used to produce explosive components for a variety of display and testing purposes. At S-Site inspection facilities, explosives obtained from commercial vendors are examined upon arrival. In preparation facilities, high explosives are readied for various uses including the coating of high explosive granules with plastics. In the plastics areas, components made of energetic and inert materials are fabricated to simulate nuclear weapons assemblies. Metal forming, a historical operation of S-Site that is now performed infrequently, takes place in a separate facility (Machen 2007).

For safety reasons, high explosives pressing operations at S-Site are conducted in locations that are physically isolated from other processing facilities. Explosives are delivered to these facilities for processing into shapes that can be precisely machined as necessary. During pressing operations, high explosive material in plastic-coated granular form is placed into molds and subjected to very high pressures. This process produces solid pieces of high explosives in various dimensions.

In machining facilities, rough pressings or castings of high explosives are machined into hemispherical shapes or test charges using a combination of computer-controlled mills and lathes. High explosives machining is conducted using water as a coolant, and each machine is provided with a re-circulating water treatment and cooling system. In inspection facilities, radiography by X-rays is used as part of the inspection process to determine the presence of flaws in cast, pressed, and machined high explosives.



Figure 9. S-Site (TA-16), TA-16-0460 Complex (foreground), 1991

Once a high explosive is no longer useful at S-Site, the materials are demilitarized—disposed by a number of methods onsite. Some high explosives are disposed by detonation, while others are burned. Most importantly, each process is conducted under strict safety regulations.

Strategic and Supporting Research

Throughout the Cold War, the Laboratory's strategic and supporting research provided critical capabilities to support the Laboratory's core responsibilities to the nation's nuclear weapons complex. Besides augmenting the areas of weapon physics, weapon engineering, and threat reduction, this type of scientific work has contributed a broad spectrum of high quality, basic research that added to the national and international scientific knowledge base (Machen et al. 2010).

Earth and Environmental Sciences

Scientists from Los Alamos have contributed towards a fundamental understanding of the geological processes that have shaped our planet. The Laboratory has been a key contributor to basic research on the surface and interiors of the earth (and other planets as well). During the Cold War era, Los Alamos

3 Technical Area Description

scientists studied plate tectonics, the composition and state of the earth's deep interior, geomagnetism and electromagnetics, and heat convection through the earth's interior (Machen et al. 2010).

At Los Alamos between 1956 and 2006, geophysical methods and tools were applied to societal issues as well; these have ranged from oil exploration to earthquake hazards to national defense.

For example, as global oil exploration began to take place in regions in which resources were difficult to locate and characterize because of the complexity of the geology overlying the resource, geologists needed better methods to characterize earth structures, as well as less invasive and more cost-effective drilling methods (Machen et al. 2010).

Materials Science

Materials science covers an extraordinarily wide variety of work, all based on developing an understanding of, and controlling, the complexity of materials. From the beginning years of the Laboratory, scientists were in the business of processing new materials for technological needs because the very nature of building an atomic weapon required new materials and new technologies. A nuclear weapon releases so much energy so rapidly that materials act more like fluids rather than solids. To deal with the unique materials used in nuclear weapons, such as actinides, special ceramics, polymers, and so forth, Los Alamos scientists not only had to develop significant expertise in materials research but also needed to develop expertise on how materials behave (Machen et al. 2010).

Analytical Chemistry at TA-16-0460

Although the origin of the art and science of explosives has a very old history, approximately 95% of the science of explosives and propellants was accomplished after 1943 (Smith 1979). This is because the science of military high explosives did not begin until the late nineteenth and early twentieth centuries. (Smith 1979). During this time, numerous explosive compounds were discovered, and the basic understanding of detonation was developed (Smith 1979). These advancements were the result of the concurrent development of instrumentation with sub-microsecond time resolution, including high-speed cameras and electronic recording equipment at Los Alamos (Smith 1979).

The 1940s and early 1950s also witnessed great strides in the development of new explosive formulations and tailoring these formulations to specific applications (Smith 1979). This included the introduction of the explosive compounds of Royal Demolition eXplosive (RDX) and high-melting (-point) explosive (HMX); the use of powdered aluminum in underwater explosives; and the development of plastic-bonded explosives (PBX) at Los Alamos (Smith 1979). Notably, nearly all high-explosive formulations used during the Manhattan Project were replaced with newer, safer, and more effective compositions (Smith 1979).

Variations in the composition of chemicals affect their stability, sensitivity, ignitability and efficiency of performance (Yinon & Hoffsommer 2008). The analytical chemistry laboratory at TA-16-0460 was used to conduct research into the purity, quality, and stability of high explosive compounds that were used for laboratory testing (Yinon & Hoffsommer 2008). This research was conducted using diverse methods such as chemistry and mass spectroscopy, mechanical shock loading, and exposure to thermal stress (Yinon & Hoffsommer 2008).

Chemical testing and mass spectroscopy were used to examine variations in chemical compositions that could affect the stability, sensitivity, ignitability, and efficiency of performance of high explosives (Yinon & Hoffsommer 2008). Mechanical testing and shock loading involved physically manipulating high explosives in a nonideal manner, such as subjecting components to blunt-force impacts (Yinon &

Hoffsommer 2008). And thermal testing uses measures of heat and time to examine the performance of high explosives under extreme heat regimes (Yinon & Hoffsommer 2008).

In the late 1950s, William Rogers, with the assistance of Los Alamos Scientific Laboratory (LASL)—the previous name of LANL—personnel in the GMX Division, investigated the thermal stability of insensitive high explosive molding powder at 100 and 120 degrees Celsius to understand its behavior under various conditions of storage and use (Rogers & Smith 1972). Many high explosives often had to be stored in units that saw a drastic fluctuation in temperatures from extreme heat to cold, which made it crucial to understand how they would respond. The study found that the density and compressive strength decreased, and the impact sensitivity and vacuum thermal stability remained unchanged (Rogers & Smith 1972).

In the early 1960s, a GMX research group affiliated with the Naval Surface Warfare Center (NSWC) started a program on thermally stable explosives (Smith 1979). This program led to the discovery/development of various plastic bonded and insensitive high explosives. Despite initial promising results, the program experienced issues with funding, and the research program ceased operations by the end of the decade (Smith 1979).

In the late Cold War era, the state of high explosive analytical chemistry progressed rapidly. By the 1970s, computational models for simulating shockwaves began to match experimental results, representing a significant advancement in high explosive research. While computational models improved rapidly, a great deal of research concerning high explosive mechanical properties was still needed. Although many problems relating to mechanical and chemical stability remained doggedly challenging to the scientists of Los Alamos, the research program of the analytical chemistry laboratory had made revolutionary strides in developing instrumentation to tackle these problems (Smith 1979).

One of the most crucial research programs facing the analytical chemistry laboratory centered on understanding the fundamentals of high explosive sensitivity. The ability to determine the amount of time and the temperatures that will inadvertently ignite high explosive compounds was of particular interest. Since high explosives are a fundamental component of nuclear weapon systems, it was vital for the laboratory to establish consistent temperature boundaries during all phases of high explosive handling from manufacture and storage to delivery (Popolato et al. 1979). Additionally, after Los Alamos experienced a series of high-explosive fatalities in the late 1950s, understanding the thermal stability of new high explosive compounds was also fundamentally important from the standpoint of occupational safety (Popolato et al. 1979).

Differential thermal analysis (DTA) was one of a series of fundamental improvements in understanding the properties of high explosives. An analytical tool used to determine thermal transitions in a wide variety of high explosive compositions, the analytical chemistry laboratory produced a series of thermograms (physical records of tracking the thermal change) of small samples of high explosives. These DTA thermograms would be used to establish new safety thresholds for high explosive compounds used in the nuclear weapons complex (Dubiel & Bayton 1963).

By 1979, researchers from GMX division were able to determine reproducible ignition times and temperatures for nearly all of the explosives used by the laboratory (Popolato et al. 1979). While a few plastic-bonded explosive compounds eluded the researchers at the time, their work in thermal analysis helped to establish more accurate computer simulations of high-explosive performance. The result would be a new reactive heat-transfer computer program, EXPLO, written to calculate the temperature and ignition as a result of this research. (Popolato et al. 1979).

3 Technical Area Description

Outside of the realm of thermal research, the study of insults (mechanical damage) to high explosive compounds was a major component of the research program at TA-16-0460. To paraphrase from GMX division's research staff, investigating the impact of mechanical damage on a high explosive compound is exceedingly complex because the sensitivity is not simply constrained to an explosive's chemical composition (Smith 1977). The sensitivity is also affected by physical and mechanical details, such as the size and shape of high explosive crystals. Because physical and mechanical features can vary between batches of high explosive compounds, measurements of sensitivity are irreproducible (Smith 1977). However, despite these challenges, the scientists of GMX did attempt to develop a mechanical explosives hazard scale, albeit with largely unsuccessful results (Smith 1977).

Despite the unsuccessful attempts to construct a hazard scale, scientists from GMX division sought to explore new and innovative methods of high explosive forensics. In 1980, a research group sought to determine whether explosives could be identified by sampling gases and residues left behind after a detonation in a highly confined area (Stine et al. 1981). After the detonation, the residues were analyzed by electron spectrometry for chemical analysis (ESCA) while the gases were analyzed using mass spectrometry. (Stine et al. 1981). The study found that because of the oxidizing/reducing effects from mixing with surrounding materials and air, neither gases nor residues could indicate the type of explosive that had survived the explosion. (Stine et al. 1981).



4 DESCRIPTION OF BUILDINGS TA-16-0460 AND TA-16-0463

Early Laboratory Architecture Style

During the Cold War era, architectural designs began emerging to meet the technical and scientific requirements of the Laboratory. Highly technical and scientific facilities commonly housed specific machines and equipment resulting in a one-of-a-kind or first-of-a-kind facilities. Such facilities were associated with man's first ventures into space, the discovery of nuclear fission, the development of computers and artificial intelligence, and genetic engineering. America's scientific and technical facilities stand as monuments to the Nation's ability to invent and exploit new technology, as well as advancing scientific and engineering knowledge (ACHP 2017; Brown et al. 2019).

Historically, significant scientific and technological facilities and structures are those that meet the criteria for inclusion in the National Register of Historic Places (NRHP) or that qualify for designation as National Historic Landmarks for the contributions they made, the role they played, or breakthroughs they were associated with in American science, technology, and industry. Significant scientific and technological structures could include the equipment itself or the facility where it was used and/or built.

Laboratory facilities were typically designed from the inside out to support the specific shape and size of the equipment that would be housed and operated within them. Characteristics of these historic facilities are defined by equipment, programs, or processes, and not by codified characteristics of a formal architecture style. While the TA-16-0460 Complex does not fit into any specific modern style, it does adhere to one of the primary attributes of 20th century modern architecture—form follows function. The high explosive manufacturing process dictated the style and materials for the utilitarian designed structures within TA-16. Heavily reinforced concrete was the primary construction material used because of its inherent security, durability, and ability to be cleaned (McGehee et al. 2003). Likewise, the interior materials for facilities in TA-16 were often chosen to address specific industrial processes or hazards; interior walls were often constructed with structural glazed tile as it is easily washable, and floors were covered with non-spark conductive material (McGehee et al. 2003).

Another characteristic of 20th century modern architecture that finds expression in the TA-16-0460 Complex and similar facilities is the concept that materials used in construction are meant to be seen and appreciated for what they are without being deliberately obscured. The construction of the buildings within the Complex, and its layout within TA-16, is directly related to its operational use. To facilitate the safe transport of materials to TA-16-0460, corridors were designed with multiple turns to reduce the direct blast path if the explosives stored in the rest houses exploded (Machen et al. n.d.). In addition, the spacing of the buildings within the Complex would, in the event of an explosion, direct blast energy away from surrounding buildings (McGehee et al. 2003).

Laboratory-processing buildings, such as the TA-16-0460 Complex, are representative of the “industrial vernacular” architectural style prevalent at all TAs in Los Alamos (McGehee et al. 2003). Although the industrial architecture style, known as industrial vernacular, does not completely capture the essence of these facilities, it has proven adequate in its description of the general characteristics of Cold War era construction throughout Los Alamos. It has been suggested that the industrial architecture movement with its systematic study of material evidence associated with the industrial past, including sites and structures of immense scale and unique structural expression from our technological past, could include these types of highly scientific facilities (Miller 2016). However, until a new architectural style has been defined to capture the highly technical and scientific facilities of the late 20th and early 21st century, facilities within

the Laboratory—such as the TA-16-0460 Complex—will continue to be described under the industrial vernacular nomenclature (Brown et al. 2019).

Building TA-16-0460



Figure 10. TA-16-0460, facing northeast.

Building TA-16-0460, a laboratory and high explosive processing building, was constructed during the Cold War in 1952 to support analytical high explosive chemistry. The building's construction began on June 19, 1951, and was completed on December 29, 1952, for a total cost of \$448,146.85. (ERID-252858).

Contractor: Vinson Construction Company

Architect: Black & Veatch: Kansas City, Missouri

After graduating from the University of Kansas, Ernest Bateman (E. B.) Black and Nathan Thomas (N. T.) Veatch founded Black & Veatch in 1915. The company eventually grew to become one of the world's most successful engineering, procurement, consulting, and construction companies. Surviving the Great Depression, the company started to thrive beginning in 1935. This growth continued between 1945 and 1955, and the “incoming tidal wave of business” initially proved challenging after the death of E. B. Black in 1949. The Manhattan Project's demand for engineering and construction services was a major contributor to this new business as the firm's “history of reliable service encompasses the Federal government's most significant programs” (Black & Veatch Consulting Engineers n.d.). This includes the

construction of multiple buildings within the Laboratory, including TA-16-0460 and TA-16-0463, with the intent to support specific operations of the early Cold War era.

Architectural Description

TA-16-0460 was a one-story, high-bay building with a mezzanine and a partial basement located at the end of Greenhouse Road in the southwest portion of the Laboratory. T-shaped in plan, it measured approximately 116 by 77 feet, encompassed approximately 11,294 square feet, and was oriented northwest by southeast. The facility was constructed into a small rise in the landscape. Built on a hardened concrete foundation, the building was constructed of poured-in-place reinforced concrete and concrete-masonry units (CMUs). Exterior wall materials included unpainted smooth-finished concrete with expansion joints and insulated aluminum panels. The southern end of the building featured a poured concrete retaining wall that safeguarded ground-level access to the basement. Several pieces of mechanical equipment were located on the exterior of the building at ground level and penetrated the walls connecting to their interior elements. This included an air intake unit on the northeast façade that was housed in corrugated metal-panels with a shed roof and a metal-framed louvered vent, and another piece of mechanical equipment housed in a poured-concrete-panel box. The exterior also featured a few small and large metal-framed louvered vents, exterior lights, alarms, conduit lines, and signs. Interior walls were constructed of poured-in-place concrete, CMUs, metal partitions, and aluminum panels.

The roof was constructed of poured concrete and clad in a built-up material. Nearly flat, the roof had numerous low-pitched, hipped areas to promote water runoff. The building featured a wide, overhanging closed concrete eave on all façades. Three large exhaust vents penetrated the eave and extended above the roofline. The roof also exhibited additional smaller vents and a lightening protection system.

The main entrance was located on the southwest façade through paired, metal-panel personnel doors accessed by concrete stairs with pipe-metal railings. On the southeast elevation, the first floor had a wide single, metal-panel personnel door accessed by concrete stairs that sat atop the retaining wall and a floating concrete walkway with pipe-metal railings. Below the walkway were a set of wide paired, metal-panel doors with louvered vents that provided access to the basement. The northwest elevation had a single, metal-panel personnel door accessed by concrete stairs with metal-pipe railings. The building's fenestration consisted of a single set and numerous bands of glass-block windows interspersed with concrete panels. Twenty-one of the windows were made up of 24 glass blocks (6 by 4) and 2 windows were made up of 16 glass blocks (4 by 4). Fifteen of these 21 windows were located on the main façade above the main entrance.

Black & Veatch completed drawings for TA-16-0460 in March 1951. Vinson Construction Company completed the building by 1953, and it served as an analytical high-explosives chemistry facility. Since the building's original construction, the Laboratory added mechanical equipment on the exterior of the building; changed out flat metal-framed louvered vents for those that extend above the roofline; constructed two mechanical equipment enclosures on the northeast elevation; replaced the roofing material; and built a connecting and enclosed walkway (TA-16-0461) to TA-16-0463 on the northwest elevation. TA-16-0460 had structural integrity, and the exterior was in good condition. Its architectural design was influenced by the International Modernist architectural style, and character-defining features included geometrical massing, lack of ornamentation, flat roof, continuous surface planes, bands of windows, and unornamented doors and windows.

Building TA-16-0463



Figure 11. TA-16-0463, facing northeast.

Building TA-16-0463, a laboratory high explosive rest house, was constructed in 1966, during the Cold War, to support analytical high explosive chemistry.

Contractor: The Zia Co.

Architect: Los Alamos Scientific Laboratory Engineering Department

Architectural Description

TA-16-0463 was a one-story building located at the end of Greenhouse Road in the southwest portion of the Laboratory. Rectangular-in-plan, it measured 14 feet 8 inches by 24 feet 8 inches, encompassed approximately 169 square feet, and was oriented northeast by southwest. Built on a 3-foot-high poured-in-place reinforced concrete foundation, the walls were constructed of CMUs. The nearly flat roof was constructed of steel joists atop a bond beam and was clad in fiber-strand boards. The southwest façade featured a deeply inset dock accessed by concrete stairs with metal-pipe railings. Adjacent to the stairs in the exterior of the foundation were dock bumpers. Access into the building from the dock was provided by paired, metal-panel personnel doors. The northwest façade featured a single, metal-panel personnel door. On its northeast end, the facility was connected to facility TA-16-0461, a covered passageway. The southeast side of the building features an adjacent and earthen-filled ARMCO metal bin.

The Laboratory completed drawings for TA-16-0463, a high-explosives storage facility, in June 1966. TA-16-0463 had structural integrity, and the exterior was in fair condition. Its architectural design was influenced by the International Modernist architectural style, and character-defining features included geometrical massing, lack of ornamentation, flat roof, continuous surface planes, and unornamented doors.

This page intentionally left blank



5 CONCLUSION

In compliance with Section 106 of the National Historic Preservation Act of 1966, as amended, this report fulfills the reporting requirements to resolve adverse effects associated with demolition activities that are identified in Appendix D.2 (B): *Demolition and Major Remodeling Requirements* from the PA among the DOE, NNSA, Los Alamos Field Office, the New Mexico SHPO, and the Advisory Council on Historic Preservation Concerning Management of the Properties at Los Alamos National Laboratory, Los Alamos, New Mexico, August 2, 2017.

This page intentionally left blank



6 REFERENCES CITED

- ACHP, Advisory Council on Historic Preservation
2017 Consideration of Highly Technical and Scientific Facilities in Section 106 Review, Washington, DC.
- Aldrich, Linda
2013 Zia Company 1946-1986. Electronic document, New Mexico History <http://newmexicohistory.org/2013/11/19/zia-company-1946-1986/>, accessed December 16, 2019.
- Bare, C. M., Foxx, Teralene S., & Los Alamos National Laboratory.
2003 *Roadside Ecology of the Pajarito Plateau and Jemez Mountains: A Real or Virtual Tour*. LA-UR-02-3834.
- Benegas, Diane (editor)
1995 Los Alamos National Laboratory: A Proud Past, an Exciting Future. In *Dateline Los Alamos*, Special Issue: 1-48. Public Affairs Office, Los Alamos National Laboratory, New Mexico. LALP-95-2-6&7.
2000 Maintaining a High-Explosives Capability. In *Dateline: Los Alamos*, December: 7-10. Public Affairs Office, Los Alamos National Laboratory, New Mexico. LALP 00-1-12.
- Black & Veatch Consulting Engineers
n.d. Black & Veatch History. Electronic document, <https://www.bv.com/company/history>, accessed July 2019.
- Brown, Charlene B., Kari L. M. Garcia, Cameron D. Townsend, and Elliot M. Schultz
2019 *Historic Documentation of TA-3-0016 Smashing Atoms & Modern Physics at the Ion Beam Facility Volume 1*. Cultural Resources Report No. 376, LA-UR-18-30885. Los Alamos National Laboratory, Los Alamos, New Mexico.
- DOD (U.S. Department of Defense)
2007 *Department of Defense Explosives Safety Board (DDESB)*, Washington, DC.
- DOE (U.S. Department of Energy)
2015 *United States Nuclear Tests, July 1945 through September 1992*. National Nuclear Security Administration. Report DOE/NV-209-Rev. 16, https://www.nnss.gov/docs/docs_librarypublications/doe_nv-209_rev16.pdf Nevada Field Office.
- Dubiel, Stanley V., and John F. Bayton
1963 *The Differential Thermal Analysis Unit At Group GMX-3: LAMS-2988*, Los Alamos Scientific Laboratory, Los Alamos, New Mexico.
- Foxx, Teralene S.
2002 *Roadside Ecology of the Pajarito Plateau and Jemez Mountains: A Real or Virtual Tour*. LA-UR-02-3834. Los Alamos National Laboratory, Los Alamos, New Mexico.

References Cited

- Garcia, Kari L., McGehee, E. D., & ESH-20.
2000 *Historical Building Assessment for the Department of Energy Conveyance and Transfer Project*; Volumes 1 and 2 (Vol. LA-UR-00-1003)
- Gosling, F. G.
2010 *The Manhattan Project: Making the Atomic Bomb*. Report DOE/MA-0002. Rev. ed. U.S. Department of Energy, Office of History and Heritage Resources, Washington, D.C.
- Hoard, Dorothy
2006 *Historic Transportation Routes on the Pajarito Plateau*. LA-UR-06-3550. Los Alamos National Laboratory, Los Alamos, New Mexico.
- Hoddeson, L., R. A. Henriksen, R. A. Meade, and C. Westfall
1993 *Critical Assembly: A technical History of Los Alamos during the Oppenheimer Years, 1943-1945*. Cambridge University Press, Cambridge, United Kingdom.
- Hurd, Alan J., and Dale W. Schaefer
2006 *Introduction to Materials and Bioscience Neutron-Scattering Research*. LA-UR-06-0218, Los Alamos Science. 2006, no.30.
- LANL (Los Alamos National Laboratory)
1984 *Los Alamos: Beginning of an Era, 1943-1945*. Reprint. Los Alamos National Laboratory, New Mexico.
1993 *RFI Work Plan for Operable Unit 1082: Environmental Restoration Program*. LA-UR-93-1196. Los Alamos National Laboratory, Los Alamos, New Mexico.
2001a *The Laboratory in a Changing World: A Los Alamos Chronology*. Los Alamos National Laboratory, Los Alamos, New Mexico.
2001b *NEPA Determination Document 9: High Explosives Research and Development and Processing Facilities*. LA-UR-01-3040. Los Alamos National Laboratory, Los Alamos, New Mexico.
2003 "Fragment Impact Initiation of High Explosives," *Nuclear Weapons Journal.*, 10-12. LALP-03-011.
2006 *LANL History: Cold War Years: H-Bomb to Stewardship: Weapon Development: Plastic-Bonded Explosives*. Los Alamos National Laboratory, Los Alamos, New Mexico.
2017 *A Plan for the Management of the Cultural Heritage at Los Alamos National Laboratory, New Mexico*. LA-UR-15-27627. Los Alamos National Laboratory, Los Alamos, New Mexico.
- Machen, Judith,
2007 "Interview with Roger Goldie on TA-37, Magazine Area C," Los Alamos National Laboratory document.
2008a "Interview with Mel Brooks on TA-16 Operations," Los Alamos National Laboratory document.

- 2008b "Interview with Clarence Courtwright and Larry Fulgenzi on TA-16 Operations," Los Alamos National Laboratory document.
- Machen, Judith, Ellen D. McGehee, Kari L. M. Garcia, Kristen A. Honig, Kenneth R. Towery, Sheila McCarthy, and Elliot M. Schultz
 2020 *Competition and Confrontation: TA-16-430 Complex and the Role of Pressed High Explosives in the Cold War Nuclear Arms Race Volume 1*. LANL Fiscal Year 2018 Footprint Reduction. Cultural Resources Report No. 293, LA-UR-19-26552. Los Alamos National Laboratory, Los Alamos, New Mexico.
- Machen, Judith, Ellen D. McGehee, Kari L. M. Garcia, Erik Loomis, Naomi Naranjo, Kenneth Towery, John Ronquillo, Sheila McCarthy, and Kristen Honig
 2010 *SM-43, Nerve Center of a National Laboratory: A History of the Los Alamos Administration Building (1956-2006)*. Cultural Resources Report No. 309, LA-UR-11-00922. Los Alamos National Laboratory, Los Alamos, New Mexico.
- Machen, Judith, Ellen D. McGehee, and Dorothy Hoard
 2012 *Homesteading on the Pajarito Plateau, 1887-1942*. Cultural Resources Report No. 313, LA-UR-12-24602. Los Alamos National Laboratory, Los Alamos, New Mexico.
- MacRoberts, Martin,
 n.d. *General S-Site Description*. document on file at Environmental Stewardship group. Los Alamos National Laboratory document.
- McGehee, E. D., and K. L. M. Garcia
 1999 *Historical Building Assessment for the Department of Energy Conveyance and Transfer Project*. Cultural Resources Report No. 178, LA-UR-00-1003. Los Alamos National Laboratory, Los Alamos, New Mexico.
- McGehee, Ellen D.
 1995 *TA-16 Heating System Replacement*. Cultural Resources Report No. 114, LA-CP-95-180. Los Alamos National Laboratory, Los Alamos, New Mexico.
- McGehee, Ellen D., Sheila McCarthy, Kari L. M. Garcia, Ken Towery, and John Ronquillo
 2003 *ESA Division's Five Year Plan: Consolidation and Revitalization at Technical Areas 3, 8, 11, and 16*. Cultural Resources Report No. 214, LA-UR-02-6841. Los Alamos National Laboratory, Los Alamos, New Mexico.
- Miller, Roland, Launius, R., Thall, B., Fahlman, B. Covault, C., Melroy, P. & O'Leary, B.
 2016 *Abandoned in Place: Preserving America's Space History*. University of New Mexico Press, Albuquerque, New Mexico.
- Mitchell, Kris C.
 2003 *Rhetoric to Reality: A Cold War context statement for the Pantex Plan 1951-1991*. Washington, D.C.: U.S. Dept. of Energy, National Nuclear Security Administration, Pantex.
- Plimpton, Kathryn D., and Kari L. M. Garcia
 2017 *Mitigation Plan for Technical Area 16*. Cultural Resources Report No. 349, LA-UR-29361. Los Alamos National Laboratory, Los Alamos, New Mexico.

References Cited

- Popolato, A., J.J. Ruminer, A.S. Vigil, N.K. Kernodie, and D. L. Jaeger
1979 *Thermal Response of Explosives Subjected to External Heating: LAMS-7667*. Los Alamos Scientific Laboratory, Los Alamos, New Mexico.
- Robert E. and Evelyn McKee Foundation
n.d. Robert Eugene McKee. Robert E. and Evelyn McKee Foundation
<http://www.mckeefoundation.org/re-mckee.htm>, accessed October 29, 2018.
- Rogers, William H., Louis C. Smith
1972 *The Effects of Long-Term Storage at 60°C on Small Cylinders of PBX 9404: LAMS-4989*. Los Alamos Scientific Laboratory, Los Alamos, New Mexico.
- Rothman, H.
1992 *On Rims and Ridges, the Los Alamos Area since 1880*. Lincoln: University of Nebraska Press.
- Smith, Louis C.
1977 *On the Problem of Evaluating the Safety of an Explosives*. LA-UR-77-1304. Los Alamos Scientific Laboratory, Los Alamos, New Mexico.
- Smith, Louis C.
1979 *Explosives Research Development Recommendations and Comments on Unsolved Problems, LAMS-8124*, Los Alamos Scientific Laboratory, Los Alamos, New Mexico.
- Stanley, Irene, and Duffy Stanley.
2010 McKee, Robert Eugene Sr. Texas State Historical Association
<https://tshaonline.org/handbook/online/articles/fmcnv>, accessed October 29, 2018.
- Stine, B.A., R.A. Hildner, M.J. Urizar, E.D. Loughran, M.P. Neary, G.W. Taylor, Marion L. Clancy, and T.L. McKinney
1981 *An Attempt to Identify an Explosive after Highly Confined Detonation: LAMS-8965*. Los Alamos National Laboratory, Los Alamos, New Mexico.
- Yinon, Jehuda, and John C. Hoffsommer
2008 "Analysis of Explosives," *C R C Critical Reviews in Analytical Chemistry*, 7:1, 1-35, DOI: 10.1080/10408347708542697.



Appendix A: LANL Historic Building Survey Forms including Key Original Drawings and As-Builts

This page intentionally left blank

LANL TA- Building # 16-0460

Camera 984242

Frame #s DCP_0352 through DCP_0355

Surveyor(s) S. McCarthy, B. McCormick, E. McGehee, K. Garcia; C. Townsend, K. Garcia

Date 7/22/2002; 2/4/2020

**Los Alamos National Laboratory
Historic Building Survey Form**

Building Name Laboratory Building UTM's easting 377847 northing 3967343 zone 13
Legal Description: Map Frijoles Quad tns 19N range 6E sec 30
Current Use/ Function Vacant Original Use/ Function Analytical HE Chemistry
Date (estimated) Date (actual) 1952/1953 Property Type Laboratory/Processing

Type of Construction

Pre-Engineered ☐ Steel Frame ☐ Wood Frame ☐ CMU ☐ Reinforced Concrete ☒

Other Type of Construction # of Stories 2

Foundation Reinforced Concrete

Exterior CMU-Exterior ☐ Reinforced Concrete-Exterior ☒ Steel (galvanized) ☐ Steel (corrugated) ☐
Wood Siding ☐ Asbestos Shingles-Exterior ☐ In-Fill Panels ☐ Other-Exterior

Exterior Treatment (painted, stuccoed, etc) Unpainted

Exterior Features (docks, speakers, lights, signs, etc) Signage, lights, alarms, and conduit

Addition CMU-Addition ☐ Reinforced Concrete-Addition ☐ Steel (galvanized)- Addition ☐ Wood ☐
Steel (corrugated)-Addition ☐ Asbestos Shingles-Addition ☐ Other- Addition

Exterior Treatment-Addition

Exterior Features-Addition

Roof Form Slanted/Shed ☐ Gable ☐ Other Roof Type Flat

Degree of Pitch/ Slope Slight

Roof Materials Corrugated Metal ☐ Rolled Asphalt ☐ Asbestos Shingles ☐ 4-Ply Built Up ☒
Other Roof Materials

Window Type Casement ☐ Single Hung Sash ☐ Double Hung Sash ☐ Fixed Window ☒
Other Window Type Glass Block

of Each Window Type/ Comments 20 glass block windows

Glass Type Clear ☐ Wire Glass ☐ Opaque ☐ Painted Glass ☐ Glass Block ☒

Light Pattern Seventeen windows of 6 over 4 glass blocks and three windows of 4 over 4 glass blocks

Door Type	Personnel Door Types	Exterior	Fire Door <input type="checkbox"/>	Single <input checked="" type="checkbox"/>	Double <input checked="" type="checkbox"/>	Roll-up <input type="checkbox"/>	Sliding <input type="checkbox"/>
			Hollow Metal <input type="checkbox"/>	Solid Wood <input type="checkbox"/>	1/2 Glazed <input type="checkbox"/>	Paneled <input type="checkbox"/>	Louvered <input type="checkbox"/>
		Interior	Fire Door <input type="checkbox"/>	Single <input checked="" type="checkbox"/>	Double <input checked="" type="checkbox"/>	Roll-up <input type="checkbox"/>	Sliding <input type="checkbox"/>
			Hollow Metal <input type="checkbox"/>	Solid Wood <input type="checkbox"/>	1/2 Glazed <input type="checkbox"/>	Paneled <input type="checkbox"/>	Louvered <input type="checkbox"/>
	Equipment Door Types	Exterior	Fire Door <input type="checkbox"/>	Single <input type="checkbox"/>	Double <input checked="" type="checkbox"/>	Roll-up <input type="checkbox"/>	Sliding <input type="checkbox"/>
			Hollow Metal <input type="checkbox"/>	Solid Wood <input type="checkbox"/>	1/2 Glazed <input type="checkbox"/>	Paneled <input type="checkbox"/>	Louvered <input type="checkbox"/>
		Interior	Fire Door <input type="checkbox"/>	Single <input type="checkbox"/>	Double <input type="checkbox"/>	Roll-up <input type="checkbox"/>	Sliding <input type="checkbox"/>
			Hollow Metal <input type="checkbox"/>	Solid Metal <input type="checkbox"/>	1/2 Glazed <input type="checkbox"/>	Paneled <input type="checkbox"/>	Louvered <input type="checkbox"/>

of Each Door Type/Comments:

Interior Wall Gypsum Board ☒ Reinforced Concrete- Interior ☒

CMU- Interior ☐ Plywood ☐ Other- Interior

In-Wall Electrical Wiring ☐ On-Wall Electrical Wiring ☐

Ceiling Drop Ceiling ☒

Interior Comments (Equipment, etc)

Degree of Remodeling

Condition Excellent ☐ Good ☒ Fair ☐ Deteriorating ☐ Contaminated ☐ Burned ☐

Associated Buildings ☒

If yes, list building names and #s

Integrity

Significance

Eligible Under Criterion A ☒ B ☐ C ☒ D ☐ Not Eligible ☐

DOE Themes

Nuclear Weapon Components and Assembly ☐ Nuclear Weapon Design and Testing ☒ Nuclear Propulsion ☐

Peaceful Uses: Plowshare, Nuclear Medicine, Nuclear Energy, Nuclear Science ☐ Energy and Environment: Research and Design Projects ☐

LANL Themes

Weapons Research and Design, Testing, and Stockpile Support ☒ Super Computing ☐

Reactor Technology ☐ Biomedical/Health Physics ☐ Strategic and Supporting Research ☐

Environment/Waste Management ☐ Administration and Social History ☐ Architectural History ☐

Recommendations/ Additional Comments

Architectural Features (elevations)

TA-16-0460 was a one-story, high-bay building with a mezzanine and a partial basement. T-shaped in plan, it measured approximately 116 by 77 feet, encompassed approximately 11,294 square feet, and was oriented northwest by southeast. The facility was constructed into a small rise in the landscape. Built on a hardened concrete foundation, the building was constructed of poured-in-place reinforced concrete and concrete-masonry units (CMUs). Exterior wall materials included unpainted smooth-finished concrete with expansion joints and insulated aluminum panels. The southern end of the building featured a poured concrete retaining wall that safeguarded ground-level access to the basement. Several pieces of mechanical equipment were located on the exterior of the building at ground level and penetrated the walls connecting to their interior elements. This included an air intake unit on the northeast façade that was housed in corrugated metal-panels with a shed roof and a metal-framed louvered vent and another piece of mechanical equipment housed in a poured-concrete-panel box. The exterior also featured a few small and large metal-framed louvered vents, exterior lights, alarms, conduit lines, and signs. Interior walls were constructed of poured-in-place concrete, CMUs, metal partitions, and aluminum panels.

The roof was constructed of poured concrete and clad in a built-up material. Nearly flat, the roof had numerous low-pitched hipped areas to promote water runoff. The building featured a wide, overhanging closed concrete eave on all façades. Three large exhaust vents penetrated the eave and extended above the roofline. The roof also exhibited additional smaller vents and a lightening protection system.

The main entrance was located on the southwest façade through paired, metal-panel personnel doors accessed by concrete stairs with pipe-metal railings. On the southeast elevation, the first floor had a wide single, metal-panel personnel door accessed by concrete stairs that sat atop the retaining wall and a floating concrete walkway with pipe-metal railings. Below the walkway were a set of wide paired, metal-panel doors with louvered vents that provided access to the basement. The northwest elevation had a single, metal-panel personnel door accessed by concrete stairs with metal-pipe railings. The building's fenestration consisted of a single set and numerous bands of glass-block windows interspersed with concrete panels. Twenty-one of the windows comprised 24 glass blocks (6 by 4) and 2 windows comprised 16 glass blocks (4 by 4). Fifteen of these 21 windows were located on the main façade above the main entrance.

Black and Veatch completed drawings for TA-16-0460 in March 1951. Vinson Construction Company completed the building by 1953, and it served as an analytical high-explosives chemistry facility. Since its original construction, the Laboratory added mechanical equipment on the exterior of the building; changed out flat metal-framed louvered vents for those that extend above the roofline; constructed two mechanical equipment enclosures on the northeast elevation; replaced the roofing material, and built a connecting and enclosed walkway (TA-16-0461) to TA-16-0463 on the northwest elevation. TA-16-0460 had structural integrity, and the exterior was in good condition. Its architectural design was influenced by the International Modernist architectural style, and character-defining features included geometrical massing, lack of ornament, flat roof, continuous surface planes, bands of windows, and unornamented doors and windows.

Total sq ft 11,572 net**Architect/ Builder**

Black & Veatch Consulting Engineers / Vinson Construction Company

Alterations**List of Selected Drawings (Cntrl + Enter for paragraph break)****ENG-C 16274****Sheet 5 of 86****TA-16, Building (141-1) (TA-16-460)****Architectural: Basement Floor Plan and Schedule****March 12, 1951****ENG-C 16275****Sheet 6 of 86****TA-16, Building (141-1) (TA-16-460)****Architectural: First Floor Plan and Schedules****March 12, 1951**

ENG-C 16276
Sheet 7 of 86
TA-16, Building (141-1) (TA-16-460)
Architectural: Ceiling Plan and Details
March 12, 1951

ENG-C 16277
Sheet 8 of 86
TA-16, Building (141-1) TA-16-460)
Architectural: Roof Plan and Details
March 12, 1951

ENG-C 16279
Sheet 10 of 86
TA-16, Building (141-1) (TA-16-460)
Architectural: Elevations
March 12, 1951

ENG-C 16280
Sheet 11 of 86
TA-16, Building (141-1) (TA-16-460)
Architectural: Sections
March 12, 1951

ENG-R 2880
Sheet 1 of 1
TA-16, Building 460 (TA-16-460)
Laboratory Building
Bsm't & First Floor Plan
November 15, 1983

ENG-C AB603
Sheet 1 of 2
TA-16, Building 460 (TA-16-460)
aboratory Building
As-built Record Floor Plan
Arch: Basement Floor Plan
January 22, 1996

ENG-C AB603
Sheet 2 of 2
TA-16, Building 460 (TA-16-460)
aboratory Building
As-built Record Floor Plan
Arch: First Floor Plan
January 22, 1996

ENG-C 16279
Sheet 10 of 86
TA-16, Building (141-1) (TA-16-460)
Architectural: Elevations
March 12, 1951
Revised to status February 4, 2020



TA-16-460 Southwest elevation




TA-16-460 Northwest elevation



TA-16-460 Northeast elevation



TA-16-460 Southeast elevation

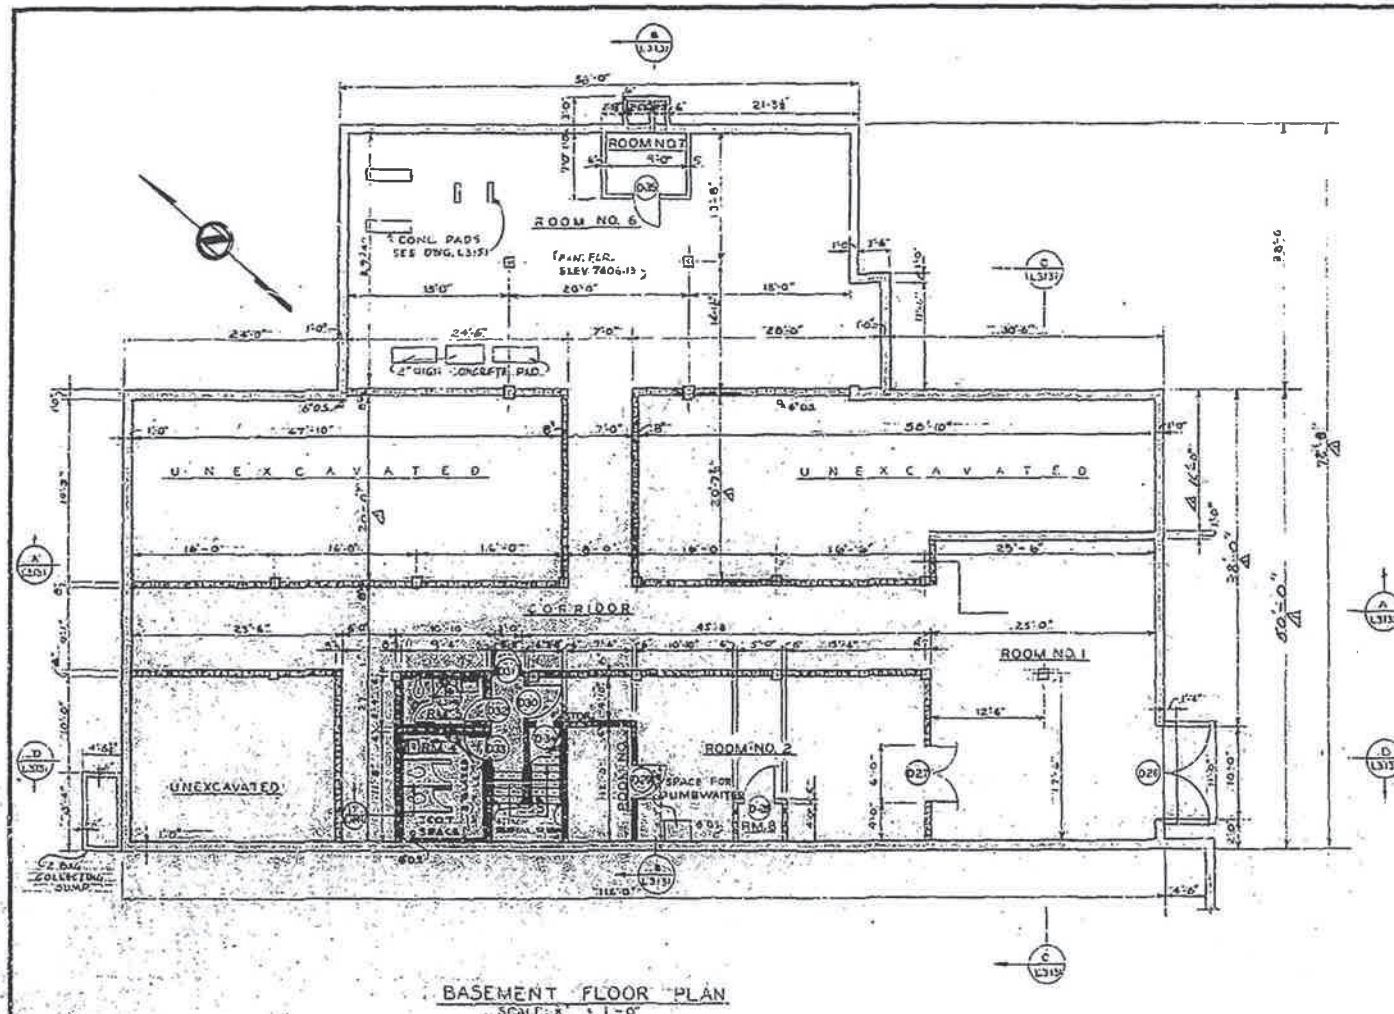


BASEMENT ROOM FINISH SCHEDULE					
ROOM NO.	FLOOR	WALLS	CEILING	WAINSCOT.	REMARKS
1	HARDENED CONCRETE	PAINTED CONCRETE	PAINTED CONCRETE	CLAZED TILE	
2	QUARRY TILE	PAINTED CONCRETE	PAINTED CONCRETE		
3		PAINTED CONCRETE	PAINTED CONCRETE		
4		PAINTED CONCRETE	PAINTED CONCRETE		
5		PAINTED CONCRETE	PAINTED CONCRETE		
6		PAINTED CONCRETE	PAINTED CONCRETE		
7		PAINTED CONCRETE	PAINTED CONCRETE		
CORRIDOR					PAINT INTERIOR WITH ACID-RESISTING PAINT

AS CONSTRUCTED DRAWING
CONSTRUCTION CONTR. OF ATOM-11207
SUBMITTED: K.O. J. J. J.
RECOMMENDED: J. J. J.
APPROVED: J. J. J.

David Charles
Keller
Verified Unclassified, EPC-ES

FOR OFFICIAL USE ONLY
THIS IS AN OFFICIAL DOCUMENT OF THE UNITED STATES. IT MAY NOT BE PUBLISHED, REPRODUCED, OR USED FOR OTHER THAN OFFICIAL PURPOSES WITHOUT THE WRITTEN CONSENT OF THE UNITED STATES ATOMIC ENERGY COMMISSION AND IS SUBJECT TO PENALTY FOR VIOLATION UNDER THE LAWS OF THE UNITED STATES.

2	REVISED TITLE: Building Number: Added	SP	MS
3	Change made in the field	BY	CHK
U.S. ATOMIC ENERGY COMMISSION NAMES RE OPERATIONS OFFICE LOS ALAMOS, NEW MEXICO		CONTRACT NO.	470
ARCHITECTURAL BUILDING (141-1) BASEMENT FLOOR PLAN AND SCHEDULE TA-16 PROJECT "I"		CHECKED	W.D.C.
BLACK & VEATCH CONSULTING ENGINEERS KANSAS CITY, MISSOURI		DATE	AS NOTED
SFA-KG-L3111		SHEET	5
LAB JOB 672		FILE NO.	2826

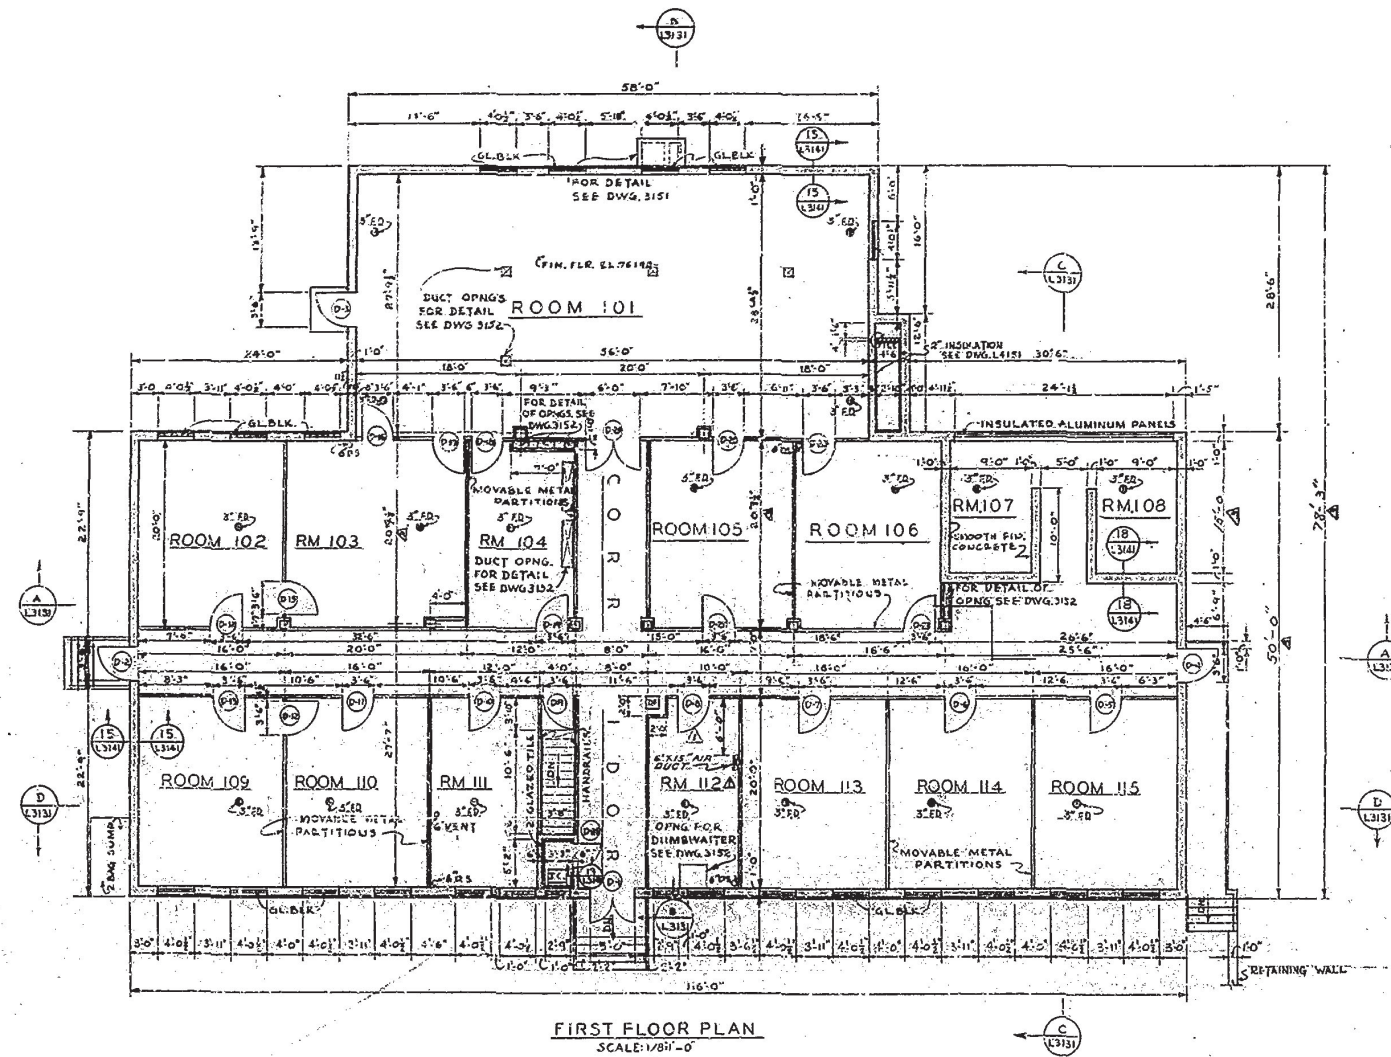


FIRST FLOOR PLAN ROOM FINISH SCHEDULE						
ROOM NO.	FLOOR	WALLS	CEILING	BASE	REMARKS	
101, 102 & 106		NON-SPARKING CONDUCTIVE HARDENED CONCRETE	PAINTED CONCRETE	PERFORATED METAL PANELS	PLEXIGLASS	
103		QUARRY TILE	PAINTED CONCRETE	PERFORATED METAL PANELS	PLEXIGLASS	
104 & 105		QUARRY TILE	PAINTED CONCRETE	PERFORATED METAL PANELS	PLEXIGLASS	
107 & 108		QUARRY TILE	PAINTED CONCRETE	PERFORATED METAL PANELS	PLEXIGLASS	
109THRU115		QUARRY TILE	PAINTED CONCRETE	PERFORATED METAL PANELS	PLEXIGLASS	
JAN. CLO.		QUARRY TILE	PAINTED CONCRETE	PERFORATED METAL PANELS	PLEXIGLASS	
CORRIDOR		QUARRY TILE	PAINTED CONCRETE	PERFORATED METAL PANELS	PLEXIGLASS	2" GLAZED TILE WAINSCOT 4'-6" HIGH

NOTE: SEE DWG. NO. L3131 FOR BASEMENT ROOM FINISH SCHEDULE

DOOR SCHEDULE						
MARK	TYPE	MATL	SIZE	GLASS	DETAILS	REMARKS
D-1	A	STL	2'-2 1/2" x 7'-0"	NONE	3-1/4" x 1-1/4"	
D-2, D-3, D-4	B	"	3'-6" x 7'-0"	"	3-1/4" x 1-1/4"	
D-5 THRU D-23	C	"	3'-6" x 7'-0"	"	3-1/4" x 1-1/4"	BY SAME MFR. AS METAL PARTITIONS - DOORS D-9, D-16, D-17, D-18, D-20, D-22 NOT LOUVERED
D-24	D	"	3'-6" x 7'-0"	"	3-1/4" x 1-1/4"	BY SAME MFR. AS METAL PARTITION
D-25	B	"	2'-6" x 7'-0"	"	3-1/4" x 1-1/4"	
D-26	A	"	2'-6" x 8'-0"	"	4-1/4" x 1-1/4"	
D-27	A	"	2'-6" x 7'-0"	"	2-1/4" x 1-1/4"	
D-28, D-29, D-30	F	"	3'-6" x 7'-0"	"	20-7/16" x 1-1/4"	D-28 NOT LOUVERED (TYPE "B")
D-31	E	"	3'-0" x 7'-0"	"	20-7/16" x 1-1/4"	LOUVERED
D-32, D-33	E	"	2'-6" x 7'-0"	"	20-7/16" x 1-1/4"	LOUVERED
D-34	B	"	2'-0" x 7'-0"	"	20-7/16" x 1-1/4"	
D-35	B	"	3'-0" x 6'-4 1/2"	"	22-22/32" x 2-3/8"	SEE DETAIL 2.4 DWG NO. L3141

NOTE: FOR DETAILS LISTED ABOVE SEE DWG. NO. L3141

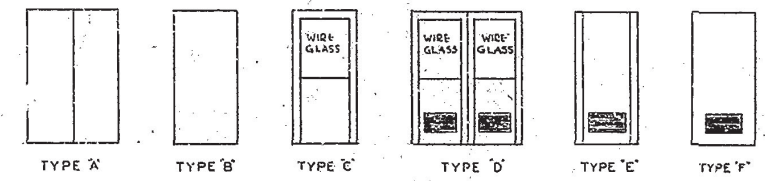

NOTES:
TACK WELD 6" O.C. ALL ASTRAGALS ON DOUBLE DOORS.
ALL EXTERIOR DOORS TO HAVE SECURITY KEEYS.
DOOR UPSET ENDS OF BOLTS, PROVIDE TWO ON EACH SIDE OF DOOR.

AS CONSTRUCTED DRAWING
CONSTRUCTION CONTRACT NO. ATC-28-D-1297
SUBMITTED BY: J. O. J. J.
RECOMMENDED BY: J. O. J. J.
APPROVED BY: J. O. J. J.


David Charles Keller
Digitally signed by David Charles Keller
Date: 2023.01.09 10:49:38 -0700

Verified Unclassified, EPC-ES

FOR OFFICIAL USE ONLY


THIS IS AN OFFICIAL DOCUMENT OF THE UNITED STATES. IT MAY NOT BE PUBLISHED, REPRODUCED, OR USED FOR OTHER THAN OFFICIAL PURPOSES WITHOUT THE WRITTEN CONSENT OF THE UNITED STATES ATOMIC ENERGY COMMISSION. ANY VIOLATION WILL BE SUBJECT TO PUNISHMENT UNDER THE LAWS OF THE UNITED STATES.

4/1/54 Revised Title - Building Dims. Added	JF US	
4/1/54 Change Made in Field	XOT	
4/1/54 Add Notes, Mod. Lb. 16	ELB	
4/1/54 Relocate Duct Opening Mod. No. 5	ELB	
U. S. ATOMIC ENERGY COMMISSION SANTA FE OPERATIONS OFFICE LOS ALAMOS, NEW MEXICO		
ARCHITECTURAL BUILDING (41-1) FIRST FLOOR PLAN AND SCHEDULES T.A.-16 PROJECT "I"		
SUBMITTED BY: J. O. J. J. RECOMMENDED BY: J. O. J. J. APPROVED BY: J. O. J. J.		
BLACK & VEATCH CONSULTING ENGINEERS KANSAS CITY, MISSOURI		
SFA-KG-L-31123 5 86		

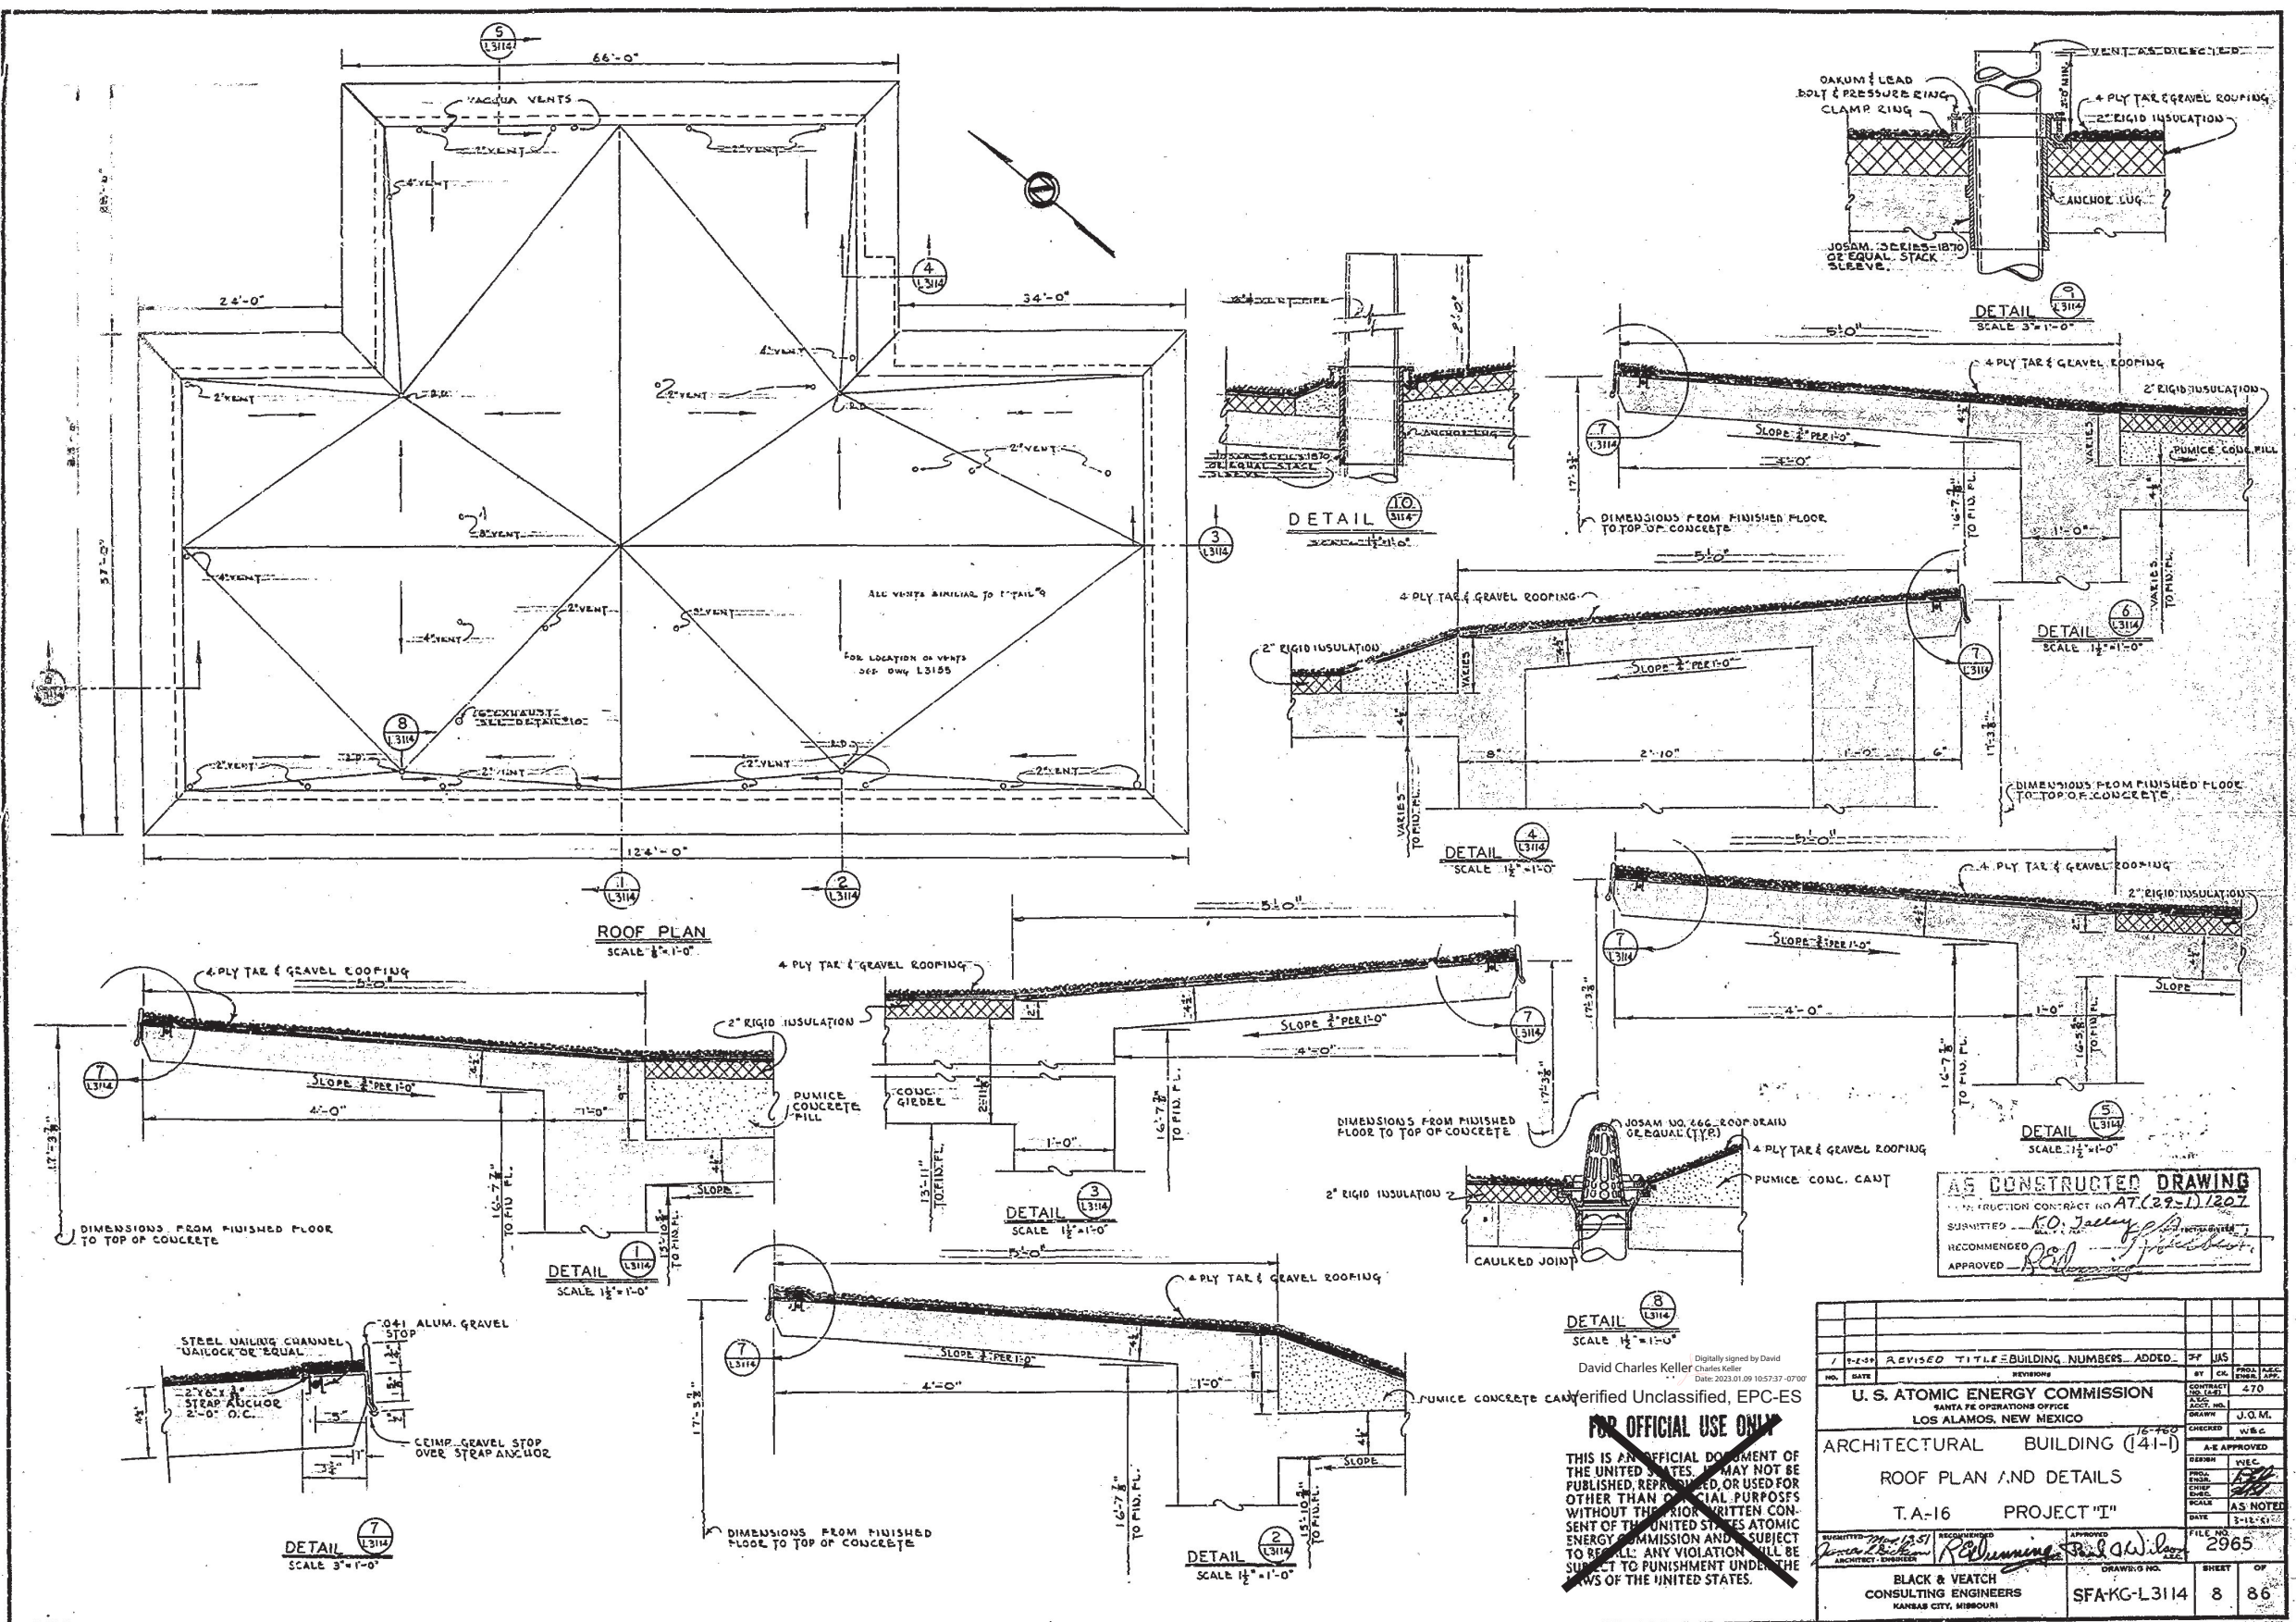


AS CONSTRUCTED DRAWING
INSTRUCTION CONTRACT NO. AT(22-1)1207
SUBMITTED: K.O. Jolley
RECOMMENDED: [Signature]
APPROVED: [Signature]


NO.	DATE	REVISION	BY	CHK.	PROJ. ASS.
1	5-2-54	REVISED TITLE-BUILDING NUMBERS ADDED	JP	JUS	
U. S. ATOMIC ENERGY COMMISSION					
SANTA FE OPERATIONS OFFICE					
LOS ALAMOS, NEW MEXICO					
ARCHITECTURAL BUILDING (41-1)			CHECKED	W.B.C.	
T.A-16 PROJECT "I"			DESIGNED	P.E.C.	
ROOF PLAN AND DETAILS			ENGINEER	[Signature]	
T.A-16 PROJECT "I"			SCALE	AS NOTED	
DATE			DATE	3-15-61	
SUBMITTED: [Signature]			RECOMMENDED: [Signature]	APPROVED: [Signature]	FILE NO. 2965
BLACK & VEATCH			CONSULTING ENGINEERS	KAUFMAN CITY, MISSOURI	DRAWING NO. SFA-KG-L3114
					SHEET 8 OF 86

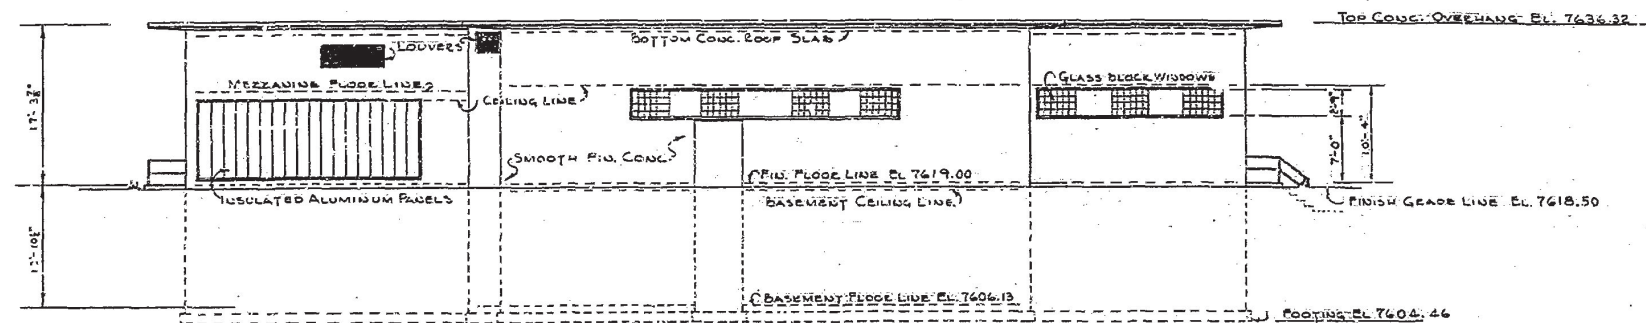


NORTHEAST ELEVATION
 SCALE 1/8"=1'-0"

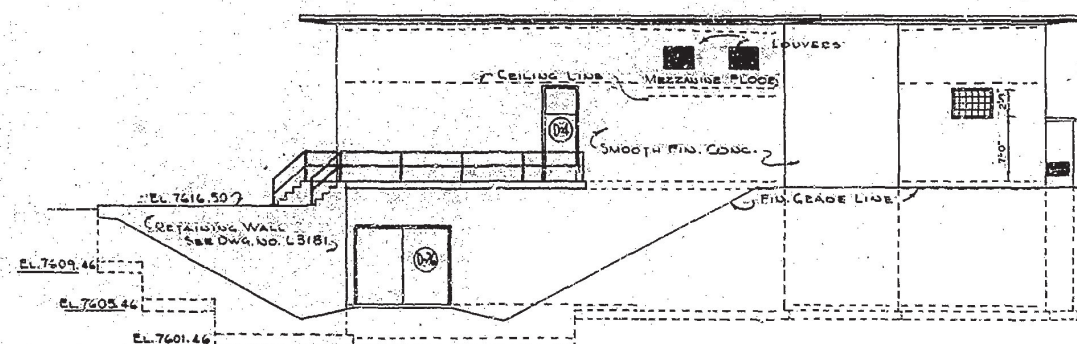

SOUTHEAST ELEVATION
 SCALE 1/8"=1'-0"

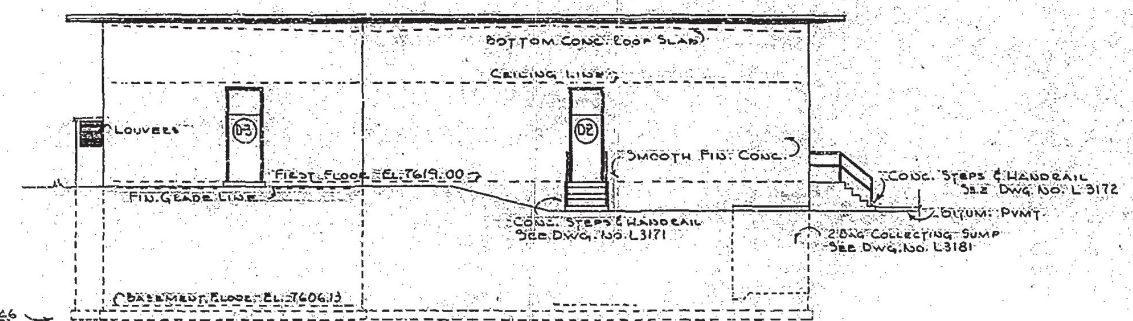

NORTHWEST ELEVATION
 SCALE 1/8"=1'-0"

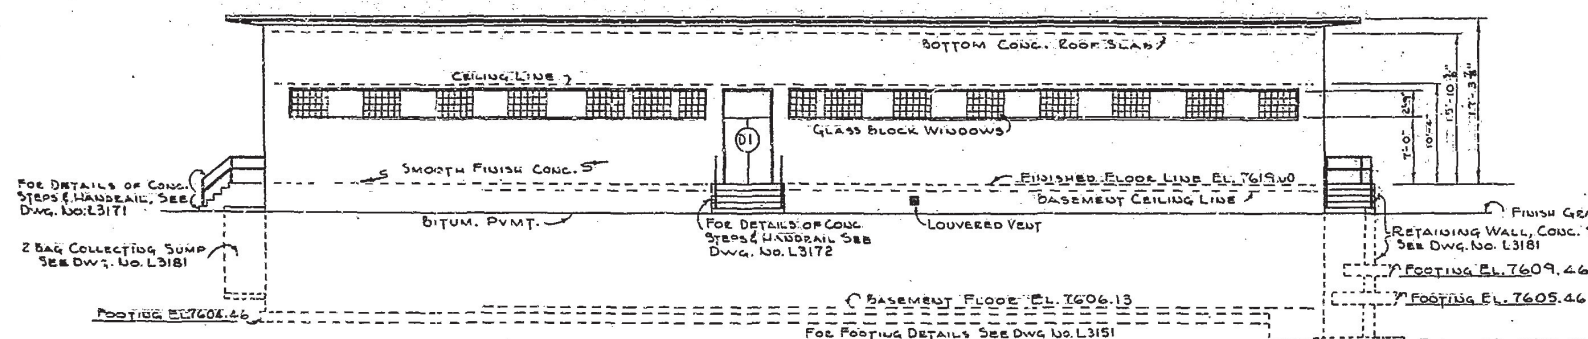

SOUTHWEST ELEVATION
 SCALE 1/8"=1'-0"

AS CONSTRUCTED DRAWING
 CONSTRUCTION CONTRACT NO. 47(2-2-1) 1207
 SUBMITTED *K.D. Jolley*
 RECOMMENDED *[Signature]*
 APPROVED *[Signature]*





David Charles Keller
 Digitally signed by David Charles Keller
 Date: 2023.01.09 10:59:44 -0700

Verified Unclassified, EPC-ES

FOR OFFICIAL USE ONLY

THIS IS AN OFFICIAL DOCUMENT OF THE UNITED STATES. IT MAY NOT BE PUBLISHED, REPRODUCED, OR USED FOR OTHER THAN OFFICIAL PURPOSES WITHOUT THE PRIOR WRITTEN CONSENT OF THE UNITED STATES ATOMIC ENERGY COMMISSION AND IS SUBJECT TO PENALTY FOR VIOLATION UNDER THE LAWS OF THE UNITED STATES.

NO.	DATE	REVISED	TITLE - Building Numbers Added	BY	CHK.	PROJ. A.E.C.
1	12-29					
U.S. ATOMIC ENERGY COMMISSION						
SANTA FE OPERATIONS OFFICE						
LOS ALAMOS, NEW MEXICO						
ARCHITECTURAL BUILDING (141-1)						
ELEVATIONS						
T.A-16 PROJECT "I"						
FILE NO. 2984						
BLACK & VEATCH CONSULTING ENGINEERS KANSAS CITY, MISSOURI						
SFA-KG-L3121 10 86						

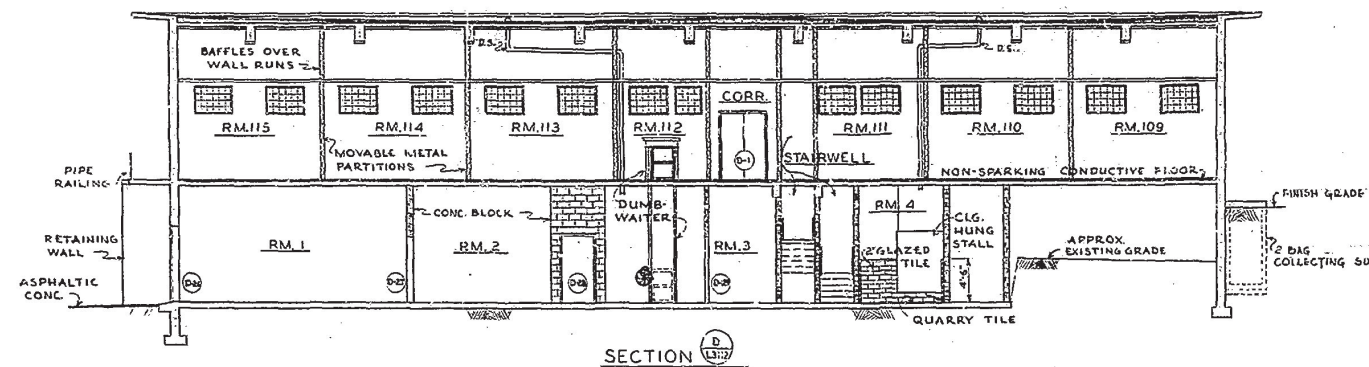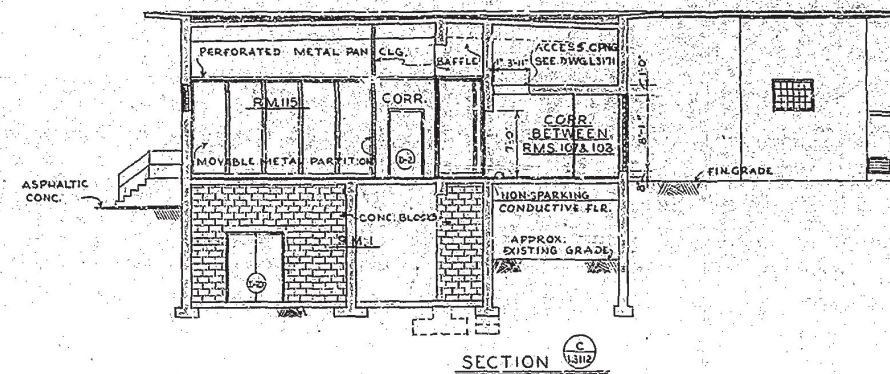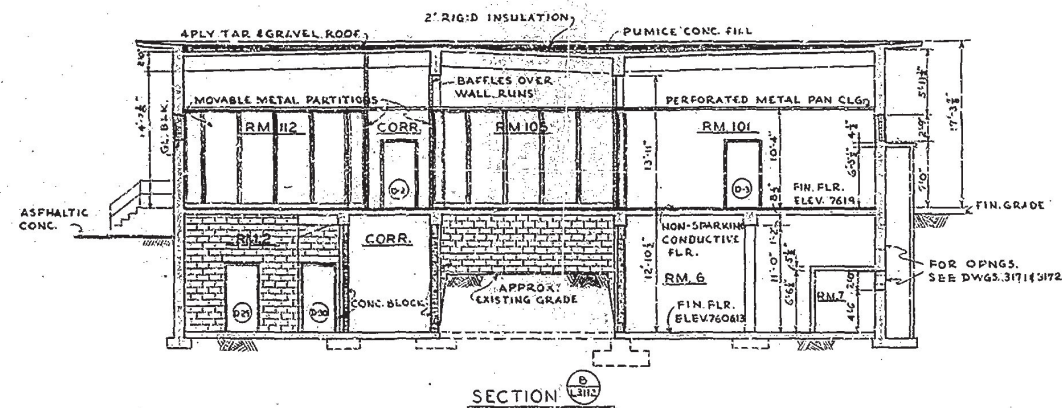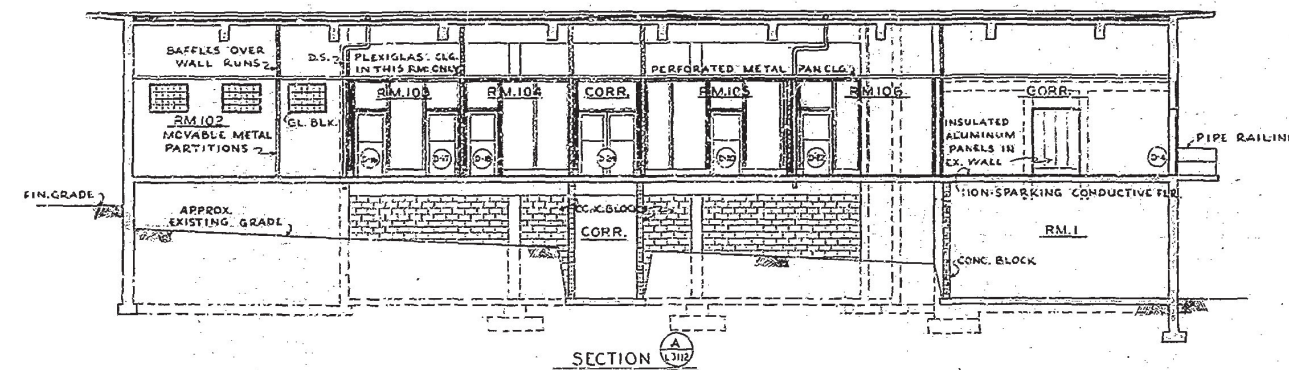


AS CONSTRUCTED DRAWING
 CONSTRUCTION CONTRACT NO. AT(29-1)7287
 SUBMITTED BY *K.O. Keller*
 RECOMMENDED BY *[Signature]*
 APPROVED BY *[Signature]*


David Charles
 Keller
 Verified Unclassified, EPC-ES

FOR OFFICIAL USE ONLY
 THIS IS AN OFFICIAL DOCUMENT OF THE UNITED STATES. IT MAY NOT BE PUBLISHED, REPRODUCED, OR USED FOR OTHER THAN OFFICIAL PURPOSES WITHOUT THE PRIOR WRITTEN CONSENT OF THE UNITED STATES ATOMIC ENERGY COMMISSION AND IS SUBJECT TO PENALTY FOR VIOLATION UNDER THE LAWS OF THE UNITED STATES.

NO.	DATE	REVISIONS	BY	CHK.	PHYS. SEC.
1	12-24	REVISED TITLE - Building Numbers Added	JIS		
U. S. ATOMIC ENERGY COMMISSION					
SANTA FE OPERATIONS OFFICE					
LOS ALAMOS, NEW MEXICO					
ARCHITECTURAL BUILDING (141-1)					
SECTIONS					
TA-16 PROJECT 'I'					
DESIGNED BY	12-24	REVISIONS	BY	CHK.	PHYS. SEC.
ARCHITECT - ENGINEER					
BLACK & VEATCH					
CONSULTING ENGINEERS					
KANSAS CITY, MISSOURI					
DRAWING NO.	SFA-KG-L3131	SHEET	11	OF	86
FILE NO.	3006				

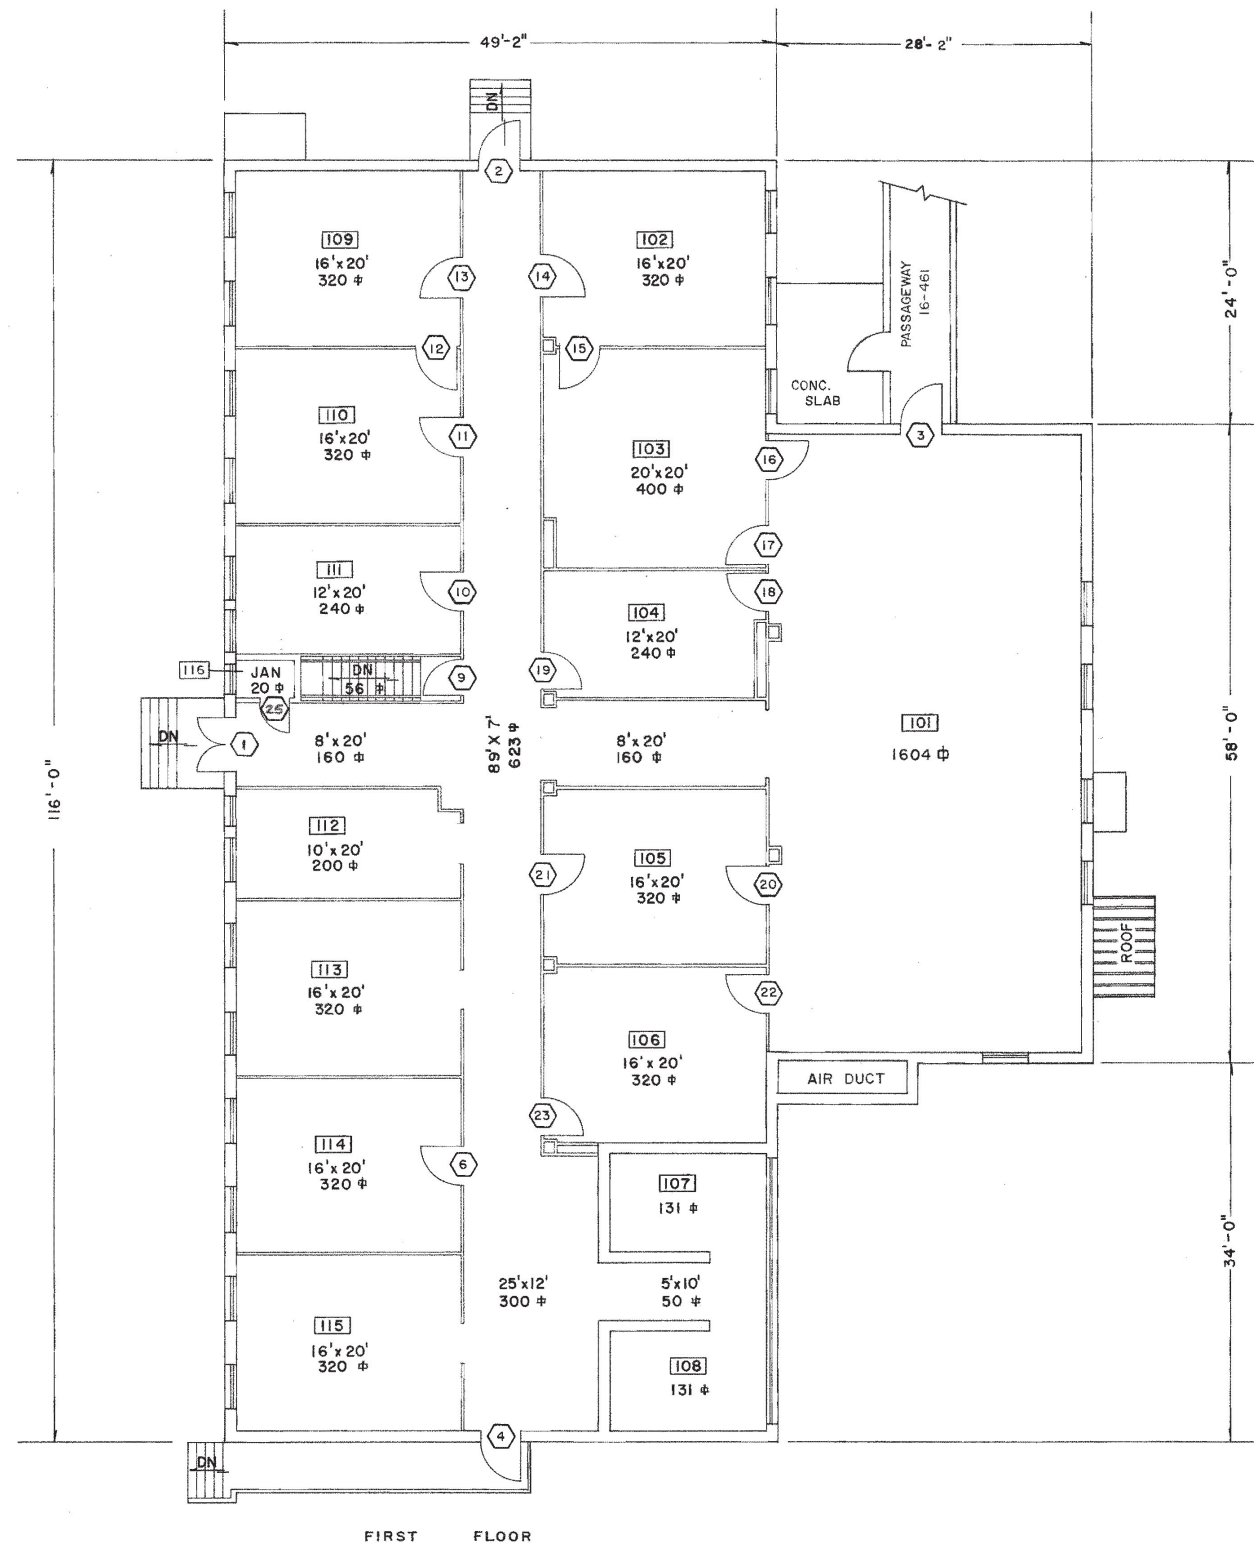

FIRST FLOOR

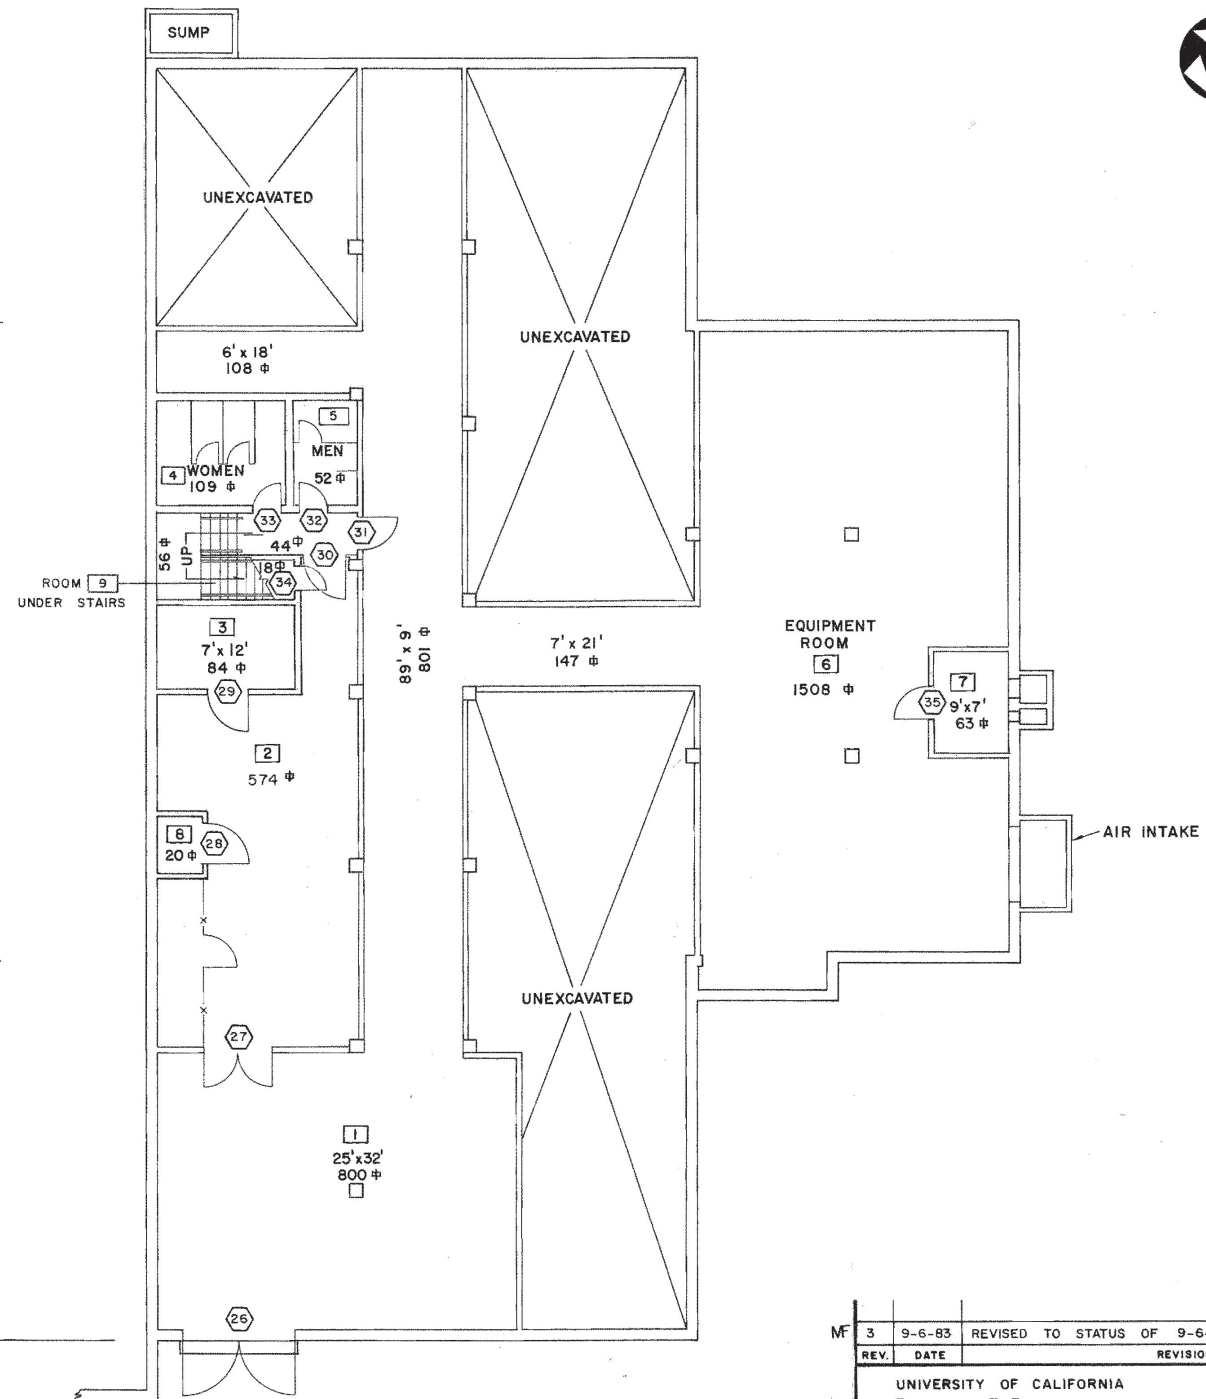

BASEMENT FLOOR

- ROOM NO. SYMBOL
- DOOR NO. SYMBOL

BASEMENT FLOOR	TOTAL SQ FT	4419
FIRST FLOOR	TOTAL SQ FT	6875
	TOTAL SQ FT	11294

REV. 3	DATE 9-6-83	REVISED TO STATUS OF 9-6-83	BY HBN	APP. [Signature]
UNIVERSITY OF CALIFORNIA Los Alamos Los Alamos National Laboratory Los Alamos, New Mexico 87545				
FACILITIES ENGINEERING DIVISION				
LABORATORY BLDG. BSM'T., & FIRST FLOOR PLAN				
BLDG. 460		TA-16		
SUBMITTED [Signature]		RECOMMENDED [Signature]		APPROVED [Signature]
DRAWN GLASS	DATE 11-15-83	SHEET NO. 1 OF 1	DRAWING NO. ENG-R2880	
CHECKED Humble HBN				

RECORDS LOGGED TO VAULT

ROOM INFORMATION CHART					
RM NO	NET SQ FOOTAGE	RM NO	NET SQ FOOTAGE	RM NO	NET SQ FOOTAGE
100	164	105	332	112	187
100A	988	106	335	113	318
100B	161	107	179	114	321
101	1611	108	171	115	318
102	326	109	323	116	20
103	386	110	321	UTILITY 1	24
104	235	111	240	1-SIW1	57

TOTAL ROOM NET SQUARE FOOTAGE (THIS SHEET) = 7,027
GROSS SQUARE FOOTAGE (THIS SHEET) = 7,439
TOTAL ROOM NET SQUARE FOOTAGE (BUILDING) = 11,572
GROSS SQUARE FOOTAGE (BUILDING) = 12,405


LEGEND

	CONCRETE
	CONCRETE BLOCK
	LOUVER
	UTILITY SPACE
	WOOD OR METAL STUD COLUMNS

NOTES

- ALL EXTERIOR WALLS ARE 12" THICK UNLESS OTHERWISE NOTED.
- ALL INTERIOR WALLS ARE 3" THICK UNLESS OTHERWISE NOTED.
- REFERENCE DRAWING ENG-R2880.
- ROOM NET SQUARE FOOTAGE IS COMPUTED BY MEASURING FROM THE INSIDE FACE OF EXTERIOR WALLS TO THE CENTERLINE OF ALL OTHER WALLS. AREAS SHOWN ARE ROUNDED TO THE NEAREST SQUARE FOOT.
- GROSS SQUARE FOOTAGE IS EQUAL TO ALL FLOOR AREA (INCLUDING ALL OPENINGS IN FLOOR SLABS) MEASURED TO THE OUTER SURFACES OF EXTERIOR OR ENCLOSING WALLS, AND INCLUDES ALL FLOORS, MEZZANINES, HALLS, VESTIBULES, STAIRWELLS, SERVICE AND EQUIPMENT ROOMS, PENTHOUSES, VAULTS, AND ENCLOSED PASSAGES.
- DIMENSIONS SHOWN ARE ROUNDED TO THE NEAREST INCH.


NO	DATE	CLASS	REV	DESCRIPTION	DWN	VER	CHKD	SUB	APP
JOHNSON CONTROLS AS-BUILT RECORD FLOOR PLAN LABORATORY BUILDING ARCH: FIRST FLOOR PLAN									
BLDG 450 SUBMITTED JERRY FORTE 2-13-96					TA-16 DATE 1-22-96 APPROVED FOR RELEASE FRED THOMPSON 2/16/96				
Los Alamos Los Alamos National Laboratory Los Alamos, New Mexico 87545					SHEET 2 OF 2				
CLASSIFICATION PROJECT ID 016523					REVIEWER T. GUSDORF DATE 2-12-96 DRAWING NO AB603				

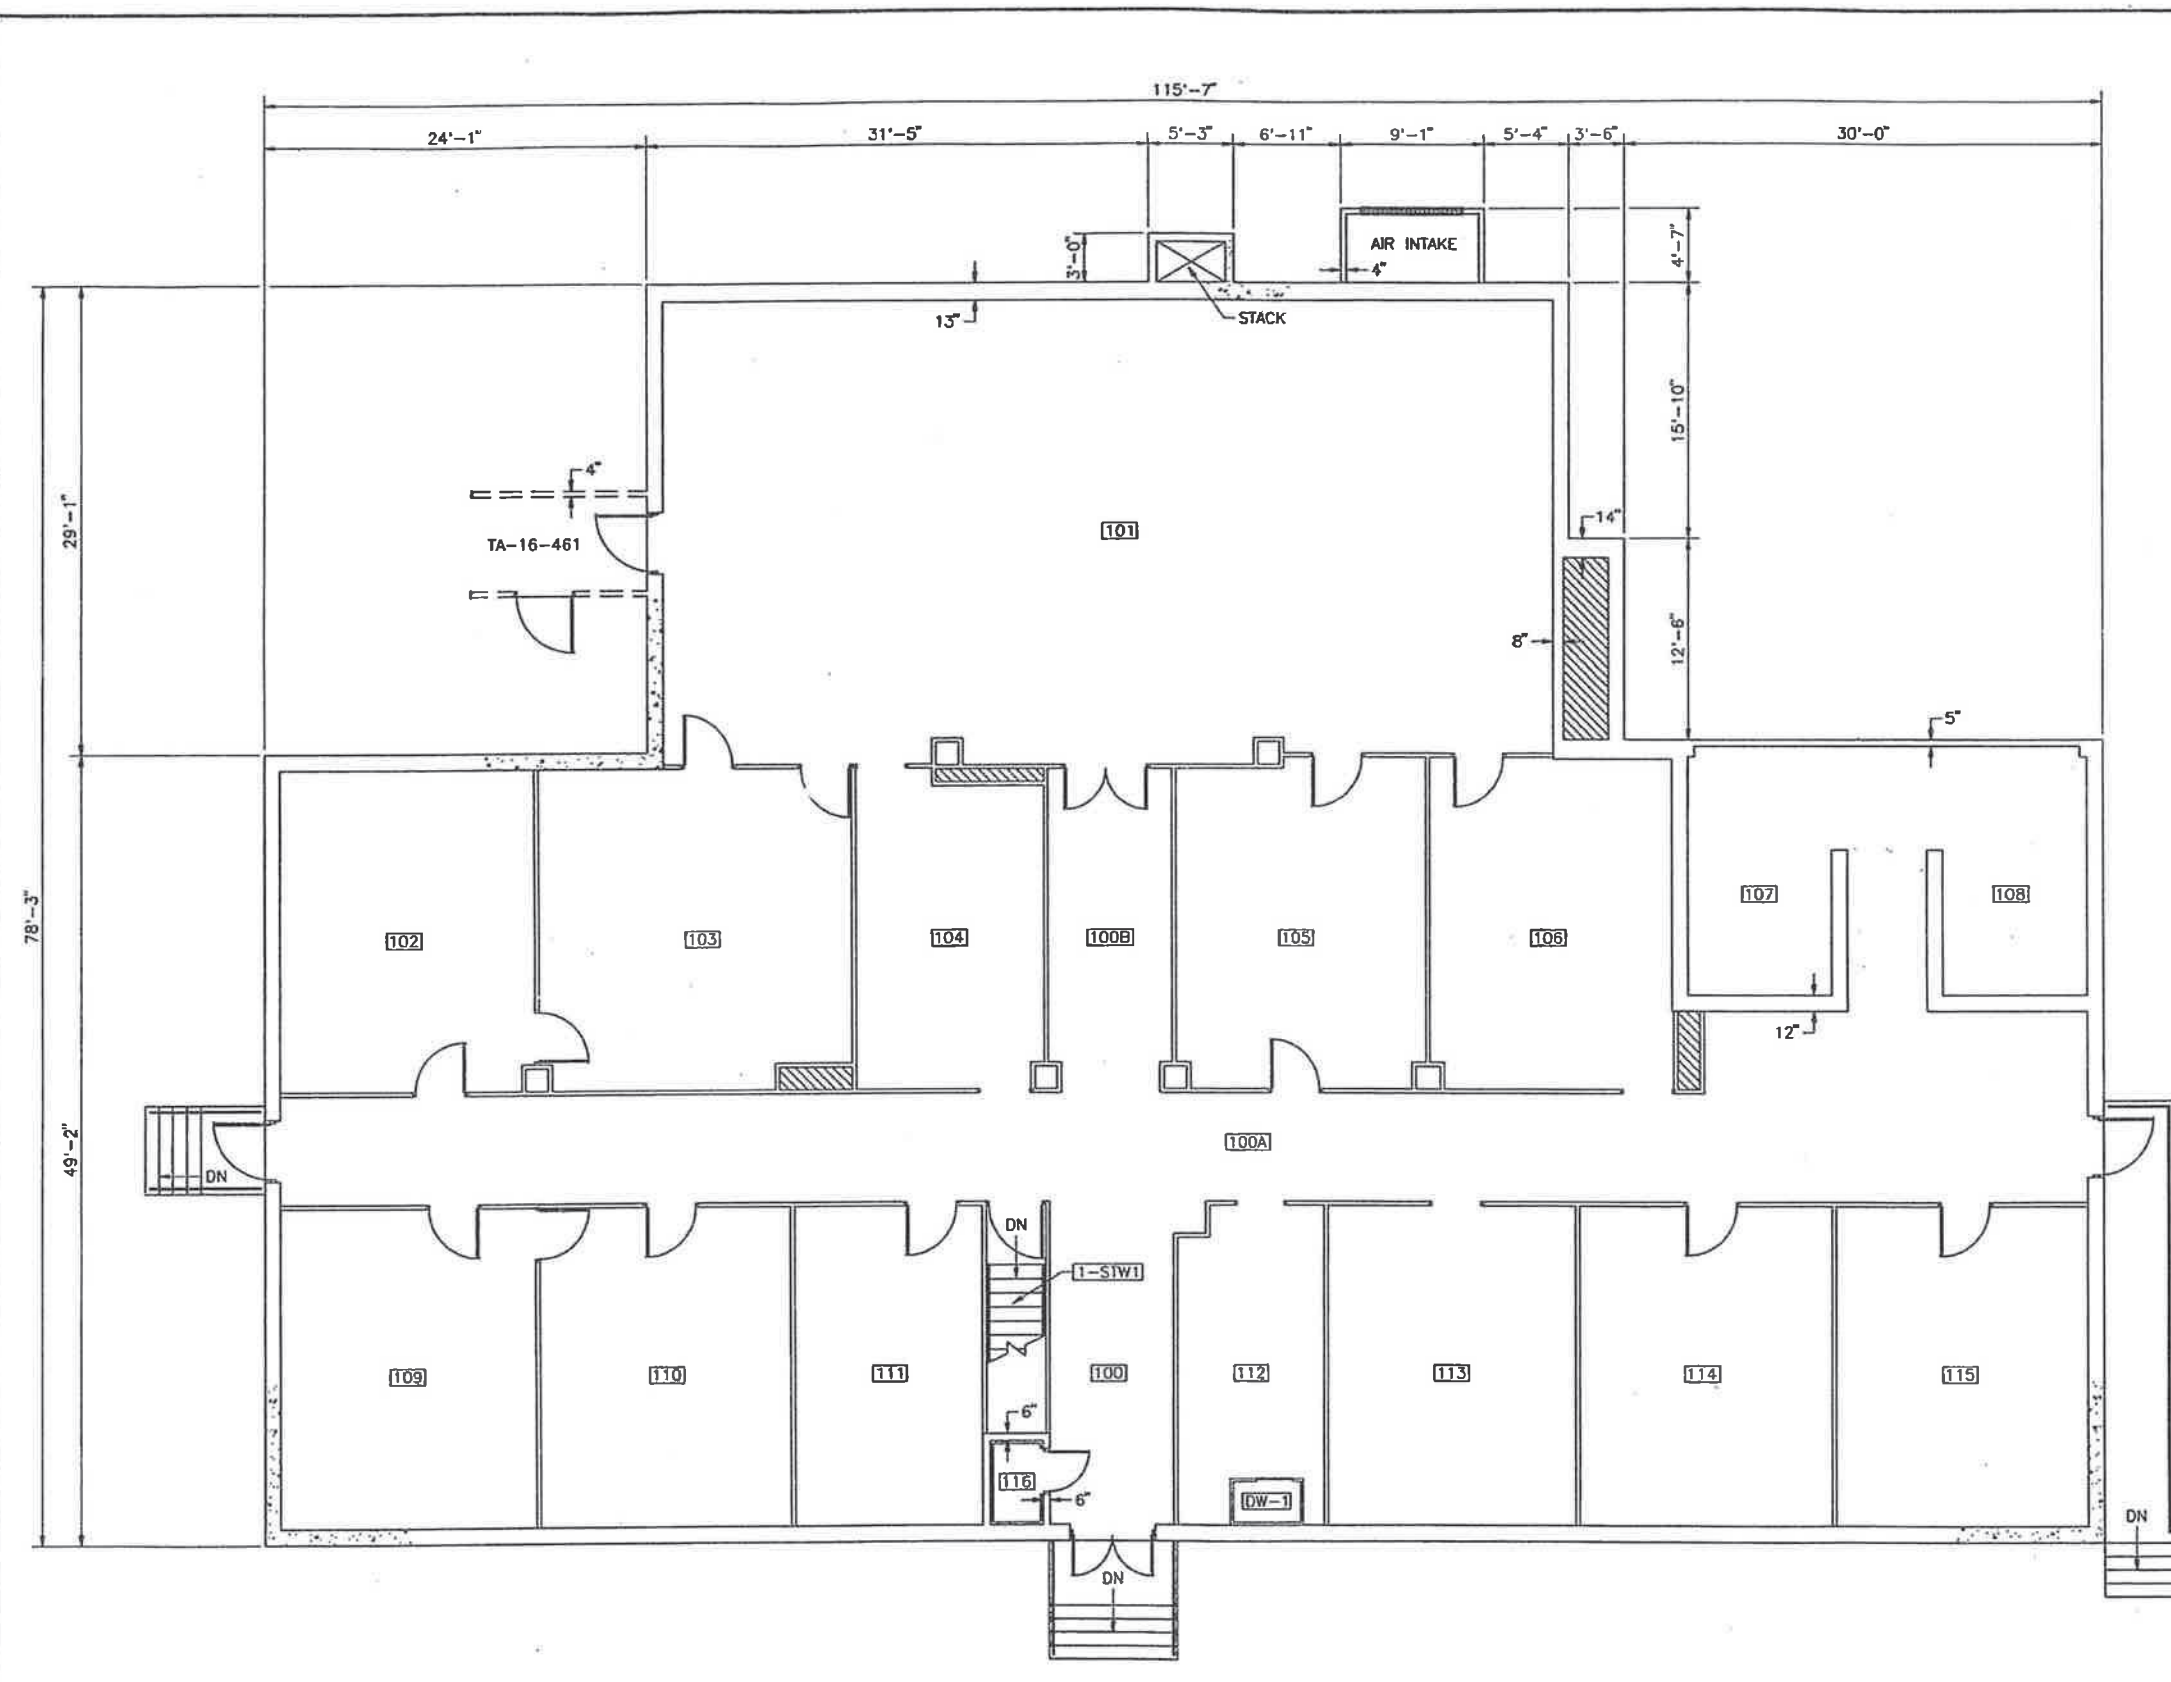


FIRST FLOOR PLAN

SCALE: 3/16" = 1'-0"




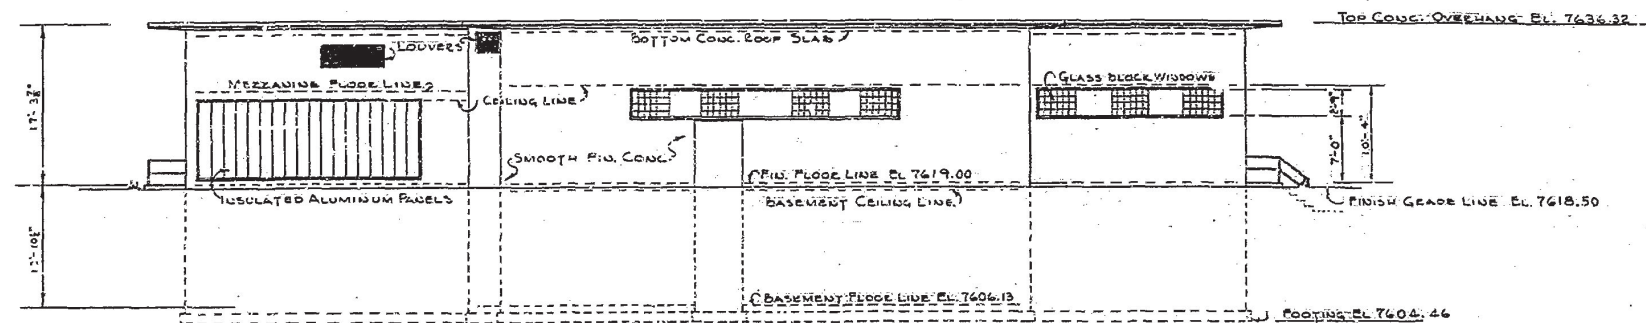


NORTHEAST ELEVATION
SCALE 1/8"=1'-0"

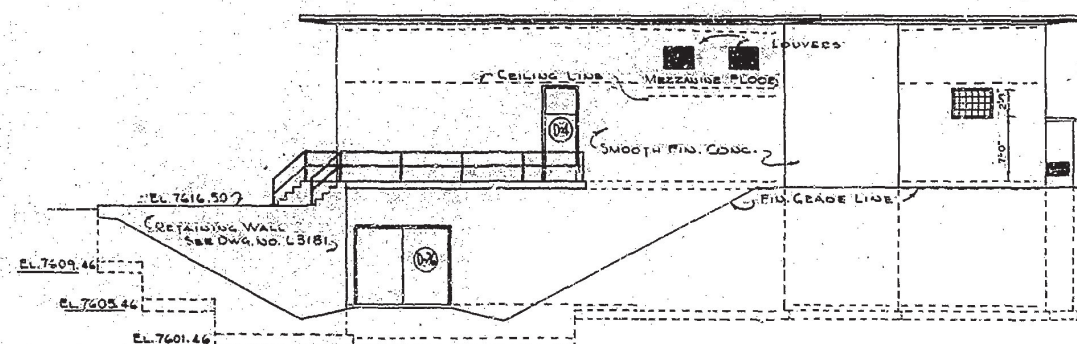

SOUTHEAST ELEVATION
SCALE 1/8"=1'-0"

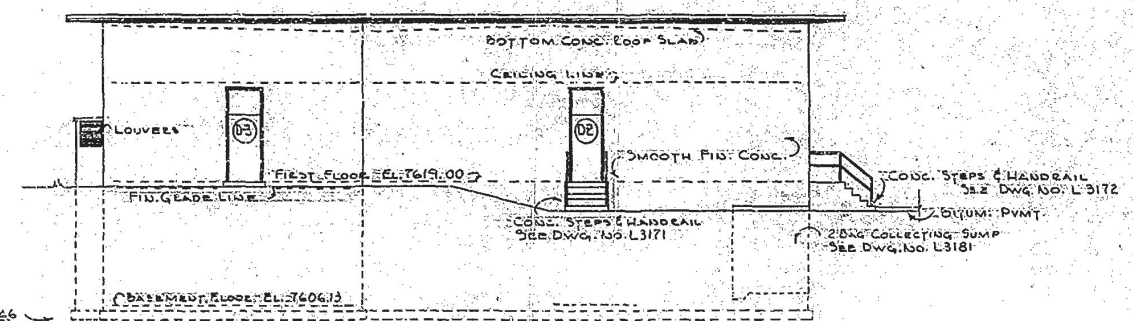

NORTHWEST ELEVATION
SCALE 1/8"=1'-0"

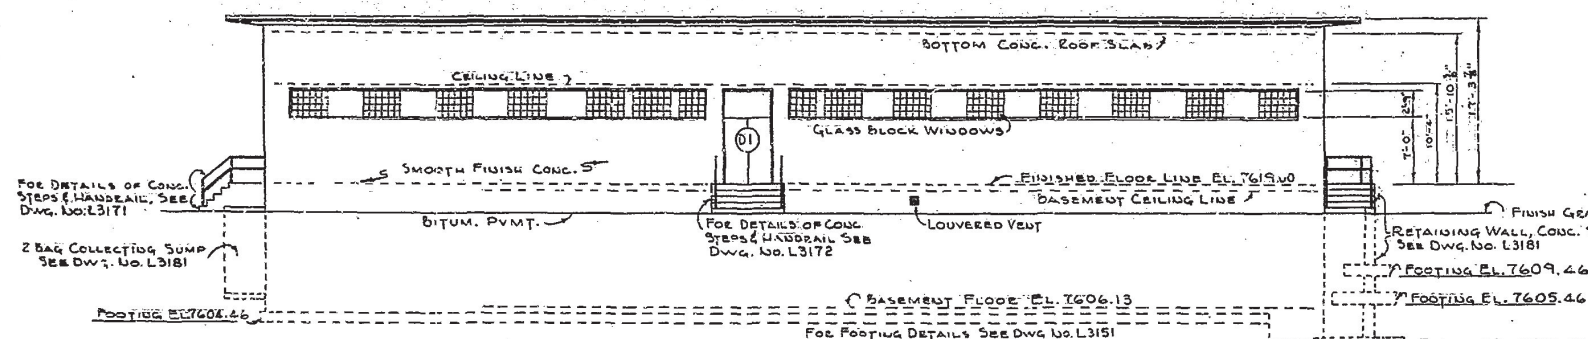

SOUTHWEST ELEVATION
SCALE 1/8"=1'-0"

AS CONSTRUCTED DRAWING
CONSTRUCTION CONTRACT NO. 7(2-2-1) 1207
SUBMITTED *K.D. Jolley*
RECOMMENDED *[Signature]*
APPROVED *[Signature]*

David Charles Keller
Digitally signed by David Charles Keller
Date: 2023.01.09 10:59:44 -0700

Verified Unclassified, EPC-ES

FOR OFFICIAL USE ONLY

THIS IS AN OFFICIAL DOCUMENT OF THE UNITED STATES. IT MAY NOT BE PUBLISHED, REPRODUCED, OR USED FOR OTHER THAN OFFICIAL PURPOSES WITHOUT THE PRIOR WRITTEN CONSENT OF THE UNITED STATES ATOMIC ENERGY COMMISSION AND IS SUBJECT TO PENALTY FOR VIOLATION UNDER THE LAWS OF THE UNITED STATES.

NO.	DATE	REVISED	TITLE - Building Numbers Added	BY	CHK.	PROJ. A.E.C.
1	12-30					
U.S. ATOMIC ENERGY COMMISSION						
SANTA FE OPERATIONS OFFICE						
LOS ALAMOS, NEW MEXICO						
ARCHITECTURAL BUILDING (141-1)						
ELEVATIONS						
T.A-16 PROJECT "I"						
FILE NO. 2984						
BLACK & VEATCH CONSULTING ENGINEERS KANSAS CITY, MISSOURI						
SFA-KG-L3121 10 86						

LANL TA- Building # 16-0463

Camera 98424

Frame #s DCP-0356 through DCP_0360

Surveyor(s) S. McCarthy, B. McCormick, K. Garcia, E. McGehee; C. Townsend, K. Garcia

Date 7/22/2002; 1/31/2020

**Los Alamos National Laboratory
Historic Building Survey Form**

Building Name Rest House, HE Storage UTM's easting 377826 northing 3967678 zone 13
Legal Description: Map Frioles Quad tns 19N range 6E sec 30
Current Use/ Function Vacant Original Use/ Function Rest House, HE Storage
Date (estimated) Date (actual) 1966 Property Type Laboratory/Processing

Type of Construction

Pre-Engineered ☐ Steel Frame ☐ Wood Frame ☐ CMU ☒ Reinforced Concrete ☒

Other Type of Construction # of Stories 1

Foundation Reinforced Concrete

Exterior CMU-Exterior ☒ Reinforced Concrete-Exterior ☐ Steel (galvanized) ☐ Steel (corrugated) ☐
Wood Siding ☐ Asbestos Shingles-Exterior ☐ In-Fill Panels ☐ Other-Exterior

Exterior Treatment (painted, stuccoed, etc) Painted

Exterior Features (docks, speakers, lights, signs, etc) Inset loading dock with exposed steel roof joists, dock lighting, speakers, and alarms.

Addition CMU-Addition ☐ Reinforced Concrete-Addition ☐ Steel (galvanized)- Addition ☐ Wood ☐
Steel (corrugated)-Addition ☐ Asbestos Shingles-Addition ☐ Other- Addition

Exterior Treatment-Addition

Exterior Features-Addition

Roof Form Slanted/Shed ☐ Gable ☐ Other Roof Type Flat with interior roof drains

Degree of Pitch/ Slope Slight

Roof Materials Corrugated Metal ☐ Rolled Asphalt ☐ Asbestos Shingles ☐ 4-Ply Built Up ☒
Other Roof Materials Built-up

Window Type Casement ☐ Single Hung Sash ☐ Double Hung Sash ☐ Fixed Window ☐
Other Window Type

of Each Window Type/ Comments None

Glass Type Clear ☐ Wire Glass ☐ Opaque ☐ Painted Glass ☐ Glass Block ☐

Light Pattern

Door Type Personnel Door Types Exterior Fire Door ☐ Single ☐ Double ☒ Roll-up ☐ Sliding ☐

		Hollow Metal <input checked="" type="checkbox"/>	Solid Wood <input type="checkbox"/>	1/2 Glazed <input type="checkbox"/>	Paneled <input type="checkbox"/>
		Louvered <input type="checkbox"/>	Painted <input checked="" type="checkbox"/>		
	Interior	Fire Door <input type="checkbox"/>	Single <input checked="" type="checkbox"/>	Double <input type="checkbox"/>	Roll-up <input type="checkbox"/> Sliding <input type="checkbox"/>
		Hollow Metal <input checked="" type="checkbox"/>	Solid Wood <input type="checkbox"/>	1/2 Glazed <input type="checkbox"/>	Paneled <input type="checkbox"/>
		Louvered <input type="checkbox"/>	Painted <input type="checkbox"/>		
Equipment Door Types	Exterior	Fire Door <input type="checkbox"/>	Single <input type="checkbox"/>	Double <input type="checkbox"/>	Roll-up <input type="checkbox"/> Sliding <input type="checkbox"/>
		Hollow Metal <input type="checkbox"/>	Solid Wood <input type="checkbox"/>	1/2 Glazed <input type="checkbox"/>	Paneled <input type="checkbox"/>
		Louvered <input type="checkbox"/>	Painted <input type="checkbox"/>		
	Interior	Fire Door <input type="checkbox"/>	Single <input type="checkbox"/>	Double <input type="checkbox"/>	Roll-up <input type="checkbox"/> Sliding <input type="checkbox"/>
		Hollow Metal <input type="checkbox"/>	Solid Metal <input type="checkbox"/>	1/2 Glazed <input type="checkbox"/>	Paneled <input type="checkbox"/>
		Louvered <input type="checkbox"/>	Painted <input type="checkbox"/>		

of Each Door Type/Comments:

Interior Wall Gypsum Board ☐ Reinforced Concrete- Interior ☐

CMU- Interior ☒ Plywood ☐ Other- Interior

In-Wall Electrical Wiring ☐ On-Wall Electrical Wiring ☒

Ceiling Drop Ceiling ☐

Interior Comments (Equipment, etc)

Degree of Remodeling

Condition Excellent ☐ Good ☐ Fair ☒ Deteriorating ☐ Contaminated ☐ Burned ☐

Associated Buildings ☒

If yes, list building names and #s

Integrity

Significance

Eligible Under Criterion A ☒ B ☐ C ☐ D ☐ Not Eligible ☐

DOE Themes

Nuclear Weapon Components and Assembly <input checked="" type="checkbox"/>	Nuclear Weapon Design and Testing <input checked="" type="checkbox"/>	Nuclear Propulsion <input type="checkbox"/>
Peaceful Uses: Plowshare, Nuclear Medicine, Nuclear Energy, Nuclear Science <input type="checkbox"/>	Energy and Environment: Research and Design Projects <input type="checkbox"/>	

LANL Themes

Weapons Research and Design, Testing, and Stockpile Support <input checked="" type="checkbox"/>	Super Computing <input type="checkbox"/>
Reactor Technology <input type="checkbox"/>	Biomedical/Health Physics <input type="checkbox"/> Strategic and Supporting Research <input type="checkbox"/>
Environment/Waste Management <input type="checkbox"/>	Administration and Social History <input type="checkbox"/> Architectural History <input type="checkbox"/>

Recommendations/ Additional Comments

Architectural Features (elevations)

TA-16-0463 was a one-story building. Rectangular-in-plan, it measured 14 feet 8 inches by 24 feet 8 inches, encompassed approximately 169 square feet, and was oriented northeast by southwest. Built on a 3-foot-high poured-in-place reinforced concrete foundation, the walls were constructed of CMUs. The nearly flat roof was constructed of steel joists atop a bond beam and was clad in fiber-strand boards. The southwest façade featured a deeply inset dock accessed by concrete stairs with metal-pipe railings. Adjacent to the stairs in the exterior of the foundation were dock bumpers. Access into the building from the dock was provided by paired, metal-panel personnel doors. The northwest façade featured a single, metal-panel personnel door. On its northeast end, the facility was connected to facility TA-16-0461, a covered passageway. The southeast side of the building features an adjacent and earthen-filled ARMCO bin. The Laboratory completed drawings for TA-16-0463, a high-explosives storage facility, in June 1966. TA-16-0463 had structural integrity, and the exterior was in fair condition. Its architectural design was influenced by the International Modernist architectural style, and character-defining features included geometrical massing, lack of ornament, flat roof, continuous surface planes, and unornamented doors.

Total sq ft 169 net

Architect/ Builder Contractor: The Zia Company

Alterations

List of Selected Drawings (Cntrl + Enter for paragraph break)

- ENG C-31940
Sheet 2 of 10
TA-16, Bldg 16-463
Plan, Elevation & Sections
January 24, 1966
- ENG-R 575
Sheet 1 of 1
TA-16, Bldg 16-463
Floor Plan
June 10, 1966
- ENG-R 575
Sheet 1 of 1
TA-16, Bldg 16-463
Floor Plan
June 10, 1966
Revised to status of January 31, 2020



TA-16-463 Southwest elevation







TA-16-463 Southeast elevation



TA-16-463 Northwest elevation




TA-16-463 Northeast elevation

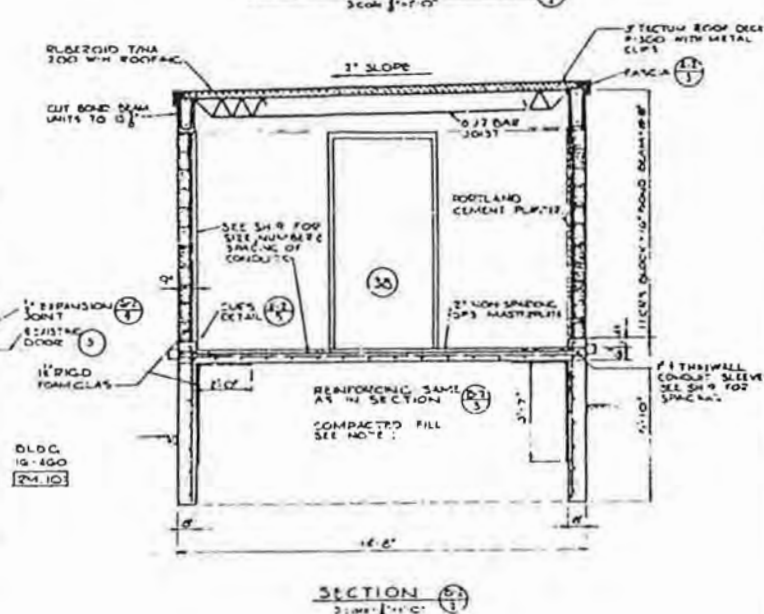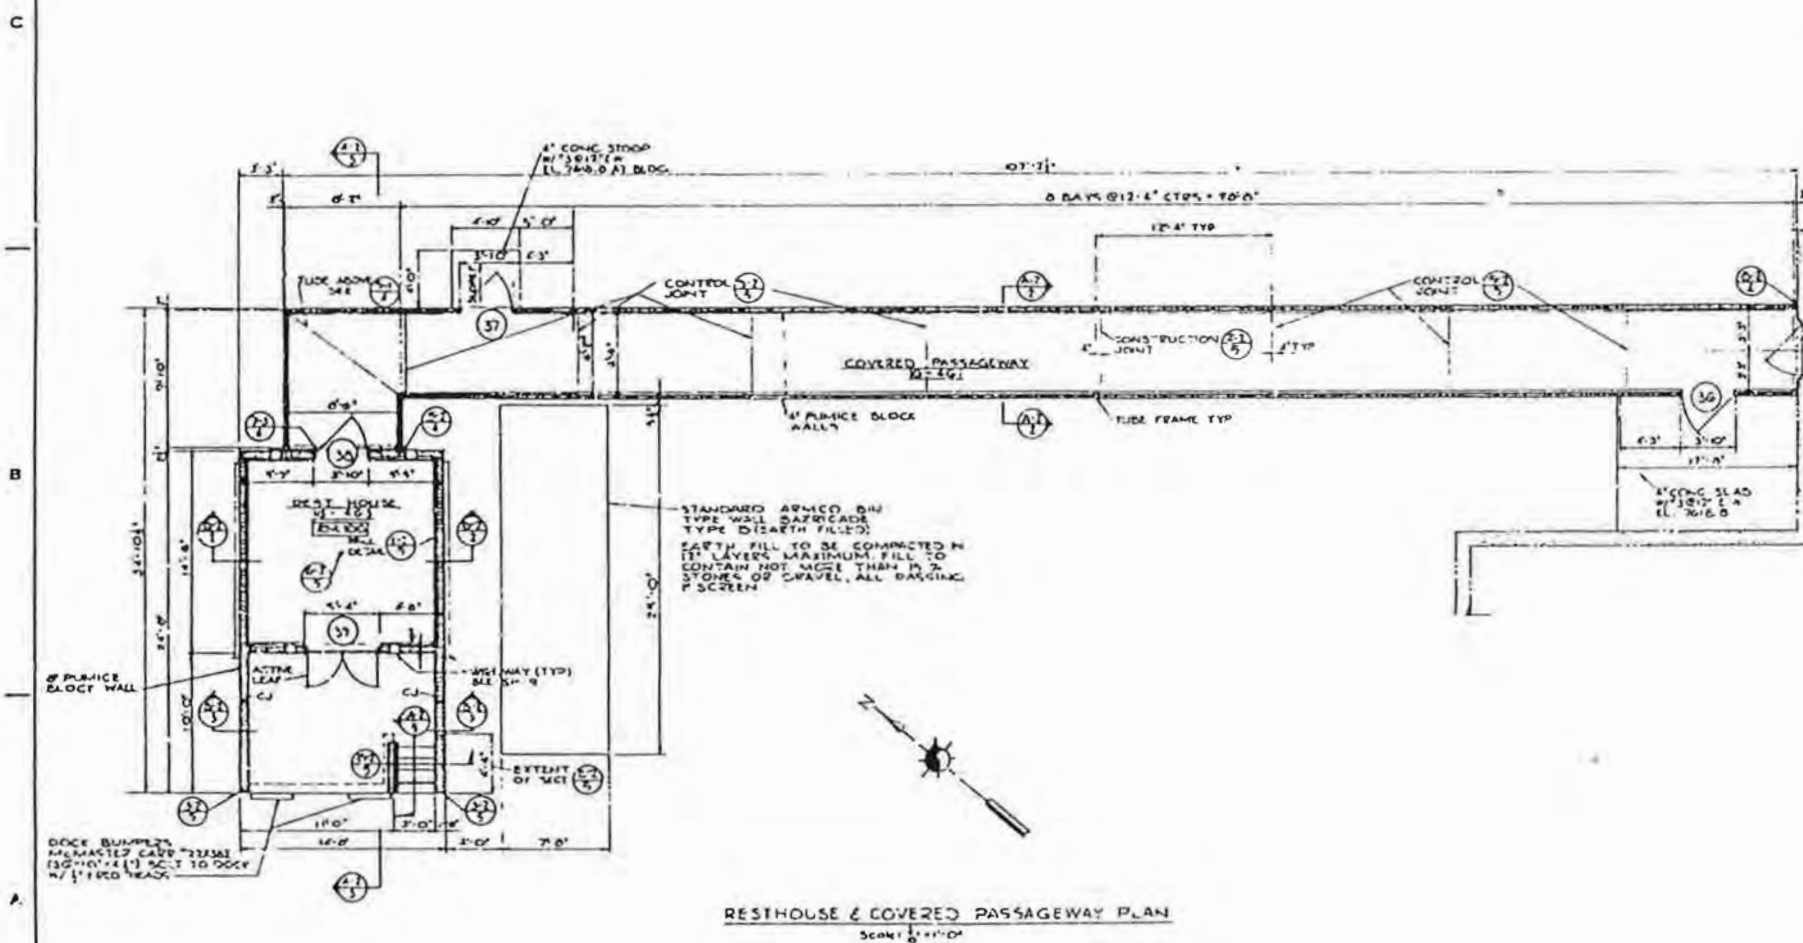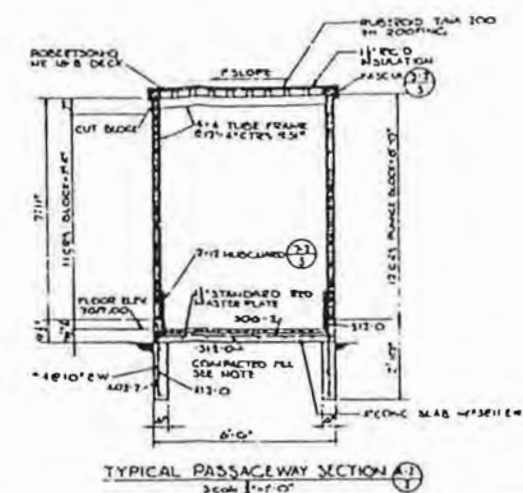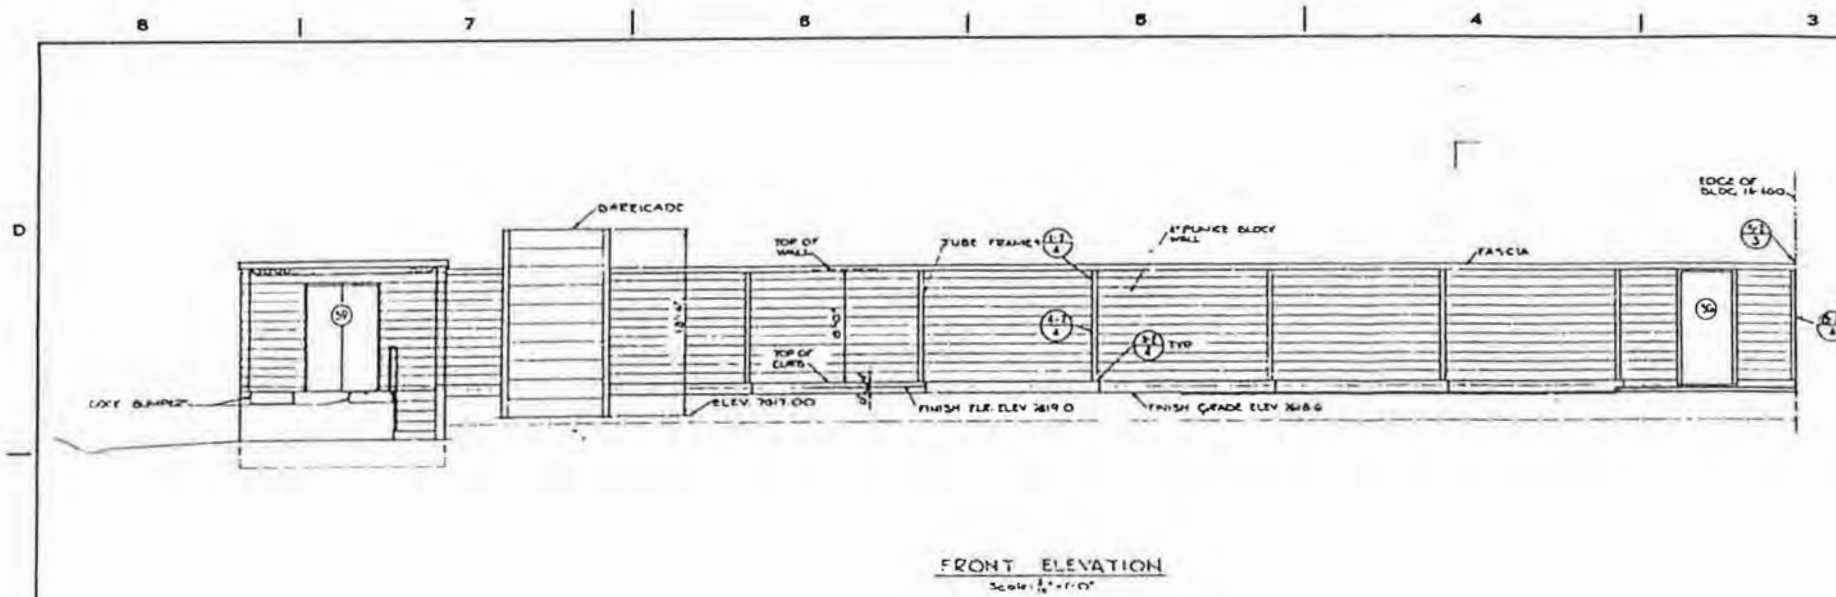

THIS JOB MUST BE CONFIDENTIAL
AND ANY CHANGES APPROVED
BY ENCL
SIA LINE THREE 3568

AUTHORIZED FOR HEALTH N.A. SAFETY C.B. FIRE PROT. C.B. REC'D		LOS ALAMOS SCIENTIFIC LABORATORY ENGINEERING DEPARTMENT UNIVERSITY OF CALIFORNIA—LOS ALAMOS, NEW MEXICO RESTHOUSE & COVERED PASSAGEWAY PLAN, ELEVATION & SECTIONS 6-DC 6-4015 403 SHEETS 31 L 1-24 GG 2 OF 10 C.A. NO. _____ E.A. NO. _____ L.J. NO. 2321-16		TA-10 DIRECTOR S. W. LOR ENG-C-31940
--	--	---	--	---

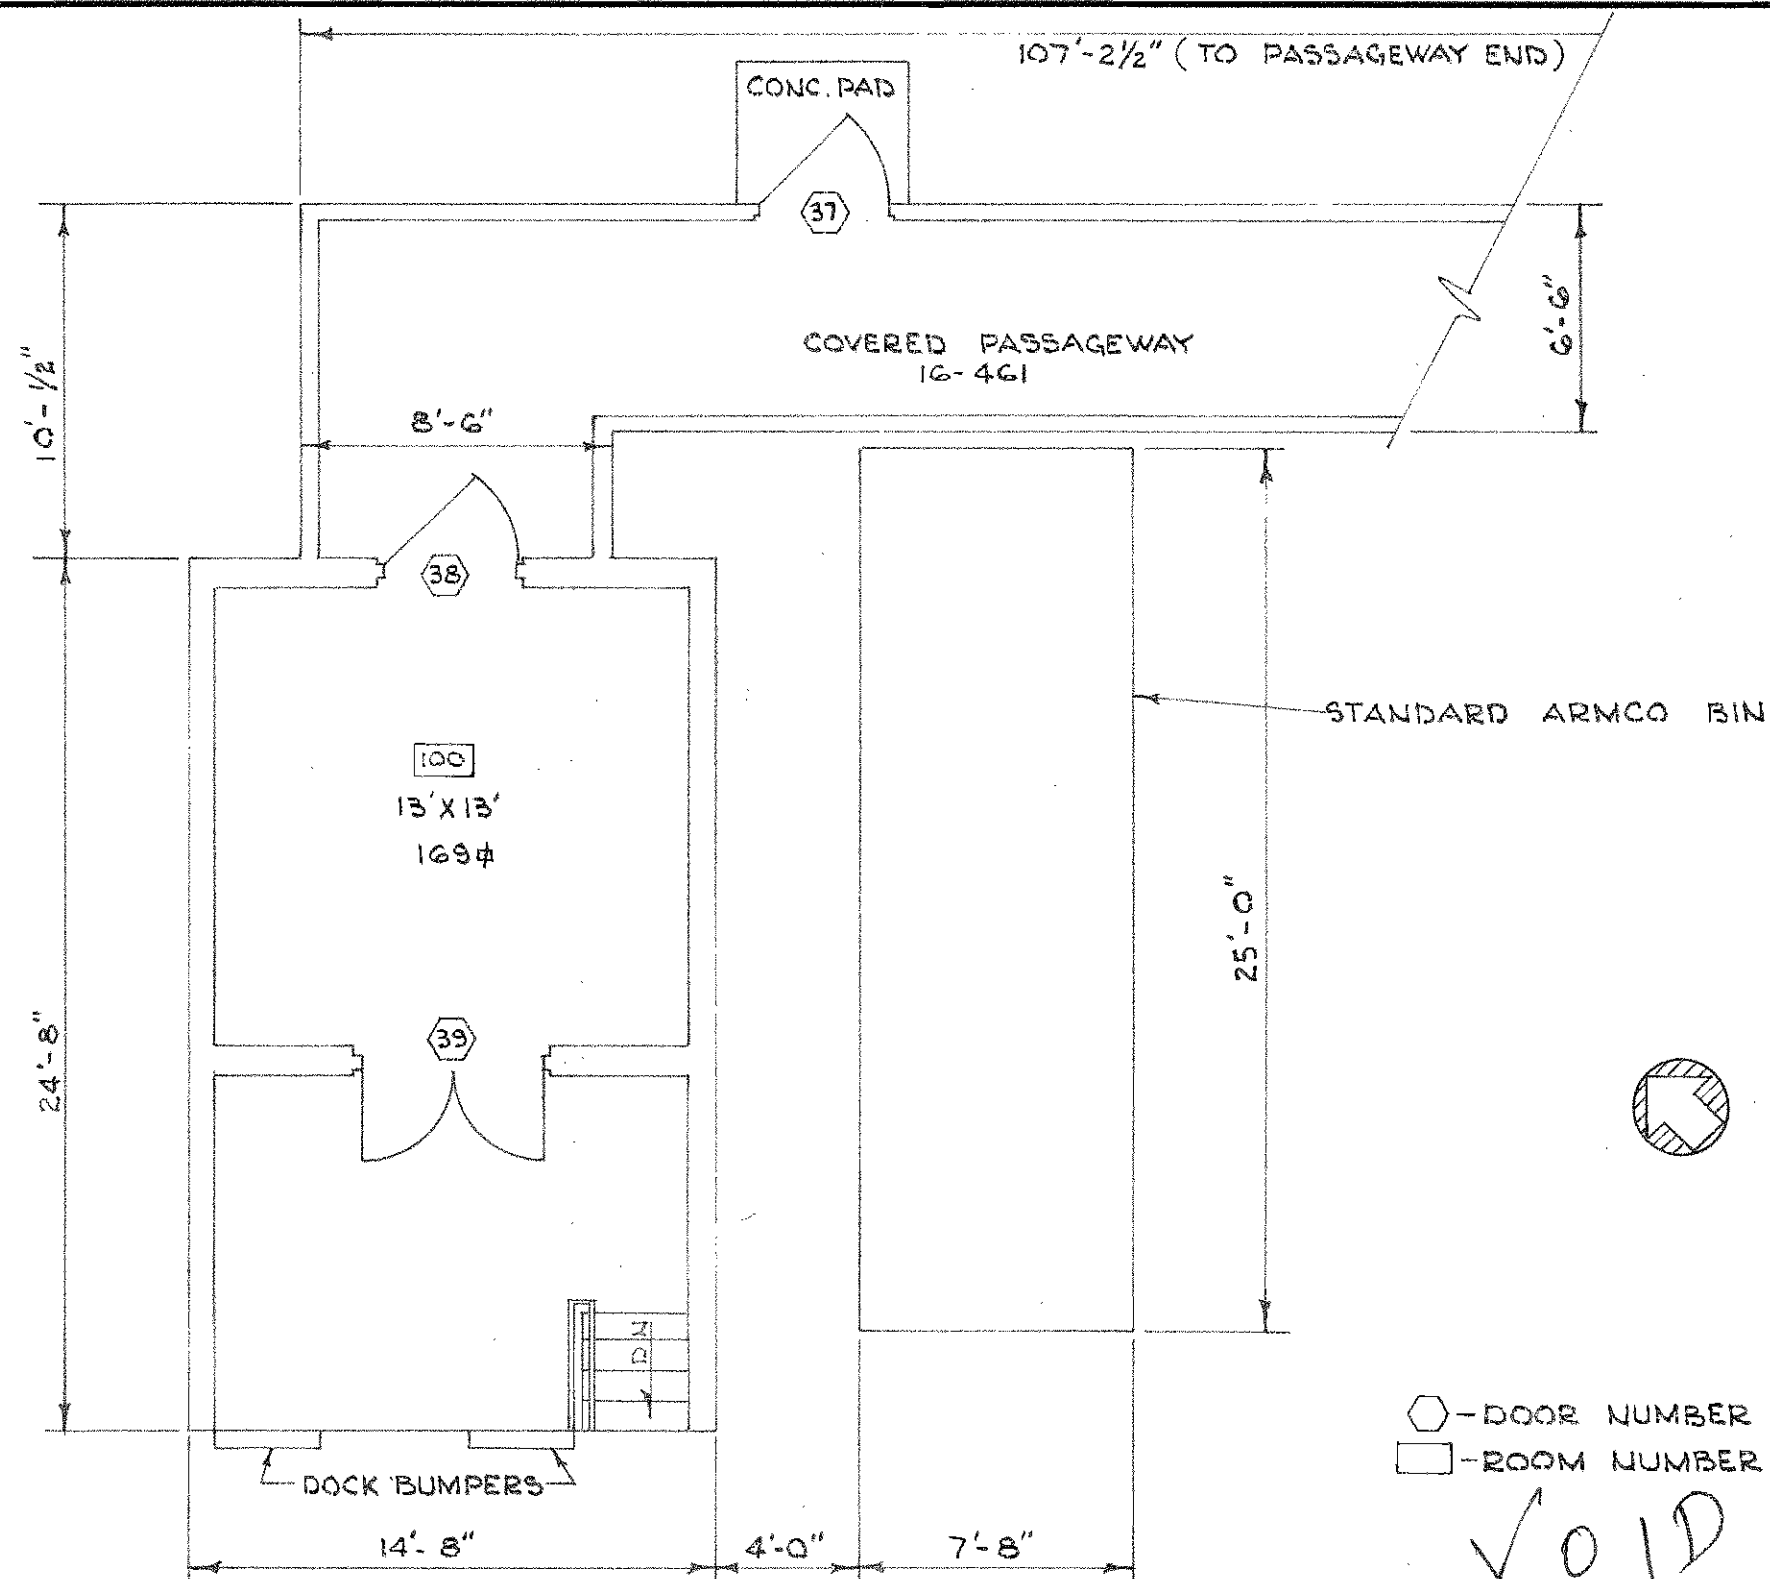

TOTAL SQ. FT. - 169

LOS ALAMOS SCIENTIFIC LABORATORY
 ENGINEERING DEPARTMENT
 UNIVERSITY OF CALIFORNIA — LOS ALAMOS, NEW MEXICO


FLOOR PLAN
 BLDG. 16-463 TA-16

AUTHORIZED FOR	
HEALTH	
SAFETY	
FIRE PROT.	
SEC.	


APPROVALS:
 ENG. GROUP: 3 *SEP*
 DIVISION: *SEP*
 ENG. DEPT. OFFICE: *SEP*

DESIGN:
 DESIGNER: TRASK
 PROJ. ENG.: *T. Trask*


DATE 6-10-66	SCALE 3/16" = 1'-0"
SHEET 1 OF 1	SKETCH NO. ENG. R-575

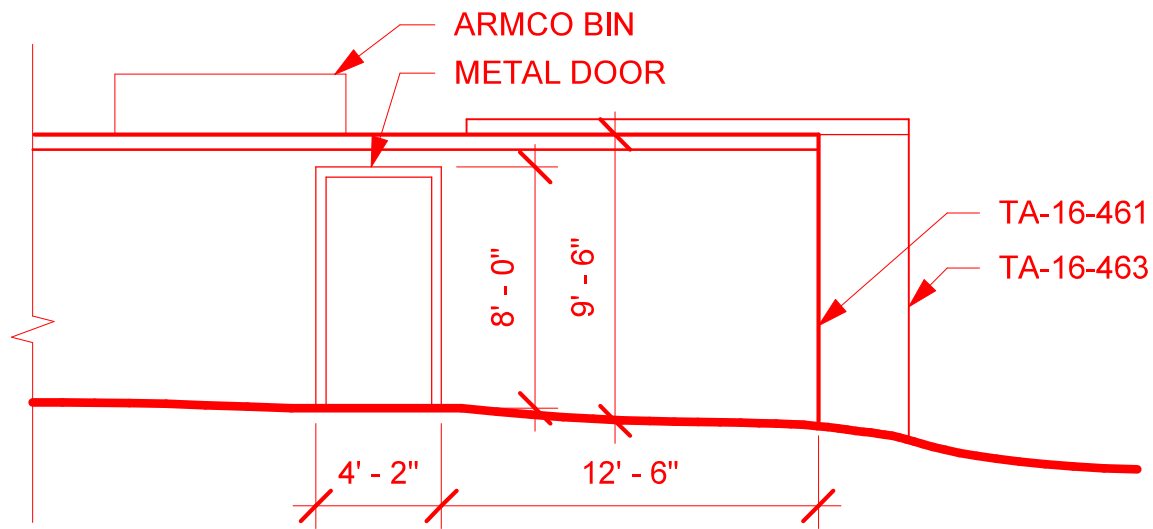


NORTHEAST ELEVATION

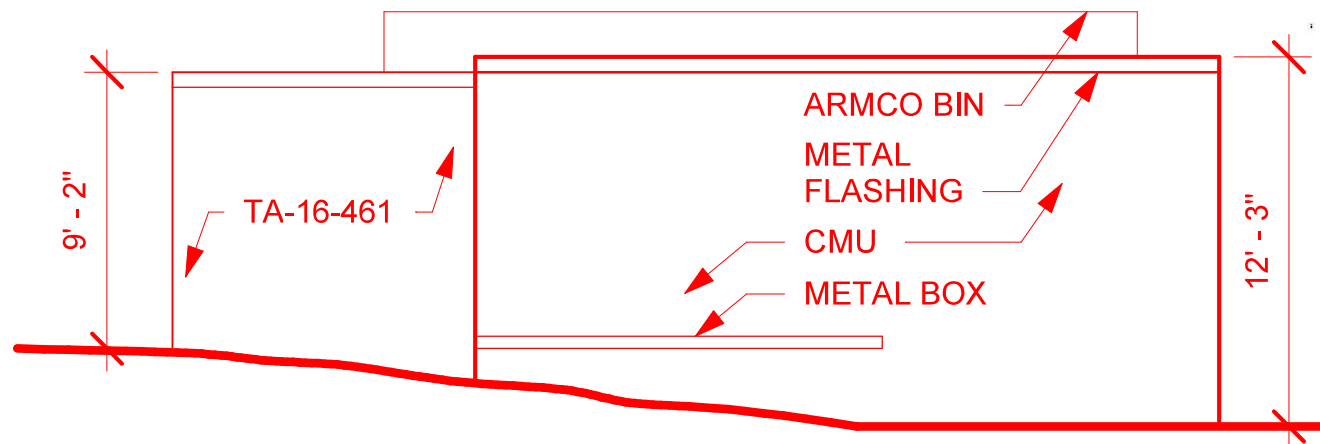

NORTHWEST ELEVATION

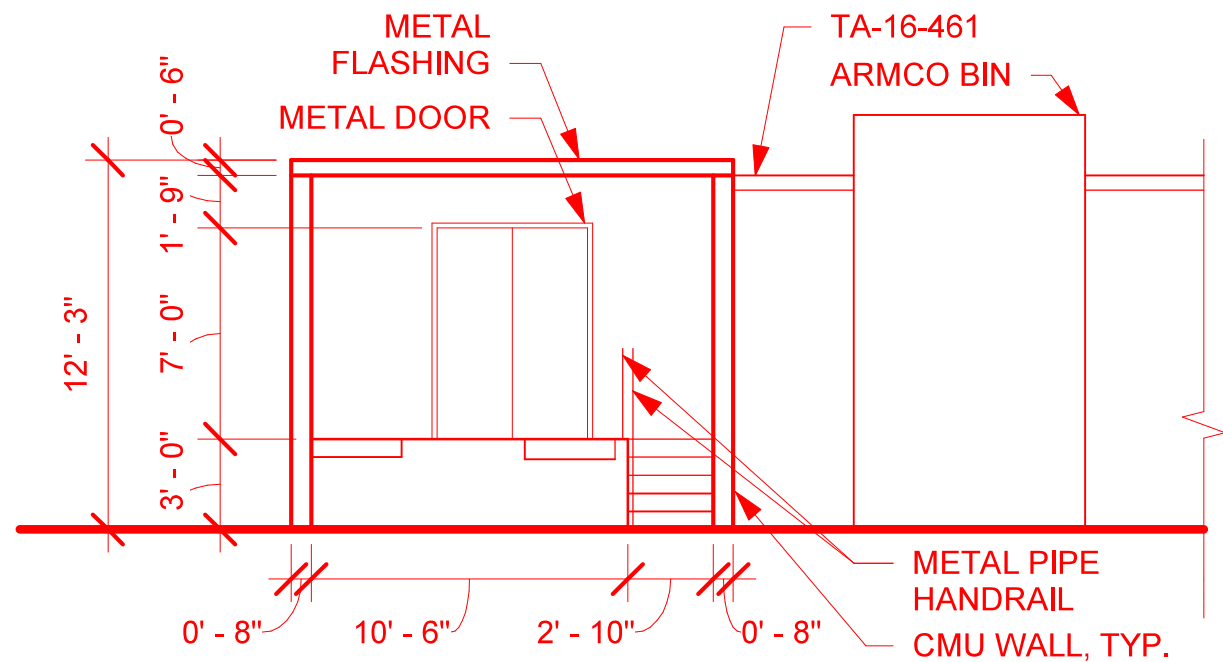

SOUTHWEST ELEVATION

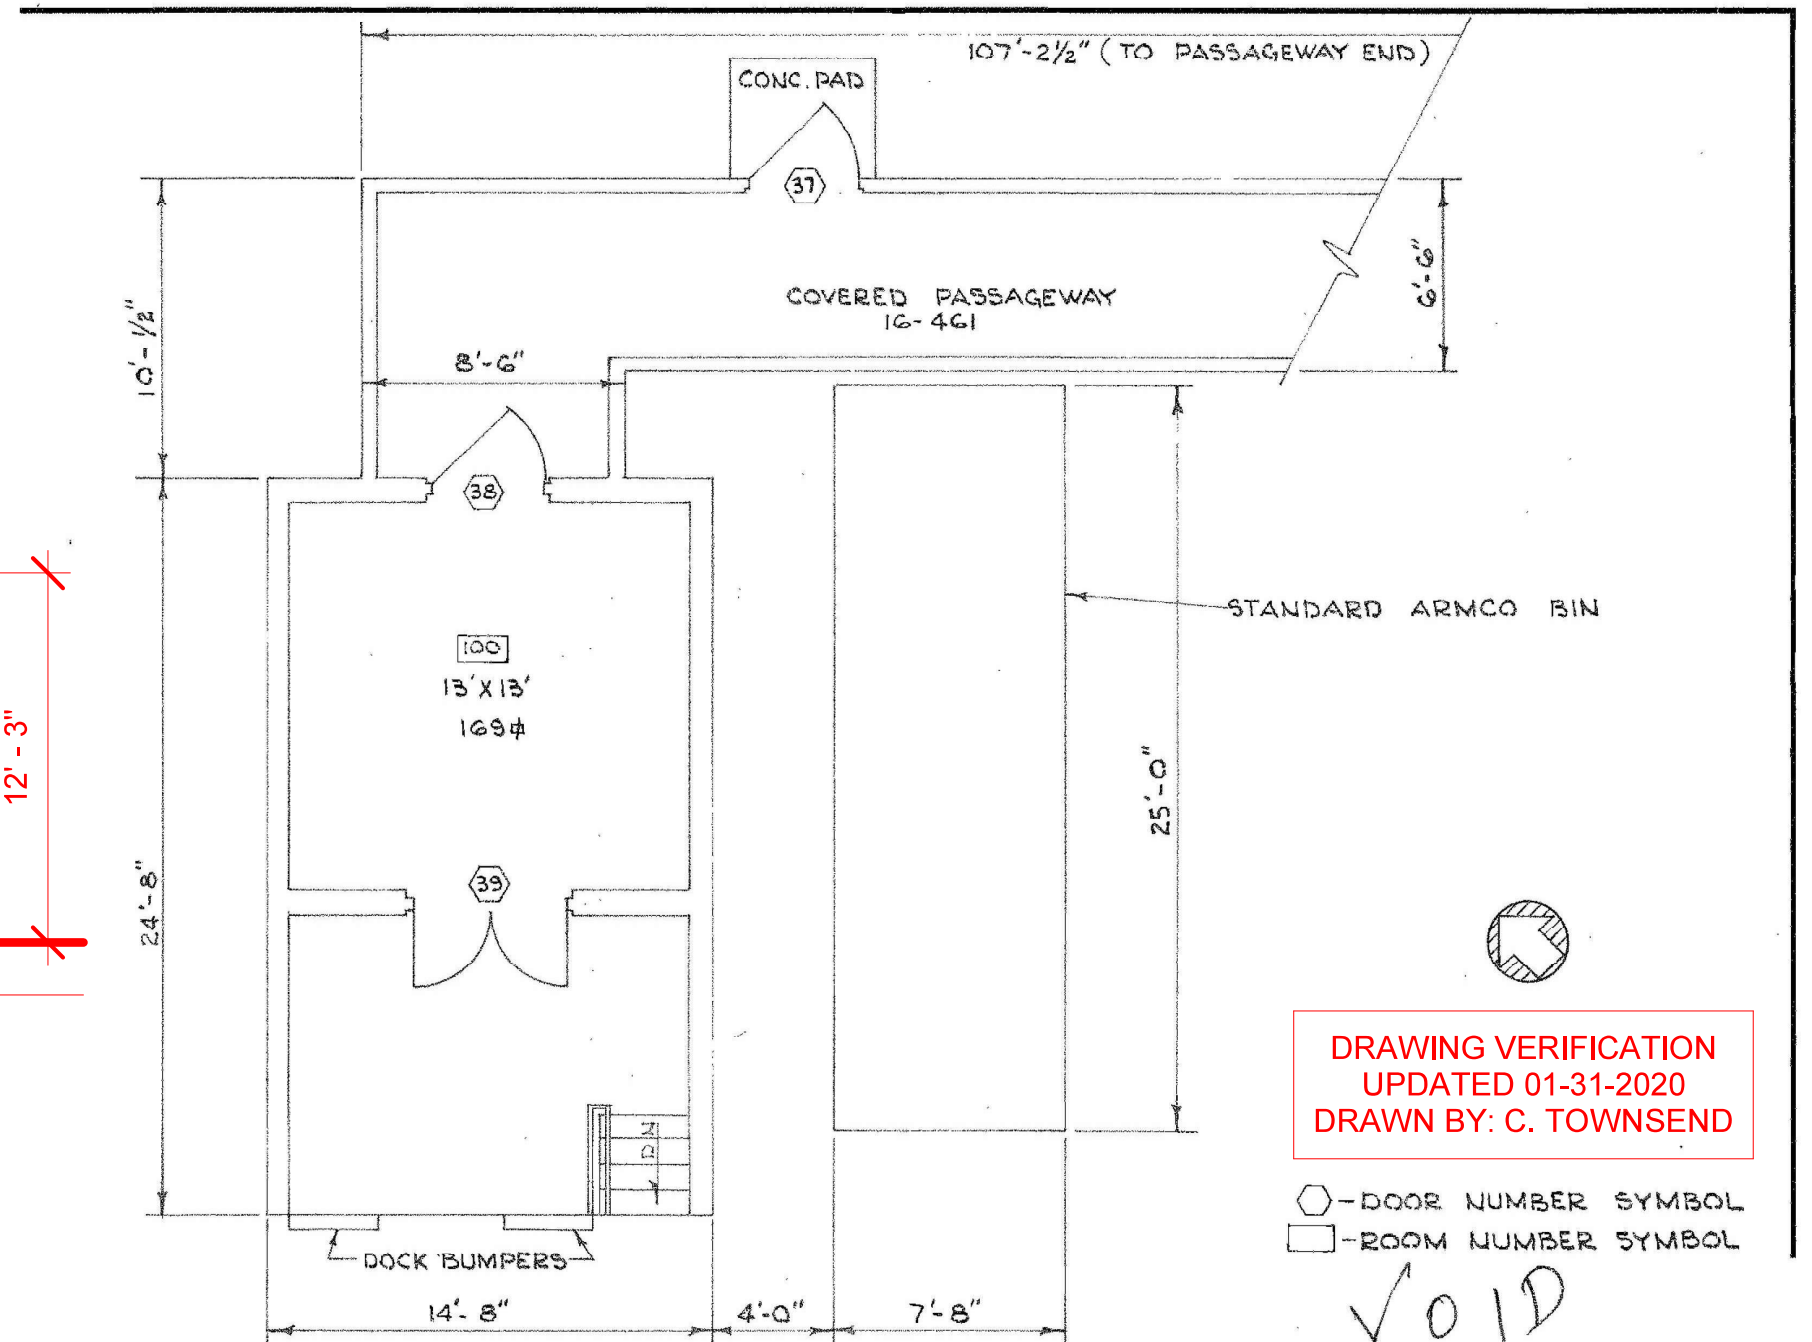

LOS ALAMOS SCIENTIFIC LABORATORY		FLOOR PLAN	
ENGINEERING DEPARTMENT		BLDG. 16-463 TA-16	
UNIVERSITY OF CALIFORNIA — LOS ALAMOS, NEW MEXICO			
AUTHORIZED FOR		APPROVALS:	
HEALTH		DESIGNER: TRASK	DATE: 6-10-66
SAFETY		PROJ. ENG.: [Signature]	SCALE: 3/16"=1'-0"
FIRE PROT.		ENG. DEPT. OFFICE: [Signature]	SHEET: 1 OF 1
SEC.			SKETCH NO.: ENG. R-575

TO VAULT

INFO. SHOWN CURRENT AS OF JUNE 1966

B. A. NO. J. O. NO. LAB. JOB NO.



Appendix B: TA-16-0460 Artifact List

This page intentionally left blank

Artifacts retained from the TA-16-460 Complex


- Glass construction bricks (TA-16-460)
- Door handle “Push” lever (TA-16-462)
- Explosion Proof Phone (TA-16-463)



Appendix C: Lists of All Drawings

This page intentionally left blank

U.S. GOVERNMENT PRINTING OFFICE: 1964
Shaded areas are restricted data as
defined in the Atomic Energy Act of 1946.

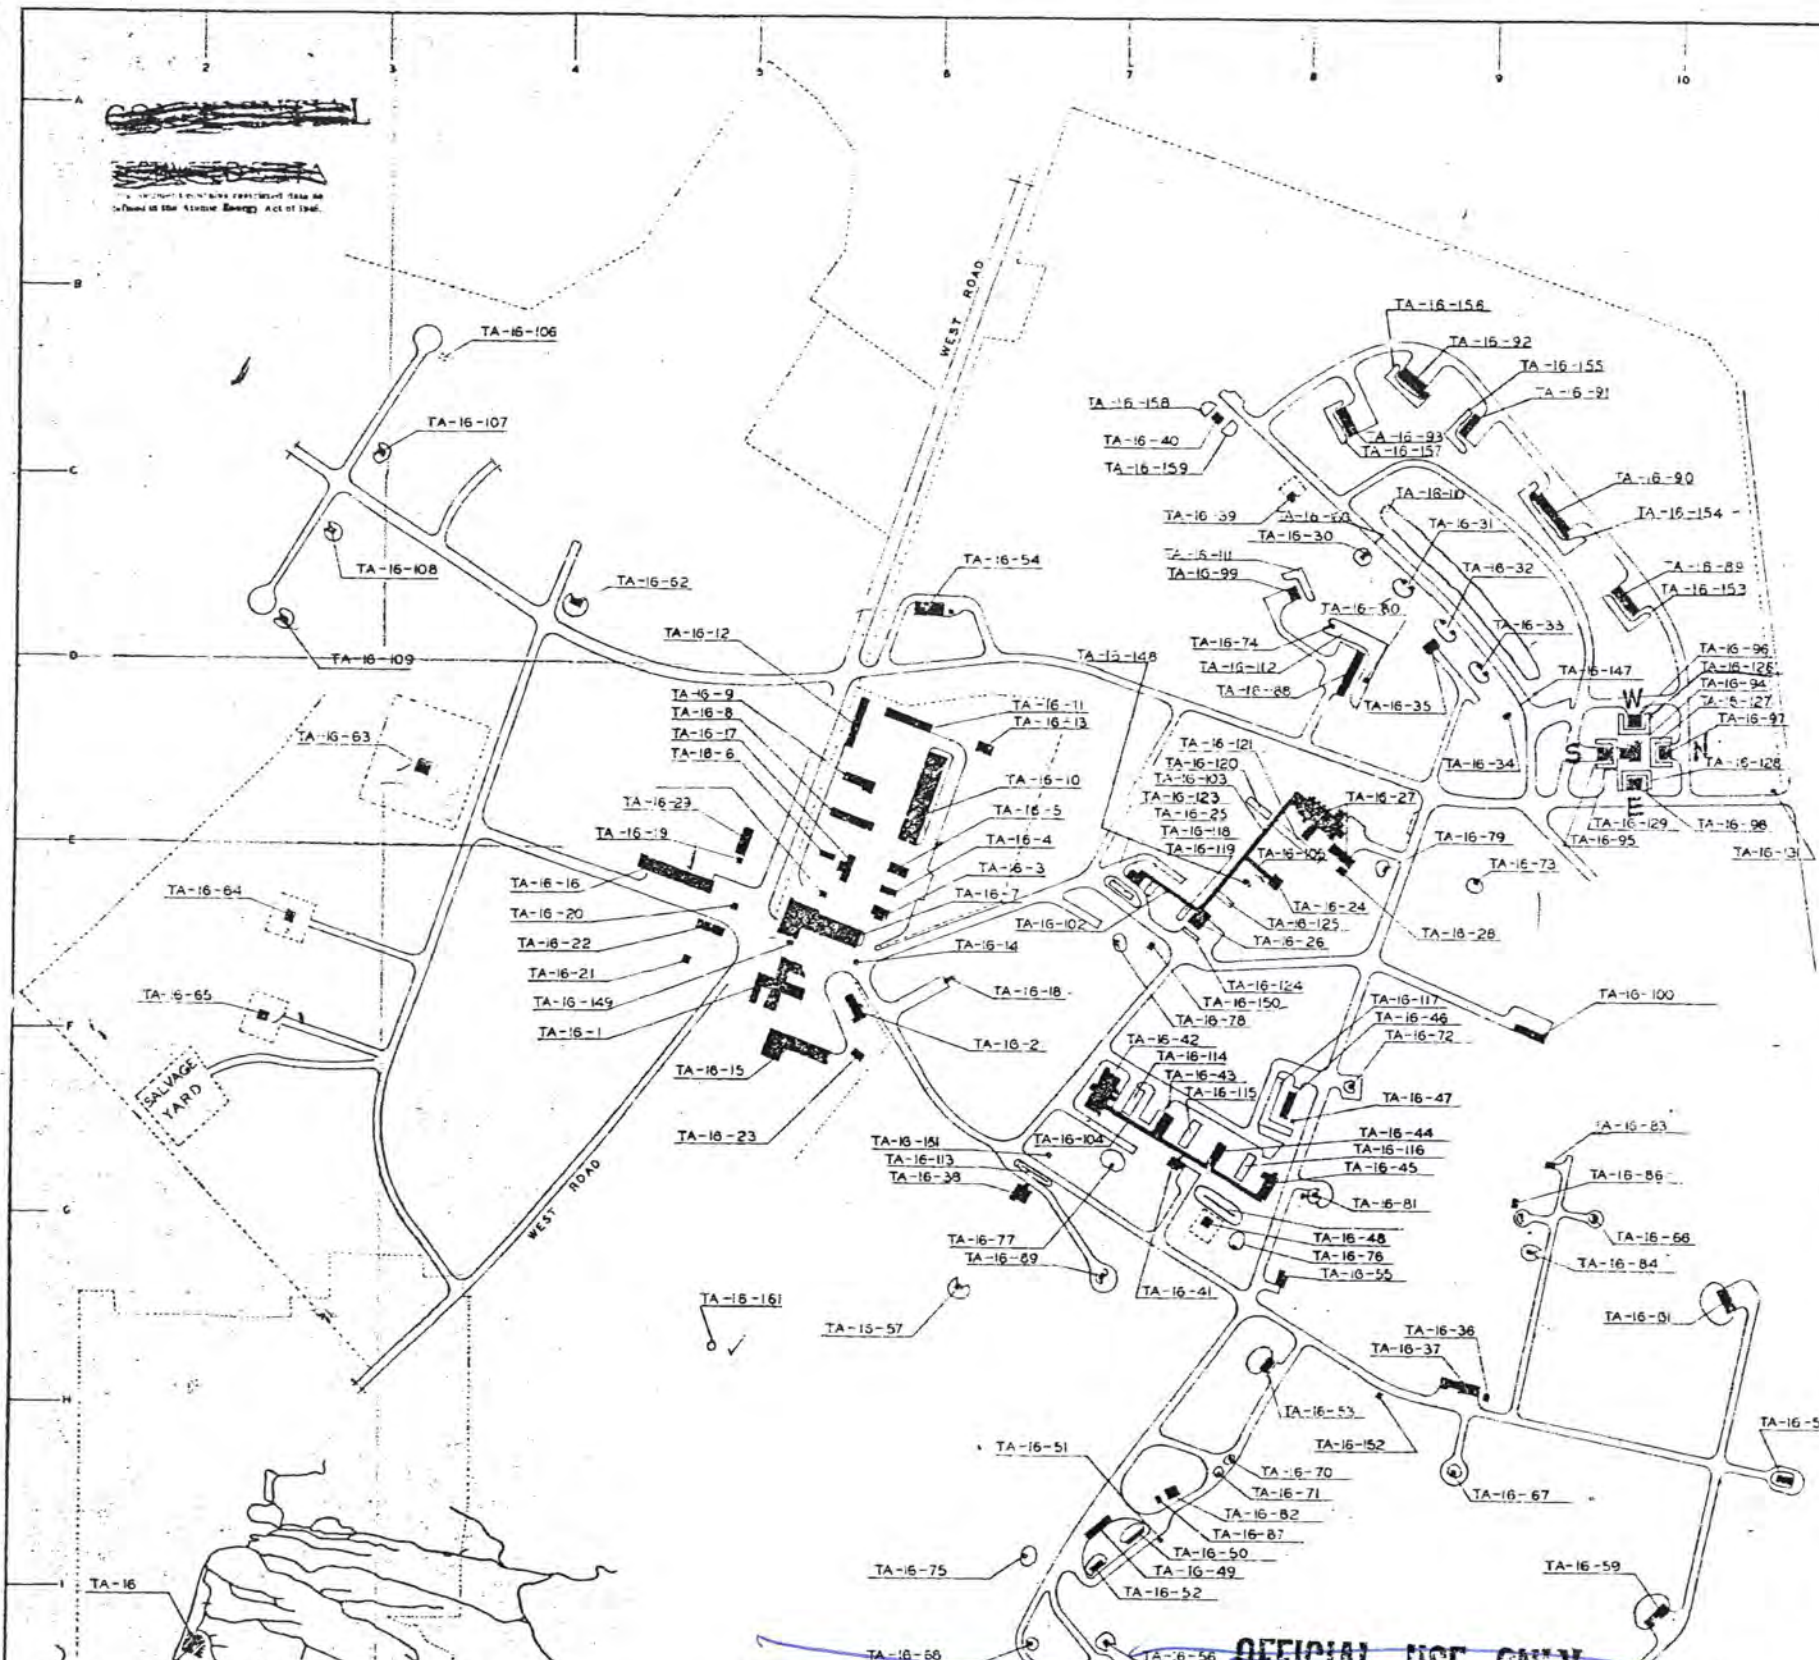

STRUCTURE NUMBER	DESIGNATION	REMARKS & FORMER DESIGNATION	STRUCTURE NUMBER	DESIGNATION	REMARKS & FORMER DESIGNATION
TA-16-1	16-1	5F ADMINISTRATION BLDG.	TA-16-82	16-82	7H STORAGE, S-91
TA-16-2	16-2	6F OFFICE	TA-16-83	16-83	9F LABORATORY, S-92
TA-16-3	16-3	6E ZIA ELEC. BLDG.	TA-16-84	16-84	9G MAGAZINE, S-93
TA-16-4	16-4	6E INFLAMMABLE STOCK STORAGE	TA-16-85	16-85	WAREHOUSE, S-94, DESTROYED
TA-16-5	16-5	6E INSTRUMENT SHOP	TA-16-86	16-86	9G LABORATORY, S-95
TA-16-6	16-6	5E ZIA REPAIR SHOP	TA-16-87	16-87	7H MACH. SHOP TRAILER, S-95A
TA-16-7	16-7	6E STEAM PLANT & MACHINE SHOP	TA-16-88	16-88	8D CASTING REST HOUSE, S-100
TA-16-8	16-8	5E ZIA CABINET SHOP	TA-16-89	16-89	9C PROCESS BLDG FORMERLY, S-101
TA-16-9	16-9	5E MOTOR POOL DISPATCH OFFICE	TA-16-90	16-90	9C PROCESS BLDG FORMERLY, S-102
TA-16-10	16-10	6E WAREHOUSE	TA-16-91	16-91	9C PROCESS BLDG FORMERLY, S-105
TA-16-11	16-11	6D OBSOLETE STORAGE, WAS S-10D	TA-16-92	16-92	9B INSPECT BLDG FORMERLY, S-101
TA-16-12	16-12	5D WAREHOUSE, WAS S-10E	TA-16-93	16-93	9C PROCESS BLDG FORMERLY, S-101
TA-16-13	16-13	6D DOCK, WAS S-10F	TA-16-94	16-94	100 EQUIP. & CONTROL, S-106
TA-16-14	16-14	6F GUARD HOUSE, WAS S-11	TA-16-95	16-95	9E MACH. BLDG, S-106 S
TA-16-15	16-15	5F LAUNDRY & LOCKER RM, WAS S-12	TA-16-96	16-96	100 MACH. BLDG, S-106 W
TA-16-16	16-16	4E CAFETERIA, WAS S-13	TA-16-97	16-97	100 MACH. BLDG, S-106 N
TA-16-17	16-17	5F PLUMBING SHOP, WAS S-14	TA-16-98	16-98	100 MACH. BLDG, S-106 E
TA-16-18	16-18	6F STEAM WASHING HOUSE, WAS S-15	TA-16-99	16-99	9F MAGAZINE, WAS S-108
TA-16-19	16-19	5E PUMP HOUSE, WAS S-16	TA-16-100	16-100	9F PROCESS BLDG WAS S-108
TA-16-20	16-20	5E WATER PUMP HOUSE, WAS S-17	TA-16-101	16-101	REVERSE
TA-16-21	16-21	5F PUMPING STATION, WAS S-17A	TA-16-102	16-102	7E PASSAGEWAY, S-12 & S-16
TA-16-22	16-22	5E OFFICE, WAS S-18	TA-16-103	16-103	7E PASSAGEWAY, S-12 & S-16
TA-16-23	16-23	6F STORAGE, WAS S-19	TA-16-104	16-104	7E PASSAGEWAY, S-12 & S-16
TA-16-24	16-24	6E ANALYTICAL LAB., WAS S-20	TA-16-105	16-105	7E PASSAGEWAY, S-12 & S-16
TA-16-25	16-25	7E PROCESS BLDG, WAS S-23	TA-16-106	16-106	3B STORAGE, S-1
TA-16-26	16-26	8E PROCESS BLDG, WAS S-24	TA-16-107	16-107	3C STORAGE, S-2
TA-16-27	16-27	8E MELTING & CASTING, WAS S-25	TA-16-108	16-108	3C STORAGE, S-3
TA-16-28	16-28	8E WATER COOLING TOWER, WAS S-25T	TA-16-109	16-109	3C STORAGE, S-4
TA-16-29	16-29	8E FUEL OIL TANK	TA-16-110	16-110	6C BARRICADE
TA-16-30	16-30	8C MAGAZINE, WAS S-26A	TA-16-111	16-111	6C BARRICADE
TA-16-31	16-31	9C MACH. BUILDING, WAS S-26B	TA-16-112	16-112	6C BARRICADE
TA-16-32	16-32	9C MACH. BUILDING, WAS S-26C	TA-16-113	16-113	6C BARRICADE (EARTHEN), S-1
TA-16-33	16-33	9D MACH. BUILDING, WAS S-26D	TA-16-114	16-114	7E PASSAGEWAY, S-1
TA-16-34	16-34	9D MAGAZINE, WAS S-26E	TA-16-115	16-115	7E PASSAGEWAY, S-1
TA-16-35	16-35	9D EQUIPMENT ROOM, S-26F	TA-16-116	16-116	7E PASSAGEWAY, S-1
TA-16-36	16-36	9H EXPLOSIVE TESTING, S-27	TA-16-117	16-117	7E PASSAGEWAY, S-1
TA-16-37	16-37	9H STEAM CLEANING, WAS S-27E	TA-16-118	16-118	7E PASSAGEWAY, S-1
TA-16-38	16-38	6G EXPERIMENTAL CASTING, S-28	TA-16-119	16-119	7E PASSAGEWAY, S-1
TA-16-39	16-39	6C RADIO-GRAPHIC BLDG, S-29	TA-16-120	16-120	7E PASSAGEWAY, S-1
TA-16-40	16-40	7C RADIO-GRAPHIC BLDG, S-29B	TA-16-121	16-121	7E PASSAGEWAY, S-1
TA-16-41	16-41	7G PROCESS LAB, WAS S-30	TA-16-122	16-122	7E PASSAGEWAY, S-1
TA-16-42	16-42	7F PROCESS BLDG, WAS S-31	TA-16-123	16-123	7E PASSAGEWAY, S-1
TA-16-43	16-43	7F PROCESS BLDG, WAS S-32	TA-16-124	16-124	7E PASSAGEWAY, S-1
TA-16-44	16-44	8G PROCESS BLDG, WAS S-33	TA-16-125	16-125	7E PASSAGEWAY, S-1
TA-16-45	16-45	8G PROCESS BLDG, WAS S-34	TA-16-126	16-126	7E PASSAGEWAY, S-1
TA-16-46	16-46	8F PROCESS BLDG, WAS S-35	TA-16-127	16-127	7E PASSAGEWAY, S-1
TA-16-47	16-47	8F EQUIPMENT, WAS S-35E	TA-16-128	16-128	7E PASSAGEWAY, S-1
TA-16-48	16-48	8G RADIUM BLDG, WAS S-36	TA-16-129	16-129	7E PASSAGEWAY, S-1
TA-16-49	16-49	7I ANALYTICAL LAB, WAS S-41	TA-16-130	16-130	7E PASSAGEWAY, S-1
TA-16-50	16-50	7I EXPERIMENTAL CASTING, S-42	TA-16-131	16-131	10E GUARD HOUSE, S-136
TA-16-51	16-51	7I STEAM CLEANING, WAS S-42A	TA-16-132	16-132	PAINT SHOP, S-37
TA-16-52	16-52	7I EXPLOSIVE MATL., WAS S-43	TA-16-133	16-133	LUMBER STORAGE, S-138
TA-16-53	16-53	8H OPTICAL EQUIP. STOR., S-44	TA-16-134	16-134	MESS HALL, S-39
TA-16-54	16-54	8D PROCESS BLDG, S-45	TA-16-135	16-135	STORAGE BLDG, S-140
TA-16-55	16-55	8G GRINDING BLDG, S-45A	TA-16-136	16-136	IMPLEMENT SHED, S-41
TA-16-56	16-56	7I TESTING LAB., S-46	TA-16-137	16-137	PLUMBING & ELEC. SHOP, S-42
TA-16-57	16-57	8C MAGAZINE, S-50	TA-16-138	16-138	BLACKSMITH SHOP, S-43
TA-16-58	16-58	10H MAGAZINE, S-57	TA-16-139	16-139	STORAGE BLDG, S-144
TA-16-59	16-59	10I MAGAZINE, S-58	TA-16-140	16-140	STORAGE BLDG, S-145
TA-16-60	16-60	9J MAGAZINE, S-59	TA-16-141	16-141	STORAGE BLDG, S-146
TA-16-61	16-61	10H MAGAZINE, S-60	TA-16-142	16-142	FIRE HOUSE, S-147
TA-16-62	16-62	4D MAGAZINE, S-66	TA-16-143	16-143	HOSE HOUSE, S-147
TA-16-63	16-63	3D MAGAZINE, S-67	TA-16-144	16-144	EQUIP. RM. & STORAGE, S-149
TA-16-64	16-64	2E MAGAZINE, S-68	TA-16-145	16-145	LATRINE, S-150
TA-16-65	16-65	2F MAGAZINE, S-69	TA-16-146	16-146	PORTABLE STORAGE, S-151
TA-16-66	16-66	10G MAGAZINE, S-70	TA-16-147	16-147	9D ROAD BLOCK
TA-16-67	16-67	9H MAGAZINE, S-71	TA-16-148	16-148	8I SOLVENT BLDG
TA-16-68	16-68	8I MAGAZINE, S-72	TA-16-149	16-149	5E GUARD BLDG
TA-16-69	16-69	7G MAGAZINE, S-73	TA-16-150	16-150	7E HOUSE
TA-16-70	16-70	8H MAGAZINE, S-74	TA-16-151	16-151	7G "
TA-16-71	16-71	8H MAGAZINE, S-75	TA-16-152	16-152	8H "
TA-16-72	16-72	8I MAGAZINE, S-76	TA-16-153	16-153	9C BARRICADE
TA-16-73	16-73	9E MAGAZINE, S-77	TA-16-154	16-154	9C BARRICADE
TA-16-74	16-74	8C MAGAZINE, S-78	TA-16-155	16-155	9C BARRICADE
TA-16-75	16-75	6I PERSONNEL SHELTER, S-80	TA-16-156	16-156	9C BARRICADE
TA-16-76	16-76	8G PERSONNEL SHELTER, S-81	TA-16-157	16-157	9C BARRICADE
TA-16-77	16-77	7G PERSONNEL SHELTER, S-82	TA-16-158	16-158	9C BARRICADE
TA-16-78	16-78	7E PERSONNEL SHELTER, S-83	TA-16-159	16-159	9C BARRICADE
TA-16-79	16-79	8E PERSONNEL SHELTER, S-84	TA-16-160	16-160	8I ROAD BLOCK
TA-16-80	16-80	9D STORAGE, S-85	TA-16-161	16-161	8H SEPTIC TANK
TA-16-81	16-81	8G PROCESS BLDG & FAN ROOM, S-90			

Classification changed to
by authority of the U. S. Atomic Energy Commission.

Per J. M. Redman 12/14/54
(Person authorizing change in classification) (Date)

By Pete A. Ciosse SEP 3 1957
(Signature of person making the change, and date)

PUBLICLY RELEASABLE
LANL Classification Group
9/25/82

1-0106191



AUTHORIZED FOR		LOS ALAMOS SCIENTIFIC LABORATORY DEPARTMENT OF ENGINEERING-CONSTRUCTION & MAINTENANCE GROUP			
HEALTH SAFETY FIRE PR. COMM. SEC.		STRUCTURE LOCATION PLAN TA-16 S-SITE			
REV. 0	SCALE 1" = 200'	DRAWN BY: GRS	DATE: 3-1-57	DWG. NO.	
		CHKD. BY:	DATE:		
		APPVD. BY:	DATE:		ENGR. 132

OFFICIAL USE ONLY

LEGEND

- STRUCTURE EXISTING
- STRUCTURE PROPOSED
- STRUCTURE REMOVED
- GRID SPACING - 400 FEET

CONFIDENTIAL

OFFICIAL USE ONLY

Classification changed to
by authority of the U. S. Atomic Energy Commission,

Per P. F. BELCHER MAY 31 1957

(Person authorizing change in classification) (Date)

By Pete A. Cissale SEP 3 1957

(Signature of person making the change, and date)

PUBLICLY RELEASABLE
LANL Classification Group

Daniel J. G. 9/29/08




REV	0	SCALE	1" = 200'	DRAWN BY	DATE	12-5	205
REV	0	APPROV BY	DATE	12-5	205	ENG	0

LOS ALAMOS SCIENTIFIC LABORATORY
DEPARTMENT OF ENGINEERING-CONSTRUCTION & MAINTENANCE GRO.


STRUCTURE LOCATION PLAN
TA-16 S-SITE

SITE LOCATION

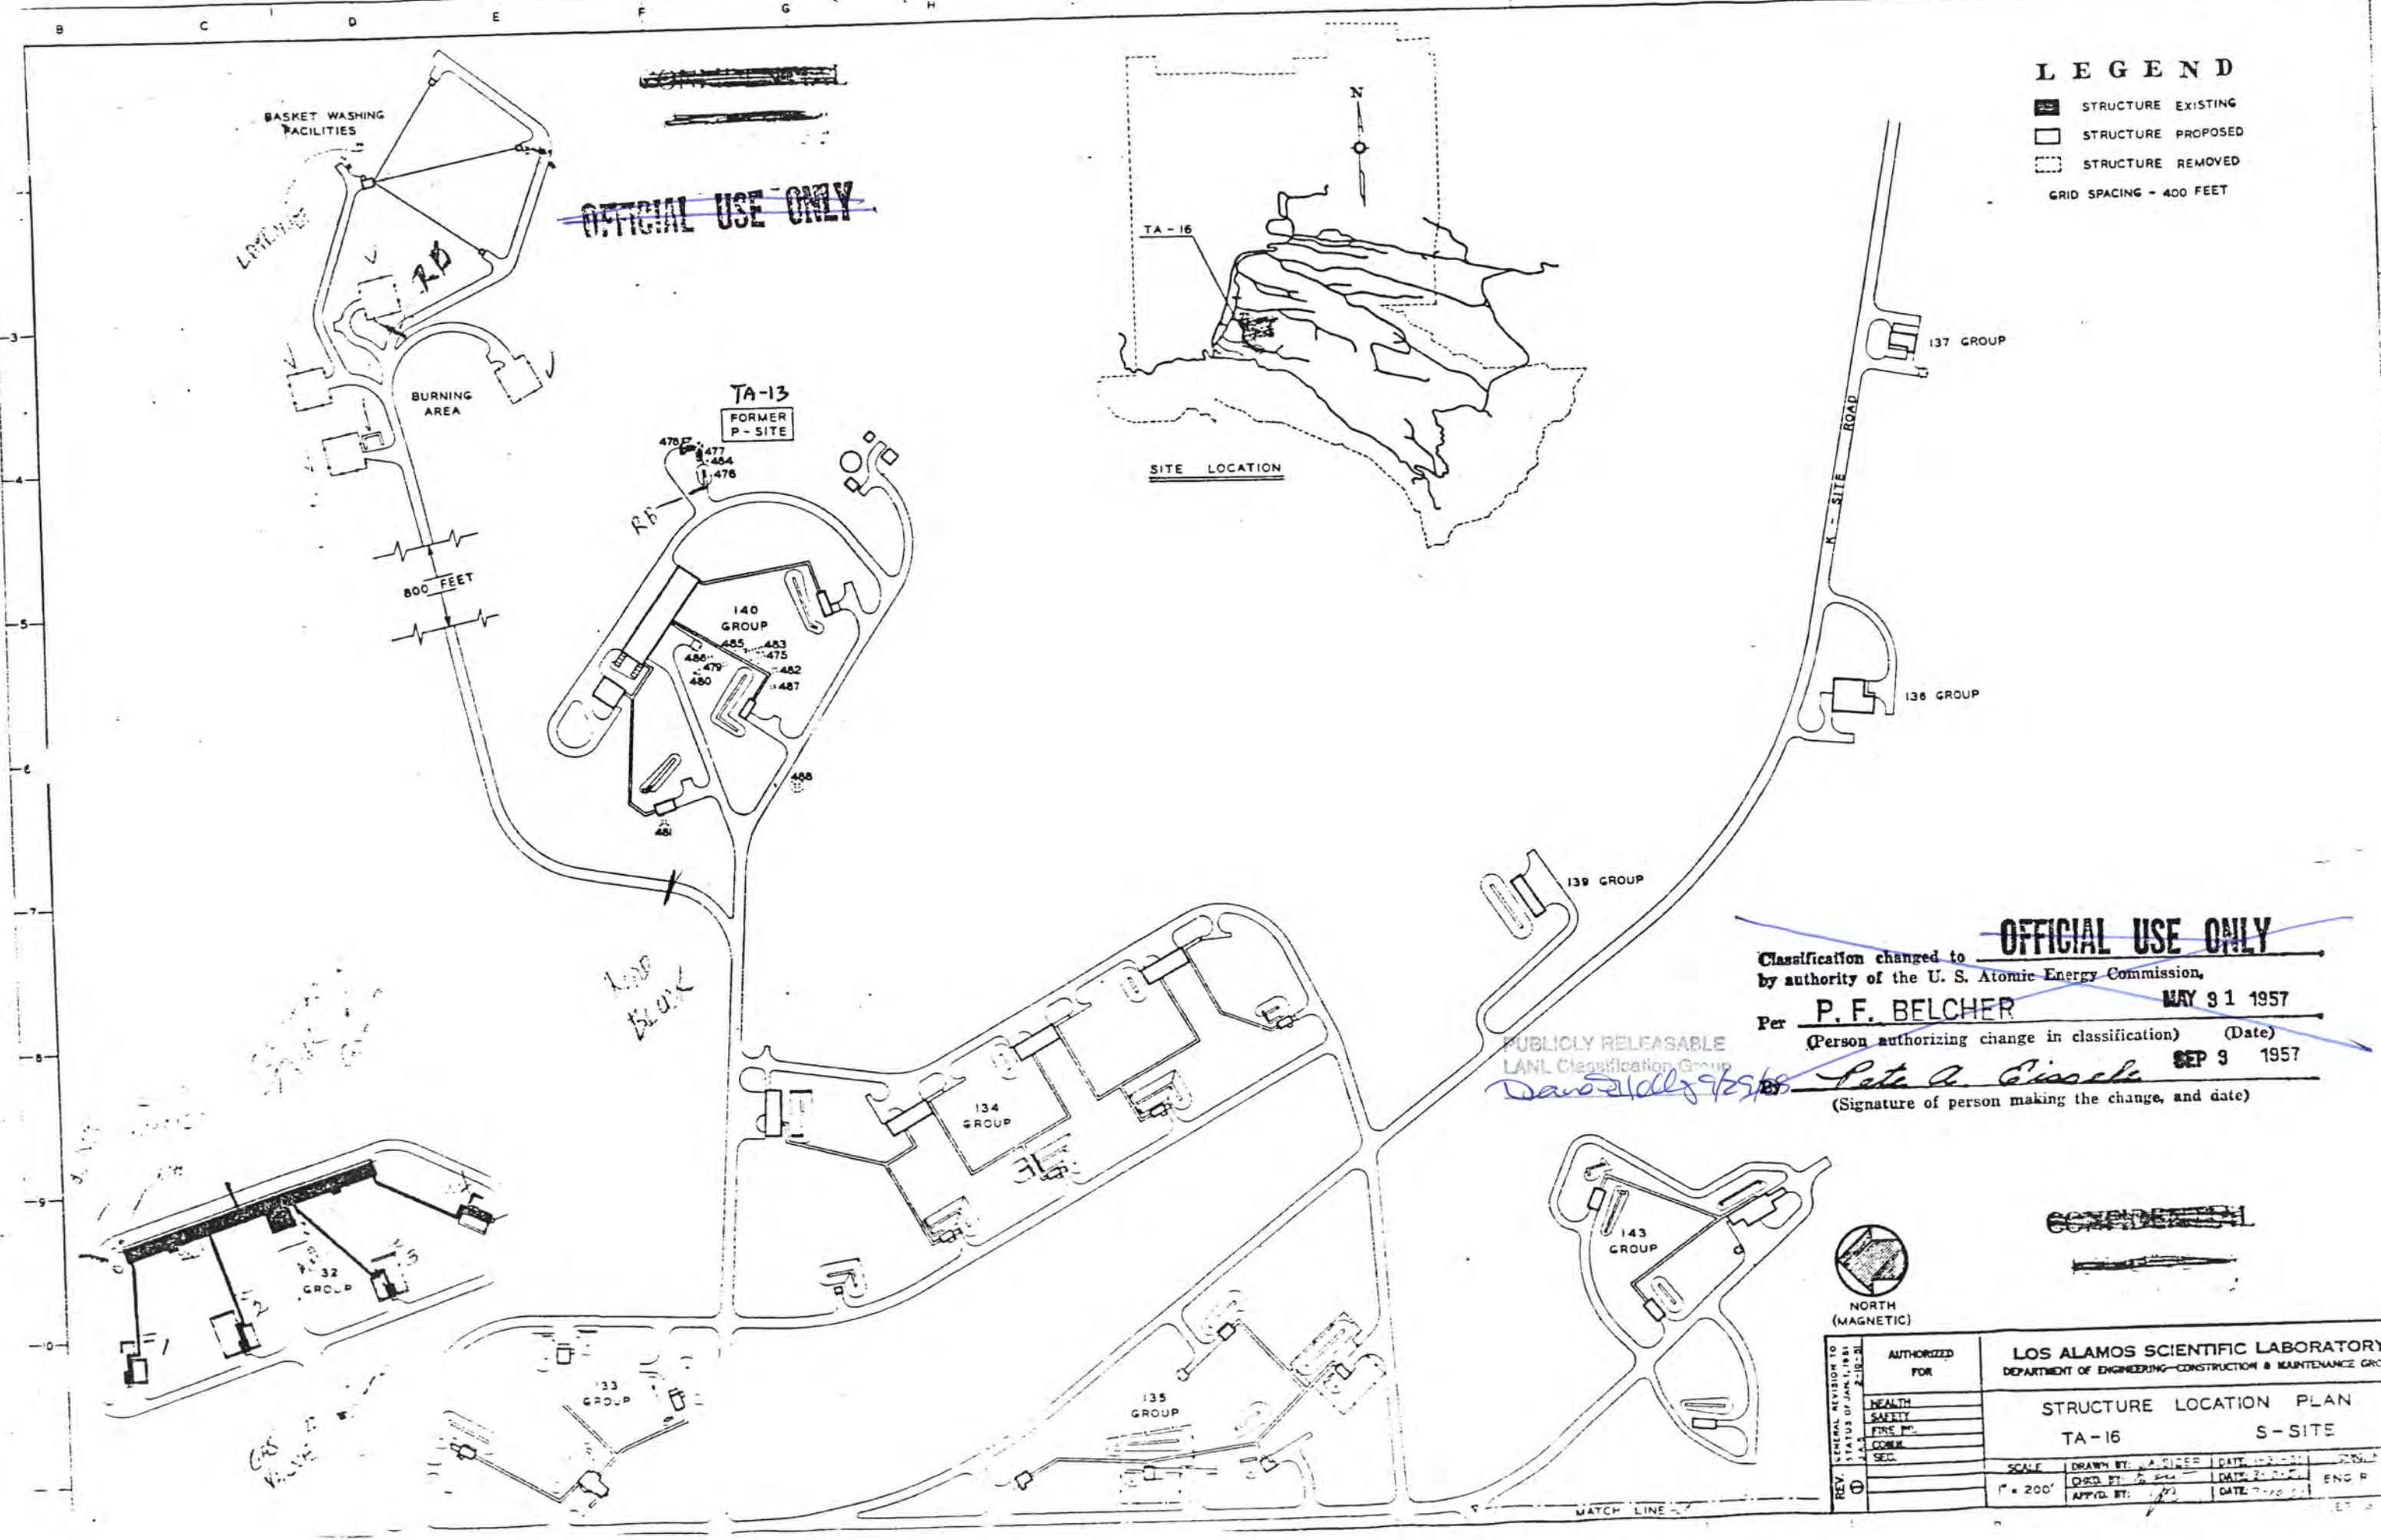

LEGEND

- STRUCTURE EXISTING
- STRUCTURE PROPOSED
- STRUCTURE REMOVED
- GRID SPACING - 400 FEET

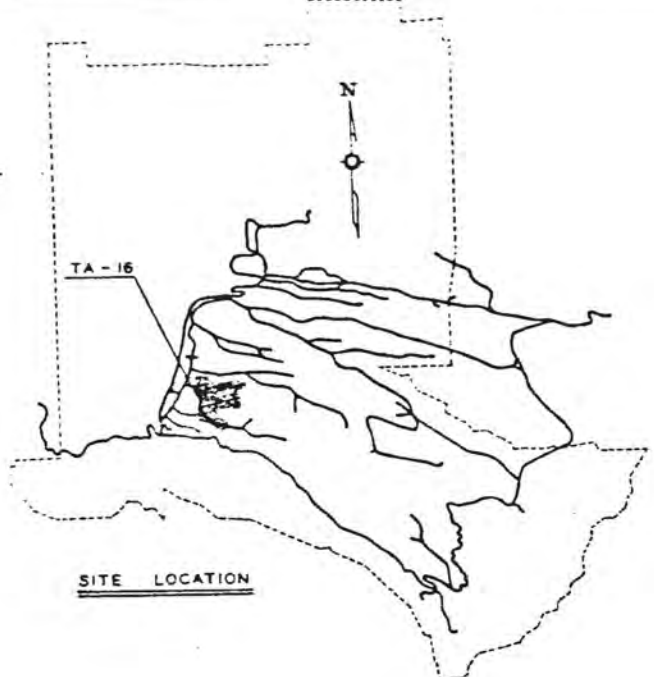

~~OFFICIAL USE ONLY~~

~~OFFICIAL USE ONLY~~

Classification changed to _____
by authority of the U. S. Atomic Energy Commission,
Per P. F. BELCHER MAY 31 1957
(Person authorizing change in classification) (Date)
Pete A. Cisselle SEP 9 1957
(Signature of person making the change, and date)

PUBLICLY RELEASABLE
LANL Classification Group
David Kelly 9/25/88



REV. 0	GENERAL REVISION TO STATUS OF JAN. 1, 1961	AUTHORIZED FOR	LOS ALAMOS SCIENTIFIC LABORATORY DEPARTMENT OF ENGINEERING-CONSTRUCTION & MAINTENANCE GROUP			
			STRUCTURE LOCATION PLAN			
			TA-16 S-SITE			
			SCALE: 1" = 200'	DRAWN BY: J. A. SIDER	DATE: 10-2-57	ENG. P.
			ORD. BY: J. M.	DATE: 2-2-58		
			APP'D. BY: J. M.	DATE: 7-10-58		

MATCH LINE

OFFICIAL USE ONLY

- LEGEND**
- STRUCTURE EXISTING
 - STRUCTURE PROPOSED
 - STRUCTURE REMOVED
- GRID SPACING - 400 FEET

CONFIDENTIAL
RESTRICTED DATA
This document contains restricted data as defined in the Atomic Energy Act of 1946.

Classification changed to **OFFICIAL USE ONLY**
by authority of the Los Alamos Security Commission,
Per **P. F. BELCHER** MAY 31 1957
(Person authorizing change in classification) (Date)
By *Pete A. Cissale* SEP 3 1957
(Signature of person making the change, and date)
PUBLICLY RELEASABLE
LANL Classification Group
David Kelly - 9/29/09

CONFIDENTIAL
RESTRICTED DATA
This document contains restricted data as defined in the Atomic Energy Act of 1946.






REV. 0		GENERAL REVISION TO N.O.D. 7-27-51		AUTHORIZED FOR		LOS ALAMOS SCIENTIFIC LABORATORY DEPARTMENT OF ENGINEERING-CONSTRUCTION & MAINTENANCE GROUP	
REV. 1		GENERAL REVISION TO J.A.S. 2-11-51		HEALTH SAFETY FIRE PR. COMM. SEC.		STRUCTURE LOCATION PLAN TA-16 S-SITE	
SCALE		DRAWN BY: J.A. SIZER		DATE: 1-31-51		DWG. NO.	
1" = 200'		CHKD. BY: <i>BSW</i>		DATE: 2-10-51		ENG. R 134	
		APPRD. BY: <i>AB</i>		DATE: 3-10-51		SHEET 3 OF 4	

~~CONFIDENTIAL~~

~~OFFICIAL USE ONLY~~

 LEGEND

-  STRUCTURE EXISTING
 STRUCTURE PROPOSED
 STRUCTURE REMOVED
 GRID SPACING - 400 FEET

SITE	LOCATION
------	----------

Classification changed to OFFICIAL USE ONLY
by authority of the U. S. Atomic Energy Commission.
P. F. BELCHER
Per _____ MAY 31 1951

Per T. J. BELCHER MAY 31 1957
(Person authorizing change in classification) (Date)

By Pete A. Fissler SEP 3 1957
(Signature of person making the change, and date)

PUBLICLY RELEASABLE
LANL Classification Group

[illegible]

~~RESTRICTED DATA~~
~~RESTRICTED DATA~~



NORTH
/ (MAGNETIC)


LOS ALAMOS SCIENTIFIC LABORATORY
DEPARTMENT OF ENGINEERING—CONSTRUCTION & MAINTENANCE GROUP

STRUCTURE	LOCATION	PLAN
-----------	----------	------

TA - i6 S - SITE

SCALE	DRAWN BY: J.A. SIZER	DATE: 1-31-51	DWG. NO.
1" = 200'	CHKD. BY: <i>[Signature]</i>	DATE: 3-10-51	ENG R 135
	APPVD. BY: <i>[Signature]</i>	DATE: 3-10-51	

SHEET 4 OF 4

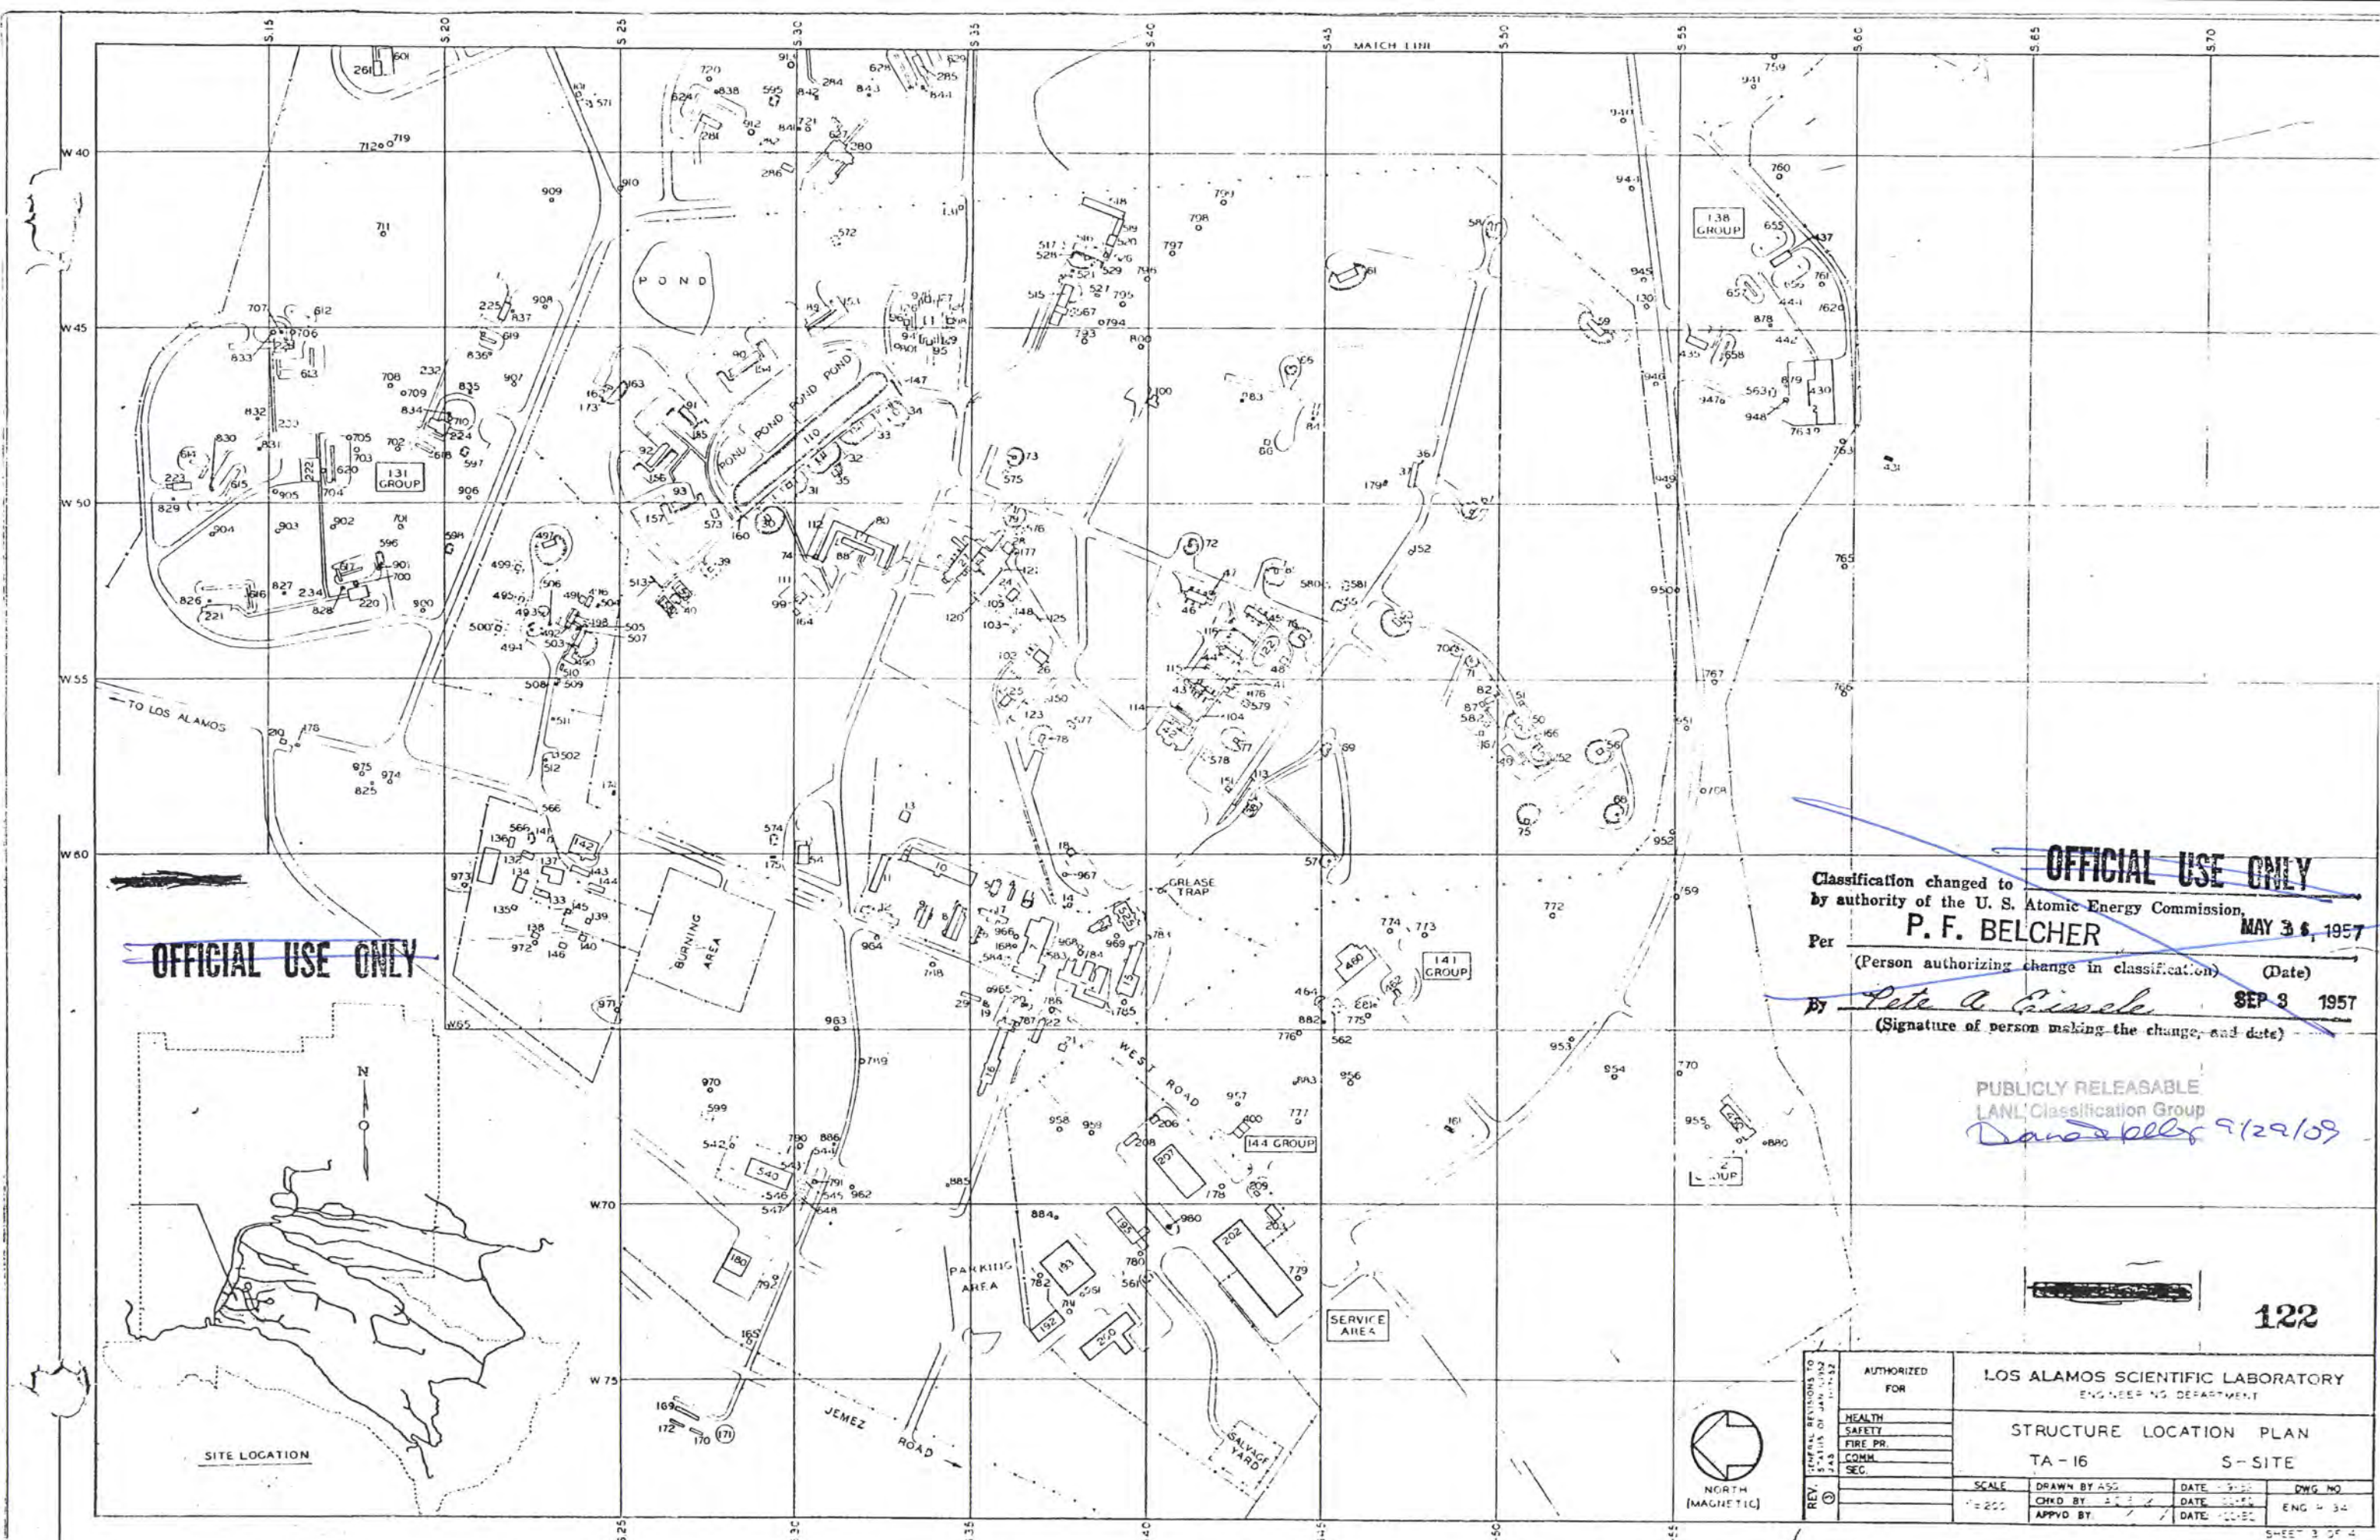

~~OFFICIAL USE ONLY~~

~~OFFICIAL USE ONLY~~
Classification changed to
by authority of the U. S. Atomic Energy Commission,
Per **P. F. BELCHER** MAY 3 8, 1957
(Person authorizing change in classification) (Date)
By *Pete A. Gissel* SEP 3 1957
(Signature of person making the change, and date)

PUBLICLY RELEASABLE
LANL Classification Group
David Kelly 9/29/09


122

REV. 1 TAPED REVISIONS TO STANDARD JAN 1952 JAS	AUTHORIZED FOR		LOS ALAMOS SCIENTIFIC LABORATORY ENGINEERING DEPARTMENT	
	HEALTH		STRUCTURE LOCATION PLAN	
	SAFETY		TA - 16 S-SITE	
	FIRE PR.		SCALE	
2	COMM.		DRAWN BY AGG	DATE 1-5-52
	SEC.		CHKD BY	DATE 1-5-52
			APPROV BY	DATE 1-5-52
		DWG NO.		ENG 4-34

~~OFFICIAL USE ONLY~~


~~OFFICIAL USE ONLY~~
Classification changed to
by authority of the U. S. Atomic Energy Commission,
Per P. F. BELCHER MAY 31 1957
(Person authorizing change in classification) (Date)
By PETE ESSELE SEP 3 1957
(Signature of person making the change, and date)

PUBLICLY RELEASABLE
LANL Classification Group
David J. Ockers 9/29/59

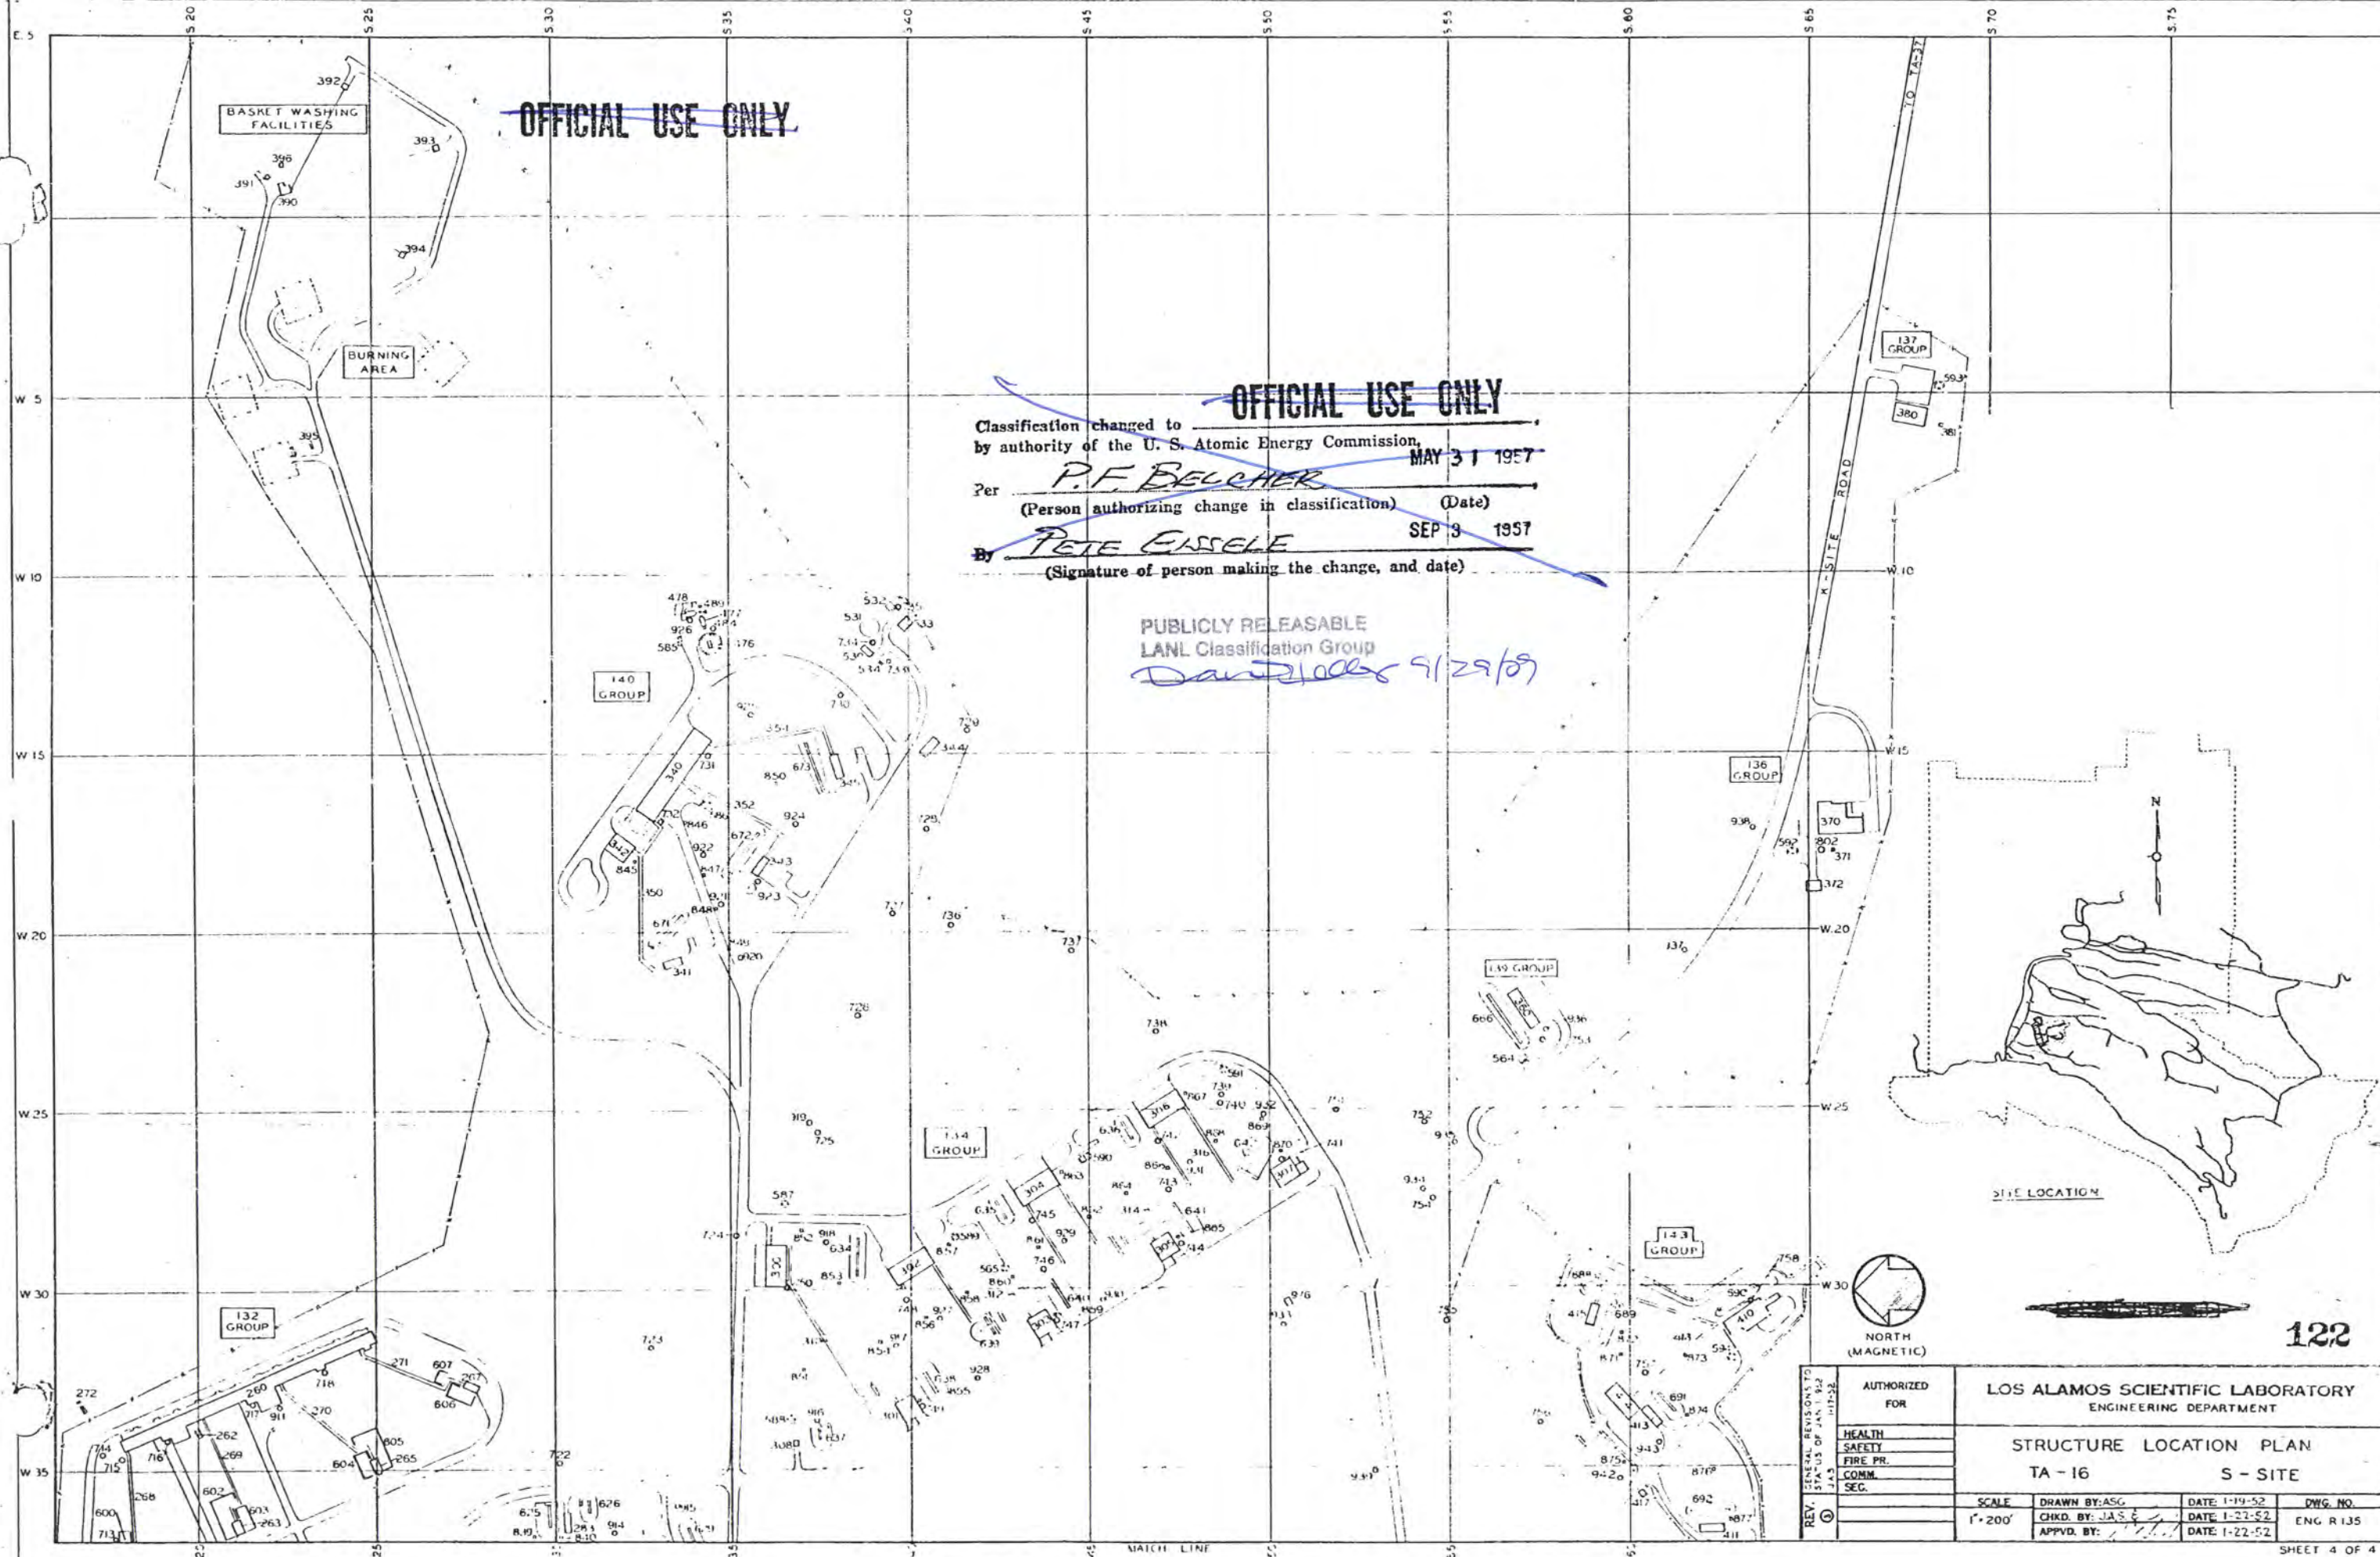

GENERAL REVISIONS TO STA-16 OF JAN. 1952 JAS JAN-52	AUTHORIZED FOR		LOS ALAMOS SCIENTIFIC LABORATORY ENGINEERING DEPARTMENT			
	HEALTH		STRUCTURE LOCATION PLAN TA - 16 S - SITE			
	SAFETY					
	FIRE PR.					
	COMM.					
REV. ①	SEC.		SCALE	DRAWN BY: ASG	DATE: 1-19-52	DWG. NO.
			1" = 200'	CHKD. BY: JAS	DATE: 1-22-52	ENG R135
				APPVD. BY: [Signature]	DATE: 1-22-52	

OFFICIAL USE ONLY

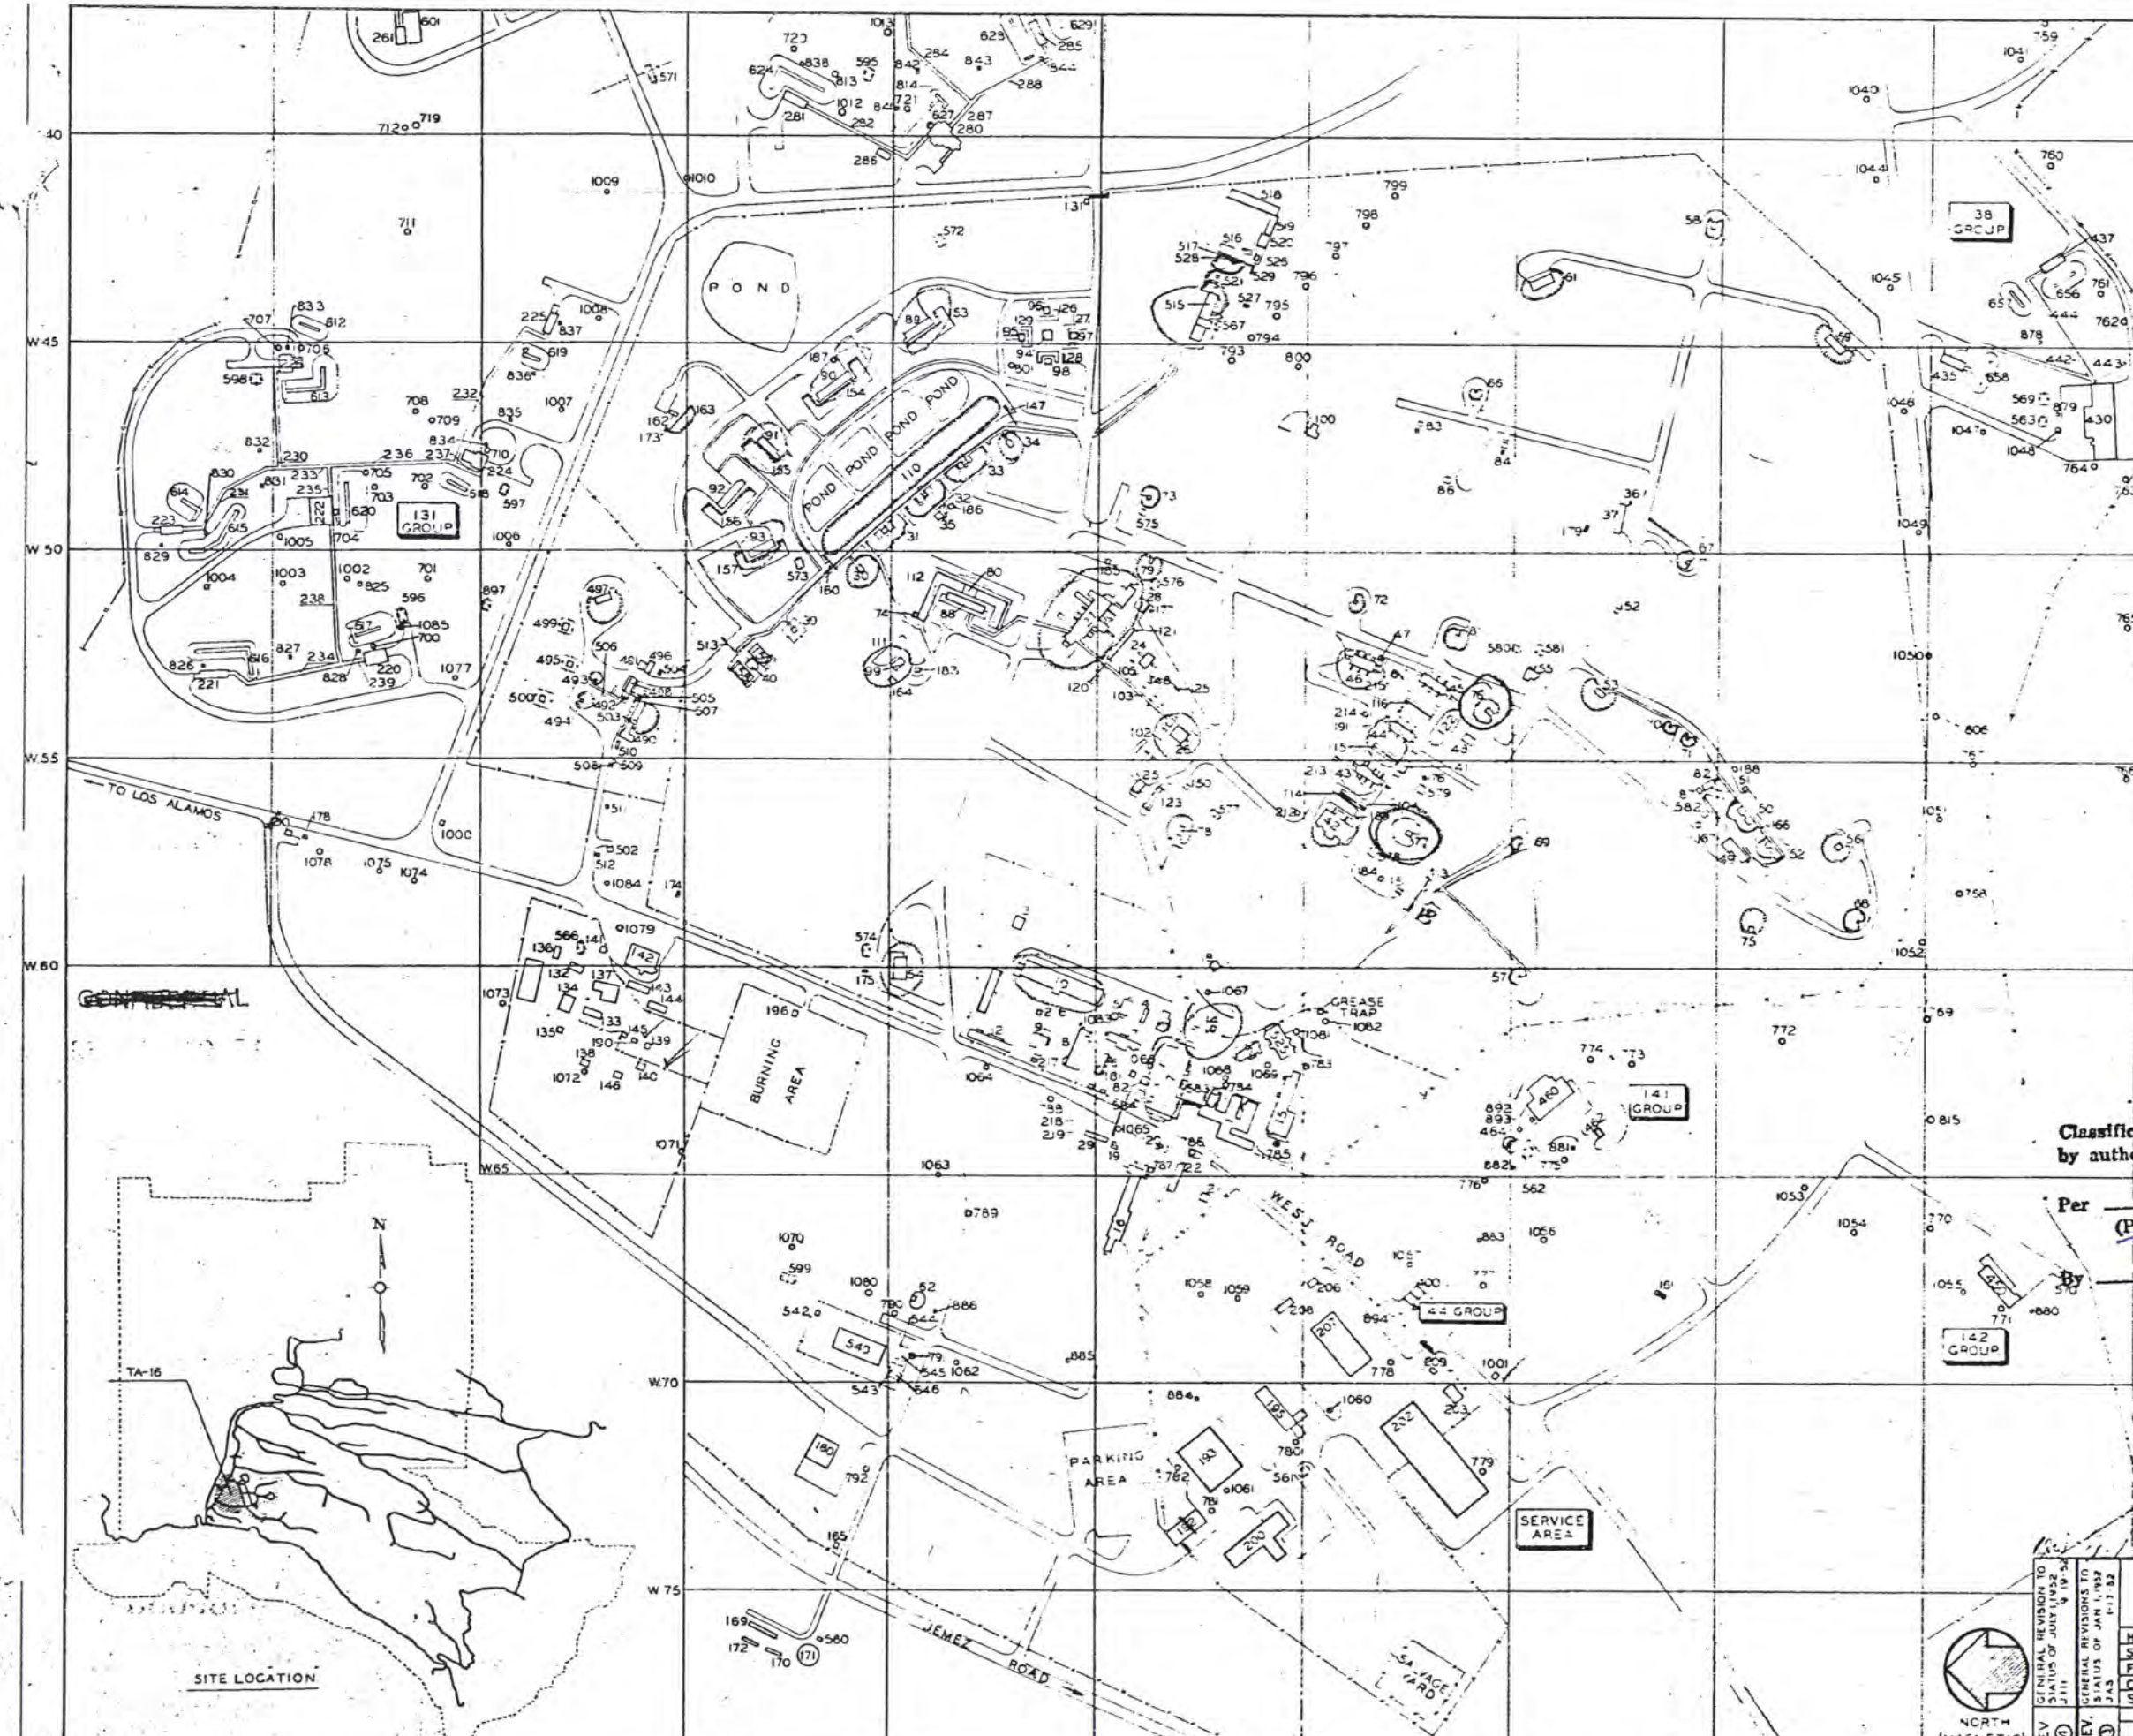

809 acres - total area
509.18 acres - excl. ar.
7.96 acres - s. excl. ar.
16.50 acres - limited acre

64% exclusion ar.
1% s. excl. ar.
35% Limited ar.

OFFICIAL USE ONLY

Classification changed to
by authority of the U. S. Atomic Energy Commission,
MAY 31 1957
Per P. F. BELCHER
(Person authorizing change in classification) (Date)
By Pete A. Cisselle
(Signature of person making the change, and date) SEP 3 1957
PUBLICLY RELEASED
LANL Classification Group
David L. Cisselle 9/29/59

CONFIDENTIAL
RESTRICTED DATA

258



AUTHORIZED FOR		LOS ALAMOS SCIENTIFIC LABORATORY ENGINEERING DEPARTMENT			
HEALTH		STRUCTURE LOCATION PLAN			
SAFETY		TA - 16 S-SITE			
FIRE PROT.		SCALE	DRAWN BY: ASG	DATE: 4-9-52	DWG. NO.
COMM.		CHKD. BY: JAS E	DATE: 1-22-52	DATE: 1-22-52	ENG. R 34
SEC.		APPROV. BY:			

~~OFFICIAL USE ONLY~~

Classification changed to			
by authority of the U. S. Atomic Energy Commission,			
P. F. BELCHER		MAY 31 1957	
Per	(Person authorizing change in classification)	(Date)	
		SEP 8 1957	
By	(Signature of person making the change, and date)		
	Pete A. Einsle		

PUBLICLY RELEASABLE
LANL Classification Group
D. A. D. D.

375

LOS ALAMOS SCIENTIFIC LABORATORY
ENGINEERING DEPARTMENT

STRUCTURE LOCATION PLAN

TA - 16 S - SITE

SCALE	DRAWN BY: ASG	DATE: 1-19-52	CONS. NO.
1"=200'	CHKD. BY: JAS & [Signature]	DATE: 1-22-52	ENG. R 13
	APPRD. BY: [Signature]	DATE: 1-22-52	

SHEET 4 OF 4

[illegible]

PUBLICLY RELEASABLE
LANL Classification Group
Daniel D. Hall 9/29/89

640

REV ⑤	GENERAL REVISION TO STATUS OF JULY 1954 JAS	REV ⑥	GENERAL REVISION TO STATUS OF JULY 1954 JAS	REV ⑦	GENERAL REVISION TO STATUS OF JULY 1954 JAS	REV ⑧	GENERAL REVISION TO STATUS OF JULY 1954 JAS
AUTHORIZED FOR HEALTH SAFETY FIRE PR. CORRU. SEC.				LOS ALAMOS SCIENTIFIC LABORATORY ENGINEERING DEPARTMENT STRUCTURE LOCATION PLAN TA - 16			
SCALE 1" = 200'				DRAWN BY: ASG CHECK BY: JAS & APP'D BY:		DATED: 1952 DATED: 1952	

~~OFFICIAL USE ONLY~~

BASKET WASHING FACILITIES

BURNING AREA

140 GROUP

134 GROUP

139 GROUP

136 GROUP

137 GROUP

143 GROUP

132 GROUP

REV. ⑥ GENERAL REVISION TO STATUS OF JULY 1, 1954
REV. ⑤ GENERAL REVISION TO STATUS OF JULY 1, 1953
REV. ④ GENERAL REVISION TO STATUS OF JULY 1, 1952
REV. ③ GENERAL REVISION TO STATUS OF JULY 1, 1951
REV. ② GENERAL REVISION TO STATUS OF JULY 1, 1950
REV. ① GENERAL REVISION TO STATUS OF JULY 1, 1949

~~OFFICIAL USE ONLY~~

Classification changed to
by authority of the U. S. Atomic Energy Commission,

Per P. F. BELCHER MAY 31 1956
(Person authorizing change in classification) (Date)

By Pete A. Cissele SEP 3 1957
(Signature of person making the change, and date)

PUBLICLY RELEASABLE
LANL Classification Group

David A. Cissele 7/2/58


~~CONFIDENTIAL~~

640


LOS ALAMOS SCIENTIFIC LABORATORY
ENGINEERING DEPARTMENT

STRUCTURE LOCATION PLAN
TA-16 S-SITE

SCALE	DRAWN BY: ASG	DATE: 1-19-52	ENG. NO.
1" = 200'	CHKD BY: JAS &	DATE: 1-23-52	ENG. R 135
	APPRD BY:	DATE: 1-22-52	

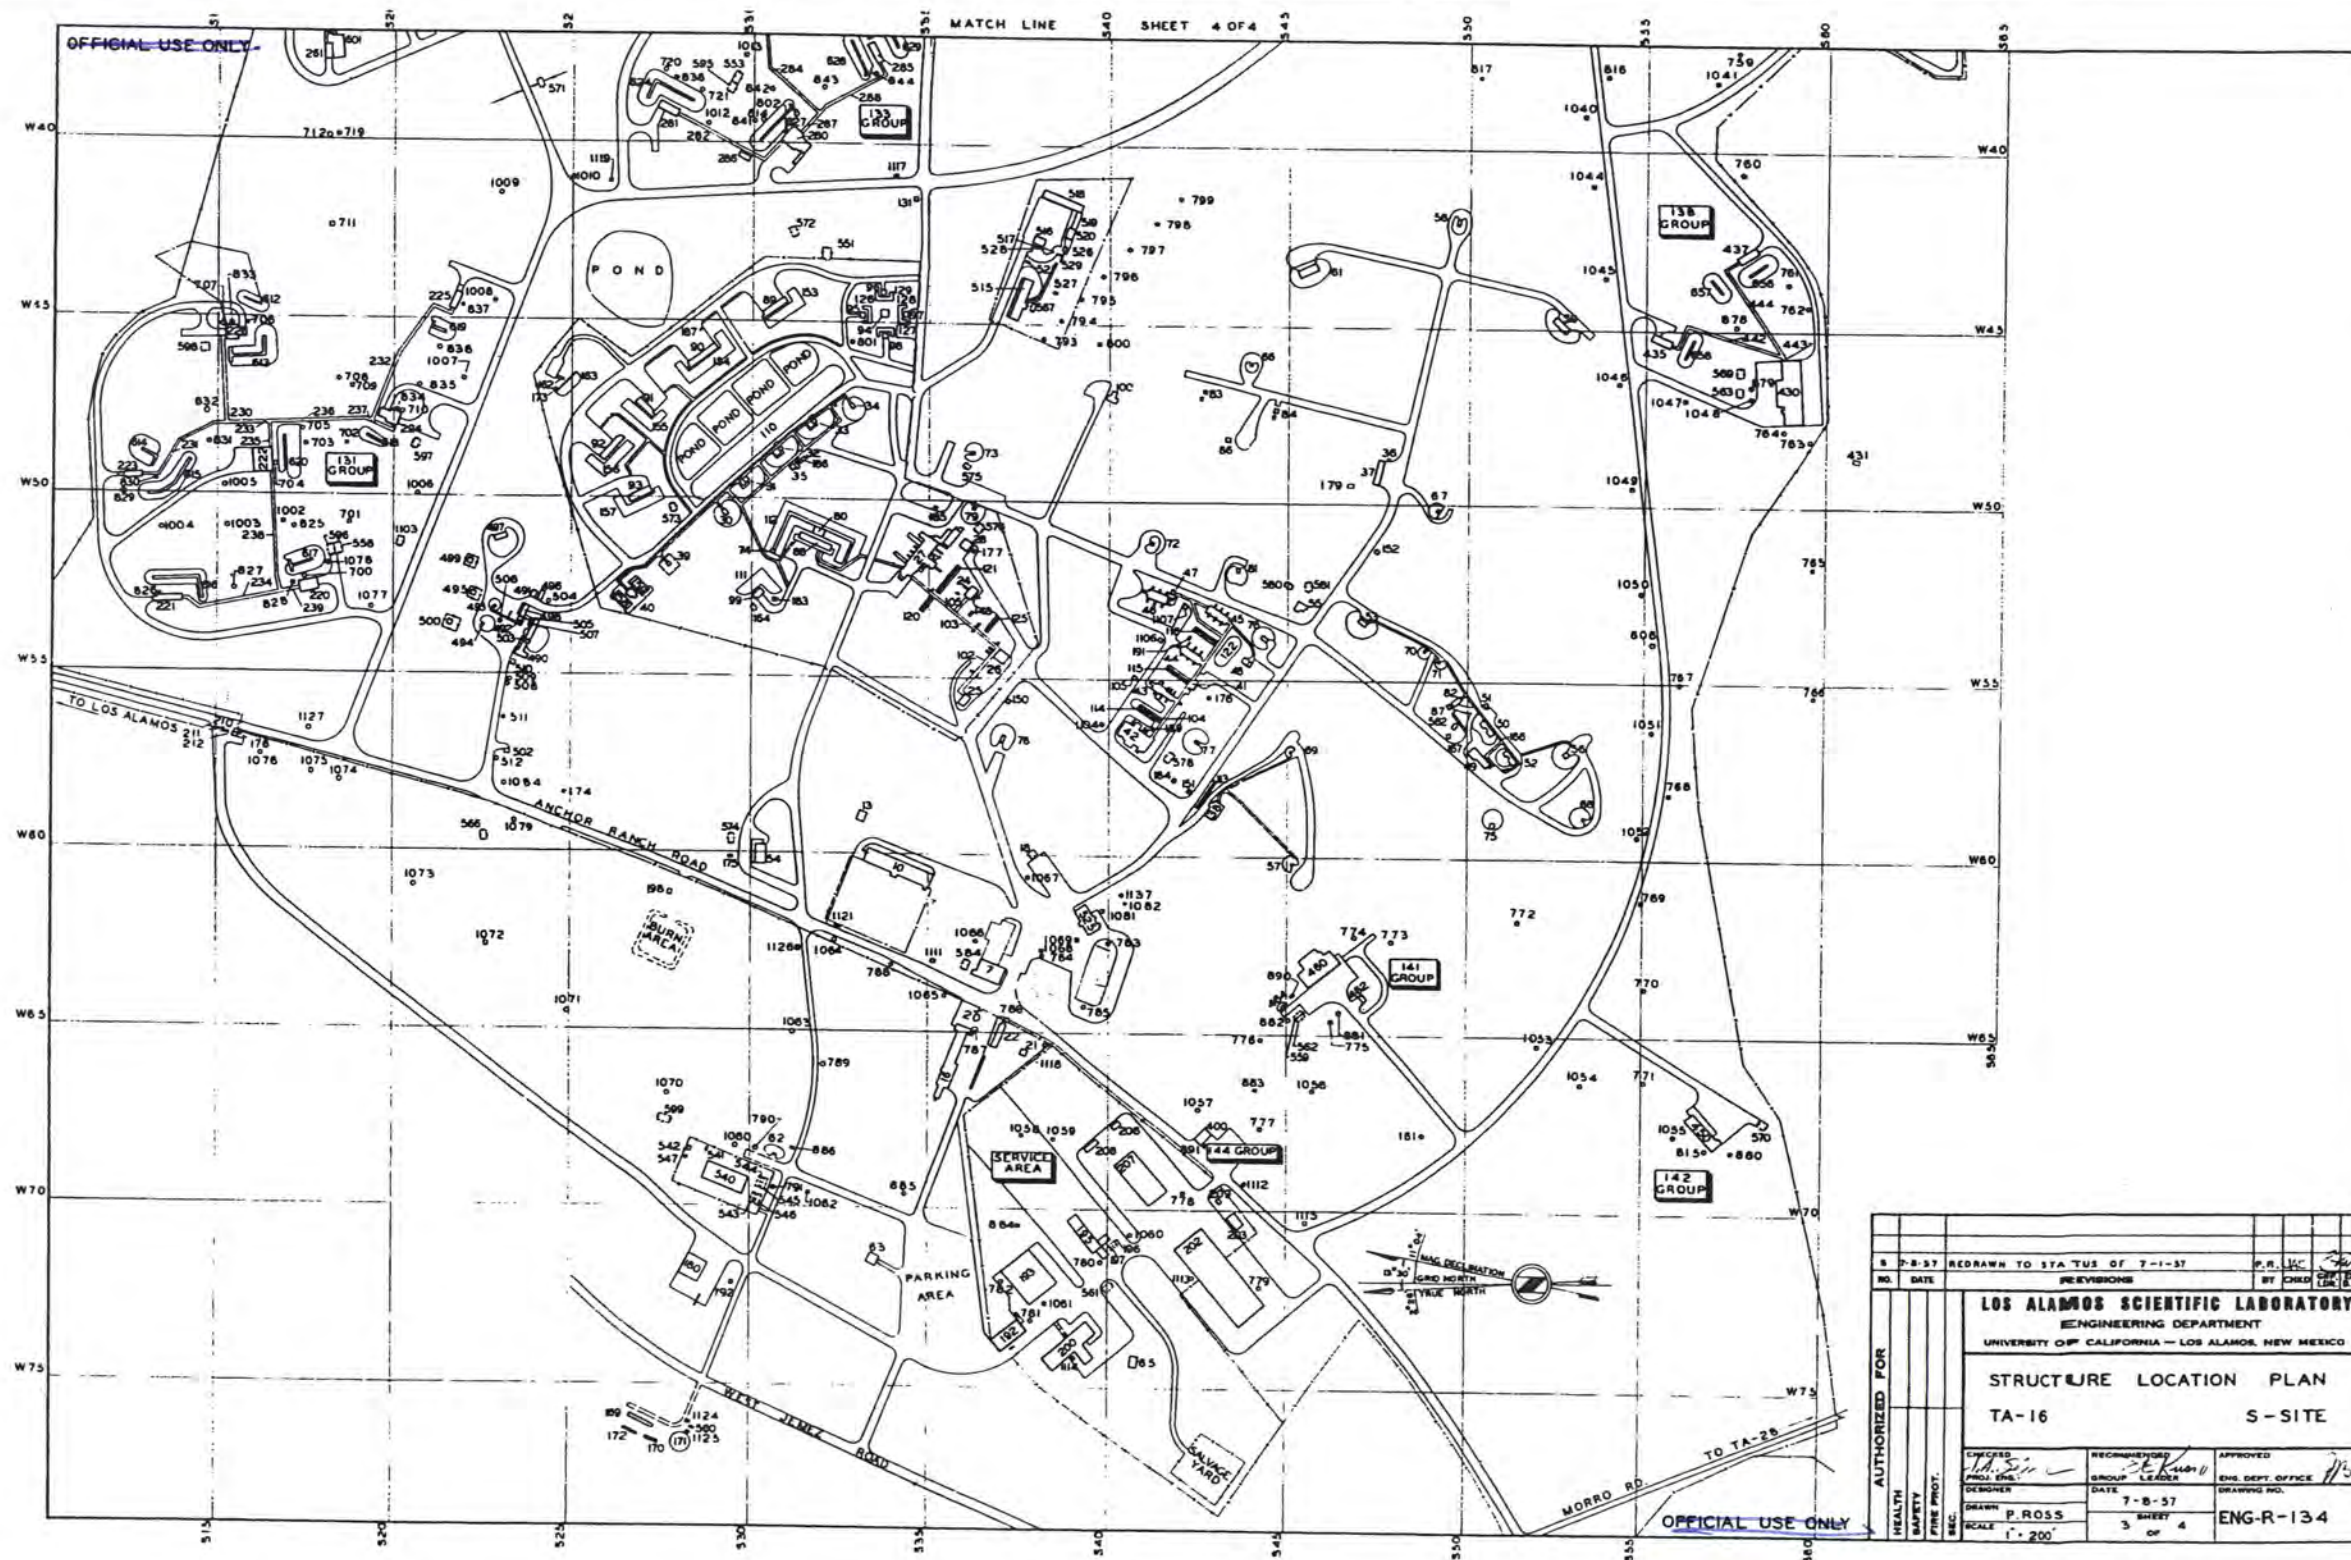


PUBLICLY RELEASABLE
 LANL Classification Group
David J. Allen 9/25/09

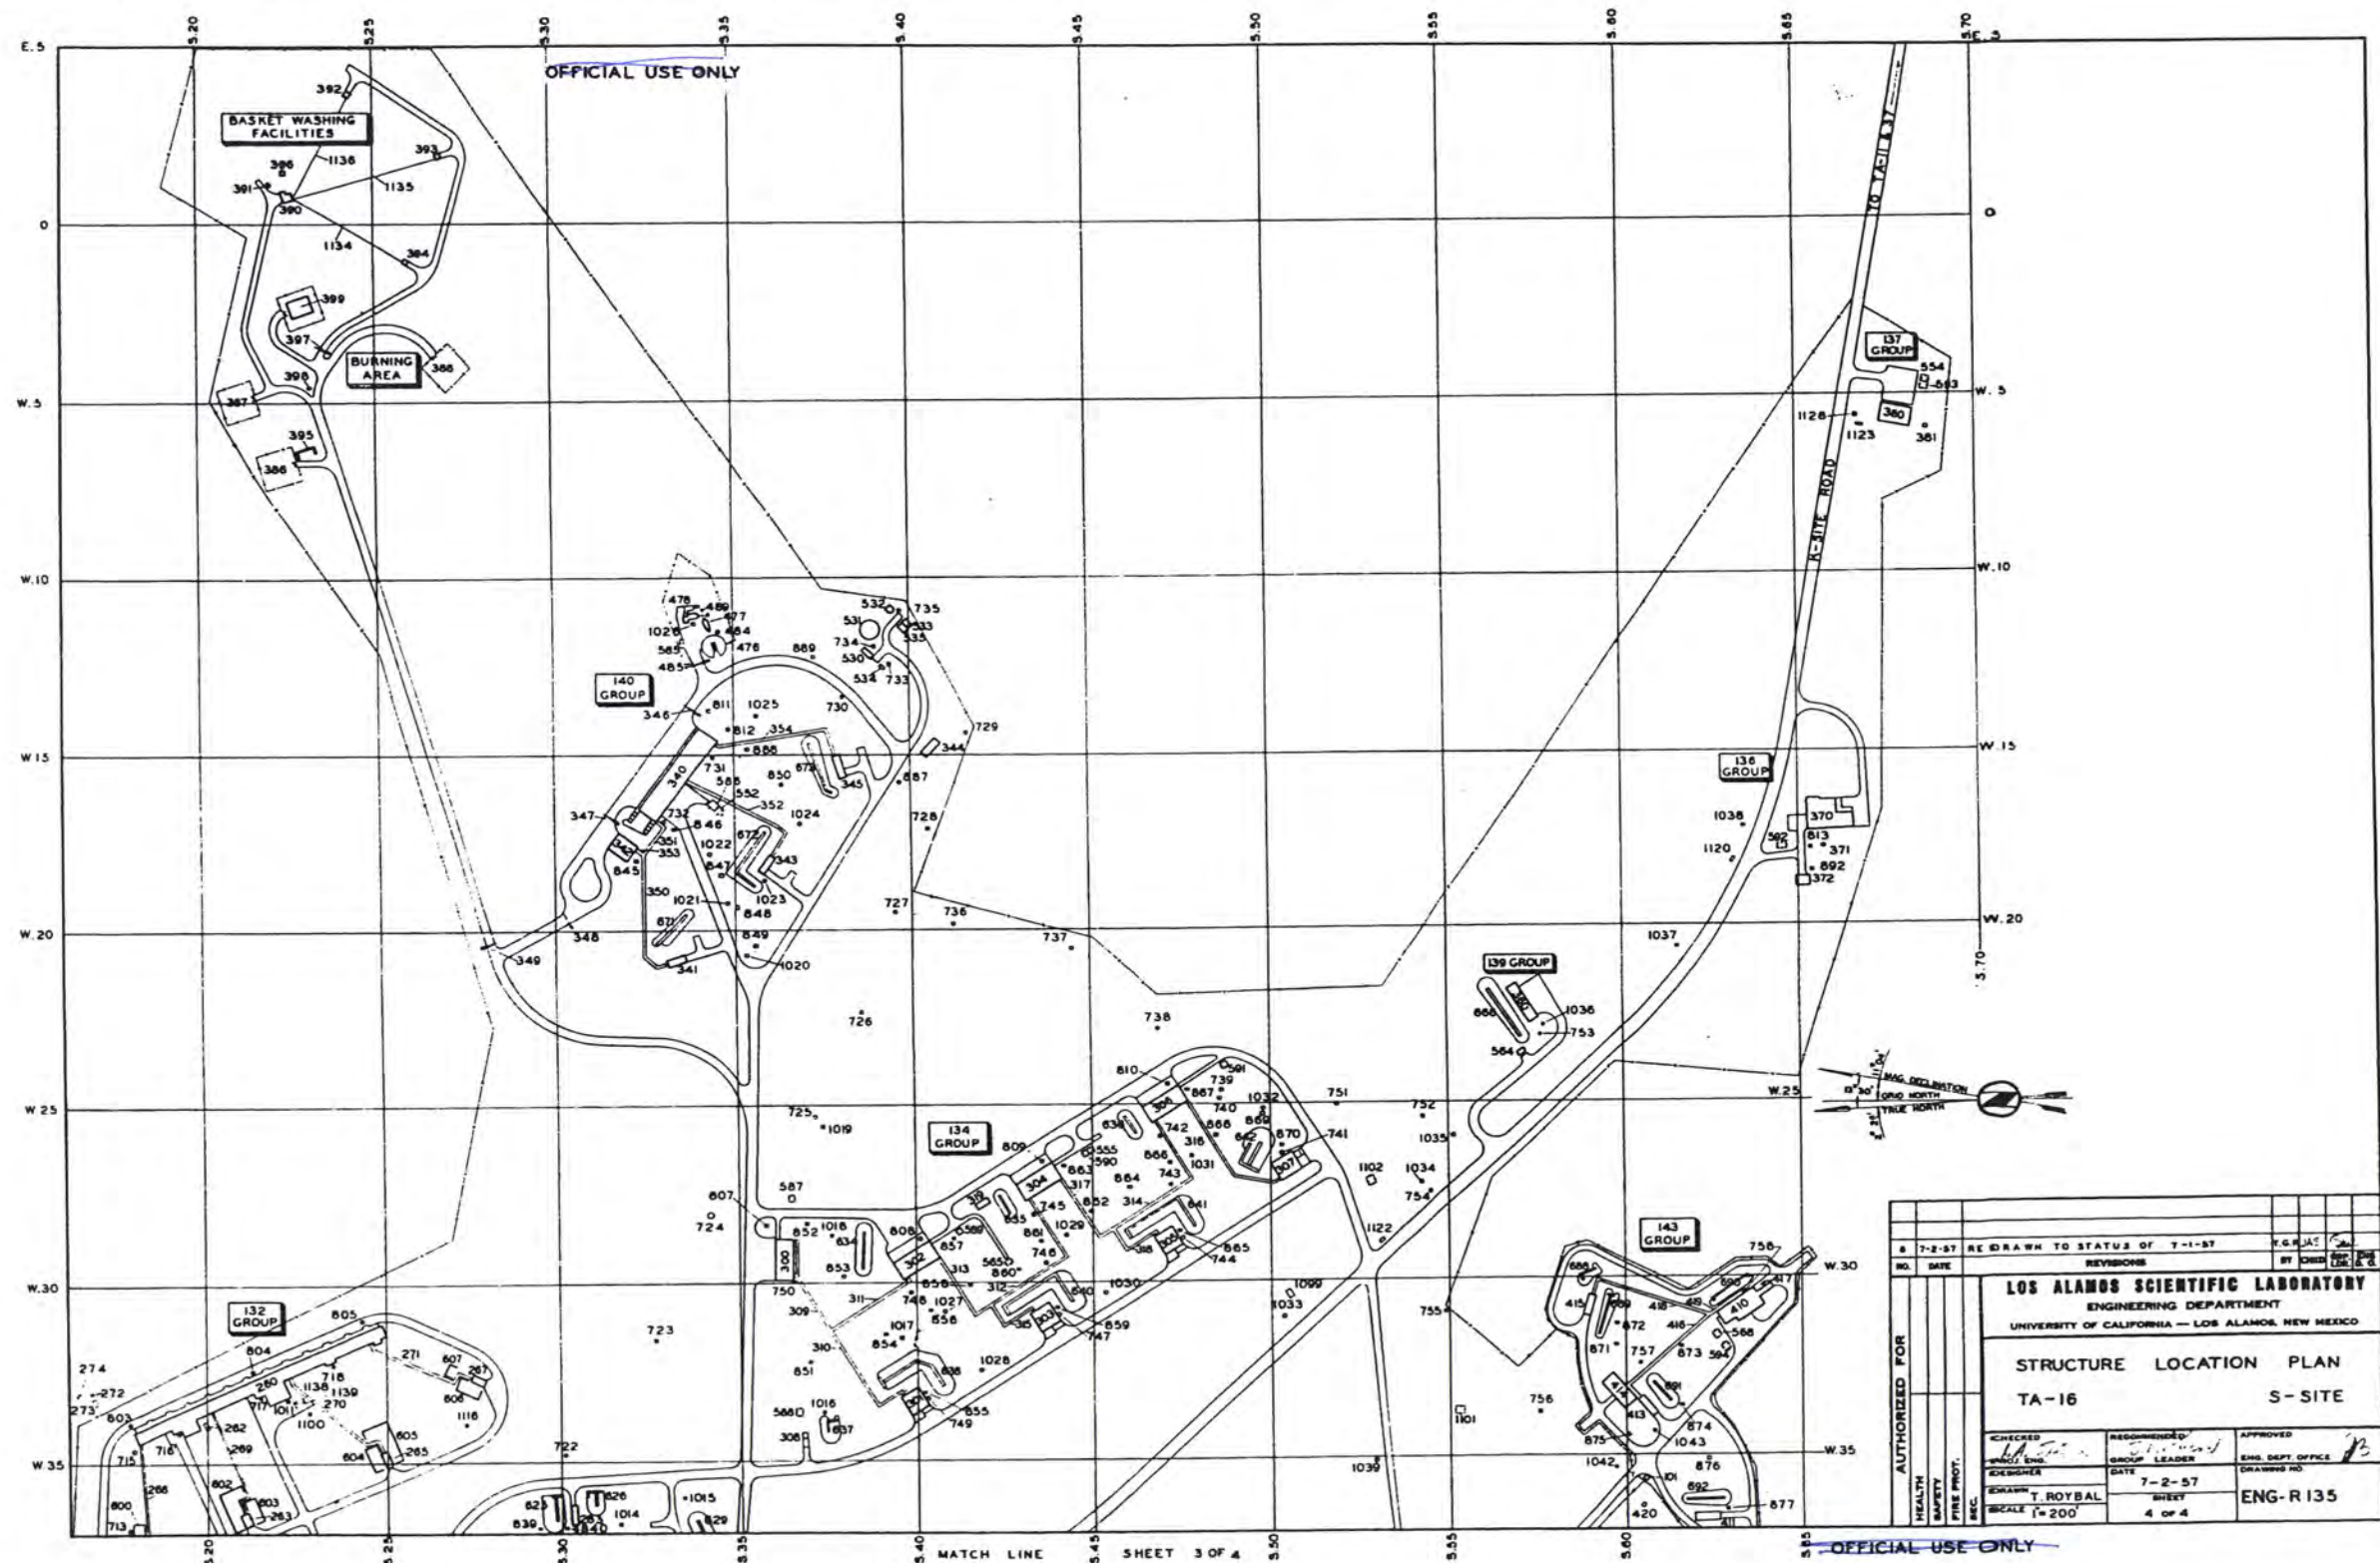


NO.		DATE		RE-DRAWN TO STATUS OF T-1-57		BY		DATE	
1		7-2-57		RE-DRAWN TO STATUS OF T-1-57		BY		DATE	
<p align="center">LOS ALAMOS SCIENTIFIC LABORATORY ENGINEERING DEPARTMENT UNIVERSITY OF CALIFORNIA - LOS ALAMOS, NEW MEXICO</p>									
STRUCTURE LOCATION PLAN					S-SITE				
TA-16									
AUTHOR FOR HEALTH SAFETY FIRE PROT. ECL.	CHECKED	DESIGNED	RECOMMENDED	APPROVED	GROUP LEADER	DATE	SHEET	OF 4	ENG. R 135
	W. H. B.	T. ROYBAL							
	7-2-57	7-2-57							
	4	4							


PUBLICLY RELEASABLE
 LANL Classification Group
 Drawn by 9/29/59



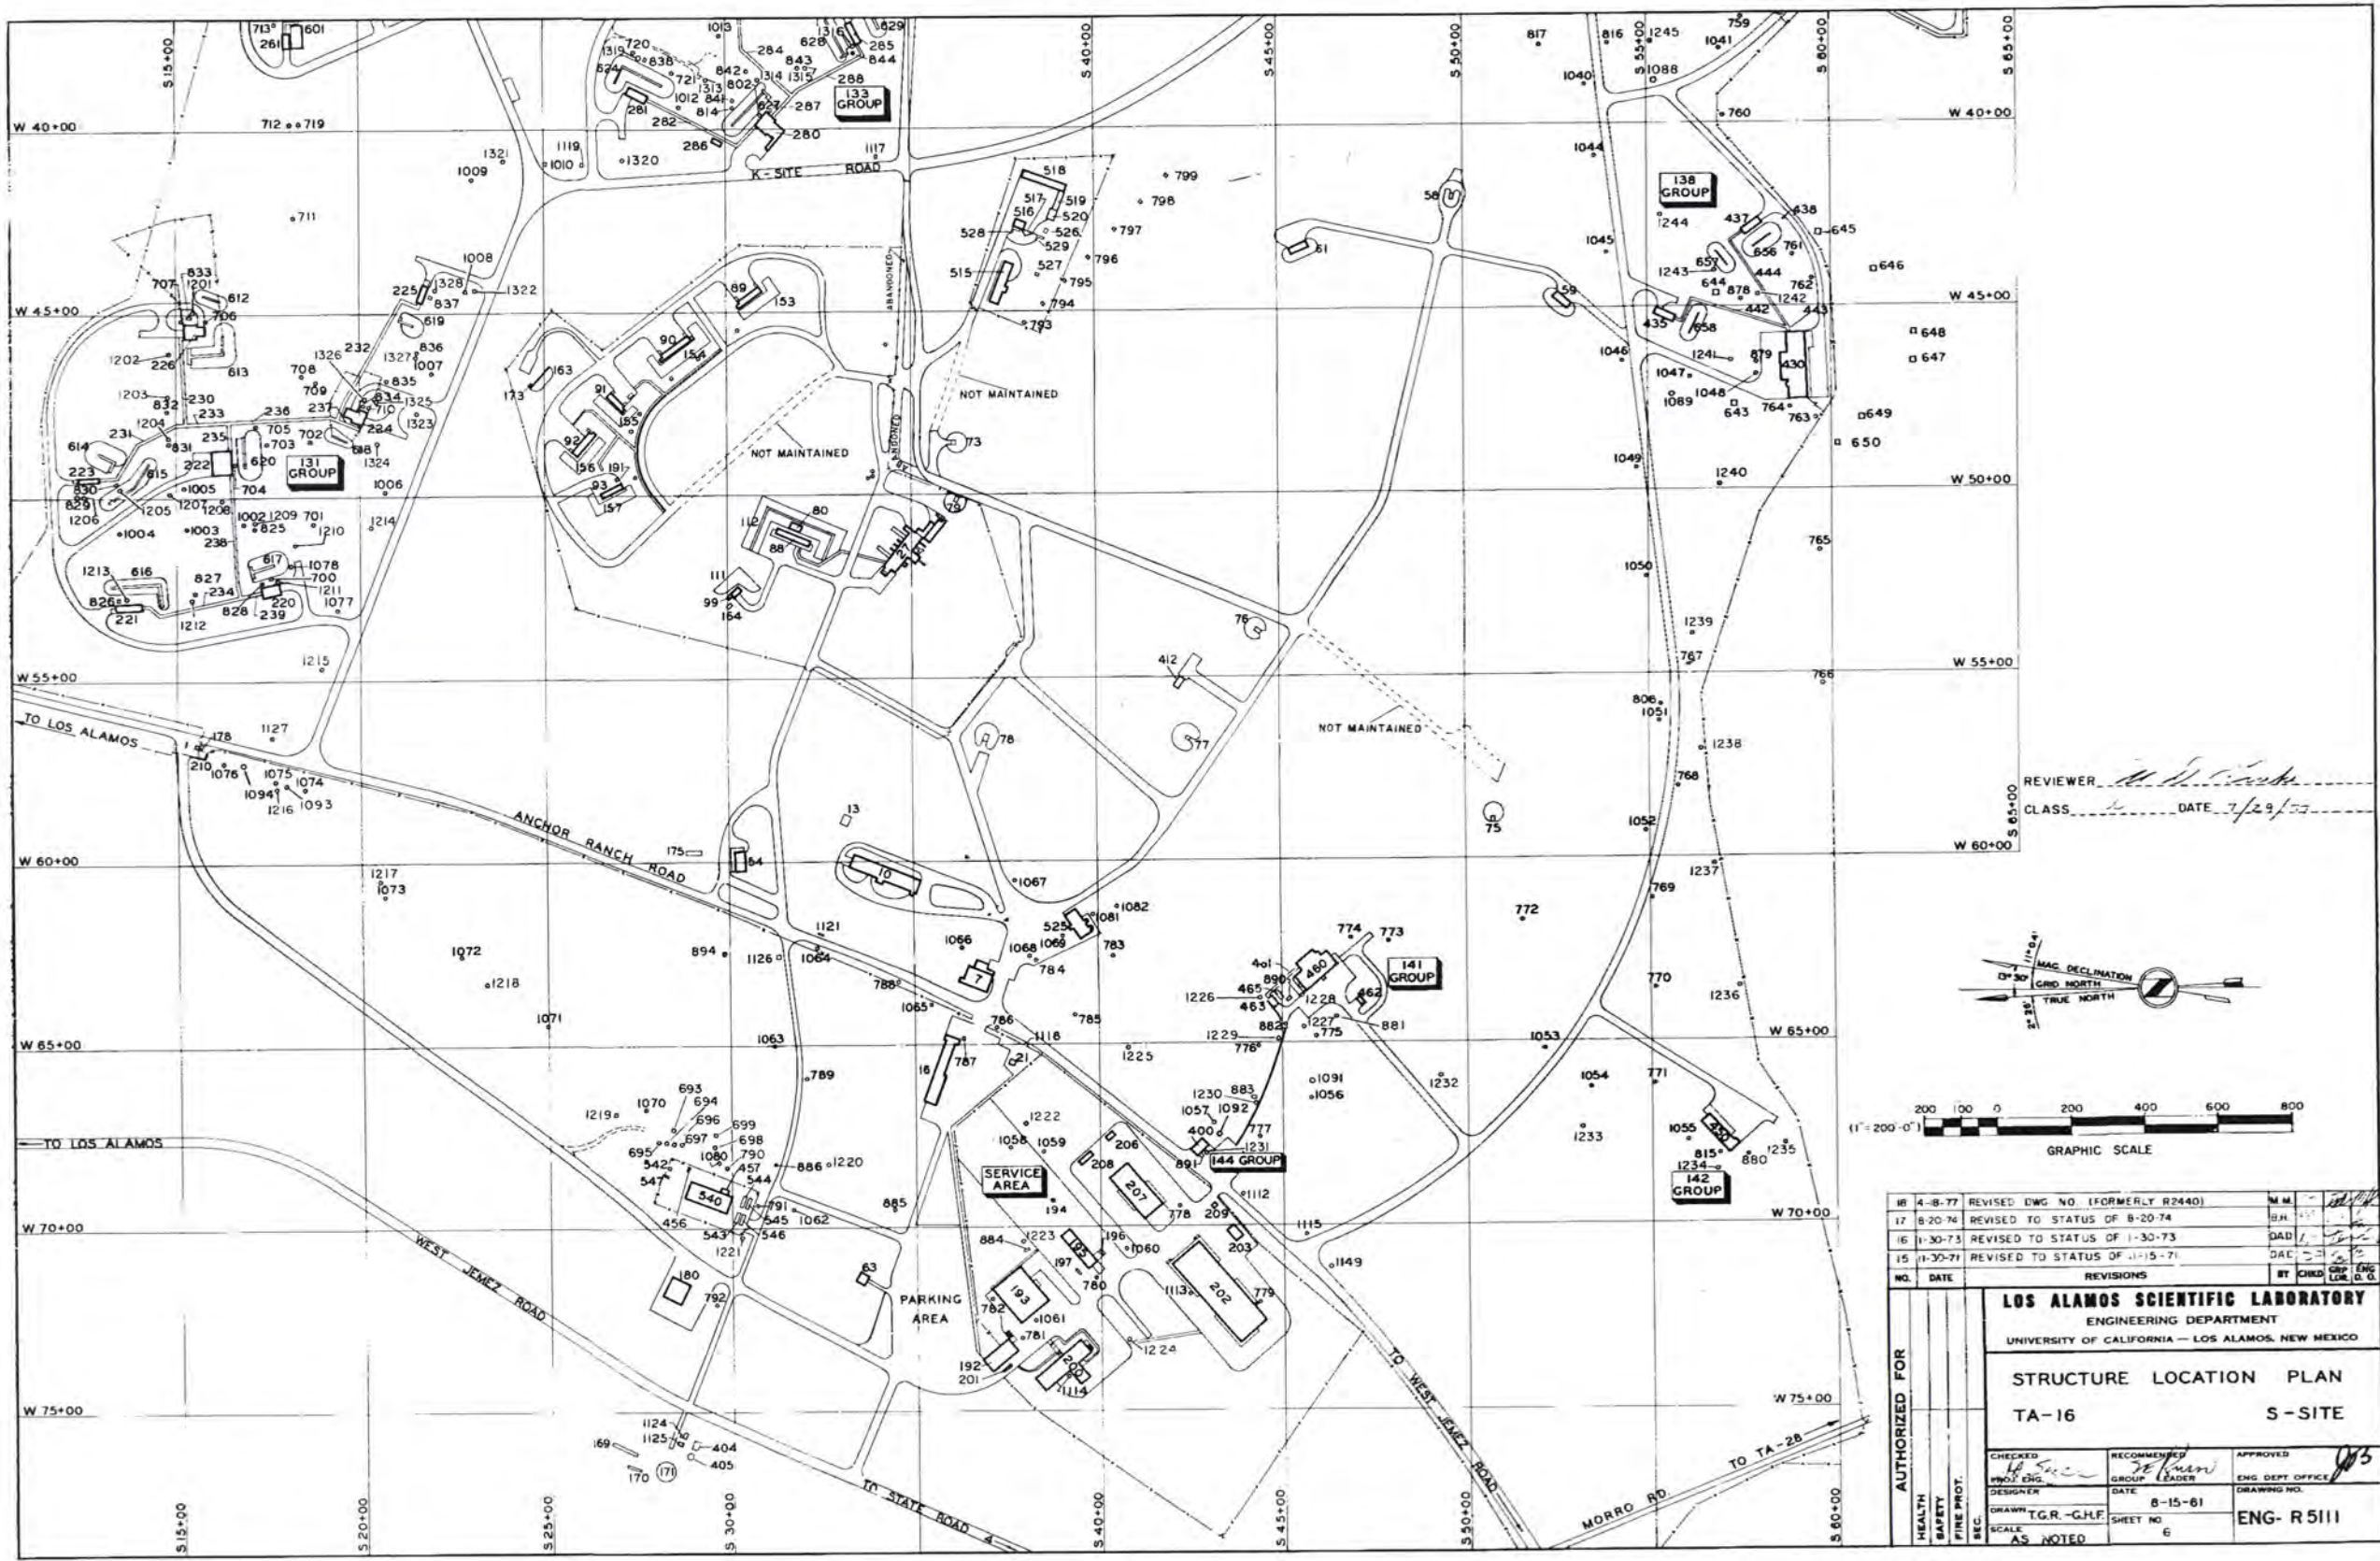


REVIEWER *[Signature]*
CLASS *[Blank]* DATE *7/29/57*

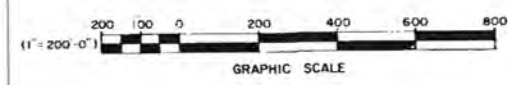


14	4-8-77	REVISED DWG NO. (FORMERLY R2440)	W.H.	<i>[Signature]</i>
17	8-20-74	REVISED TO STATUS OF 8-20-74	BR	<i>[Signature]</i>
16	1-30-73	REVISED TO STATUS OF 1-30-73	DAD	<i>[Signature]</i>
15	11-30-71	REVISED TO STATUS OF 11-15-71	DAC	<i>[Signature]</i>
REVISIONS				
NO.	DATE	BY	CHKD	APP. ENG. OR O.
LOS ALAMOS SCIENTIFIC LABORATORY ENGINEERING DEPARTMENT UNIVERSITY OF CALIFORNIA - LOS ALAMOS, NEW MEXICO				
STRUCTURE LOCATION PLAN				
TA-16 S-SITE				
AUTHORIZED FOR HEALTH SAFETY FIRE PROT. SEC.	CHECKED <i>[Signature]</i> W.D. ENG. DESIGNER	RECOMMENDED <i>[Signature]</i> GROUP LEADER	APPROVED <i>[Signature]</i> ENG. DEPT. OFFICE	
	DRAWN T.G.R.-G.H.F.	DATE 8-15-61	DRAWING NO.	
	SCALE AS NOTED	SHEET NO. 6	ENG- R 5111	

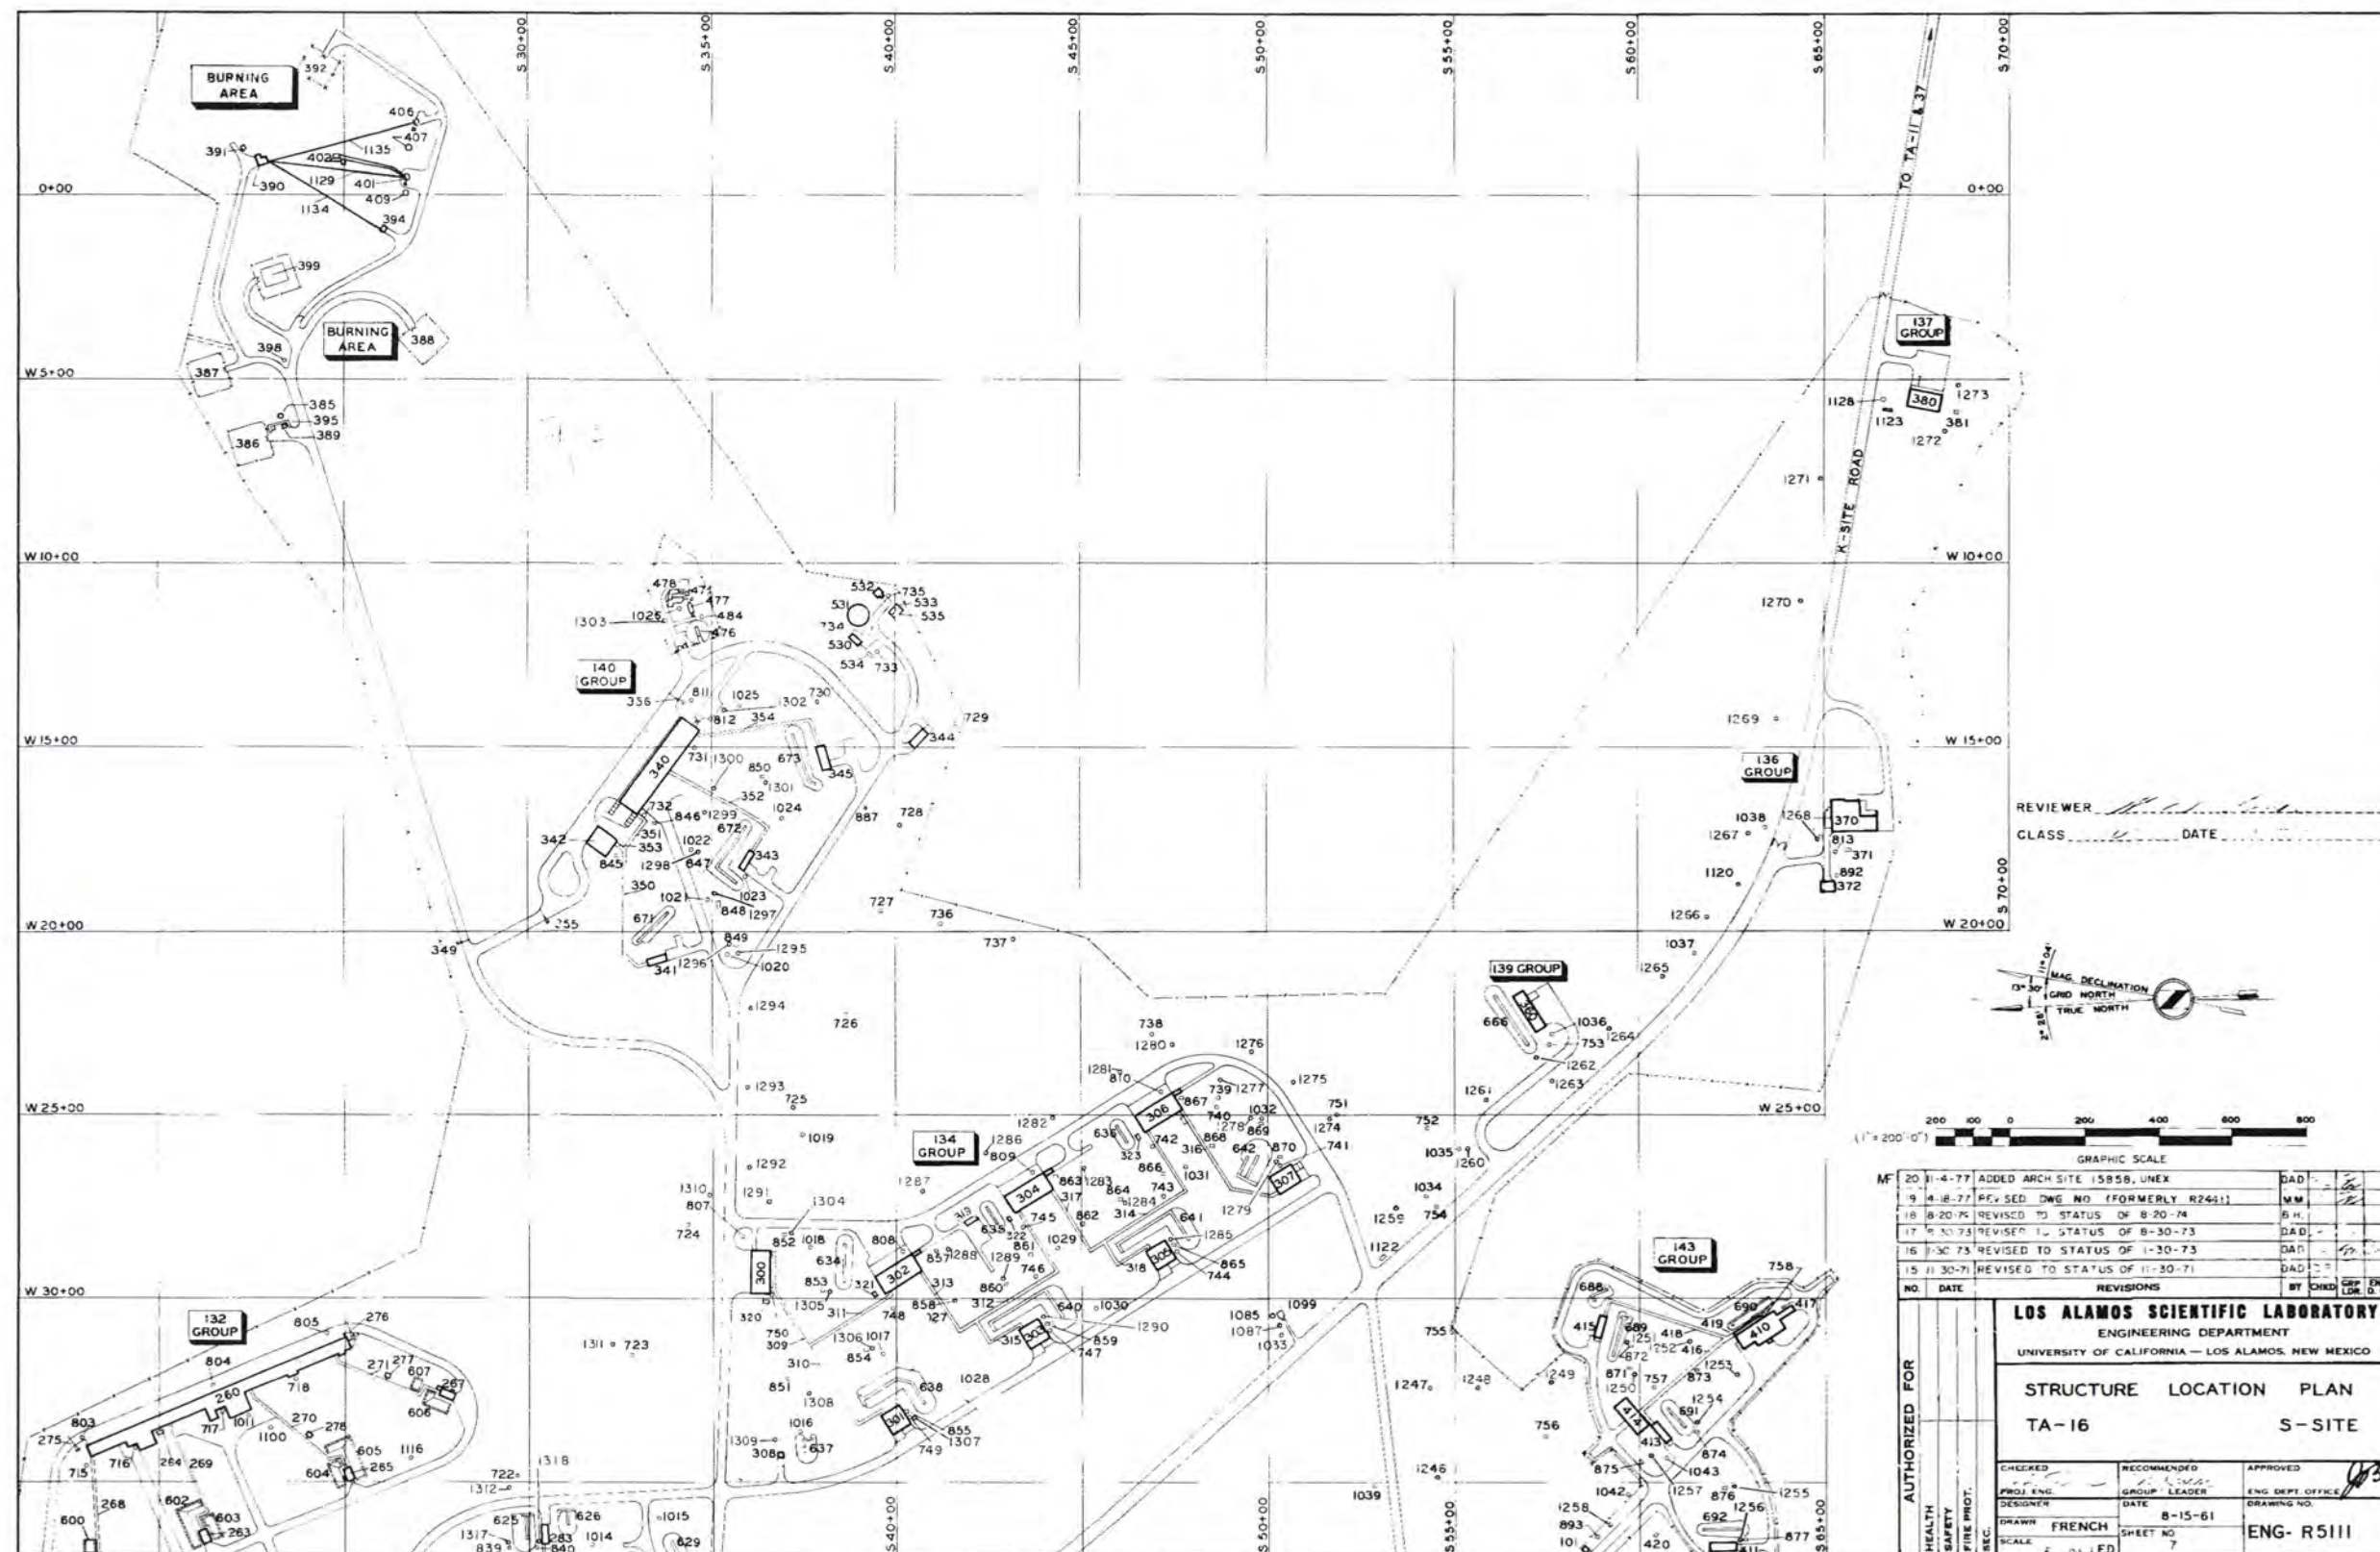

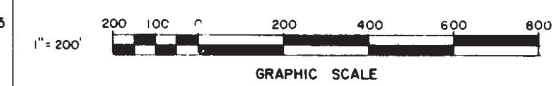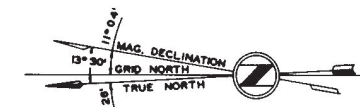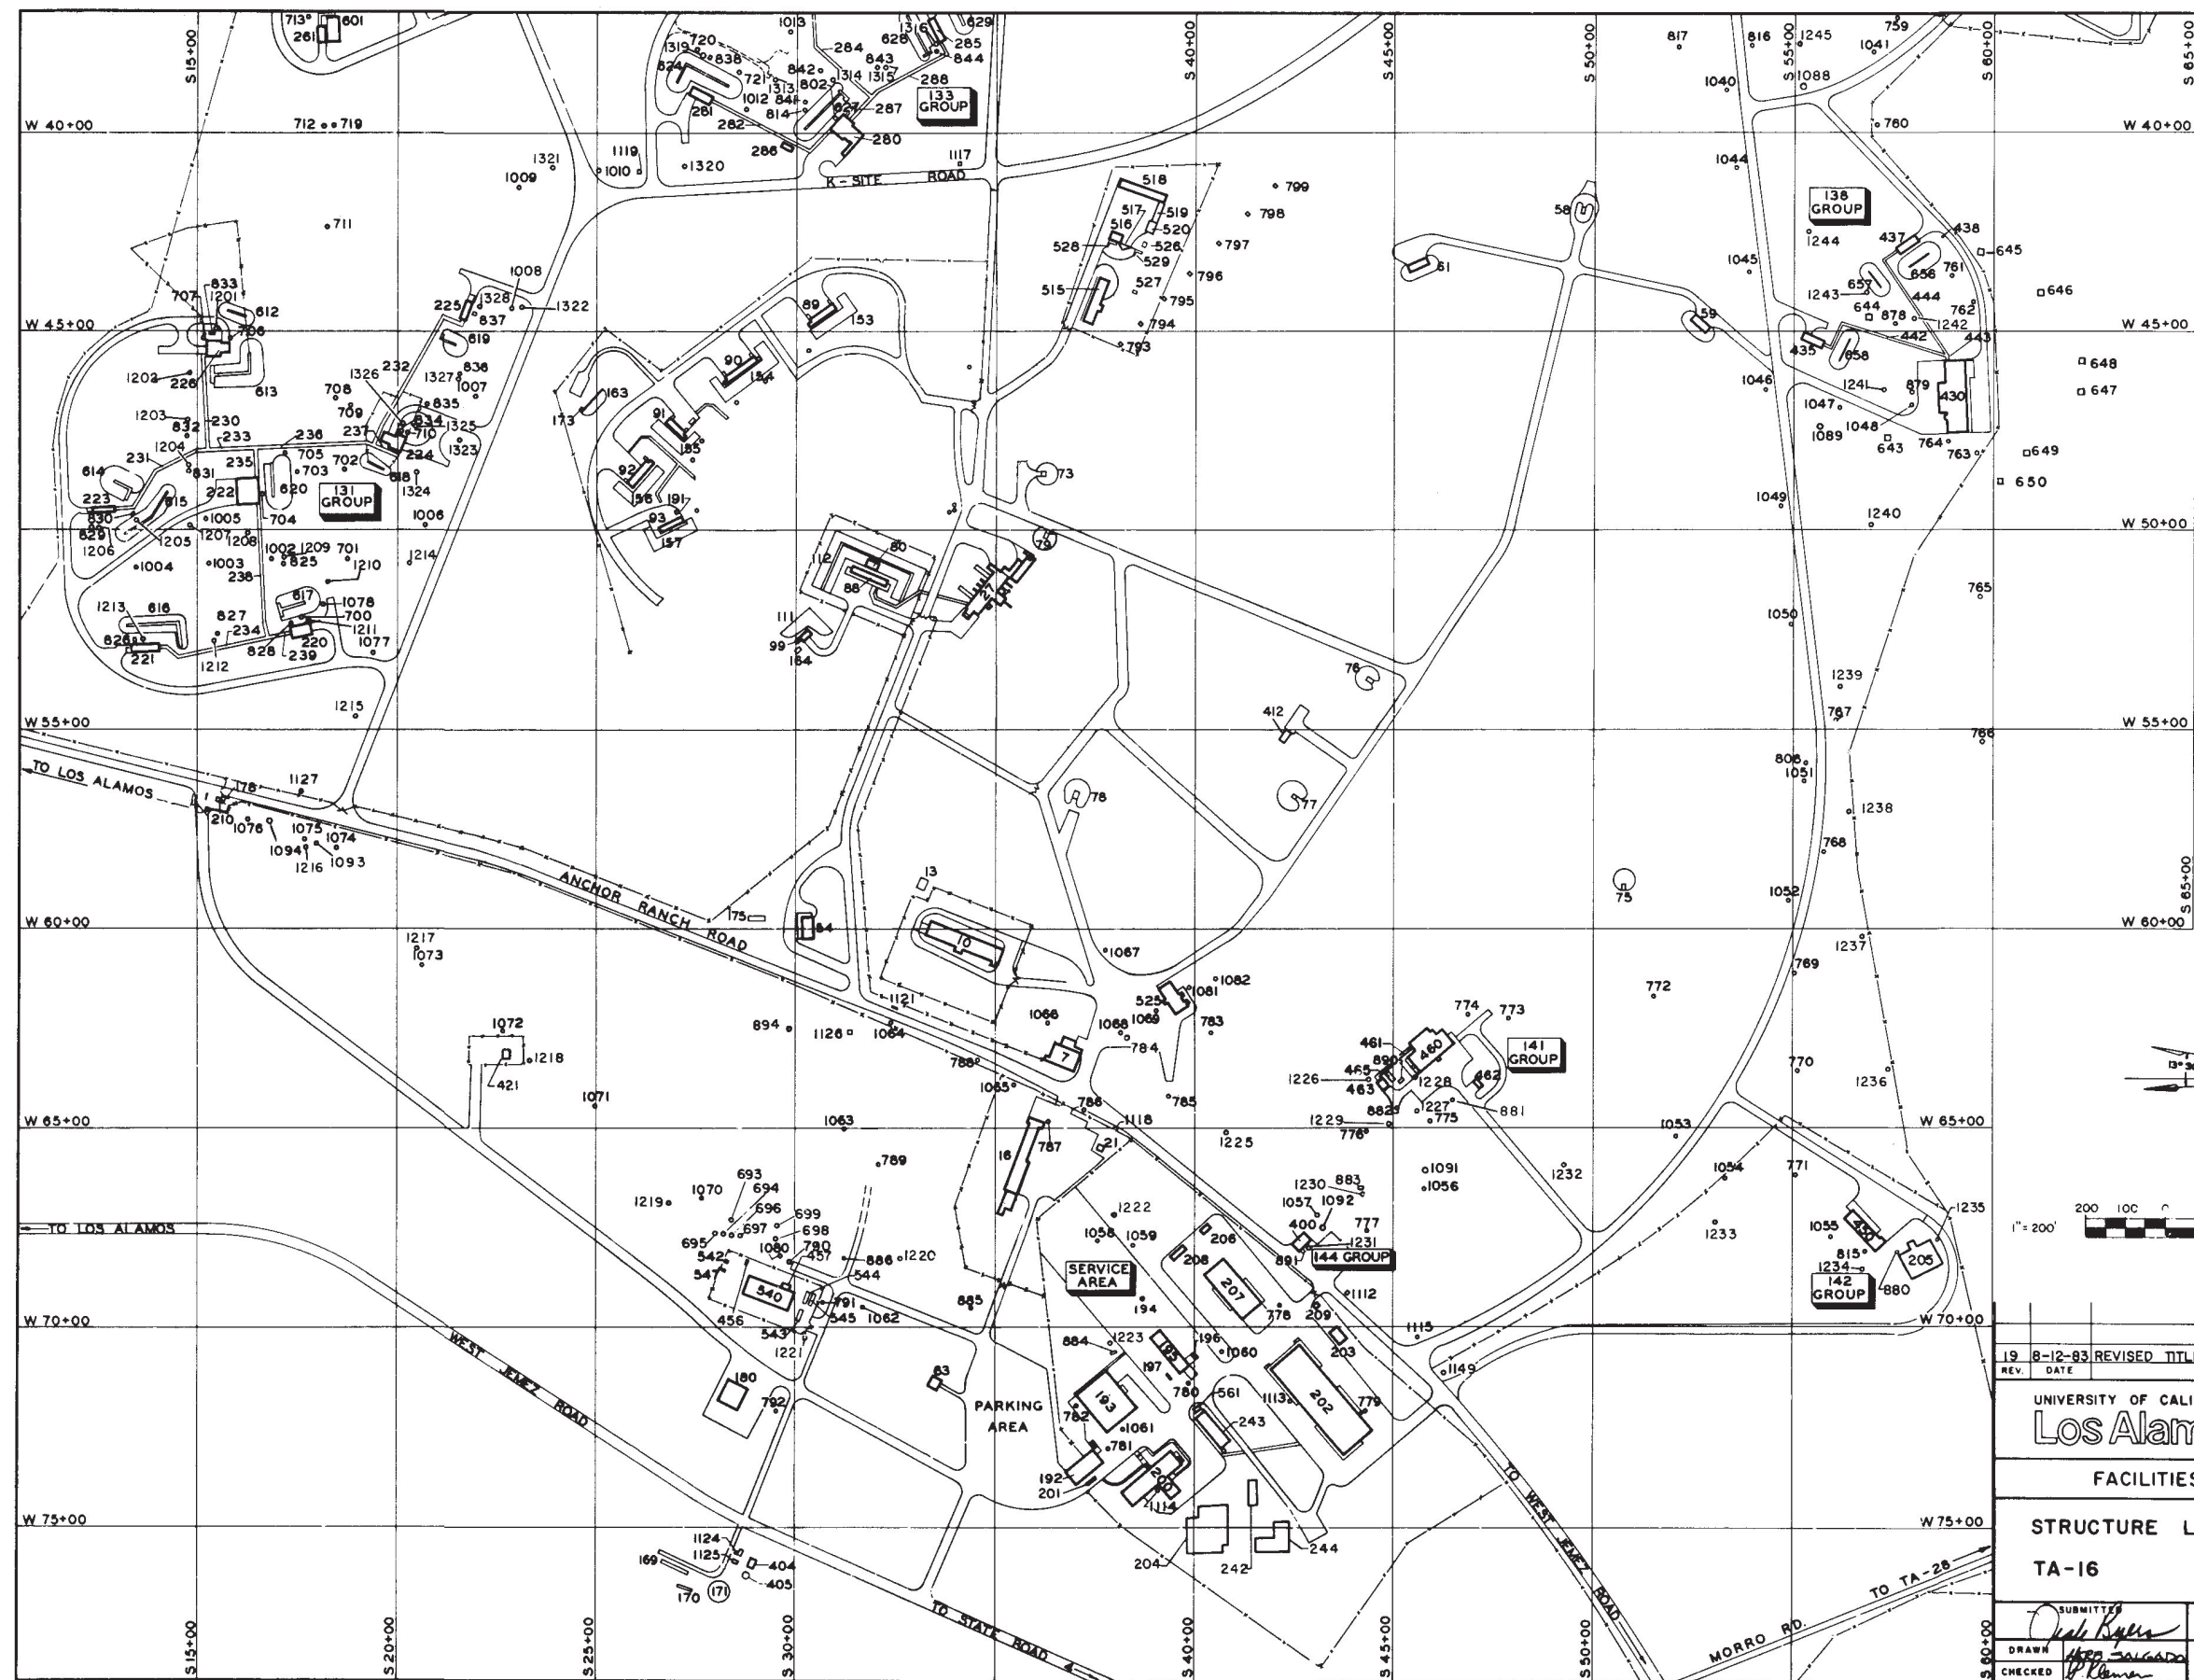

19 8-12-83 REVISED TITLE BLOCK & DWG TO STATUS OF 8-10-83 HS	
REV. DATE	REVISION
UNIVERSITY OF CALIFORNIA Los Alamos Los Alamos National Laboratory Los Alamos, New Mexico 87545	
FACILITIES ENGINEERING DIVISION	
STRUCTURE LOCATION PLAN TA-16 S-SITE	
SEC CLASSIFICATION CLASS 4 REVIEWER [Signature] DATE 10-19-83	
SUBMITTED [Signature]	RECOMMENDED [Signature]
DRAWN [Signature]	DATE 8-12-83
CHECKED [Signature]	SHEET NO. 6 OF 7
DRAWING NO. ENG-R5111	

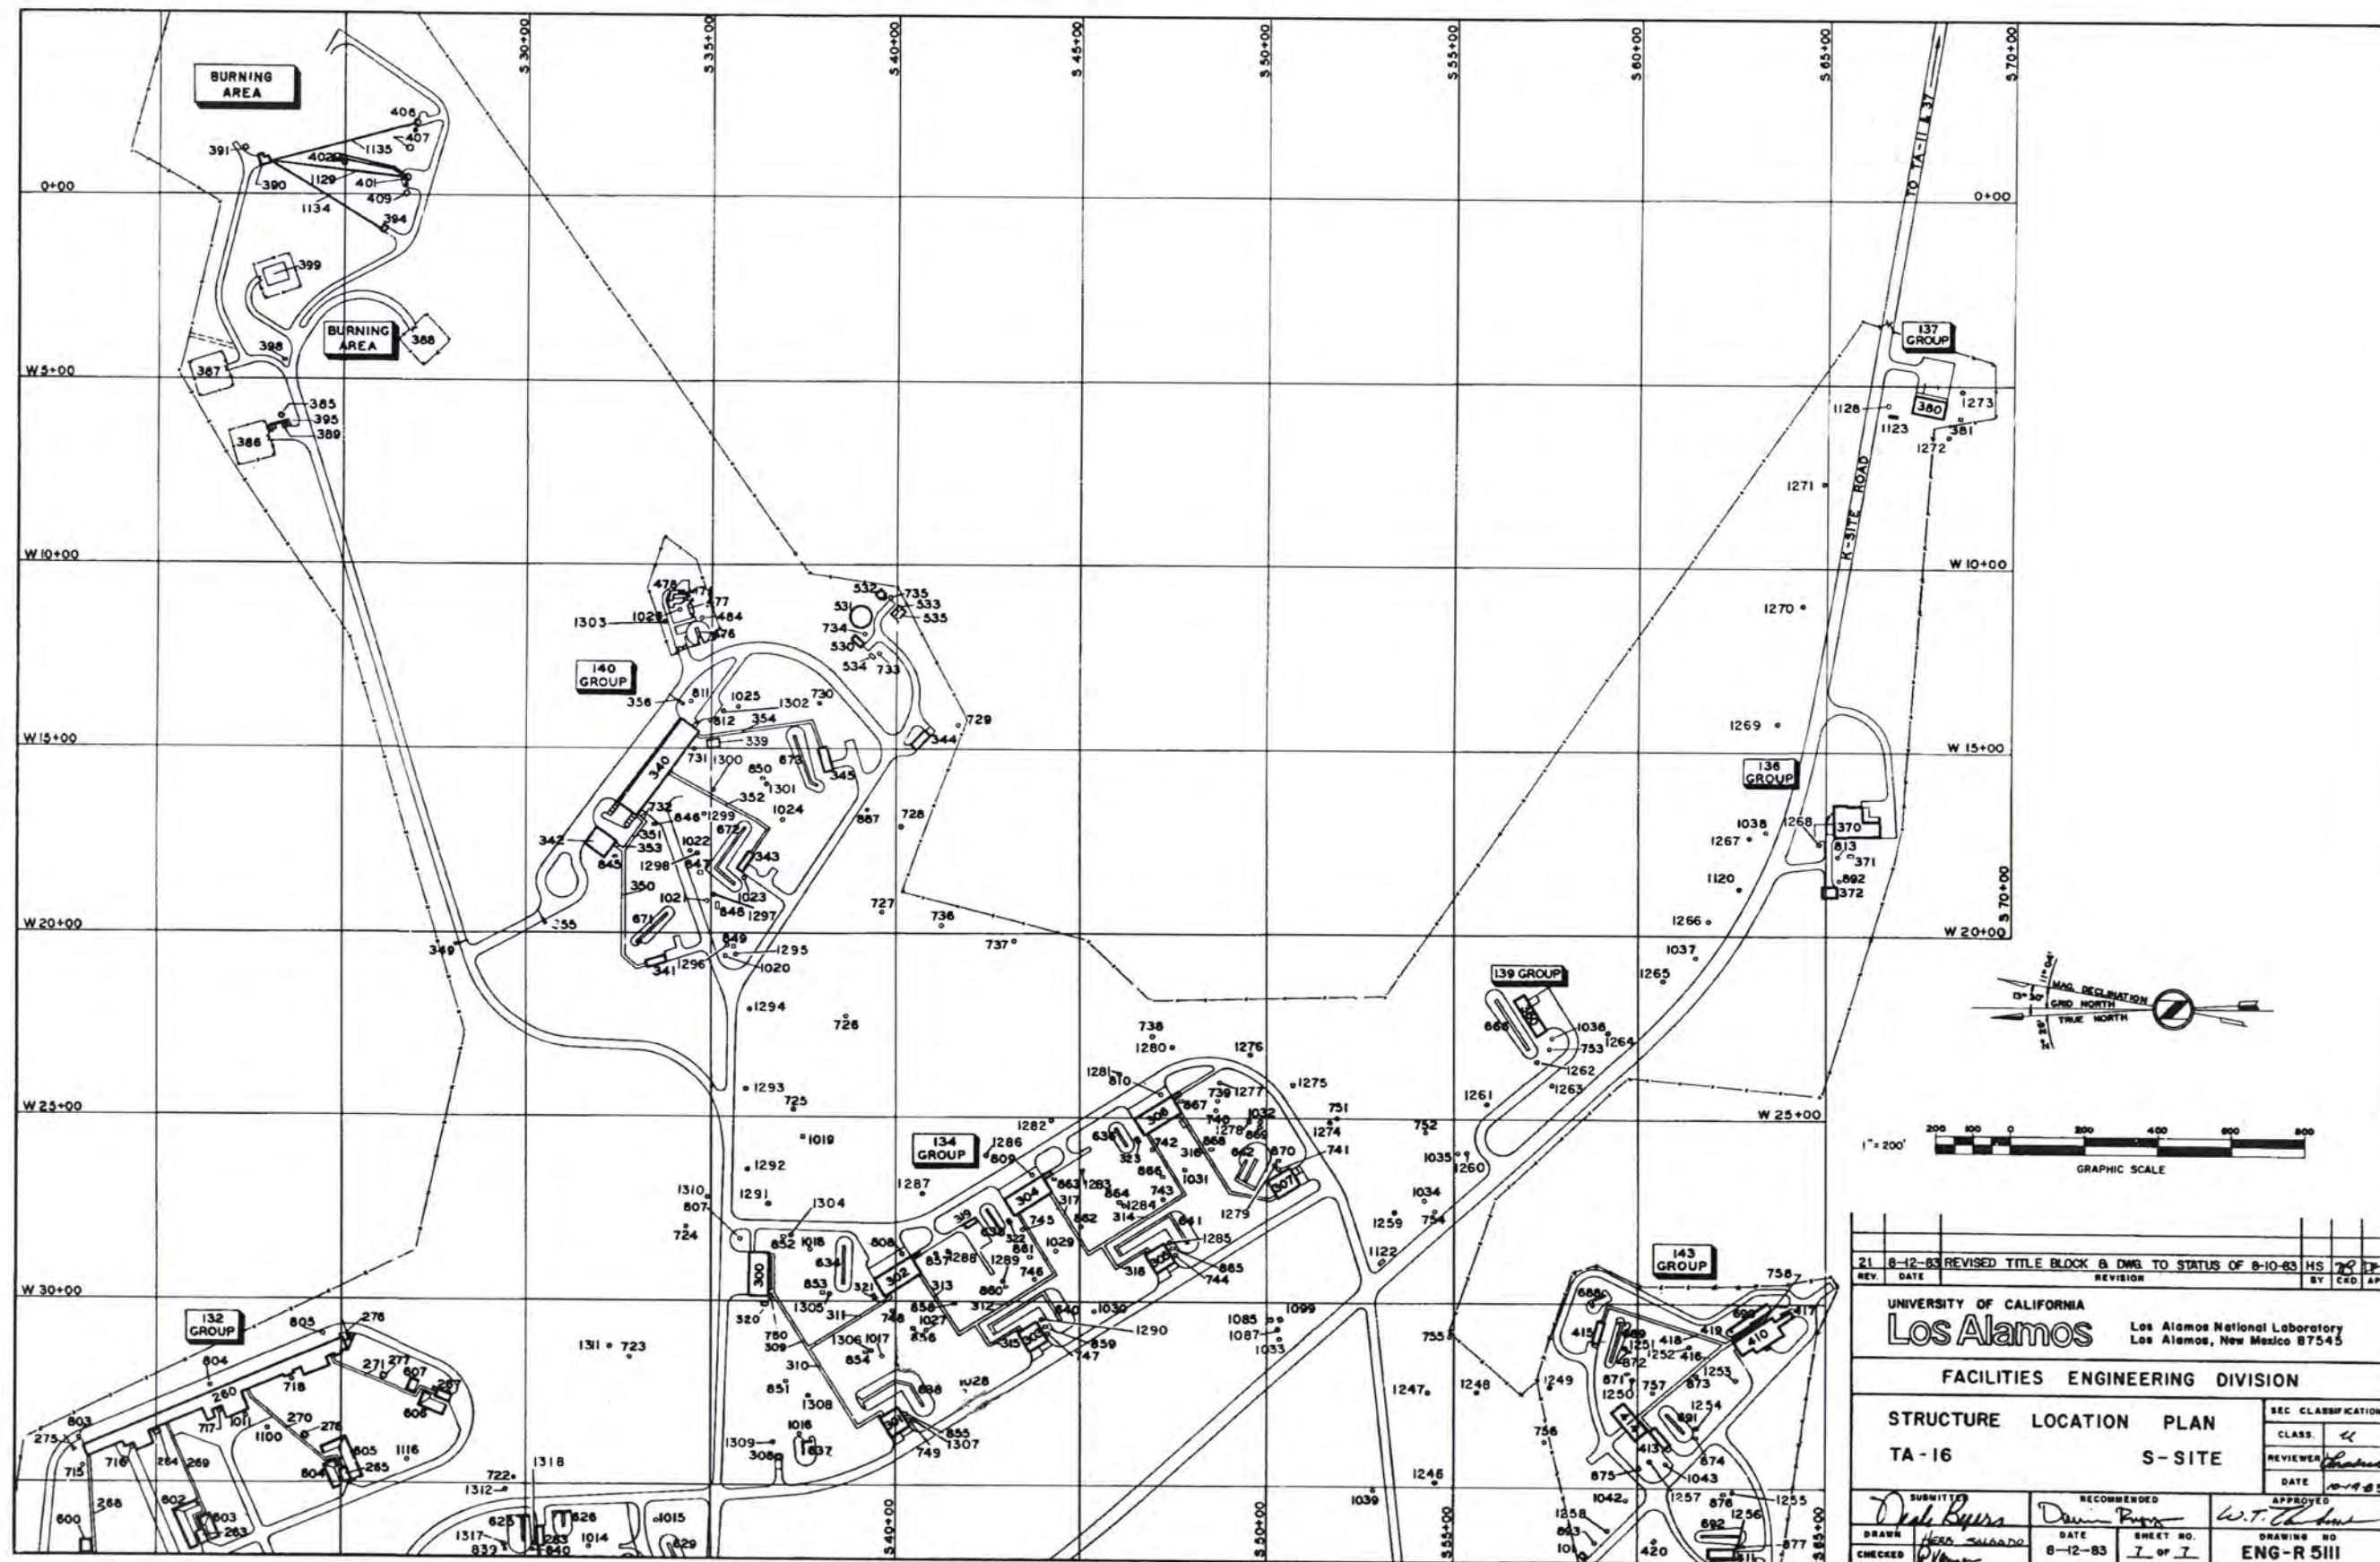

REV.	DATE	REVISION	BY	CHKD	APP
21	8-12-83	REVISED TITLE BLOCK & DWG. TO STATUS OF 8-10-83	HS	79	JP

UNIVERSITY OF CALIFORNIA
Los Alamos Los Alamos National Laboratory
 Los Alamos, New Mexico 87545



FACILITIES ENGINEERING DIVISION

STRUCTURE LOCATION PLAN
 TA-16 S-SITE

CLASS	U
REVIEWER	<i>Chambers</i>
DATE	10-19-83


SUBMITTED	RECOMMENDED	APPROVED
<i>Deak Bays</i>	<i>Deak Bays</i>	<i>W.T. Adams</i>
DRAWN	DATE	SHEET NO.
<i>Deak Bays</i>	8-12-83	1 OF 1
CHECKED		DRAWING NO.
<i>Deak Bays</i>		ENG-R 5111

TA-16

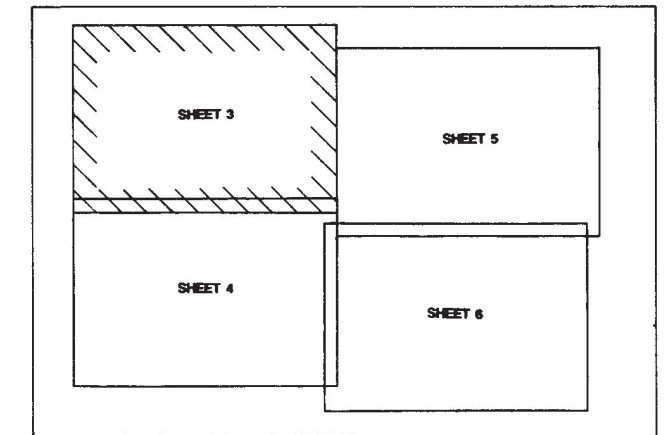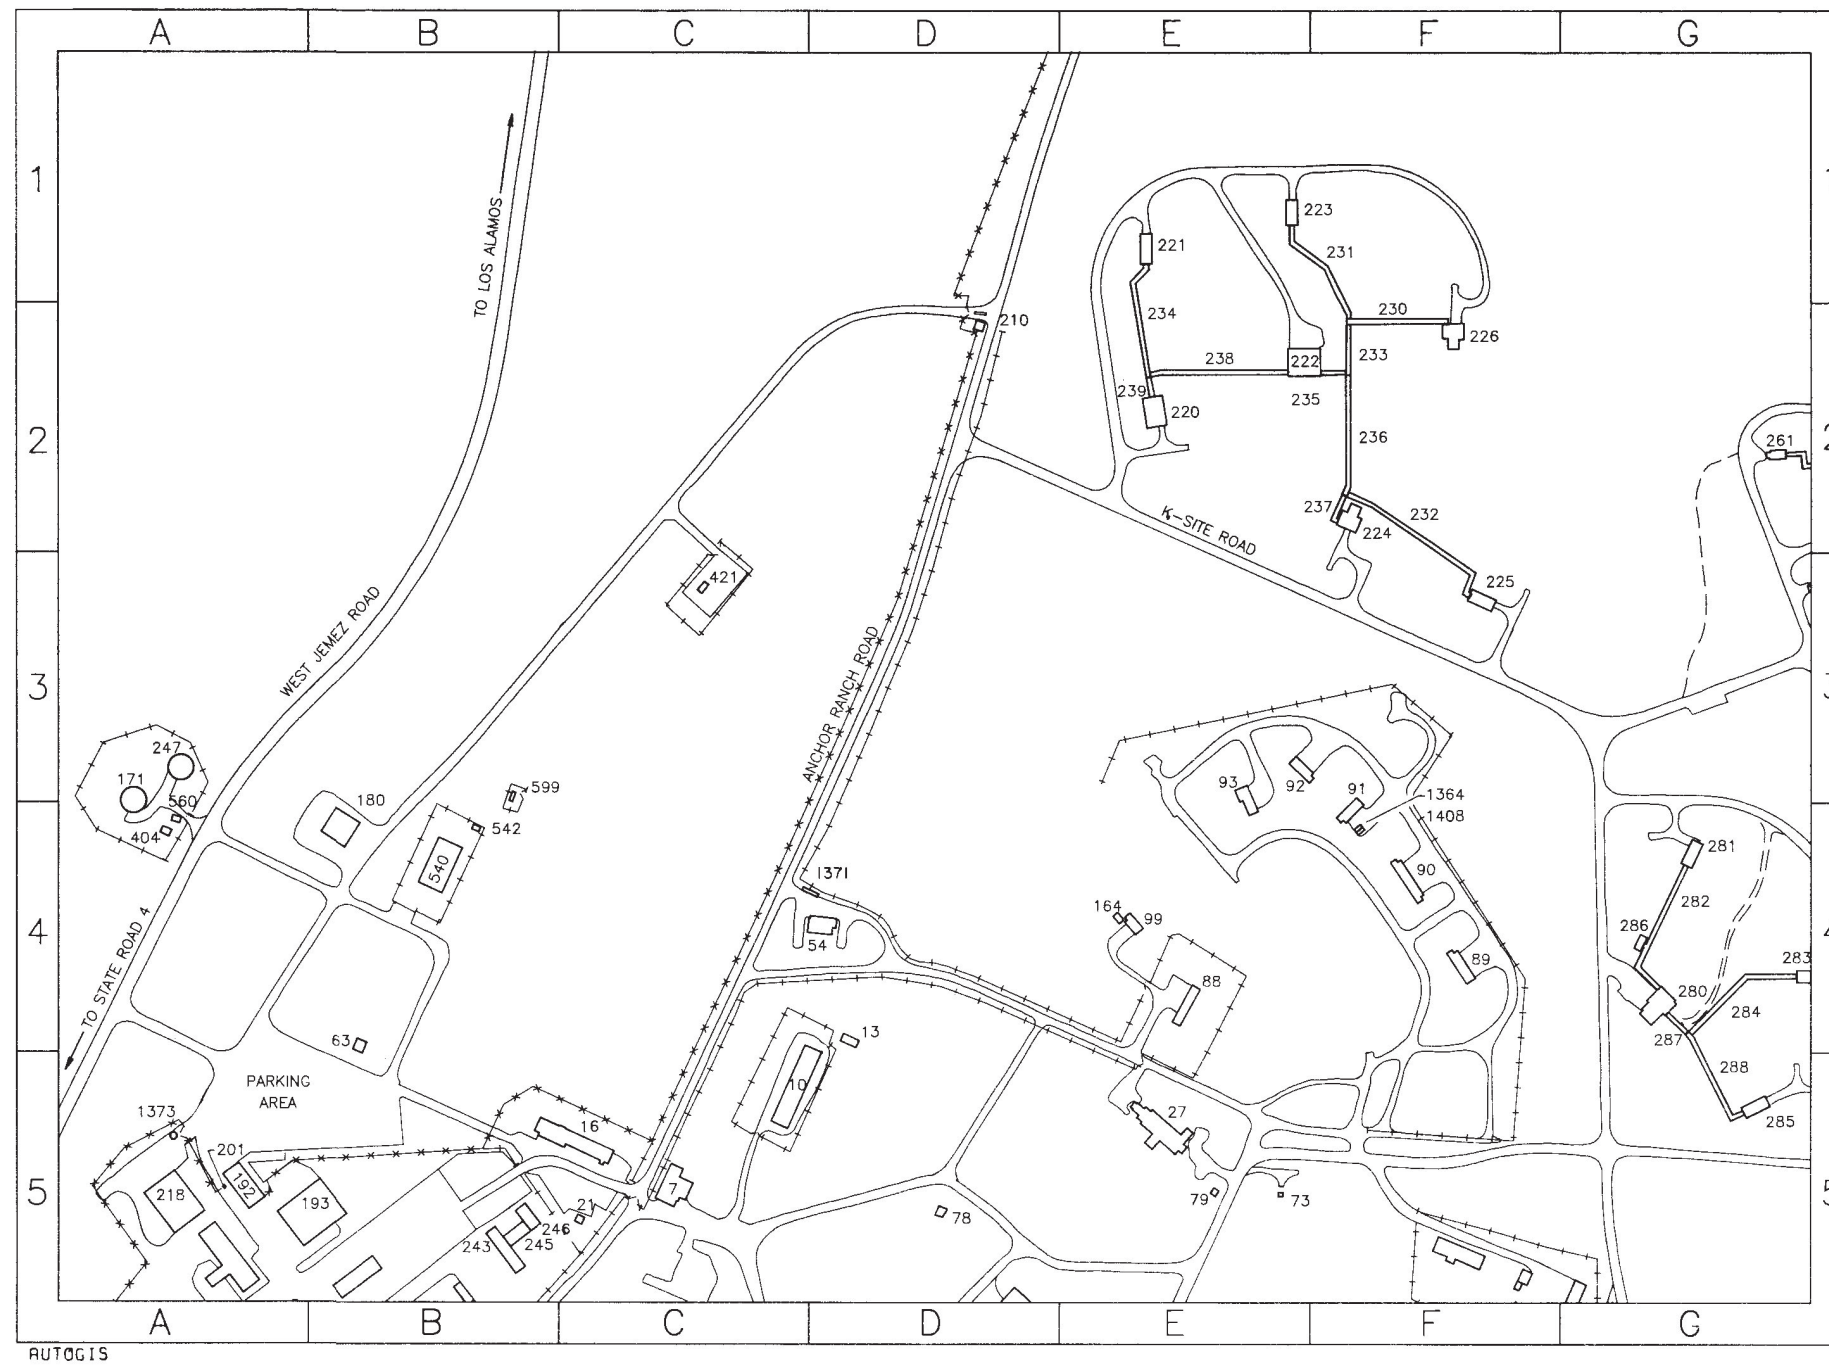


TA-16 MAP GUIDE

SCALE 1: 2400.

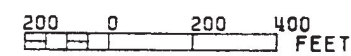



22	5-10-89	REDRAWN & REVISED TO STATUS OF 5-1-89	JUN 1989
REV	DATE	REVISION	BY
UNIVERSITY OF CALIFORNIA Los Alamos Los Alamos National Laboratory Los Alamos, New Mexico 87545			
FACILITIES ENGINEERING DIVISION			
STRUCTURE LOCATION MAP		SEC. CLASSIFICATION	
TA-16		CLASS U	
S-SITE		REVIEWER S. C. Cady	
DATE 5/10/89		APPROVED	
SUBMITTED J. M. R. M. R.	RECOMMENDED D. R. R.	APPROVED C. M. R.	
DRAWN J. M. R.	DATE 5-10-89	SHEET NO. 3 of 6	DRAWING NO. ENG-R 5111
CHECKED N. BYERS			

TA-16

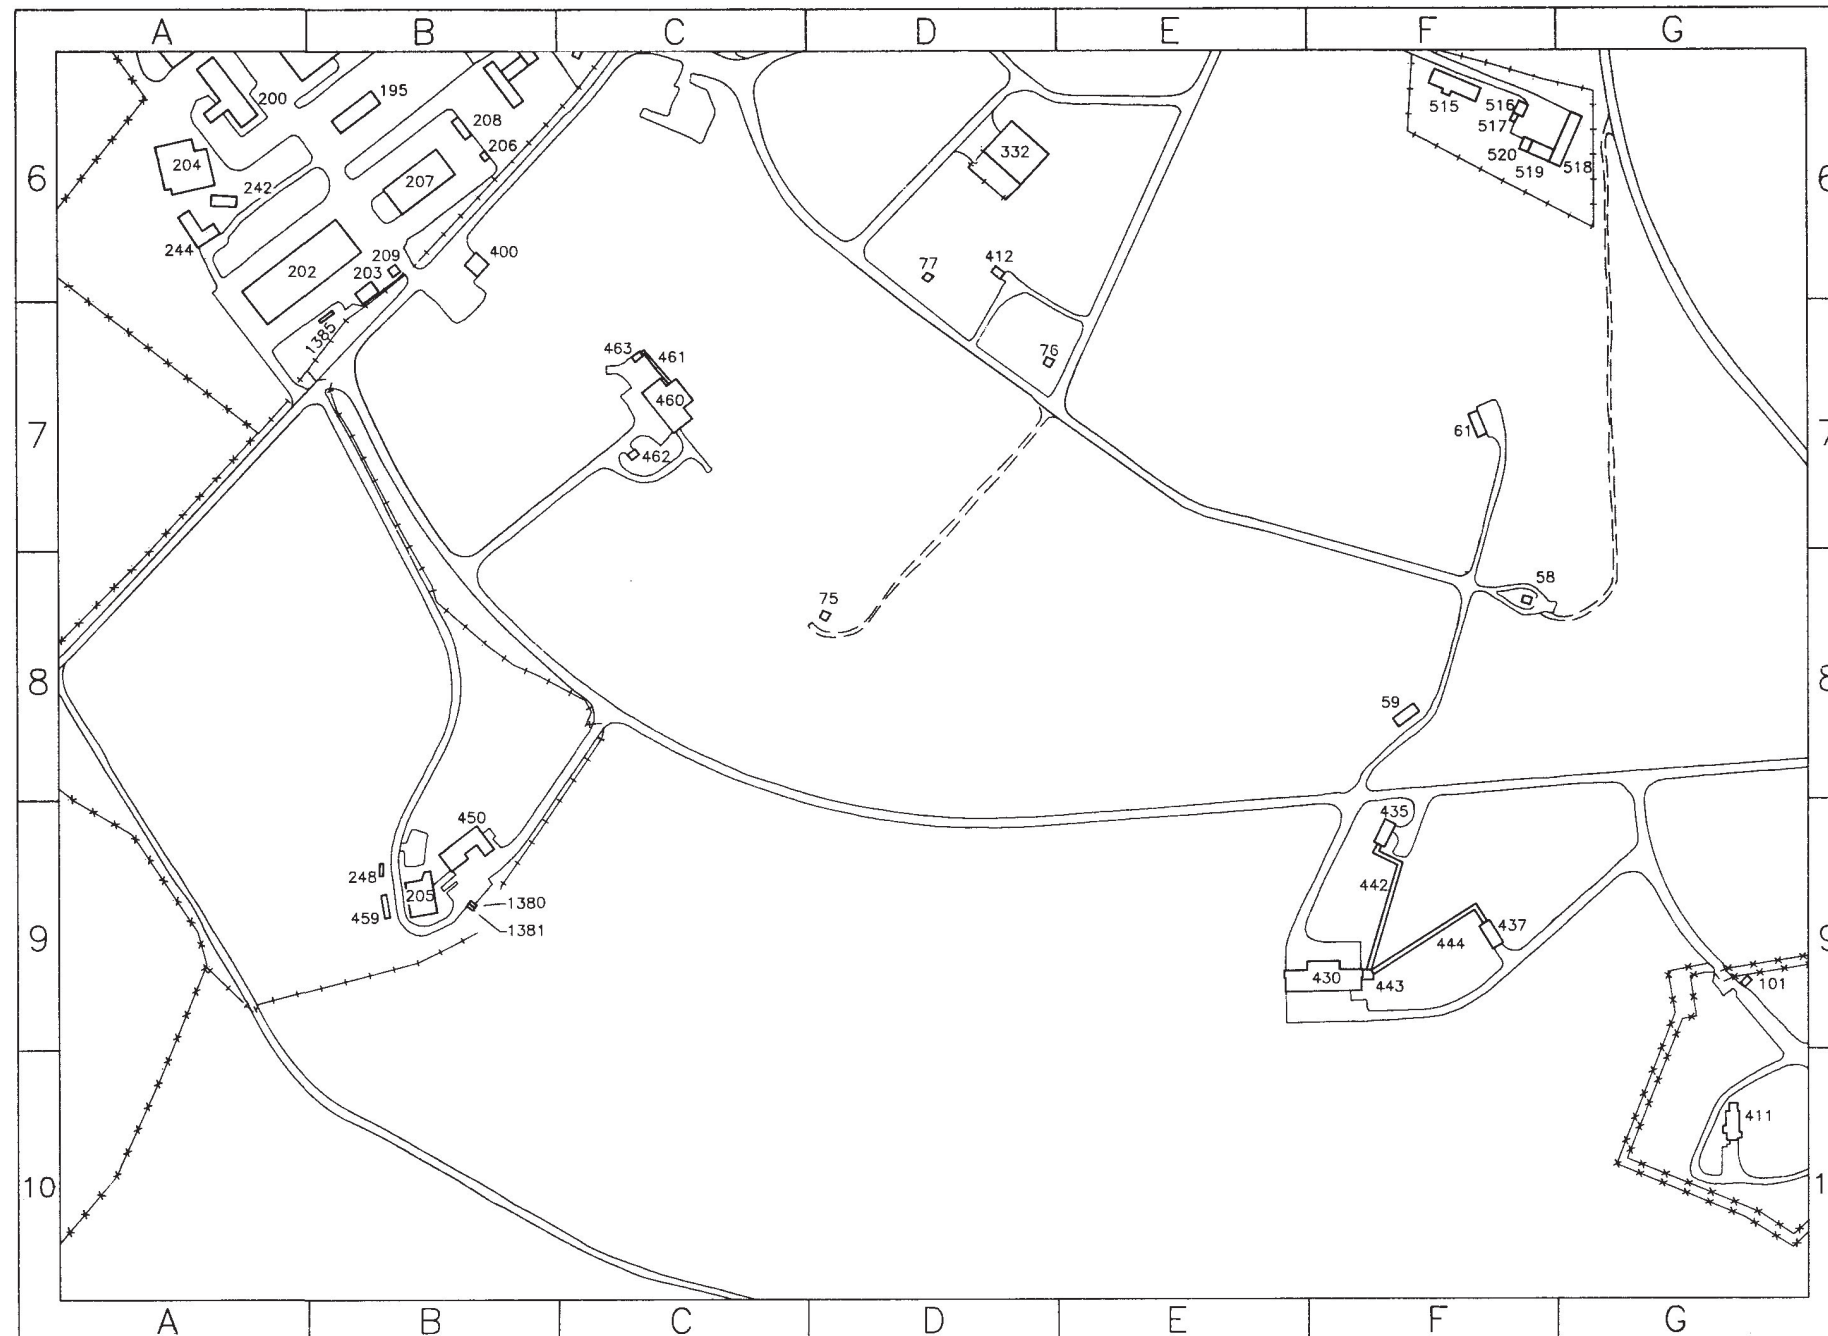

AUTOGIS


SCALE 1: 2400.

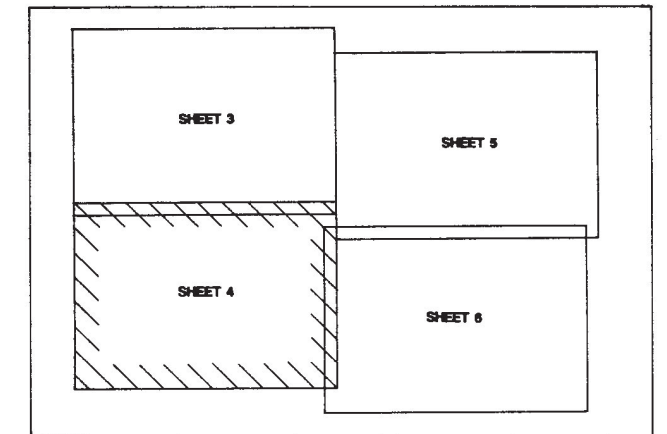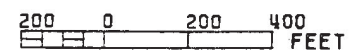

TA-16 MAP GUIDE



REV	DATE	REVISION	BY	CHKD	APP
22	5-10-88	REDRAWN & REVISED TO STATUS OF 5-1-89			
UNIVERSITY OF CALIFORNIA					
Los Alamos Los Alamos National Laboratory Los Alamos, New Mexico 87545					
FACILITIES ENGINEERING DIVISION					
STRUCTURE LOCATION MAP					SEC. CLASSIFICATION
TA-16					S-SITE
SUBMITTED					APPROVED
DRAWN J. WICK					DATE 5-10-89
CHECKED N. BYERS					4 OF 6
RECOMMENDED					ENG- R 5111
REVIEWER S. GARDNER					
DATE 5/10/89					

TA-16

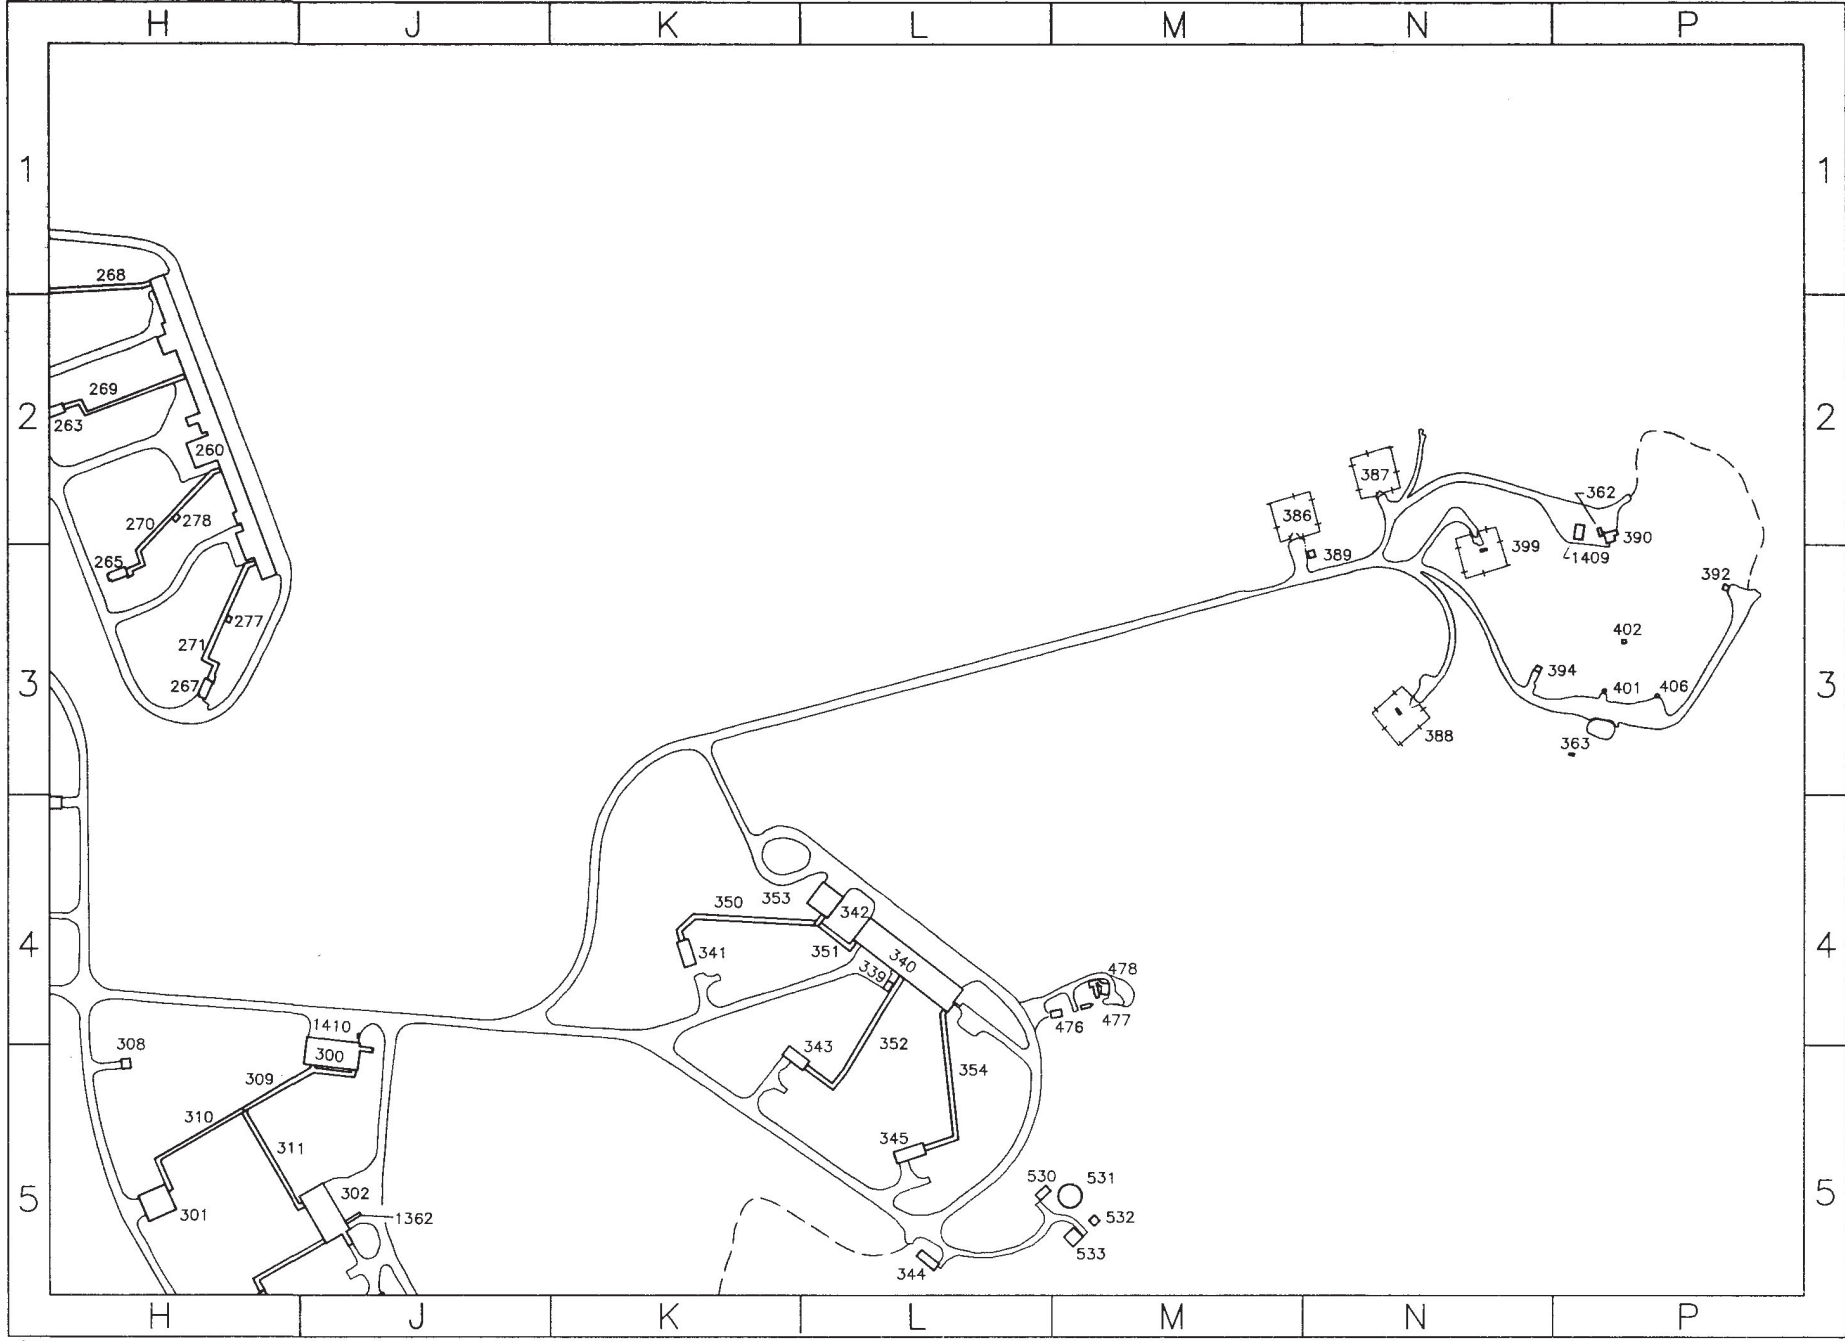

RUTOGIS


SCALE 1: 2400.

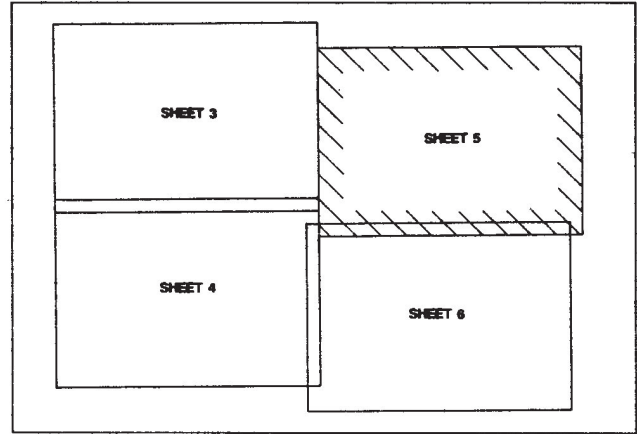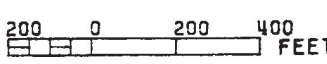



TA-16 MAP GUIDE

22	5-10-89	REDRAWN & REVISED TO STATUS OF 5-1-89	BY: J. B. BYERS
REV	DATE	REVISION	BY: CKD, APP
UNIVERSITY OF CALIFORNIA			
Los Alamos Los Alamos National Laboratory Los Alamos, New Mexico 87545			
FACILITIES ENGINEERING DIVISION			
STRUCTURE LOCATION MAP			SEC. CLASSIFICATION
TA-16			CLASS 14
S-SITE			REVIEWER J. B. BYERS
			DATE 5/10/89
SUBMITTED	RECOMMENDED	APPROVED	
J. B. BYERS	J. B. BYERS	J. B. BYERS	
DRAWN	DATE	SHEET NO.	DRAWING NO.
J. B. BYERS	5-10-89	5 OF 6	ENG- R 5111
CHECKED			
N. BYERS			

TA-16

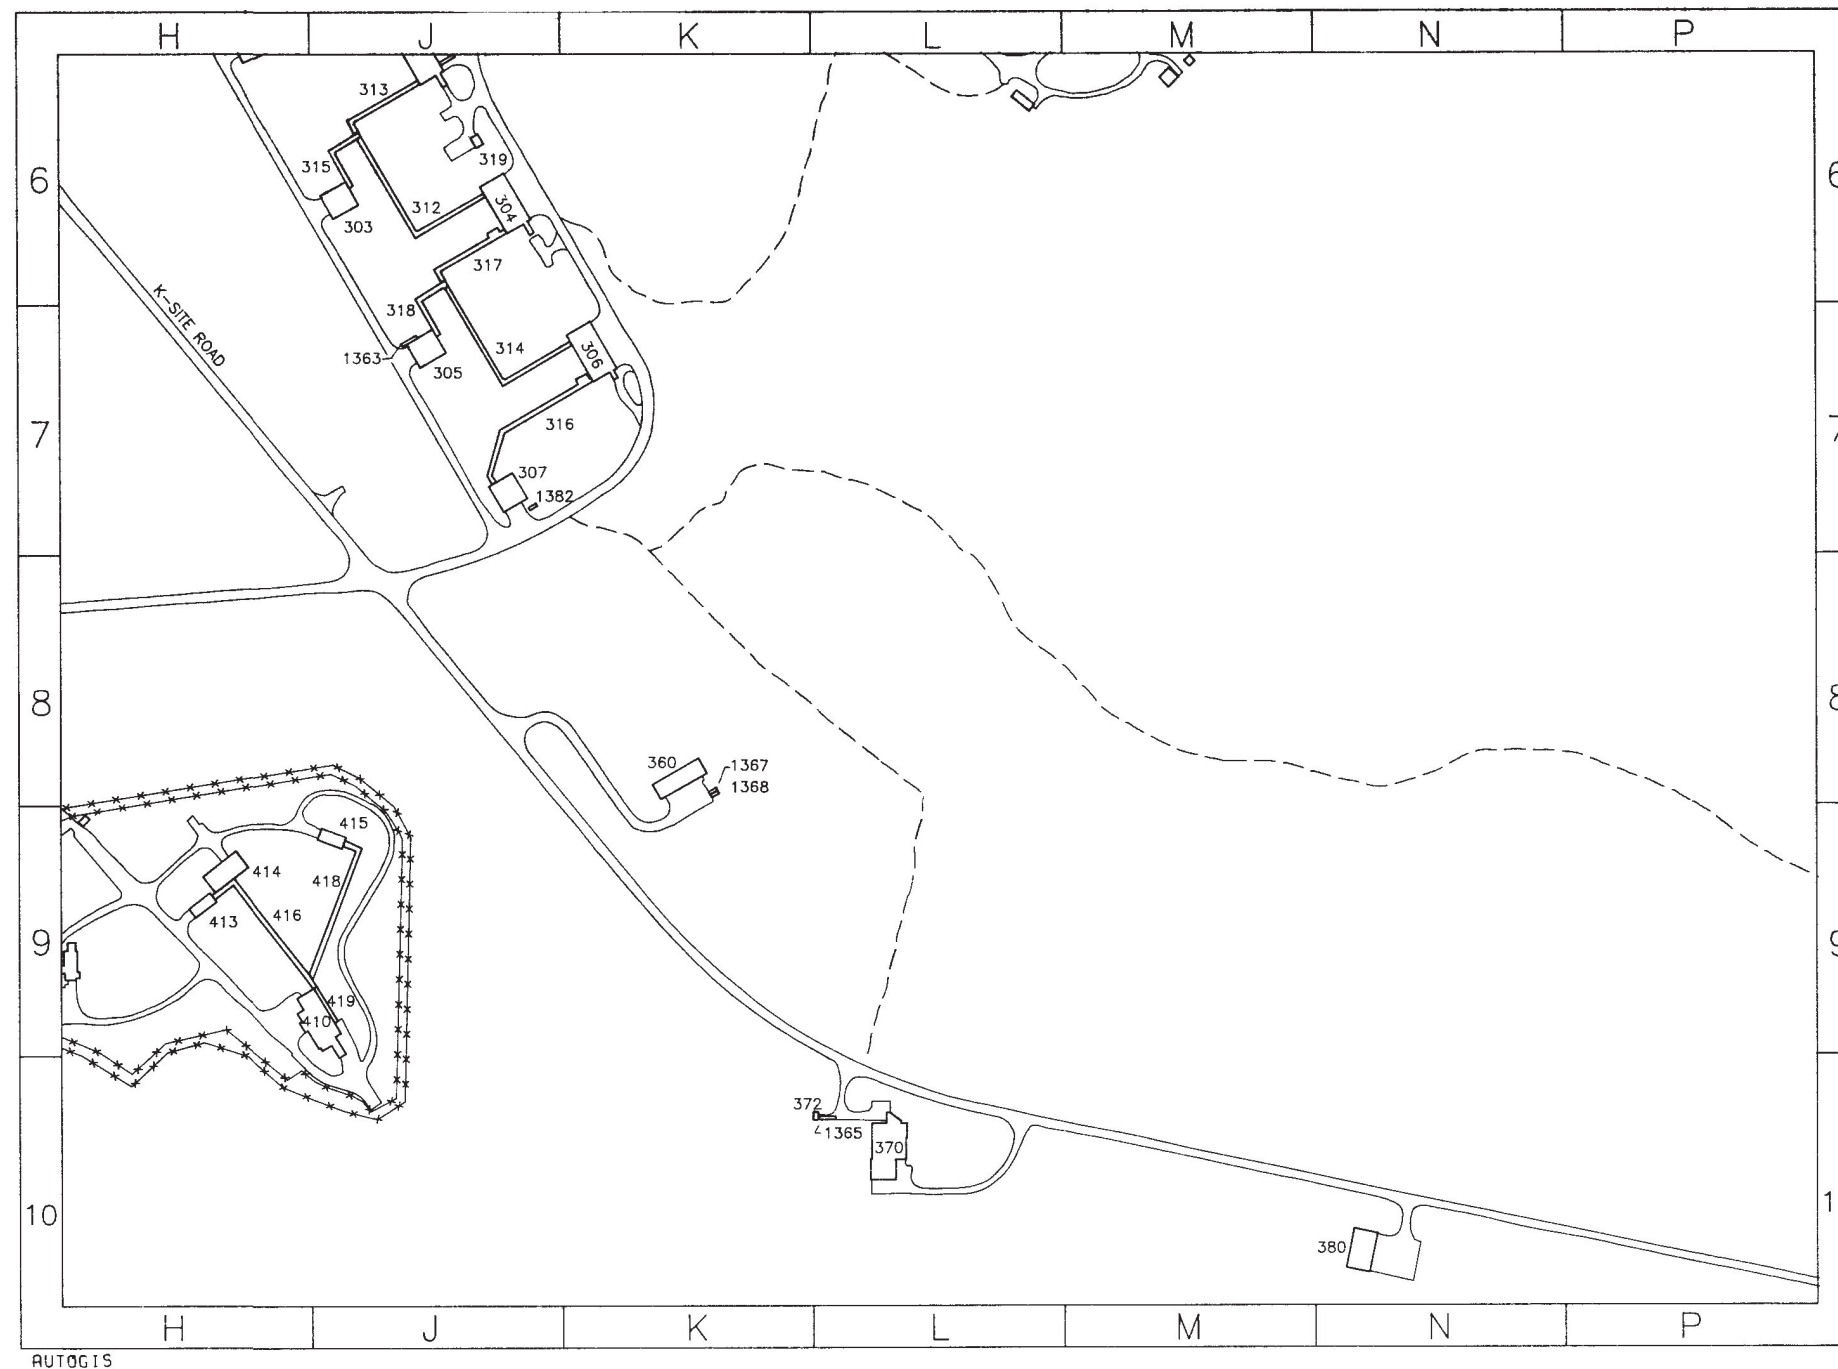


SCALE 1: 2400.

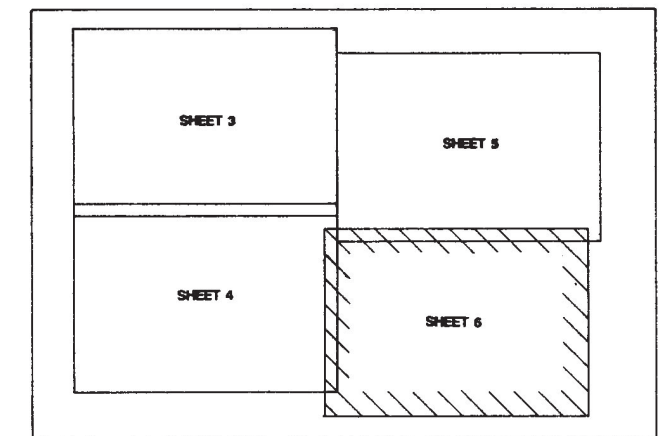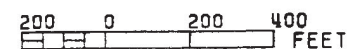


TA-16 MAP GUIDE


22	5-10-89	REDRAWN & REVISED TO STATUS OF 5-1-89	BY: JMD	APP: GMB
REV	DATE	REVISION	BY	APP
UNIVERSITY OF CALIFORNIA Los Alamos Los Alamos National Laboratory Los Alamos, New Mexico 87545				
FACILITIES ENGINEERING DIVISION				
STRUCTURE LOCATION MAP			SEC. CLASSIFICATION	
TA-16			S-SITE	
SUBMITTED J. MORK			RECOMMENDED D. L. M. S.	
DATE 5-10-89			DATE 5/10/89	
CHECKED N. BYERS			APPROVED C. J. M. S.	
SHEET NO. 6 OF 6			DRAWING NO. ENG- R 5111	

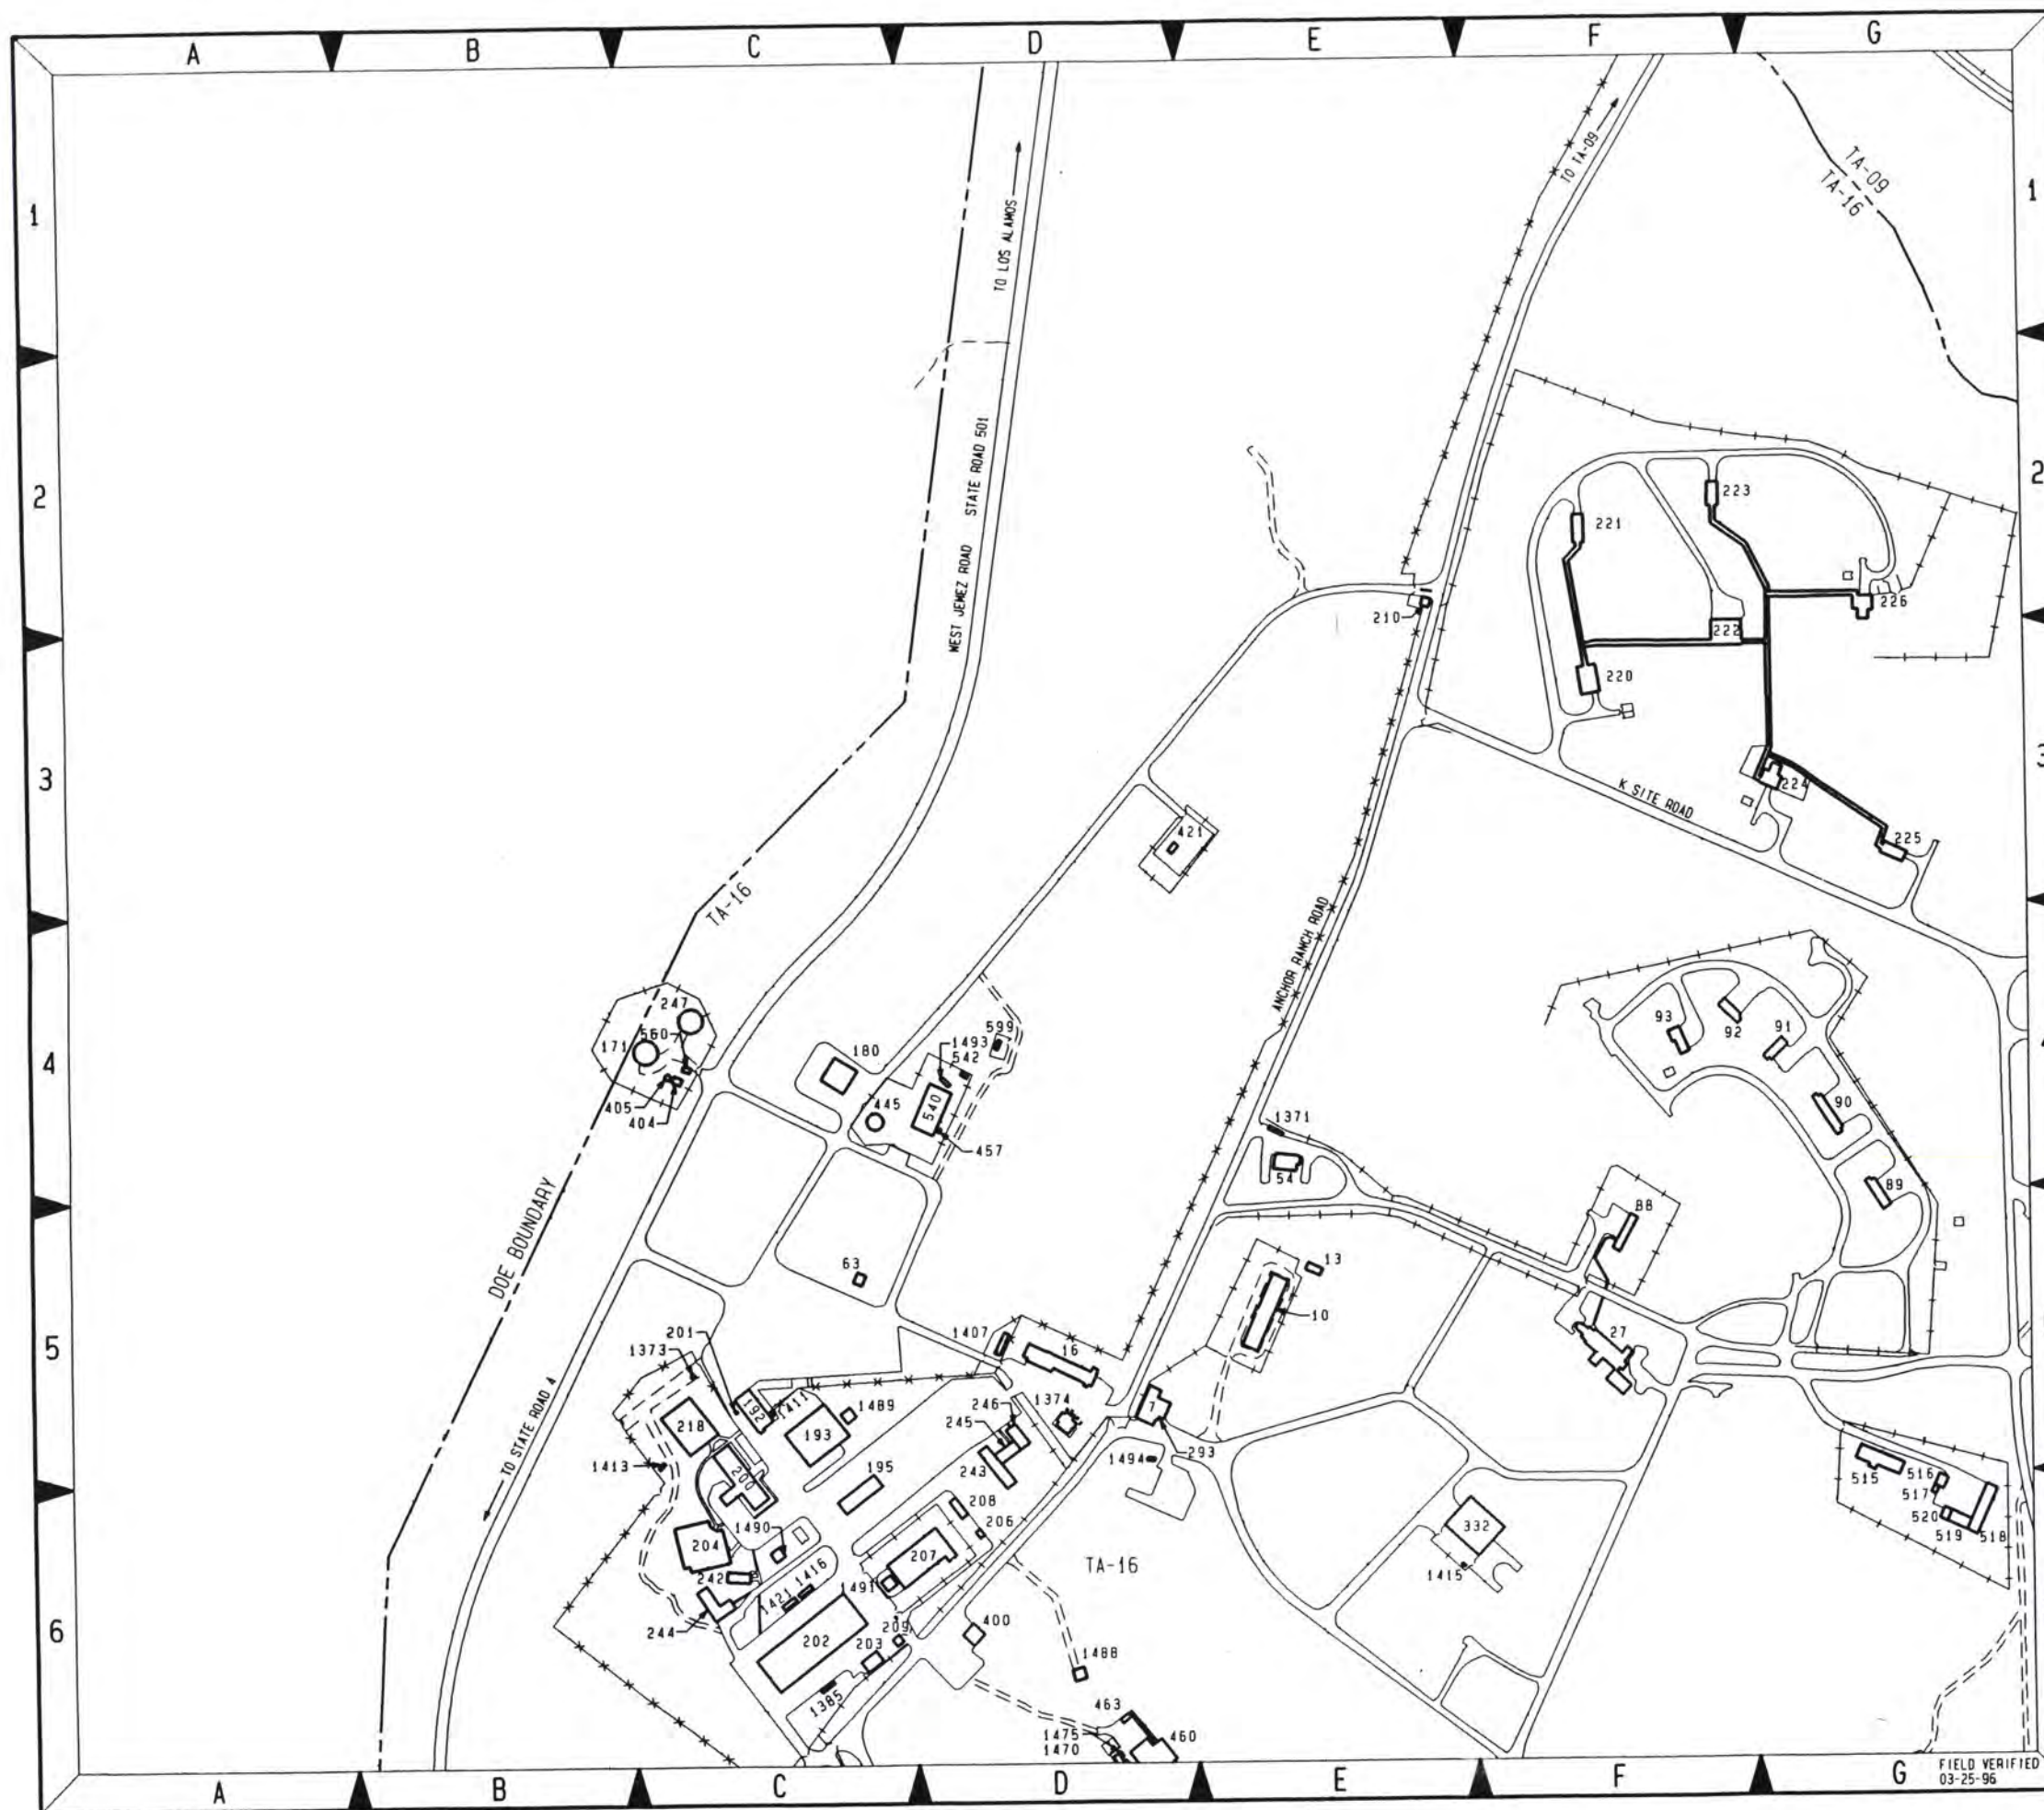

KEY MAP

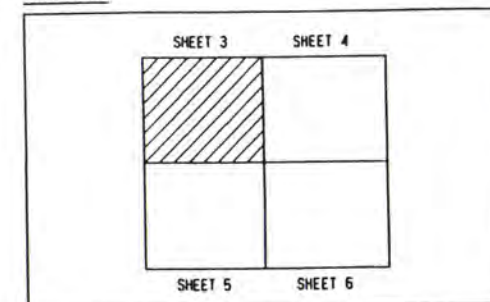


SCALE: 1:2400


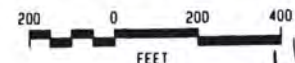


7	03-29-96	REVISED TO STATUS OF 03-25-96	JAC	JAC	JPM	JAF	FCT				
6	01-31-96	REVISED TO STATUS OF 01-26-96	JAC	JAC	JPM	JAF	FCT				
5	12-20-95	REVISED TO STATUS OF 12-19-95	JAC	JAC	JPM	JAF	FCT				
NO	DATE	CLASS REV	DESCRIPTION				DWN	VER	CHKD	SUB	APP

JOHNSON CONTROLS		AS-BUILT STRUCTURE LOCATION MAPS	
TA-16		S-SITE	
SUBMITTED JERRY FORTE		APPROVED FOR RELEASE FRED THOMPSON	
Los Alamos		Los Alamos National Laboratory Los Alamos, New Mexico 87545	
CLASSIFICATION		REVIEWER H. SALAZAR	
PROJECT ID		DRAWING NO	
11952		AB21	
FIELD VERIFIED 03-25-96		DATE 4/4/96	
JC1 NO 91-020		SHEET 3 of 6	
7		7	

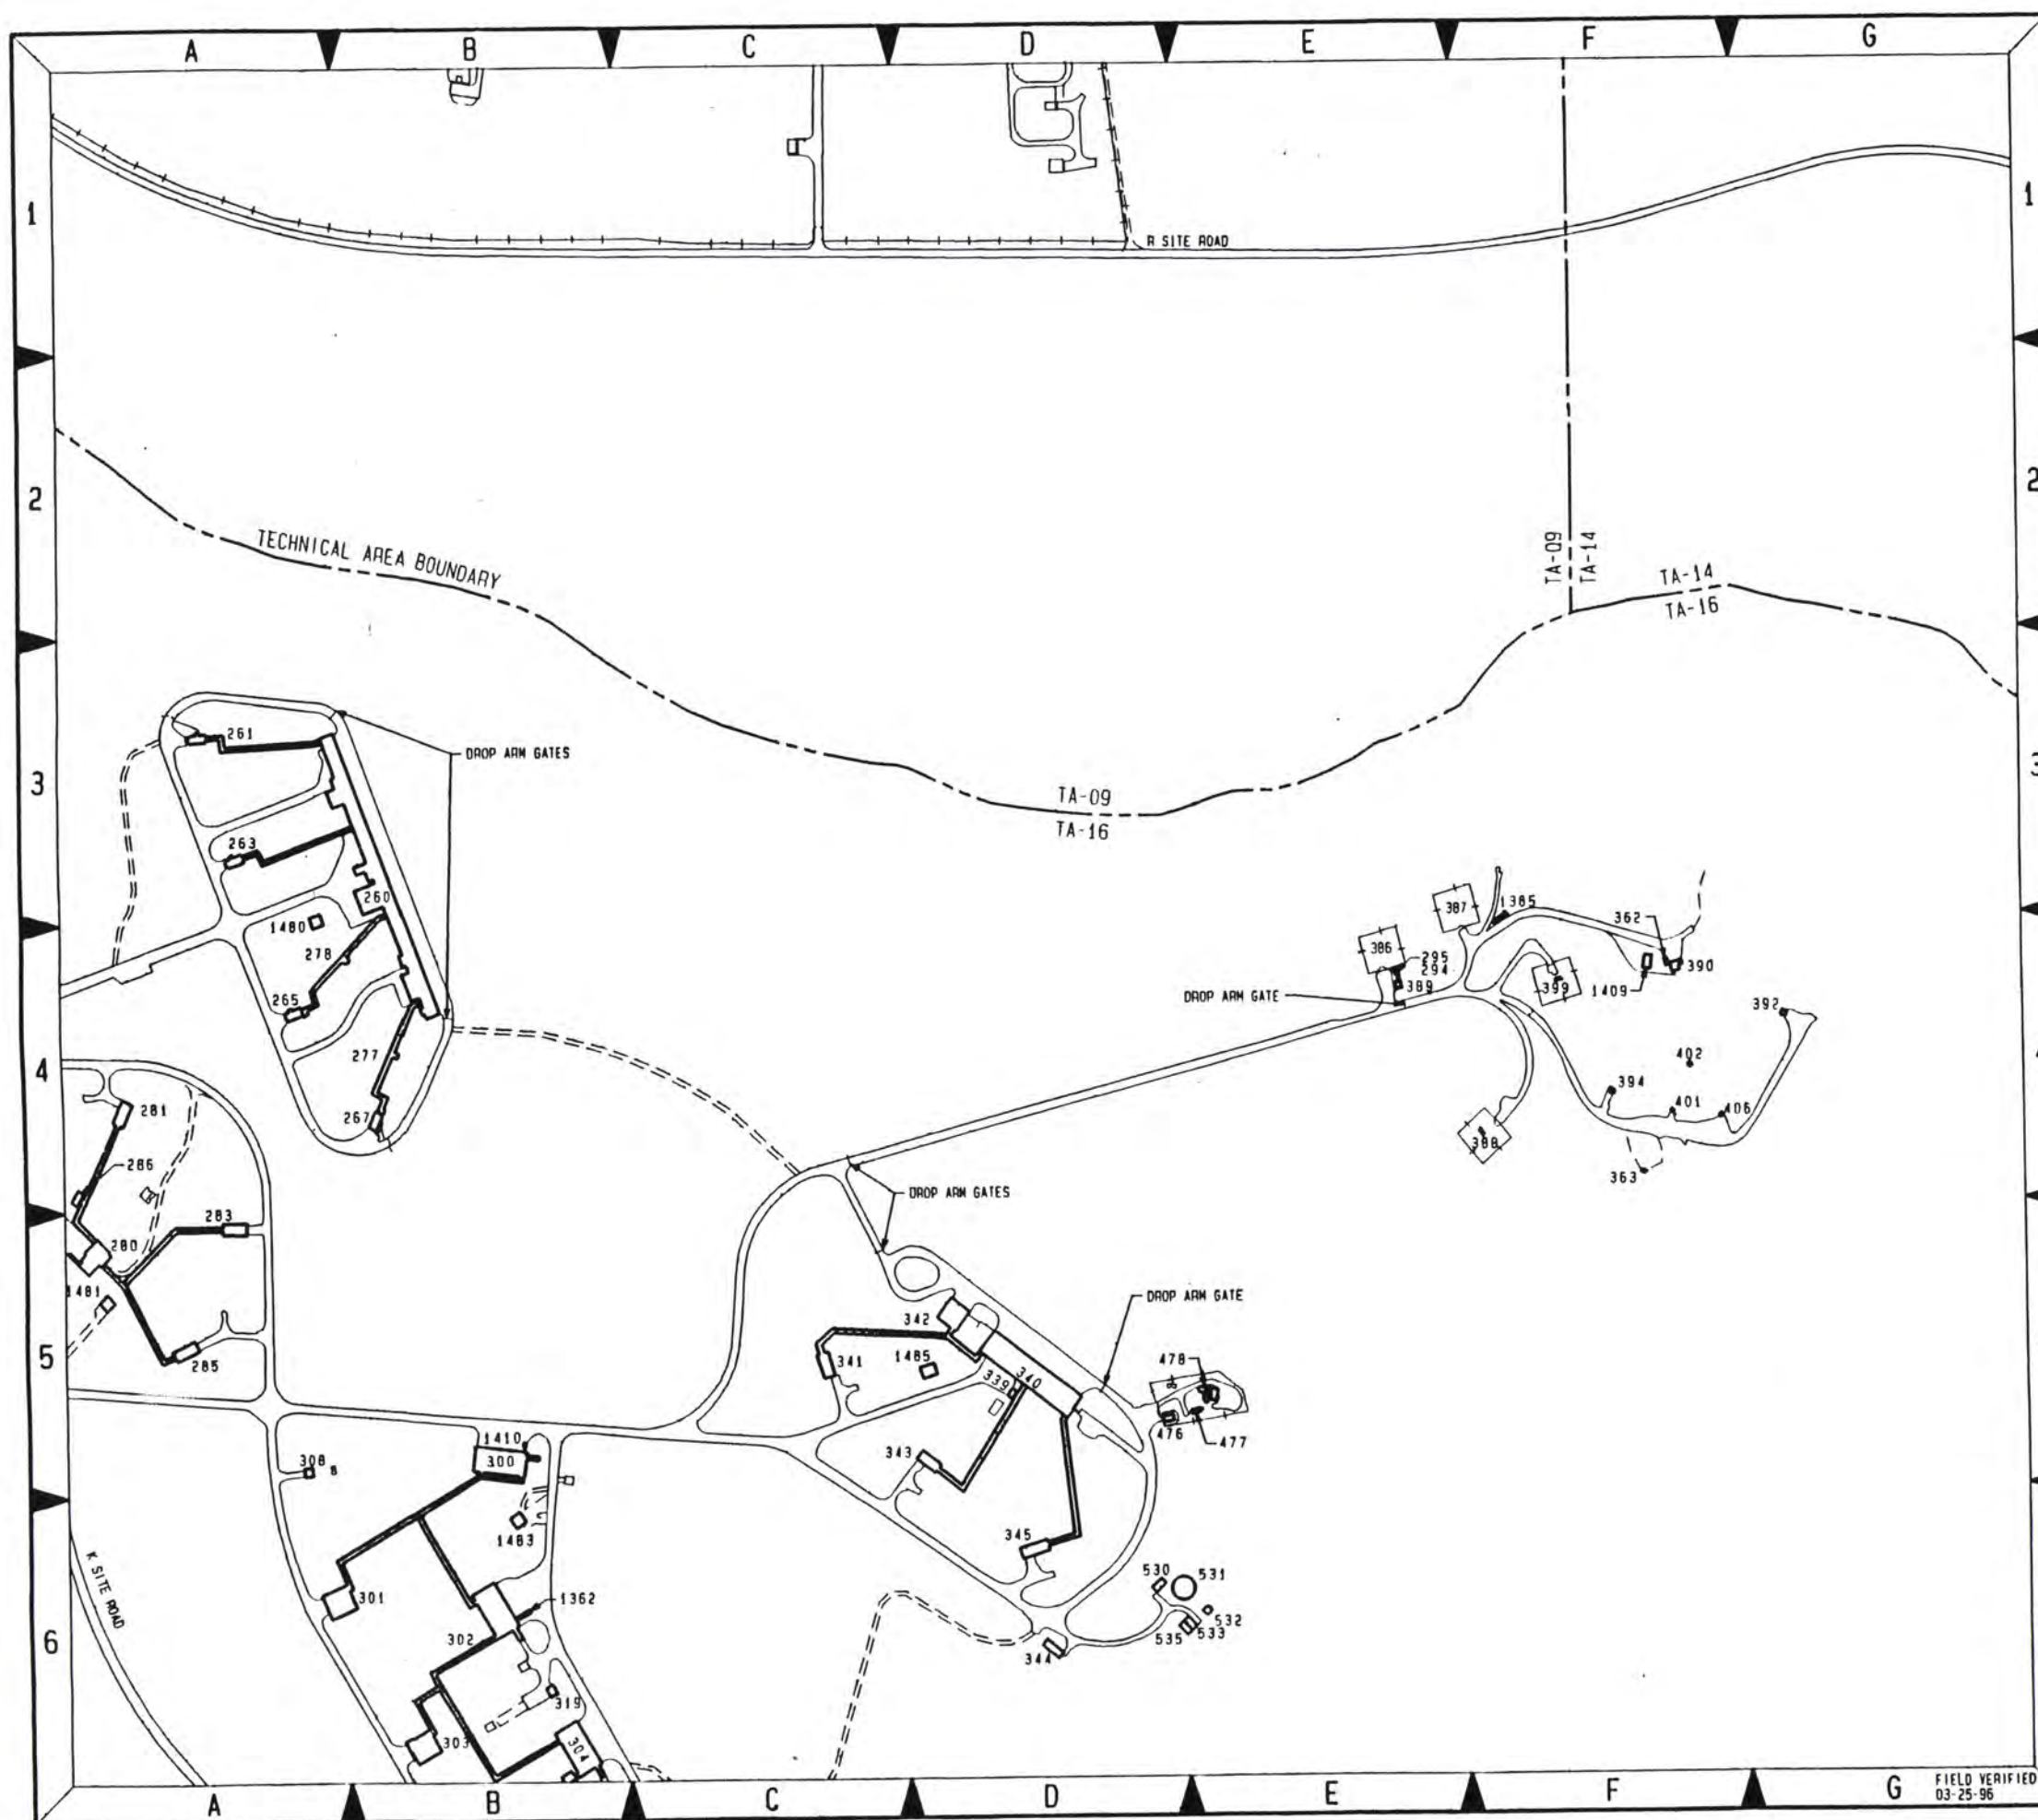

KEY MAP

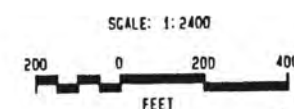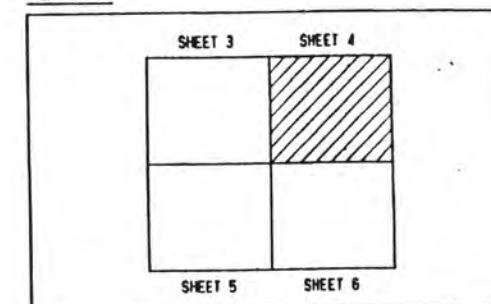


4	03-29-96	REVISED TO STATUS OF 03-25-96	JAC	JAC	JPM	JAF	FCT		
3	01-31-96	REVISED TO STATUS OF 01-26-96	JAC	JAC	JPM	JAF	FCT		
2	12-20-95	REVISED TO STATUS OF 12-19-95	JAC	JAC	JPM	JAF	FCT		
NO	DATE	CLASS REV	DESCRIPTION		DNN	VER	CHD	SUB	APP


		JOHNSON CONTROLS	
		AS-BUILT STRUCTURE LOCATION MAPS	
TA-16		S-SITE	
SUBMITTED JERRY FORTE 4-2-96		APPROVED FOR RELEASE FRED THOMPSON 4-2-96	
Los Alamos		Los Alamos National Laboratory Los Alamos, New Mexico 87545	
CLASSIFICATION PROJECT ID	REVIEWER H. SALAZAR	DATE 4/1/96	REV 4
11952	AB21	4	

JCI NO 91-020


FIELD VERIFIED
03-25-96

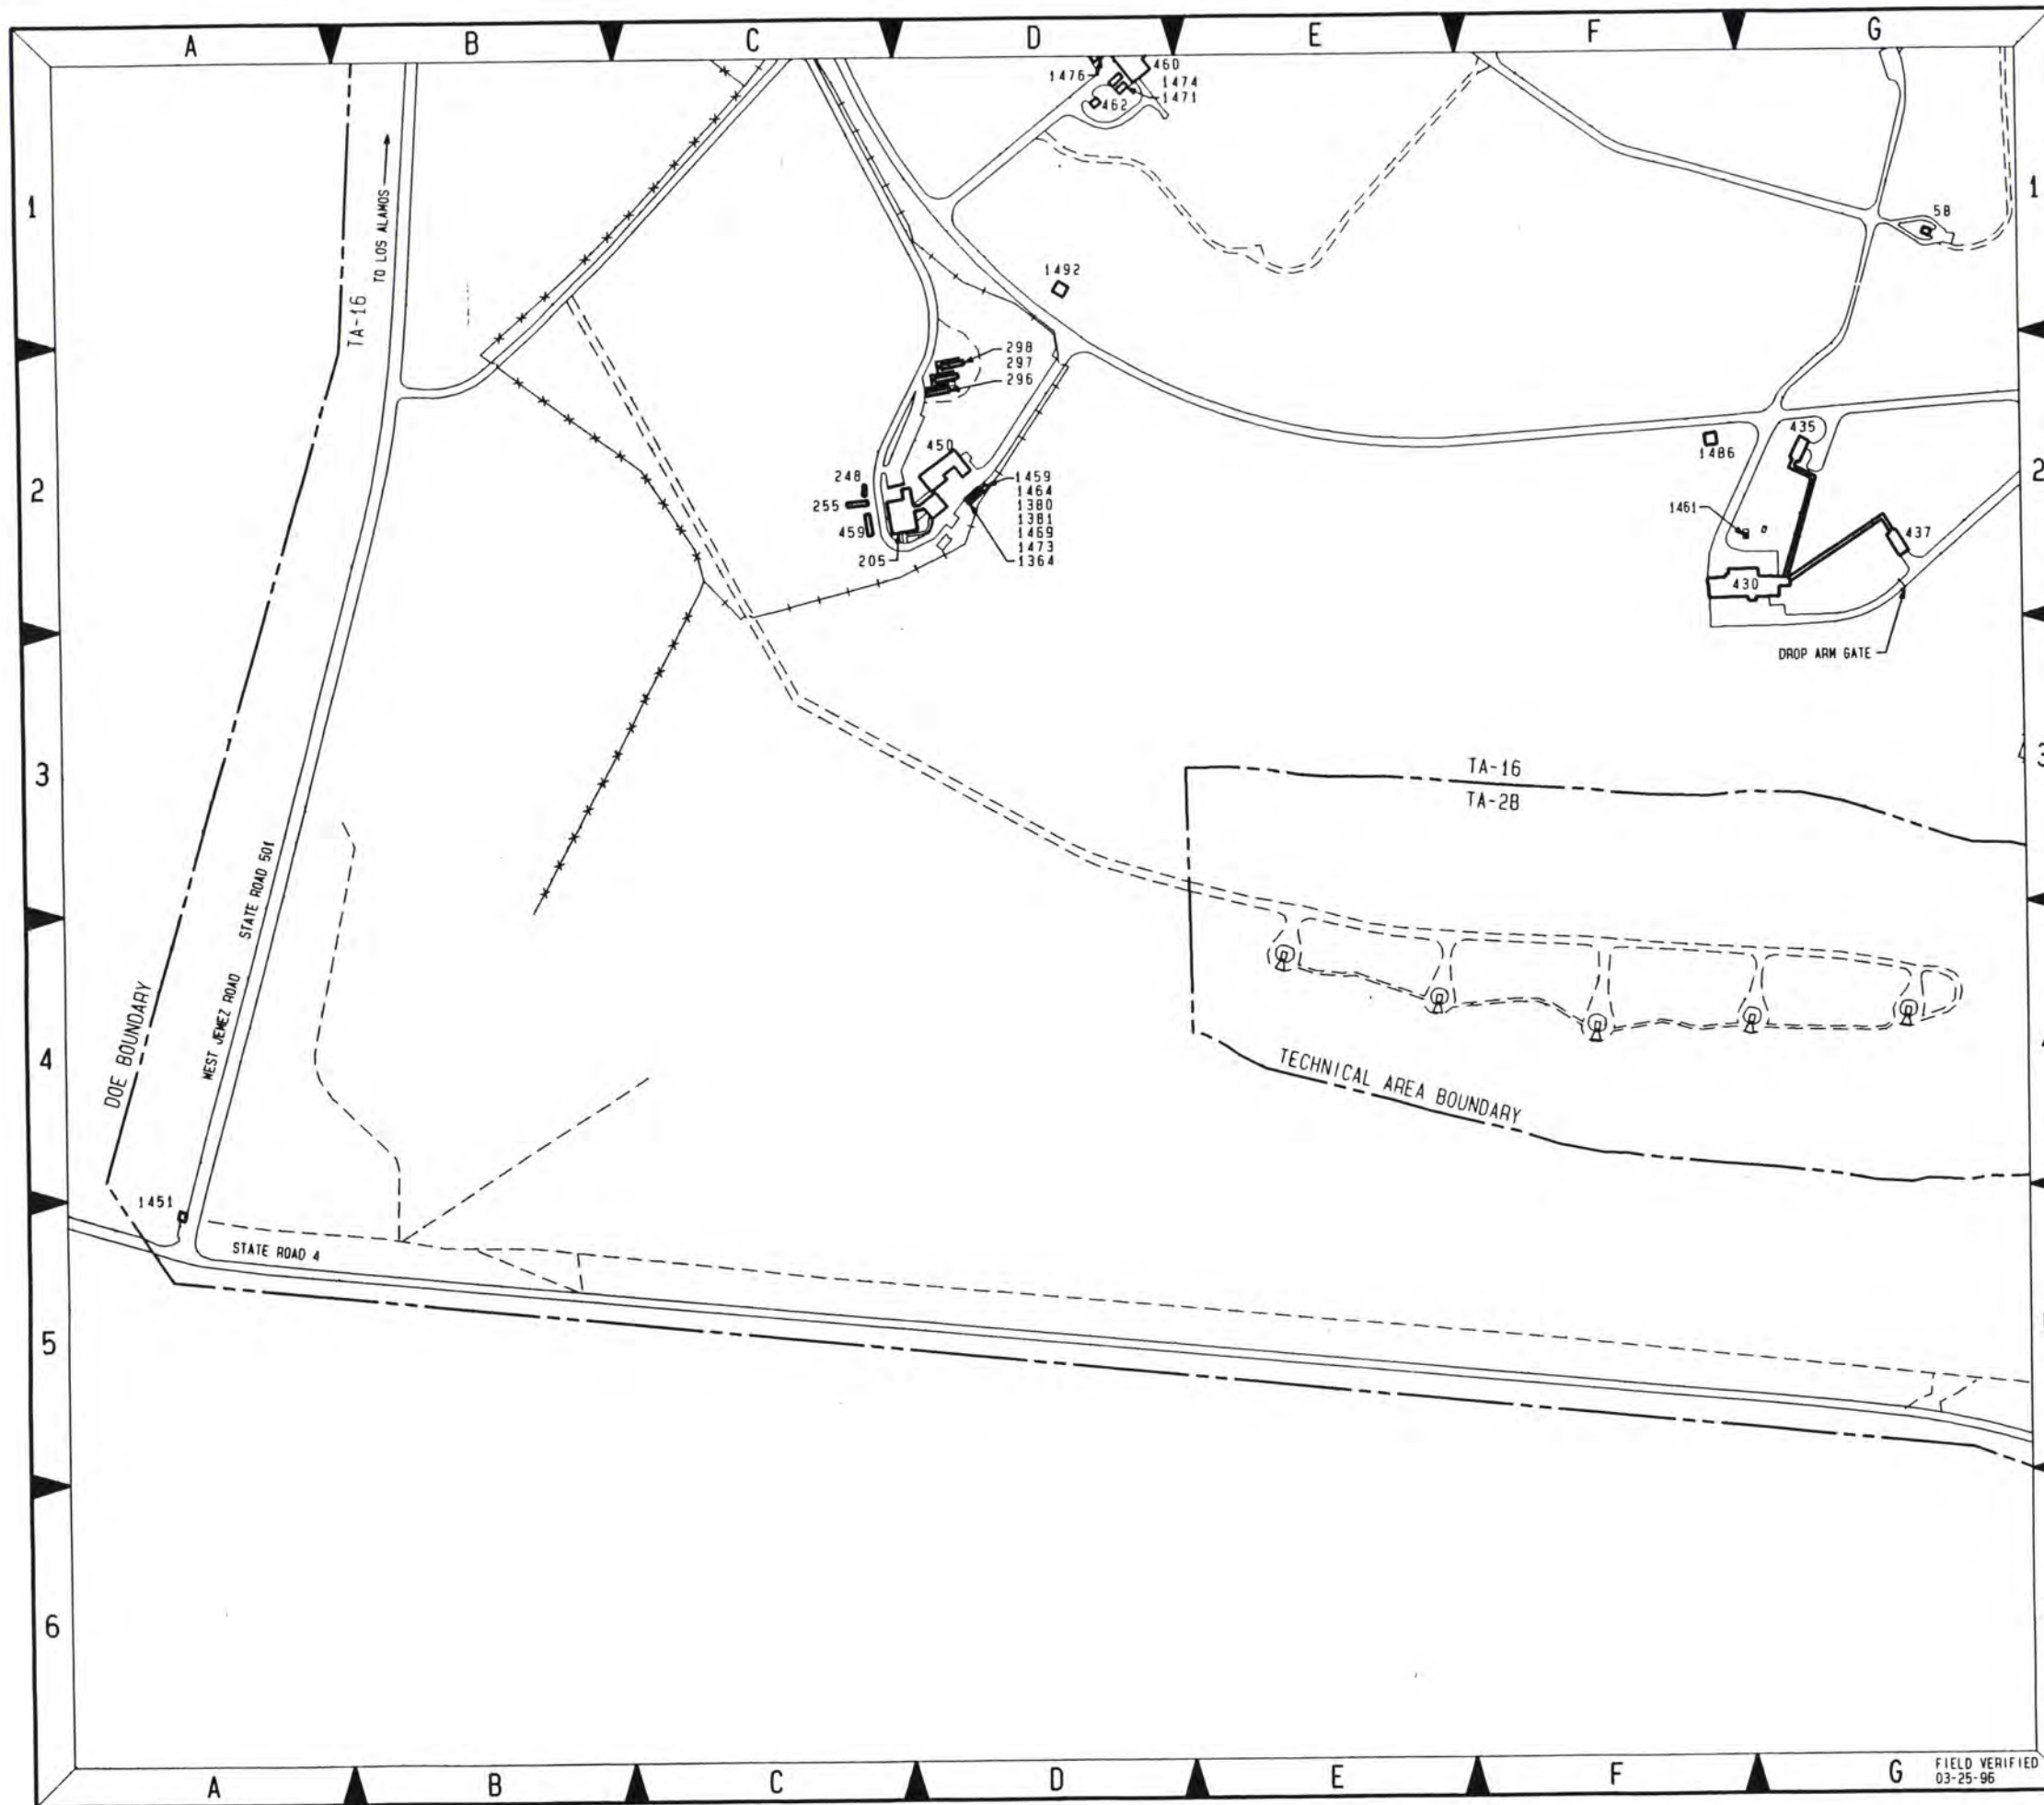

KEY MAP

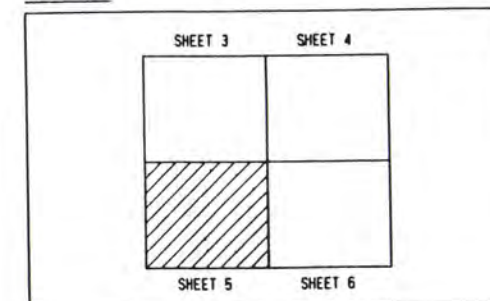

SCALE: 1:2400


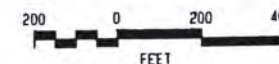


6	03-29-96		REVISED TO STATUS OF 03-25-96	JAC	JAC	JPM	JAF	FCT
5	01-31-96		REVISED TO STATUS OF 01-26-96	JPM	JPM	HMS	JAF	FCT
4	12-20-95		REVISED TO STATUS OF 12-19-95	JPM	JPM	HMS	JAF	FCT
NO	DATE	CLASS	DESCRIPTION	OWN	VER	CHD	SUB	APP

JOHNSON CONTROLS			
AS-BUILT STRUCTURE LOCATION MAPS			
TA-16			
S-SITE			
DATE	08-04-93	CHECKED	H. SALAZAR
VERIFIED	J. WILSON	DRAWN	J. WILSON

SUBMITTED	JERRY FORTE	APPROVED FOR RELEASE	FRED THOMPSON
Los Alamos		Los Alamos National Laboratory Los Alamos, New Mexico 87545	
CLASSIFICATION	U	REVIEWER	N. SALAZAR
PROJECT ID	11952	DRAWING NO.	AB21
DATE		4/4/96	REV
SHEET		5	6
JCI NO 91-020			

FIELD VERIFIED
03-25-96

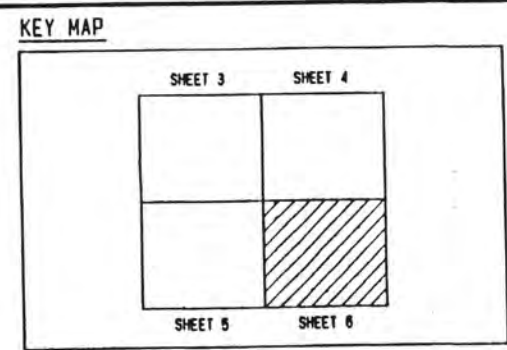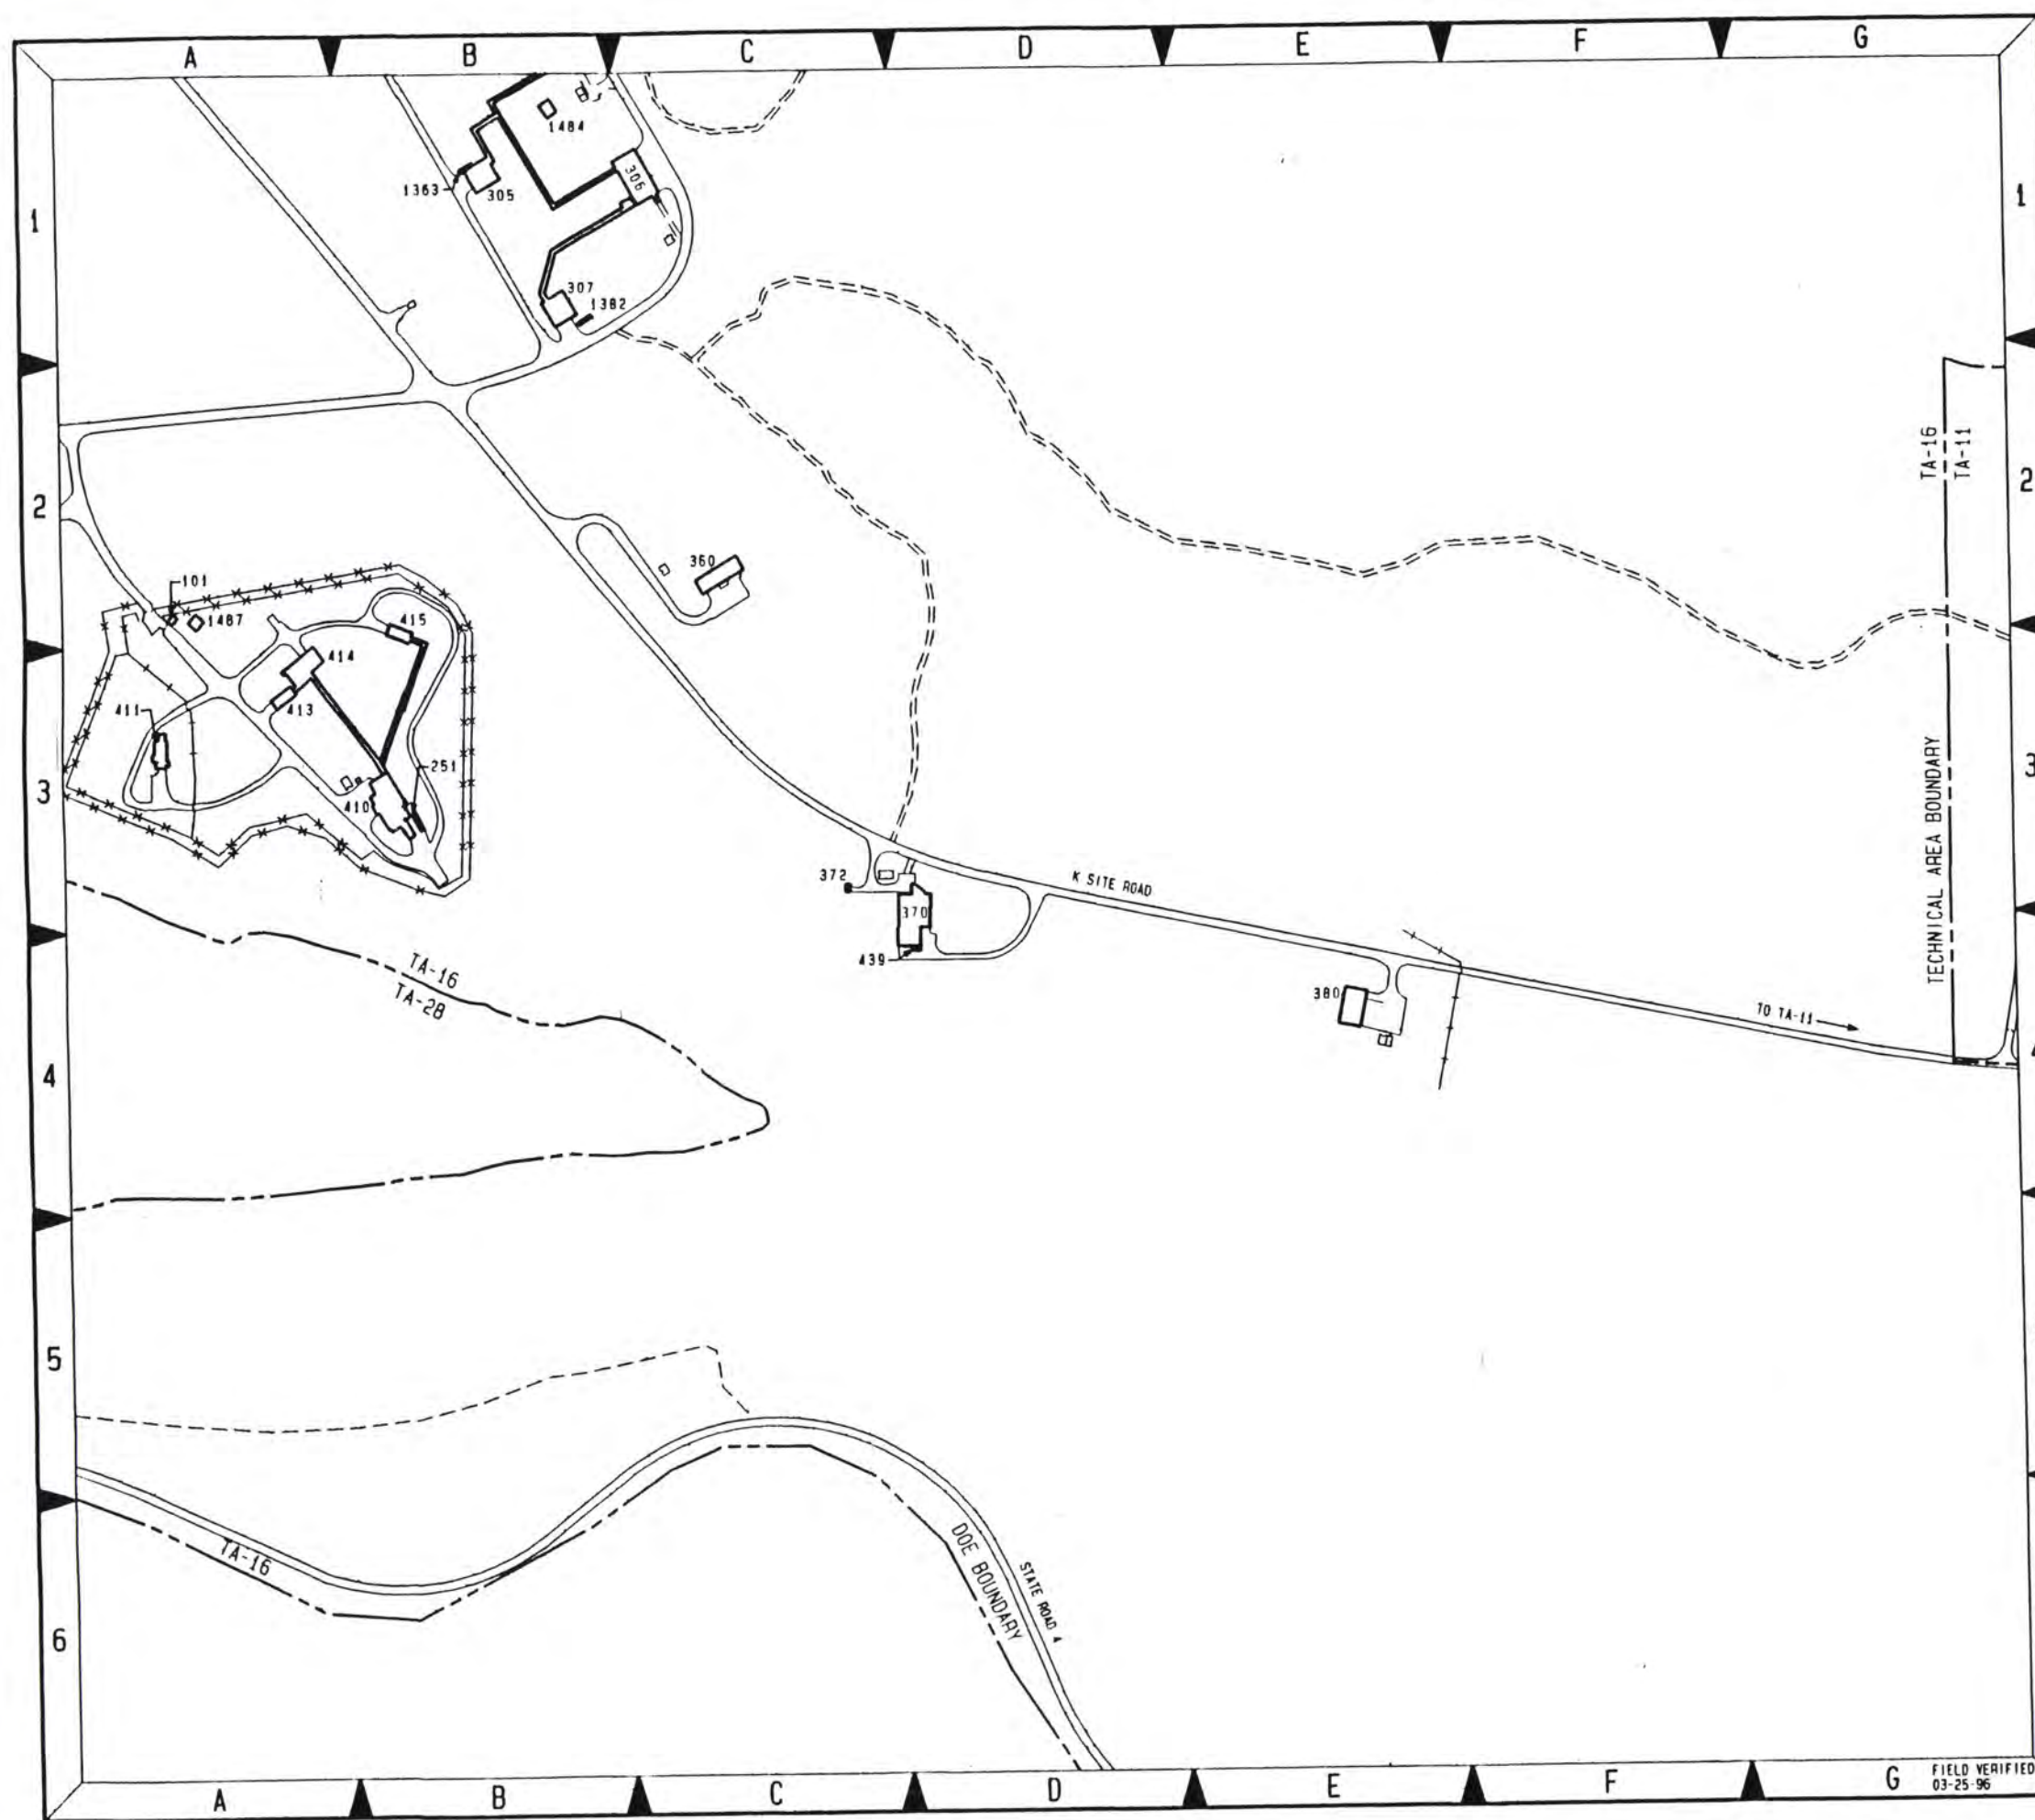

SCALE: 1"=2400

200 0 200 400
FEET

NO	DATE	CLASS	REV	DESCRIPTION	DWN	VER	CHKD	SUN	APP
3	03-29-96			REVISED TO STATUS OF 03-25-96	JAC	JAC	JPM	JAF	FCT
2	01-31-96			REVISED TO STATUS OF 01-26-96	JAC	JAC	JPM	JAF	FCT
1	05-16-94			REVISED PER NEW STANDARDS AND TO STATUS OF 05-05-94	JPM	JPM	HMS	JAF	FCT

JOHNSON CONTROLS

AS-BUILT STRUCTURE LOCATION MAPS

TA-16

S-SITE

NO	DATE	CLASS	REV	DESCRIPTION	DWN	VER	CHKD	SUN	APP
3	03-29-96			REVISED TO STATUS OF 03-25-96	JAC	JAC	JPM	JAF	FCT
2	01-31-96			REVISED TO STATUS OF 01-26-96	JAC	JAC	JPM	JAF	FCT
1	05-16-94			REVISED PER NEW STANDARDS AND TO STATUS OF 05-05-94	JPM	JPM	HMS	JAF	FCT

SUBMITTED FOR RELEASE: JERRY FORTE, 03-29-96, 4-L-TU

APPROVED FOR RELEASE: FRED THOMPSON, 03-29-96, 4-L-TU

Los Alamos Los Alamos National Laboratory
Los Alamos, New Mexico 87545

CLASSIFICATION: U REVIEWER: M. SALAZAR DATE: 4/4/96





PROJECT ID: 11952 DRAWING NO: AB21

SHEET 6 OF 6

3

FIELD VERIFIED 03-25-96

JCI NO 91-020

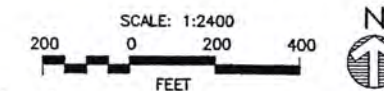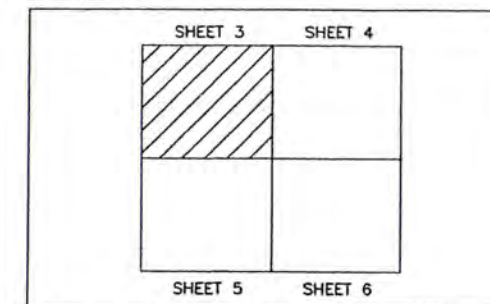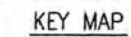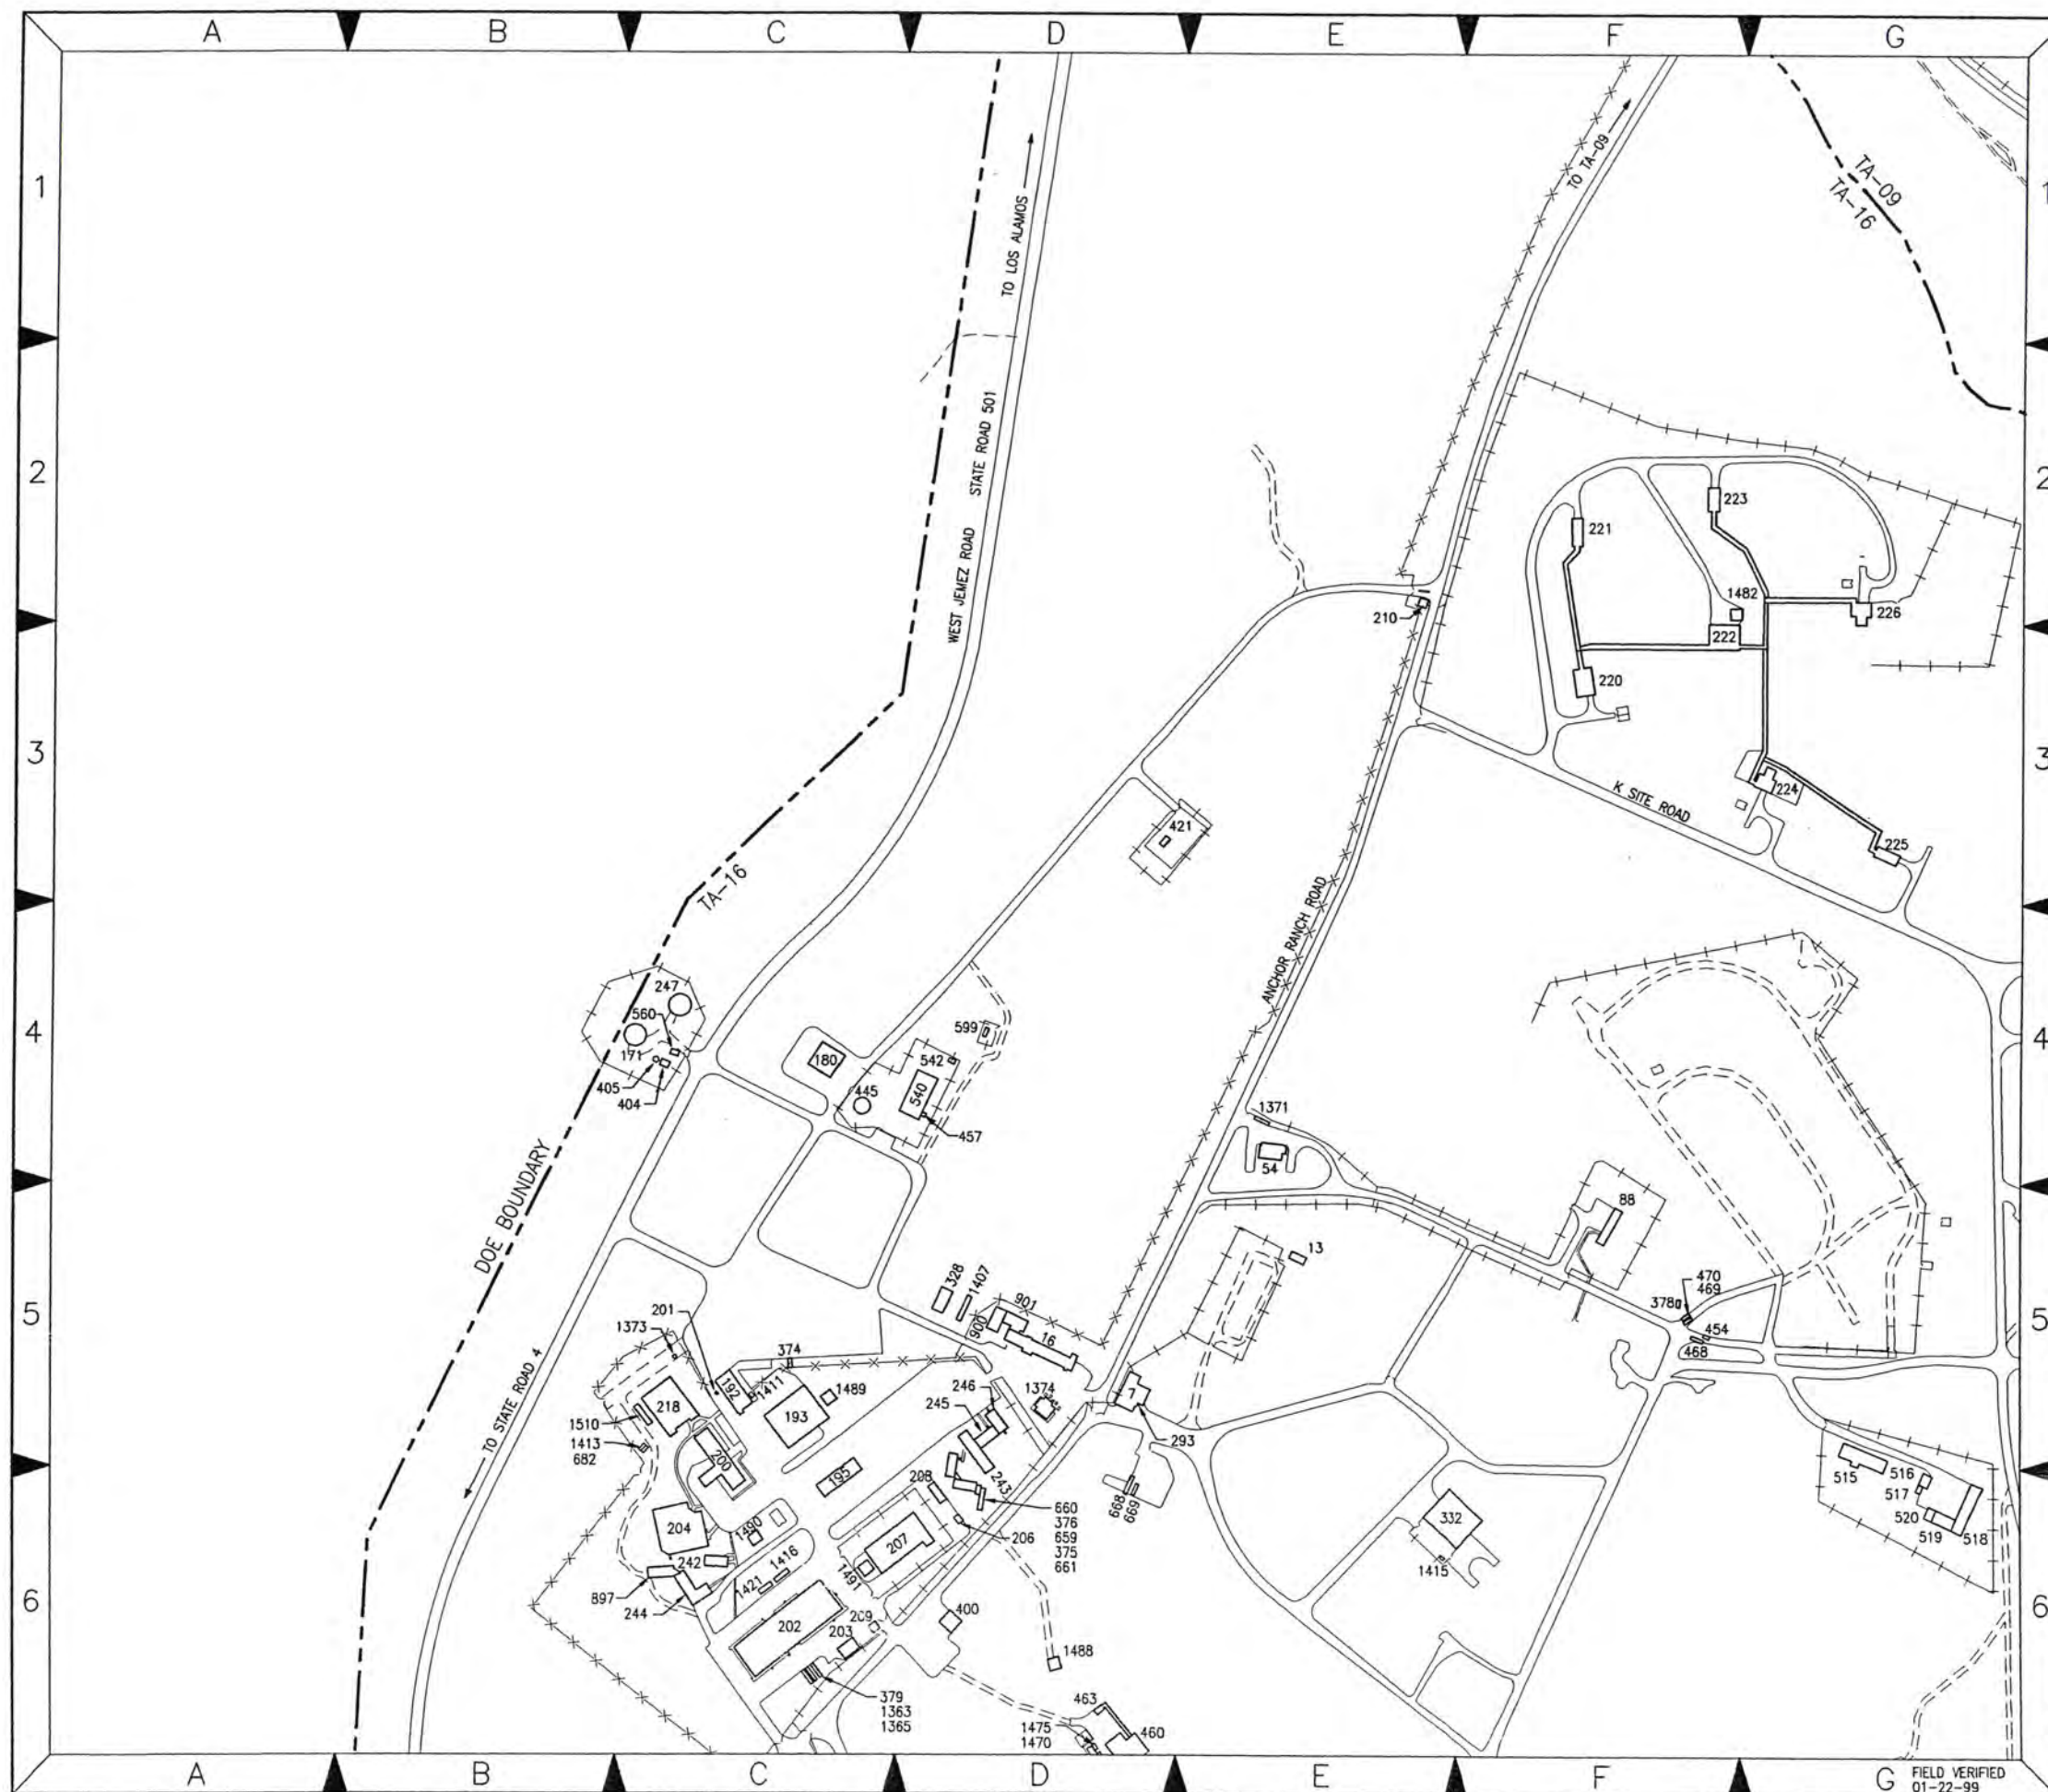

11	03-01-99		REVISED TO STATUS OF 03-01-99	SAD	MSY	HMS	HMS	U
10	02-10-97	U	REVISED TO STATUS OF 02-10-97	CJR	CJR	HMS	JAF	U
9	07-31-96	U	REVISED TO STATUS OF 07-31-96	JAC	JAC	JAF	JAF	U
8	05-31-96	U	REVISED TO STATUS OF 05-31-96	JFM	JFM	HMS	JAF	U
NO	DATE	CLASS REV	DESCRIPTION	DWN	VER	CHKD	SUB	U

Johnson Controls
Northern New Mexico

AS-BUILT STRUCTURE LOCATION MAPS

TA-16

S-SITE

DRAWN	J. WORK
VERIFIED	J. WORK
CHECKED	H. SALAZAR
DATE	08-04-93

SUBMITTED HAROLD SALAZAR	APPROVED FOR RELEASE LARRY BAYS
-----------------------------	------------------------------------




Los Alamos Los Alamos National Laboratory
Los Alamos, New Mexico 87545

SHEET	3
3	OF

CLASSIFICATION	U	REVIEWER	HAROLD SALAZAR	DATE	4-23-94
----------------	---	----------	----------------	------	---------

PROJECT ID	11052	DRAWING NO	AB31	REV	1
------------	-------	------------	------	-----	---

JCI NO 97-002	11952	AB21	1
---------------	-------	------	---

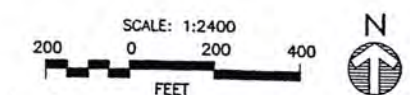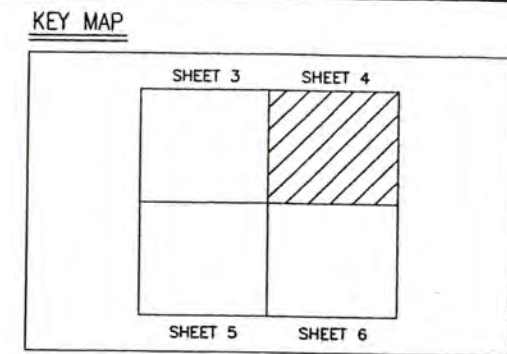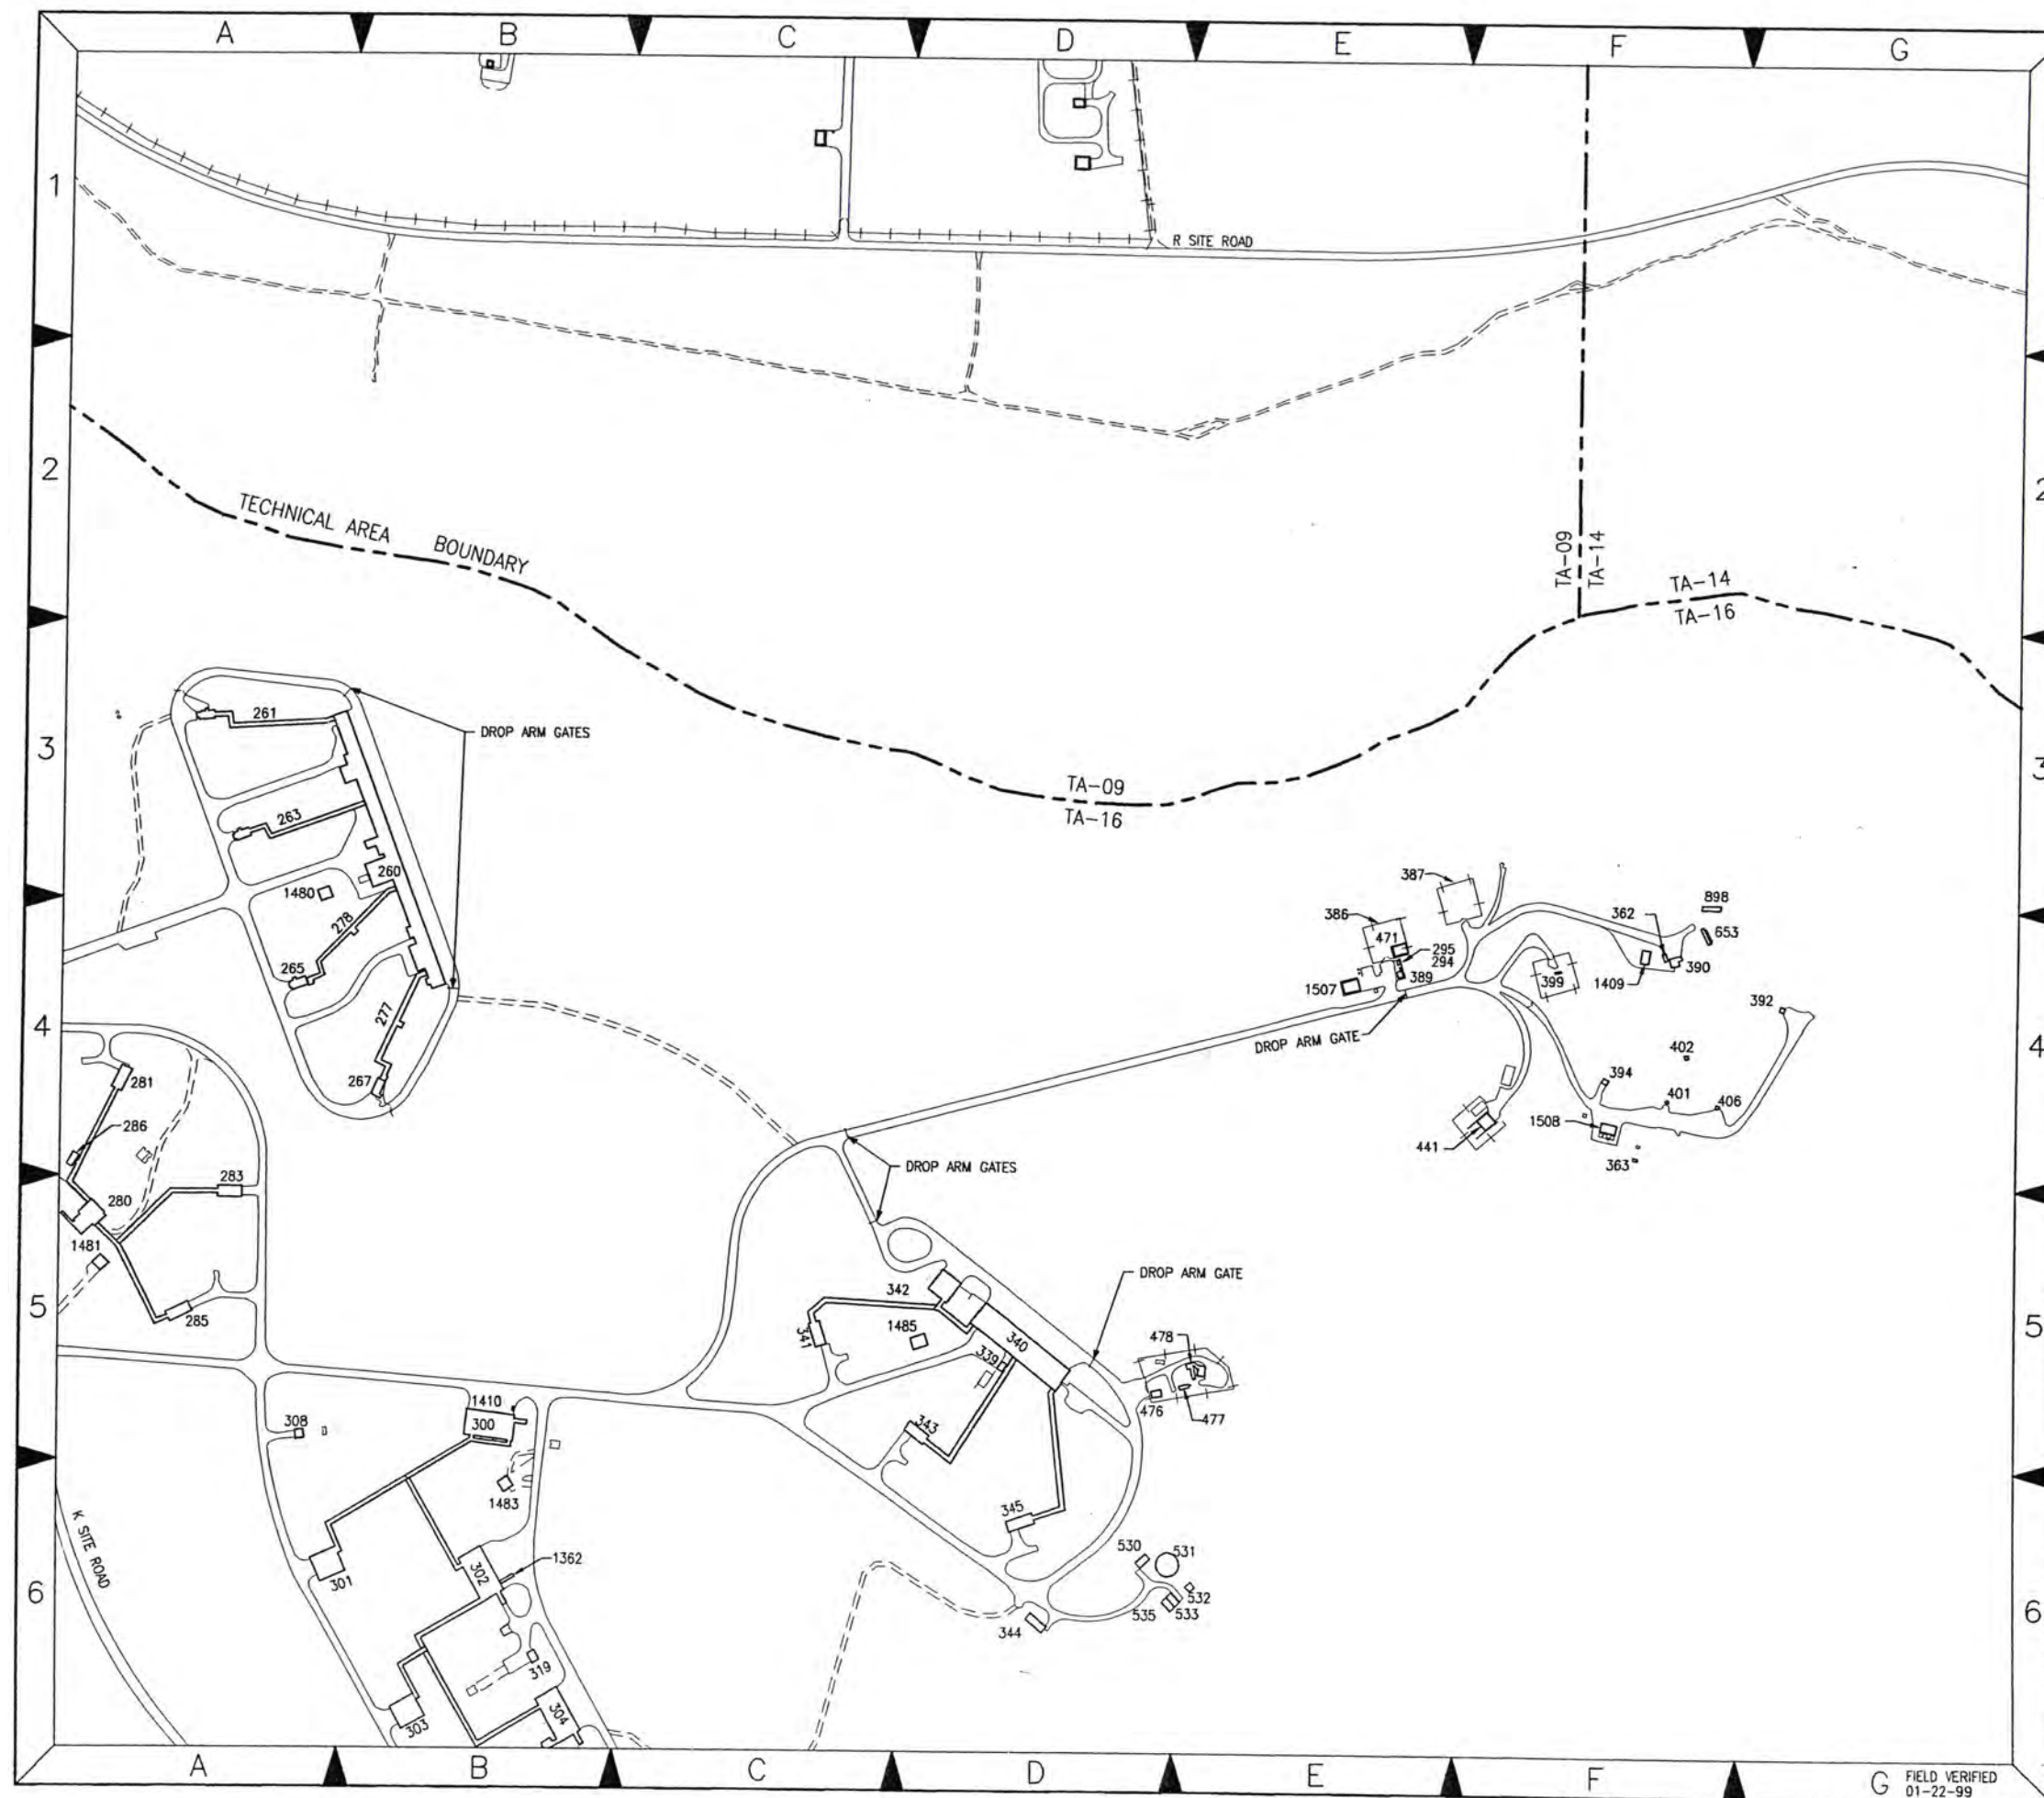


6	03-01-99		REVISED TO STATUS OF 03-01-99	SAD	MSV	HMS	HMS	LAB
5	07-31-96	U	REVISED TO STATUS OF 07-31-96	JAC	JAC	JPM	JAF	LAB
4	03-29-96	U	REVISED TO STATUS OF 03-25-96	JAC	JAC	JPM	JAF	FCT
3	01-31-96	U	REVISED TO STATUS OF 01-31-96	JPM	JPM	JPM	JAF	FCT
NO	DATE	CLASS	DESCRIPTION	OWN	VER	CHKD	SUB	APP

Johnson Controls
Northern New Mexico



AS-BUILT STRUCTURE LOCATION MAPS				DRAWN	J. MORK
TA-16				VERIFIED	J. MORK
S-SITE				CHECKED	H. SALAZAR
				DATE	08-04-93

SUBMITTED HAROLD SALAZAR		APPROVED FOR RELEASE LARRY BAYS	
Los Alamos		Los Alamos National Laboratory Los Alamos, New Mexico 87545	
CLASSIFICATION	1A	REVIEWER	HAROLD SALAZAR
PROJECT ID	11952	DRAWING NO	AB21
SHEET 4 OF 6		DATE	4-23-99
JOI NO 97-002		REV	6

FIELD VERIFIED
01-22-99

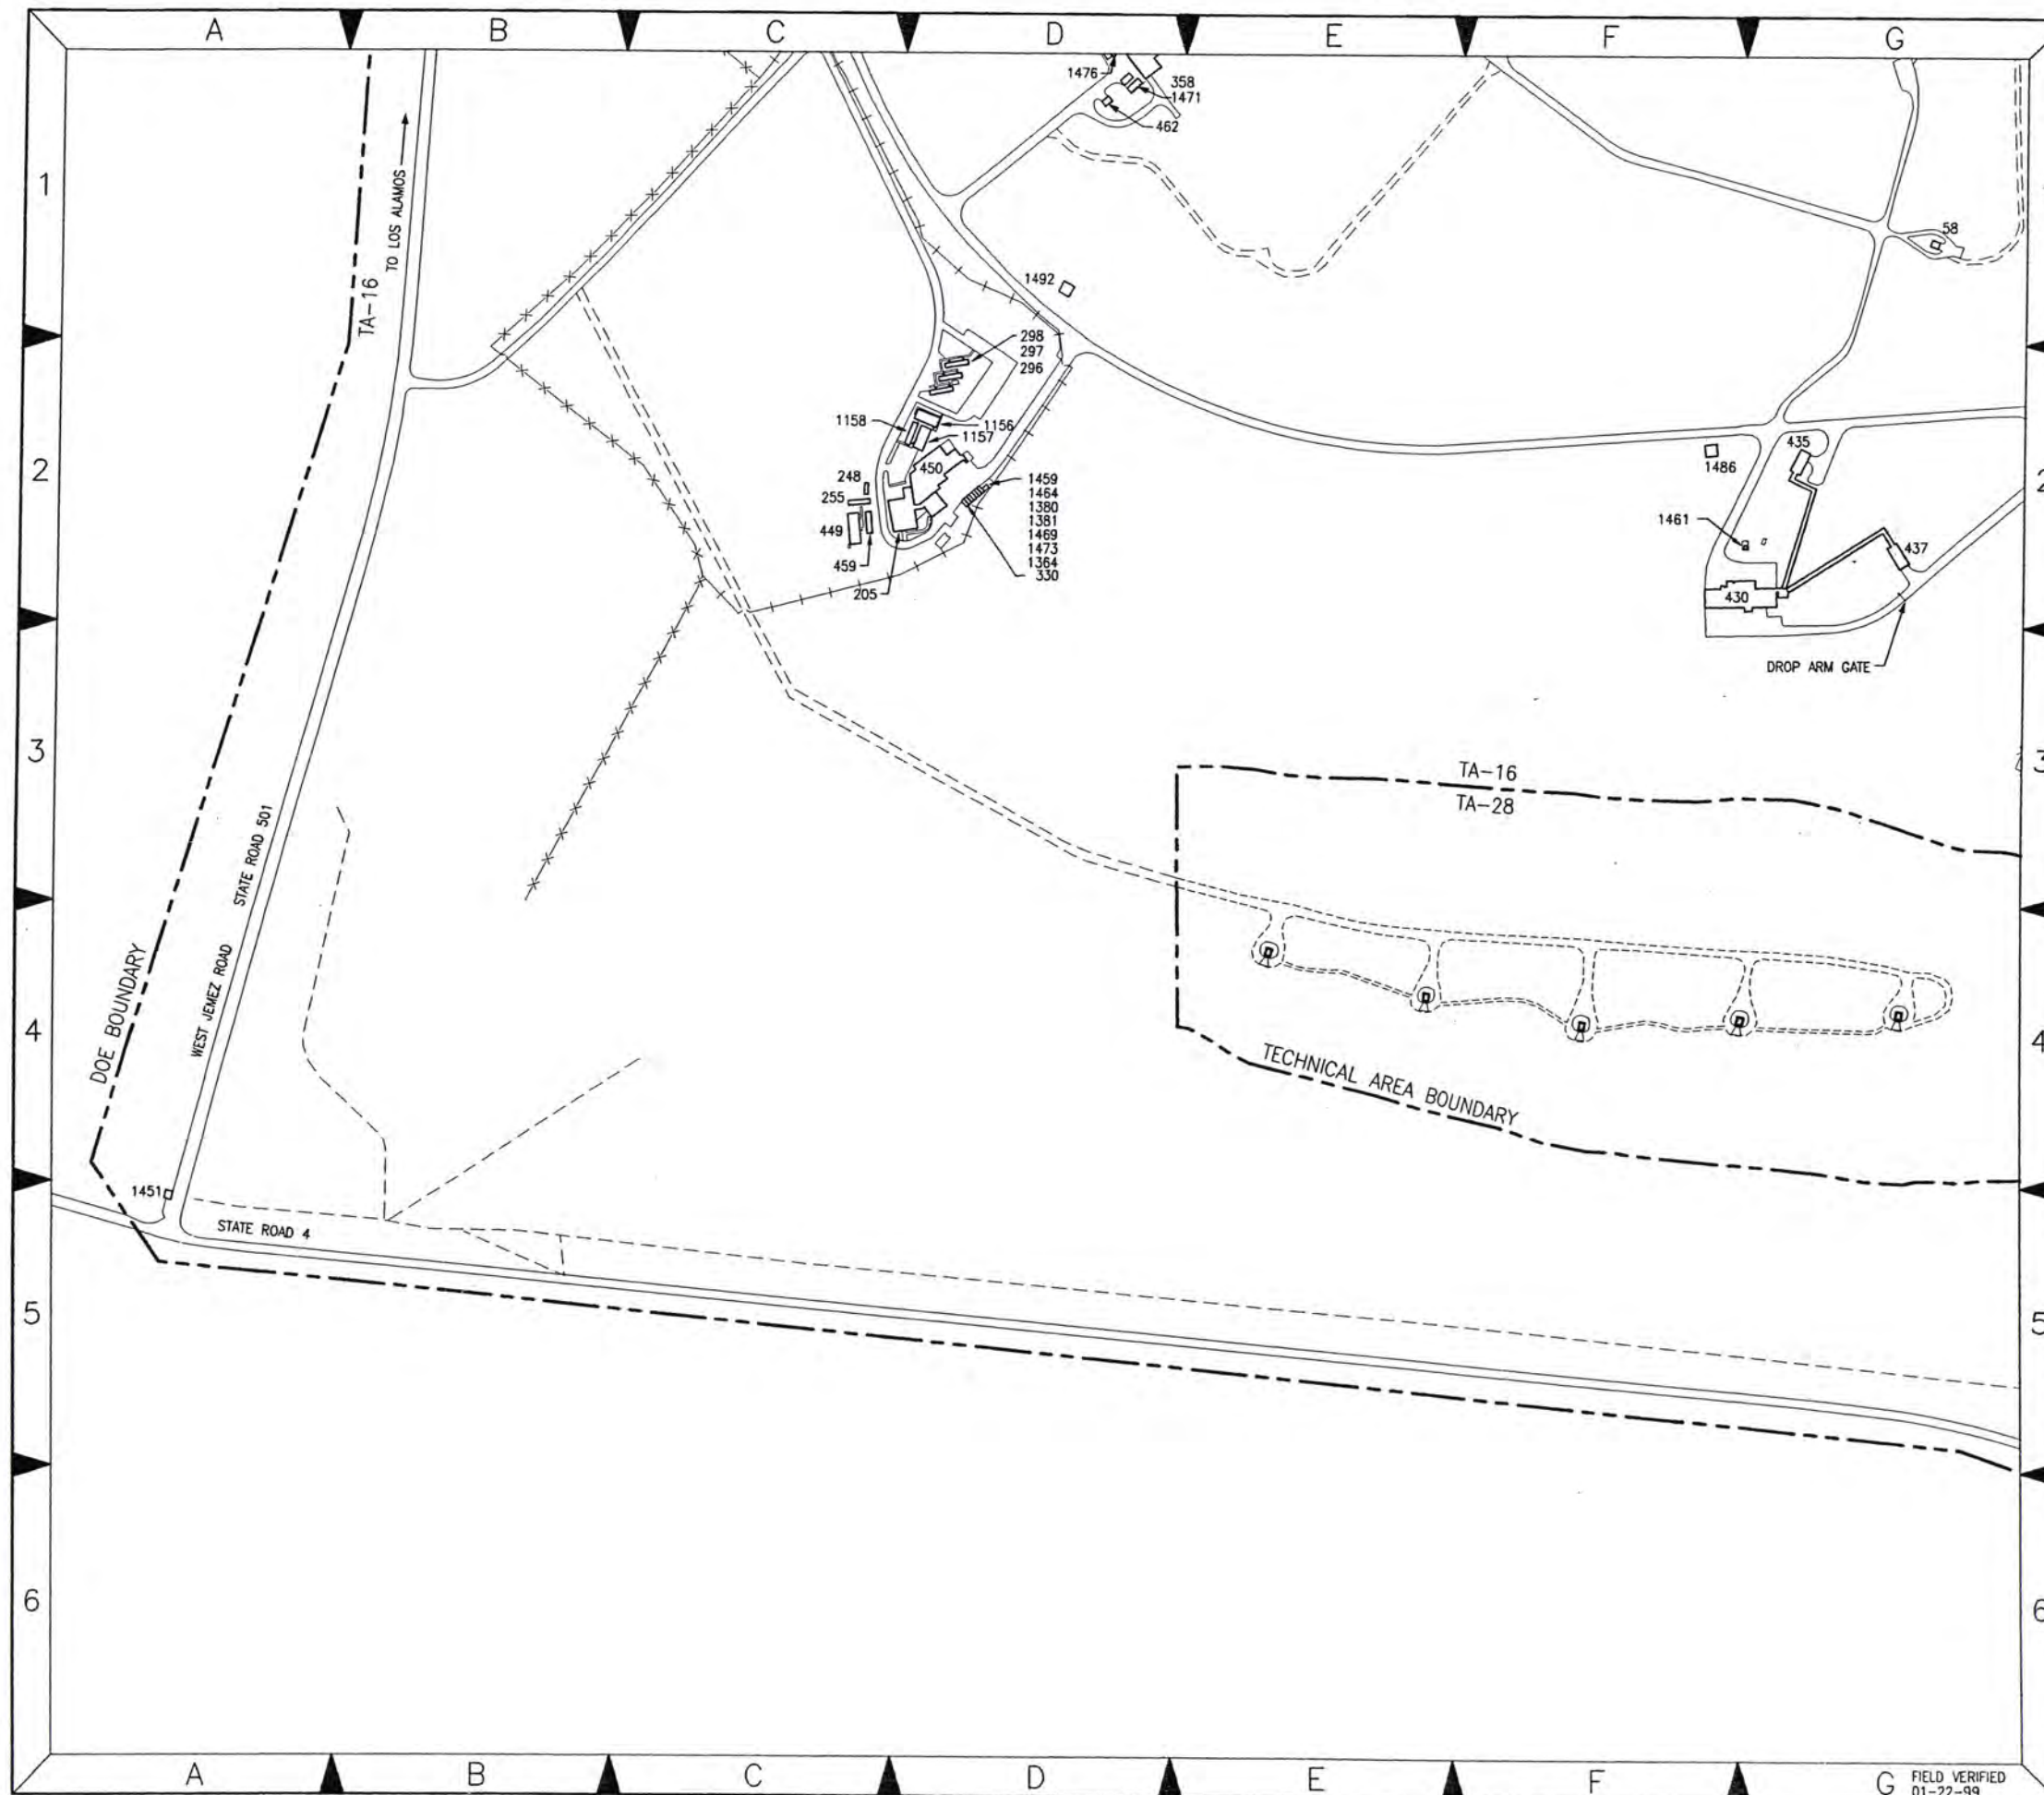

KEY MAP

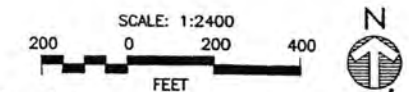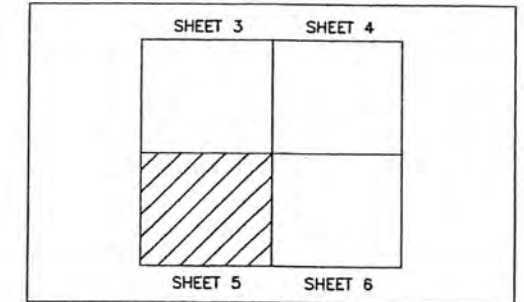

8	03-01-99		REVISED TO STATUS OF 03-01-99	SW	BSW	HMS	HMS	LAB
7	02-10-97	U	REVISED TO STATUS OF 02-10-97	CJR	CJR	HMS	JAF	LAB
6	03-29-96	U	REVISED TO STATUS OF 03-29-96	JAC	JAC	JAF	JAF	FCT
5	01-31-96	U	REVISED TO STATUS OF 01-31-96	JPM	JPM	HMS	JAF	FCT
NO	DATE	CLASS	DESCRIPTION	OWN	VER	CHKD	SUB	APP

Johnson Controls
Northern New Mexico

AS-BUILT STRUCTURE LOCATION MAPS

TA-16

S-SITE

DRAWN	J. WORK
VERIFIED	J. WORK
CHECKED	H. SALAZAR
DATE	08-04-93

SUBMITTED HAROLD SALAZAR	APPROVED FOR RELEASE LARRY BAYS
-----------------------------	------------------------------------


Los Alamos Los Alamos National Laboratory
Los Alamos, New Mexico 87545

CLASSIFICATION U REVIEWER HAROLD SALAZAR H-307 DATE 9-23-99 SHEET 5 OF 6



PROJECT ID 11952 DRAWING NO AB21 REV 8

ICJ NO 97-002

FIELD VERIFIED
01-22-99

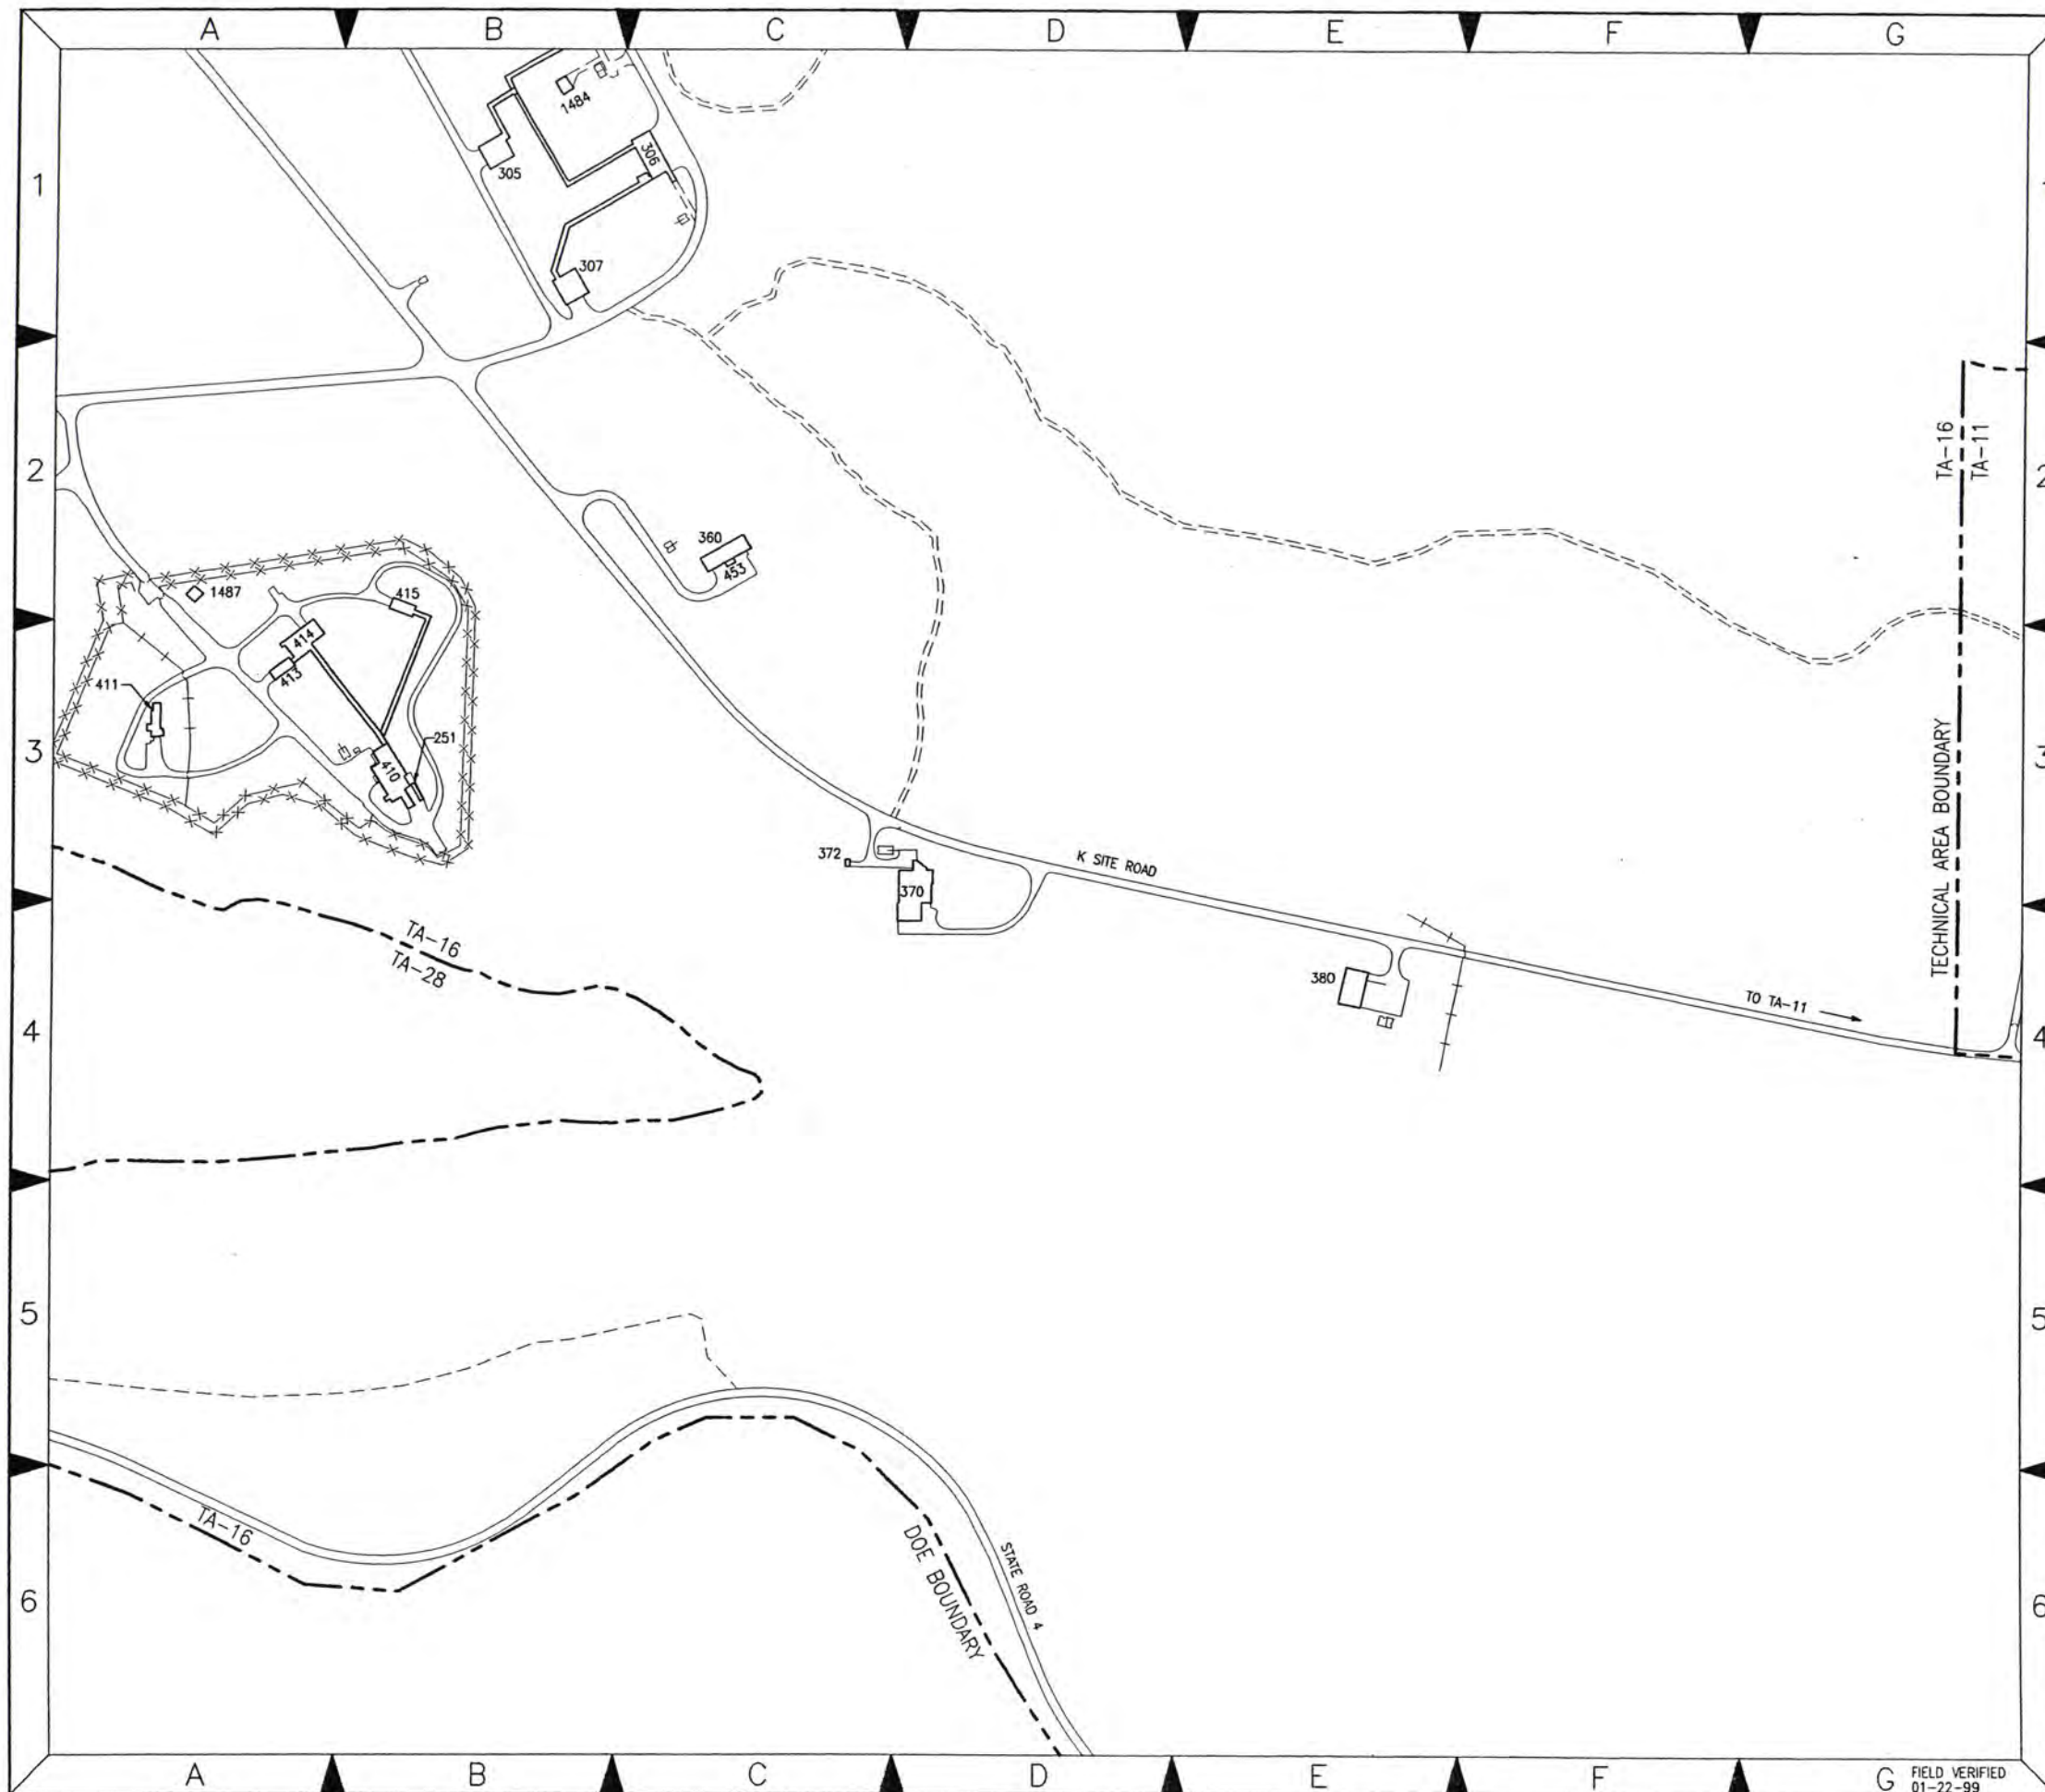

KEY MAP

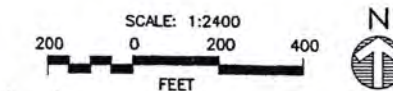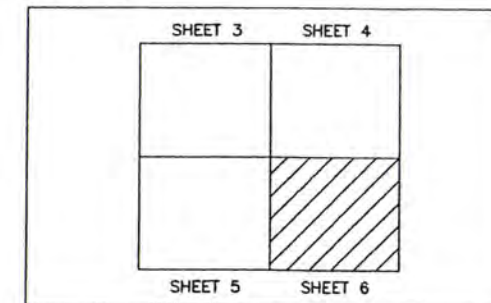

5	03-01-99		REVISED TO STATUS OF 03-01-99	SJD	MSV	HMS	HMS	LAB
4	05-31-96	U	REVISED TO STATUS OF 05-31-96	JAC	JAC	JPM	JAF	LAB
3	03-29-96	U	REVISED TO STATUS OF 03-25-96	JAC	JAC	JPM	JAF	FCT
2	01-31-96	U	REVISED TO STATUS OF 01-31-96	JPM	JPM	JPM	JAF	FCT
NO	DATE	CLASS REV	DESCRIPTION	DWN	VER	CHKD	SUB	APP

Johnson Controls
Northern New Mexico

AS-BUILT STRUCTURE LOCATION MAPS

TA-16

S-SITE

DRAWN	J. MORK
VERIFIED	J. MORK
CHECKED	H. SALAZAR
DATE	08-04-93

SUBMITTED
HAROLD SALAZAR

APPROVED FOR RELEASE
LARRY BAYS

Los Alamos

Los Alamos National Laboratory
Los Alamos, New Mexico 87545

SHEET
6
OF
6

CLASSIFICATION U REVIEWER HAROLD SALAZAR HSJ DATE 7-23-97



PROJECT ID 11952 DRAWING NO AB21 REV 5

JCI NO 97-002

FIELD VERIFIED
01-22-99



KEY MAP

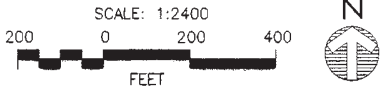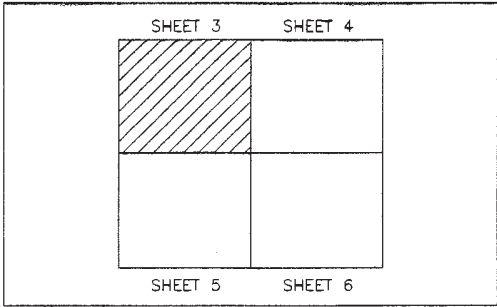


18	07-09-04	U	REVISED TO STATUS OF 07-09-04	EIM	HPR	RAG	HMS	LAB
17	10-22-03	HMS	REVISED TO STATUS OF 10-22-03	EIM	HPR	MEG	HMS	LAB
16	03-24-03		REVISED TO STATUS OF 03-24-03	EIM	HPR	MEG	HMS	LAB
15	11-25-02		REVISED TO STATUS OF 11-25-02	HPR	MEG	MEG	HMS	LAB
NO	DATE	CLASS	DESCRIPTION	DWN	DES	CHKD	SUB	APP




AS-BUILT STRUCTURE LOCATION MAPS		DRAWN	J. WORK
S-SITE		DESIGN	J. WORK
TA-16		CHECKED	H. SALAZAR
		DATE	08-04-93

SUBMITTED		APPROVED FOR RELEASE BY	
HAROLD SALAZAR		LARRY BAYS	
SHEET		3	
3		OF 6	
Los Alamos NATIONAL LABORATORY		PO Box 1663 Los Alamos, New Mexico 87545	
CLASSIFICATION	U	REVIEWER	H. SALAZAR
PROJECT ID	11952	DRAWING NO	AB21
FIELD VERIFIED	07-09-04	DATE	08-04-93
REV	18		

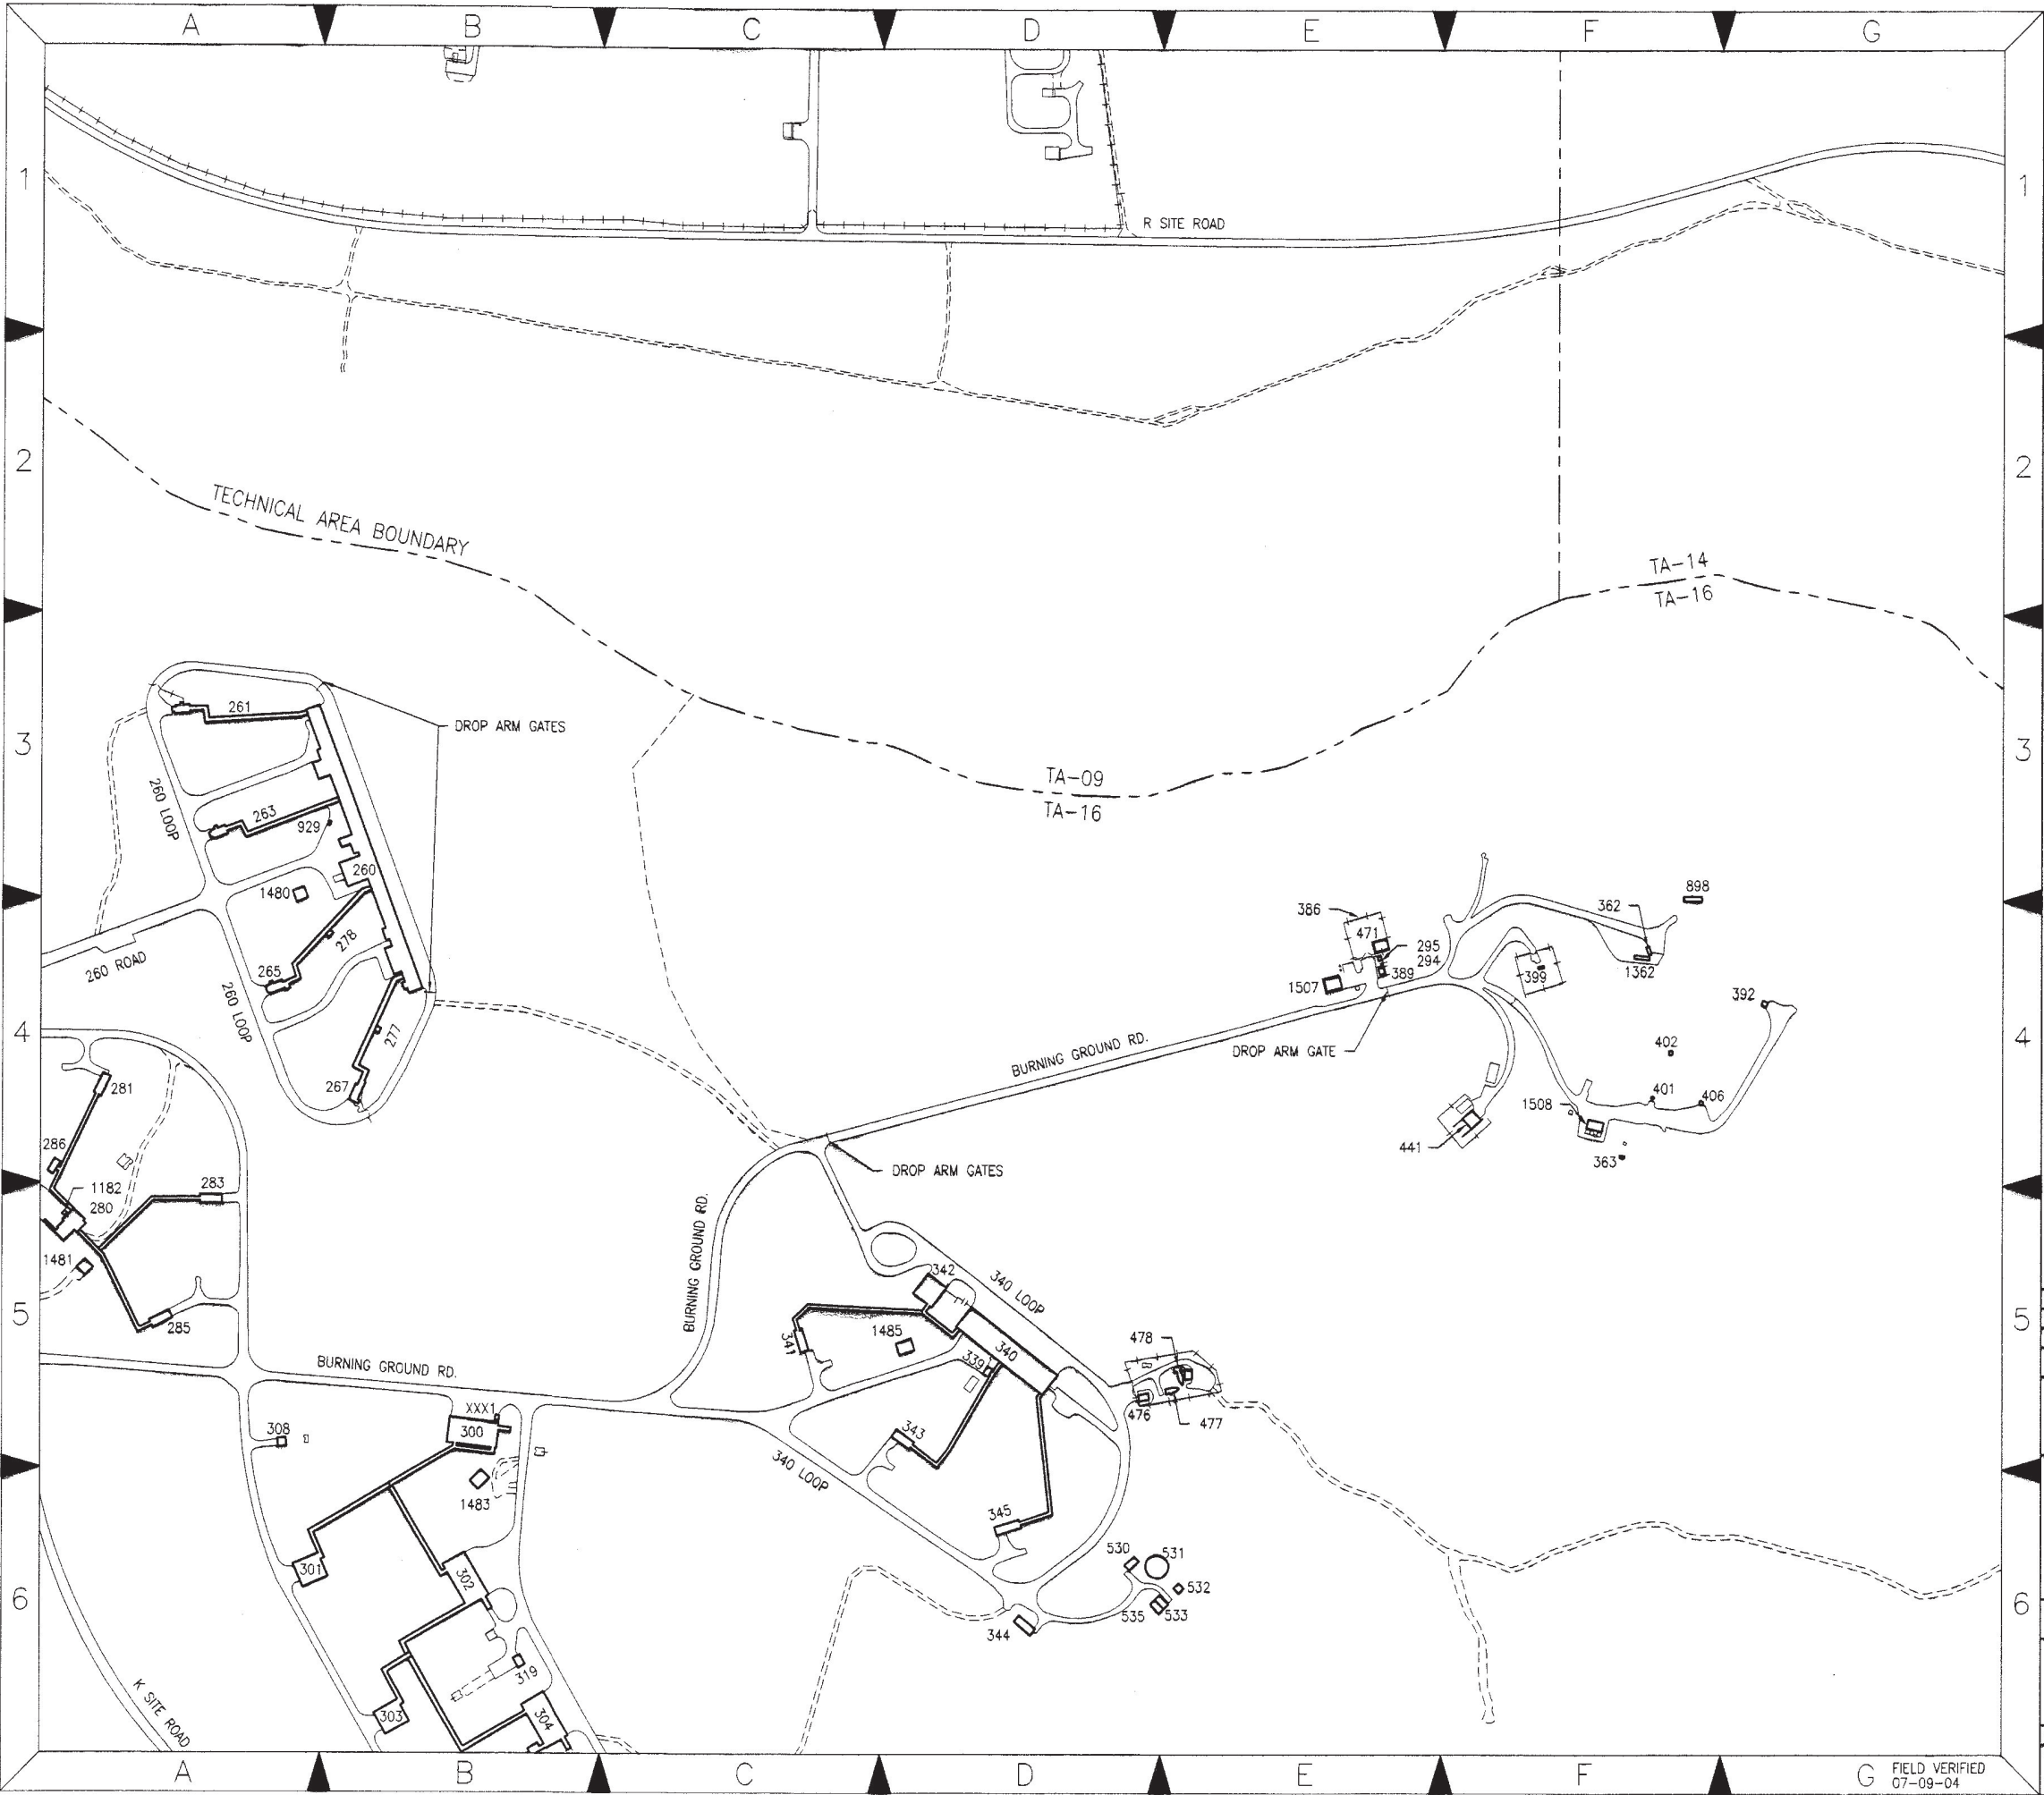


KEY MAP

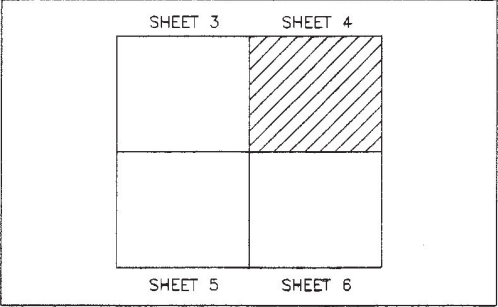


12	07-09-04	LL HMS	REVISED TO STATUS OF 07-09-04	EIM	HPR	RAC	HMS	LAB
11	10-22-03		REVISED TO STATUS OF 10-22-03	EIM	HPR	MEG	HMS	LAB
10	03-24-03		REVISED TO STATUS OF 03-24-03	EIM	HPR	MEG	HMS	LAB
9	11-25-02		REVISED TO STATUS OF 11-25-02	HPR	MEG	MEG	HMS	LAB
NO	DATE	CLASS REV	DESCRIPTION	DWN	DES	CHKD	SUB	APP



 **KBR • SHAW • LATA**

AS-BUILT STRUCTURE LOCATION MAPS				DRAWN	J. WORK
S-SITE TA-16				DESIGN	J. WORK
				CHECKED	H. SALAZAR
				DATE	08-04-93

SUBMITTED HAROLD SALAZAR		APPROVED FOR RELEASE BY LARRY BAYS		SHEET 4	
 Los Alamos NATIONAL LABORATORY		P.O. Box 1663 Los Alamos, New Mexico 87545		4 OF 6	
CLASSIFICATION U		REVIEWER H. SALAZAR		DATE	
PROJECT ID		DRAWING NO		REV	
KSL NO. 91-020		11952		AB21	
FIELD VERIFIED 07-09-04				12	

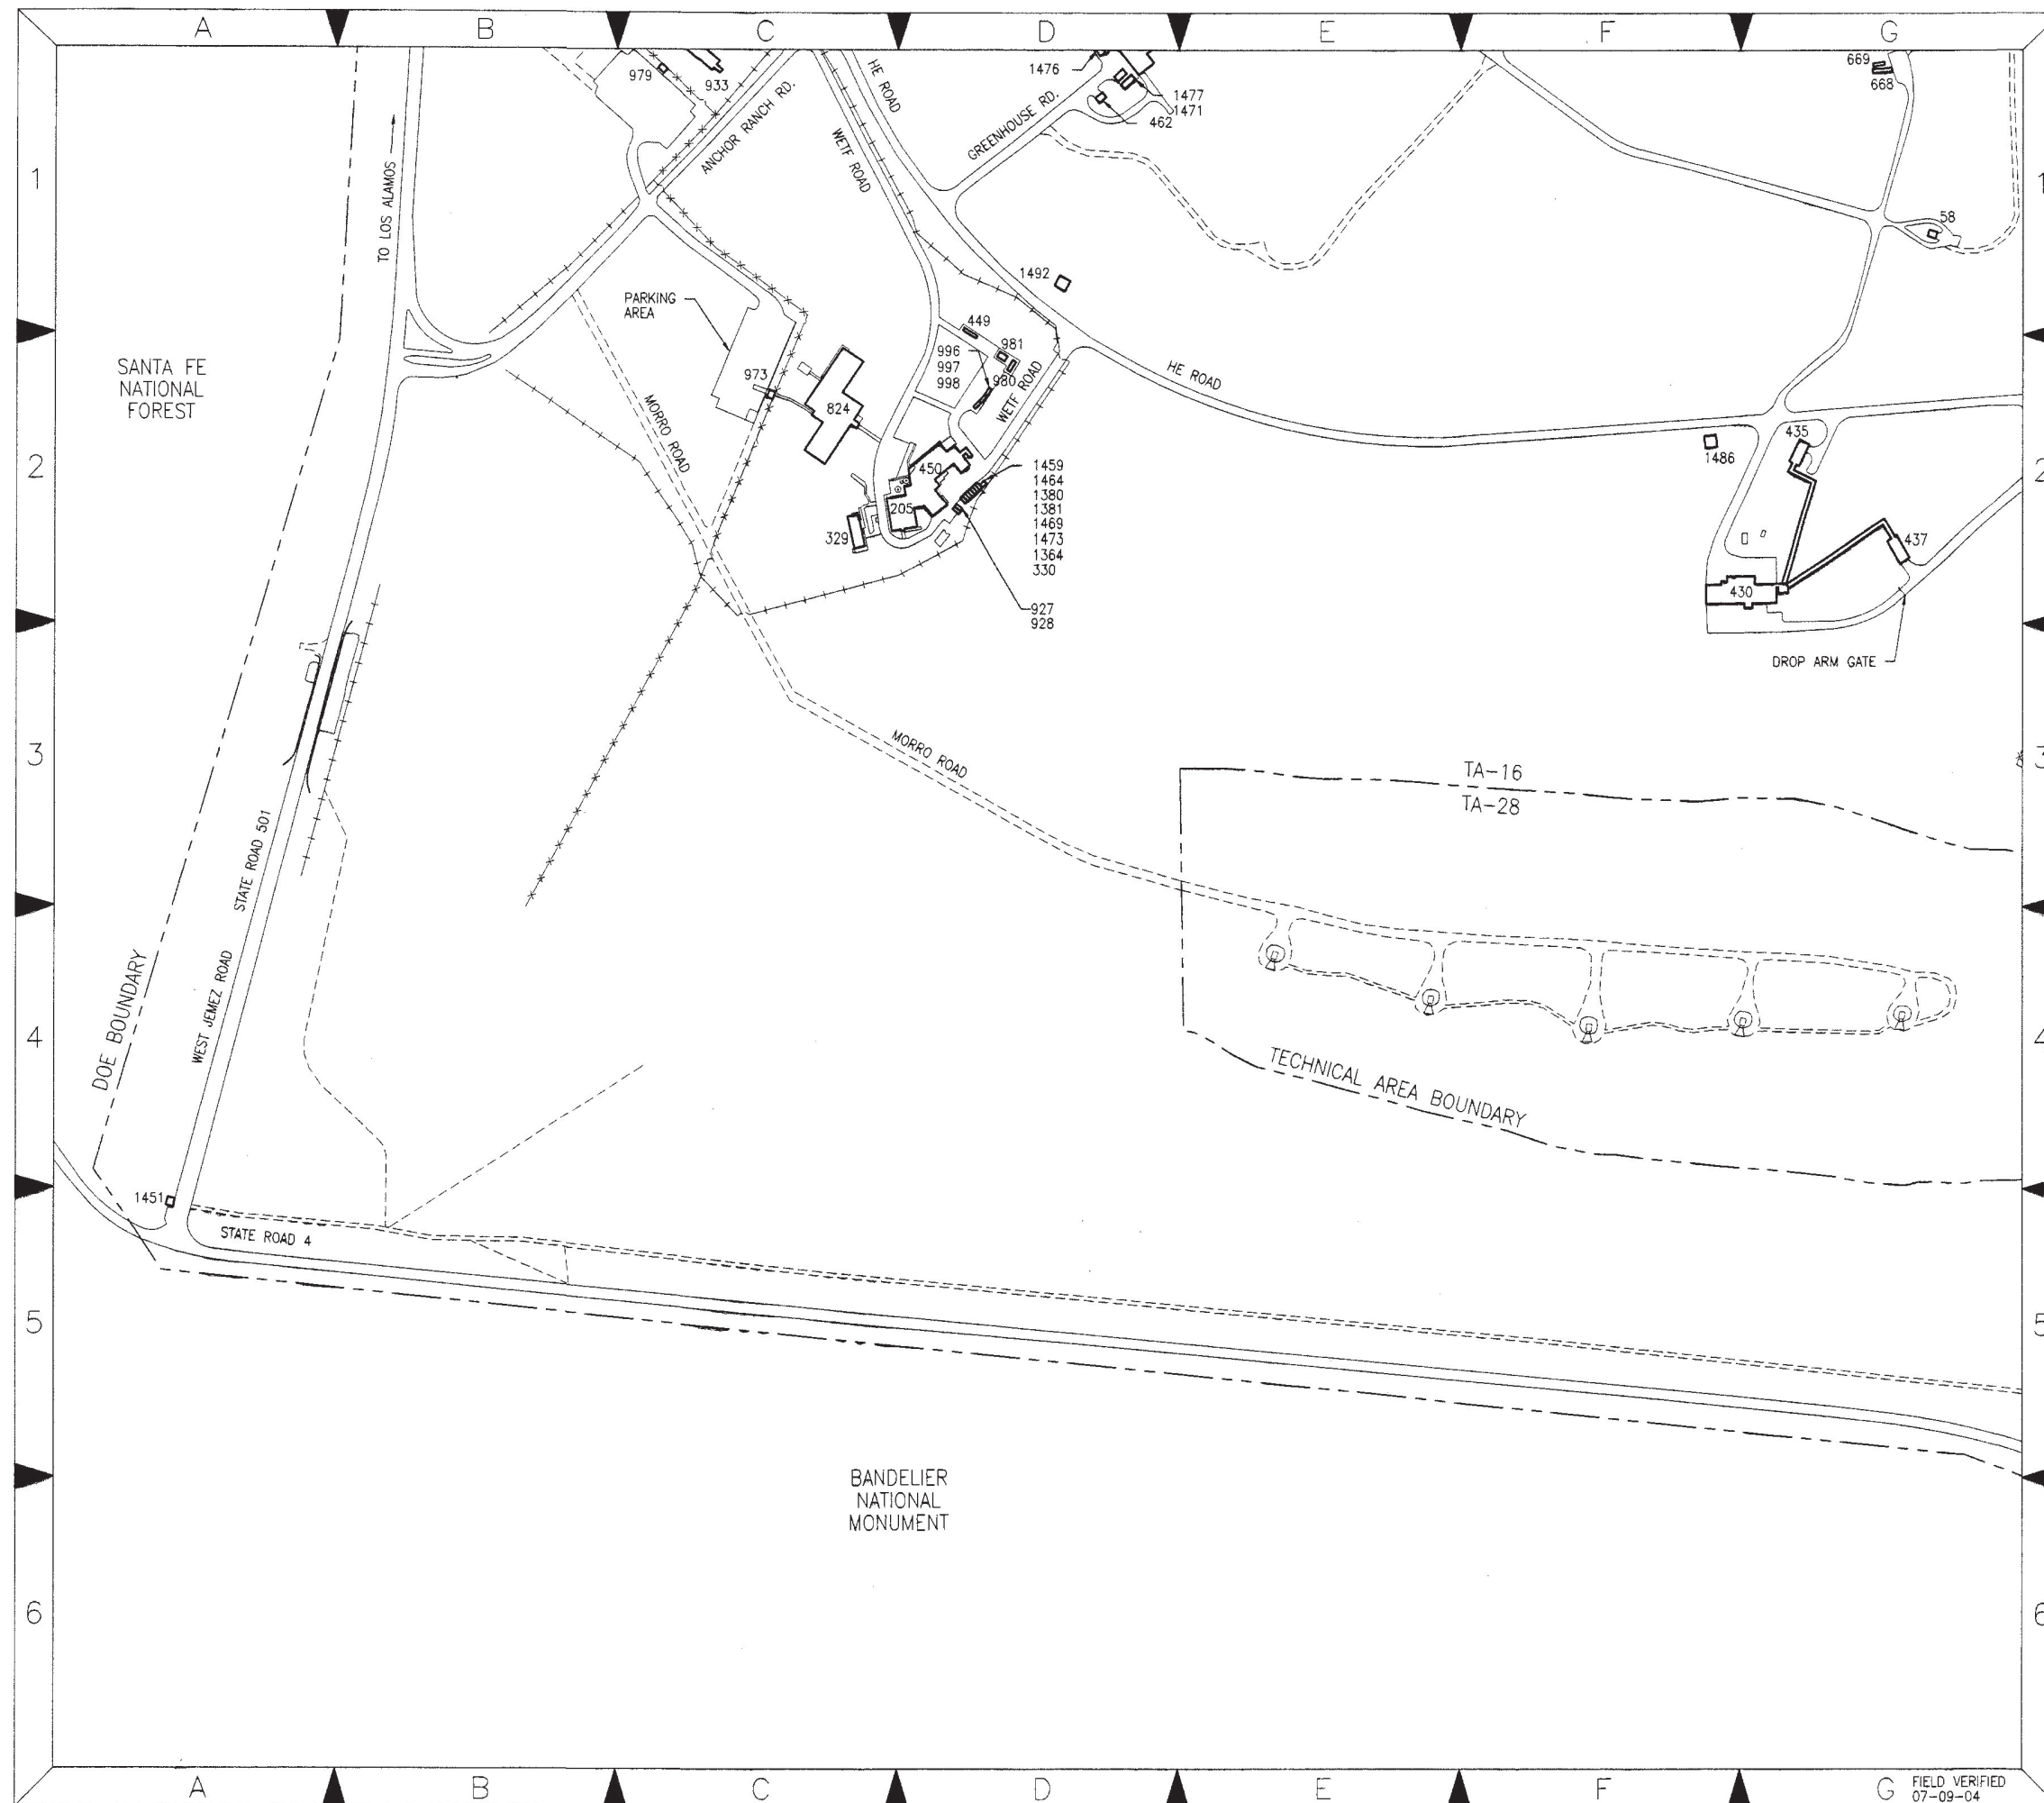

KEY MAP

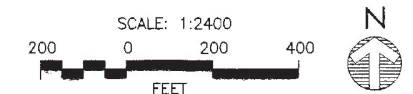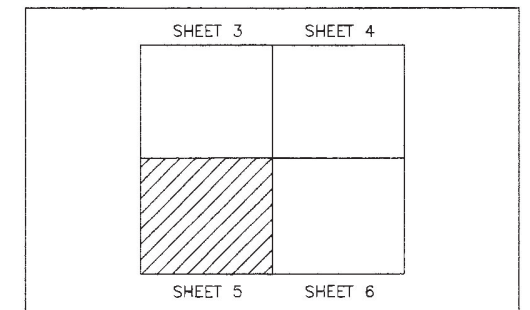


15	07-09-04	HA	REVISED TO STATUS OF 07-09-04	EIM	HPR	RAC	HMS	LAB
14	10-22-03		REVISED TO STATUS OF 10-22-03	EIM	HPR	MEG	HMS	LAB
13	03-24-03		REVISED TO STATUS OF 03-24-03	EIM	HPR	MEG	HMS	LAB
12	11-25-02		REVISED TO STATUS OF 11-25-02	HPR	MEG	MEG	HMS	LAB
NO	DATE	CLASS	DESCRIPTION	DWN	DES	CHKD	SUB	APP





AS-BUILT STRUCTURE LOCATION MAPS	DRAWN	J. MORK
S-SITE	DESIGN	J. MORK
TA-16	CHECKED	H. SALAZAR
	DATE	08-04-93

SUBMITTED	APPROVED FOR RELEASE BY	SHEET
HAROLD SALAZAR	LARRY BAYS	5
Los Alamos NATIONAL LABORATORY	PROJECT ID	5 OF 6
PO Box 1663 Los Alamos, New Mexico 87545	REVIEWER	DATE
	H. SALAZAR	
CLASSIFICATION U	DRAWING NO	REV
PROJECT ID	11952	AB21
KS L No. 91-020		15

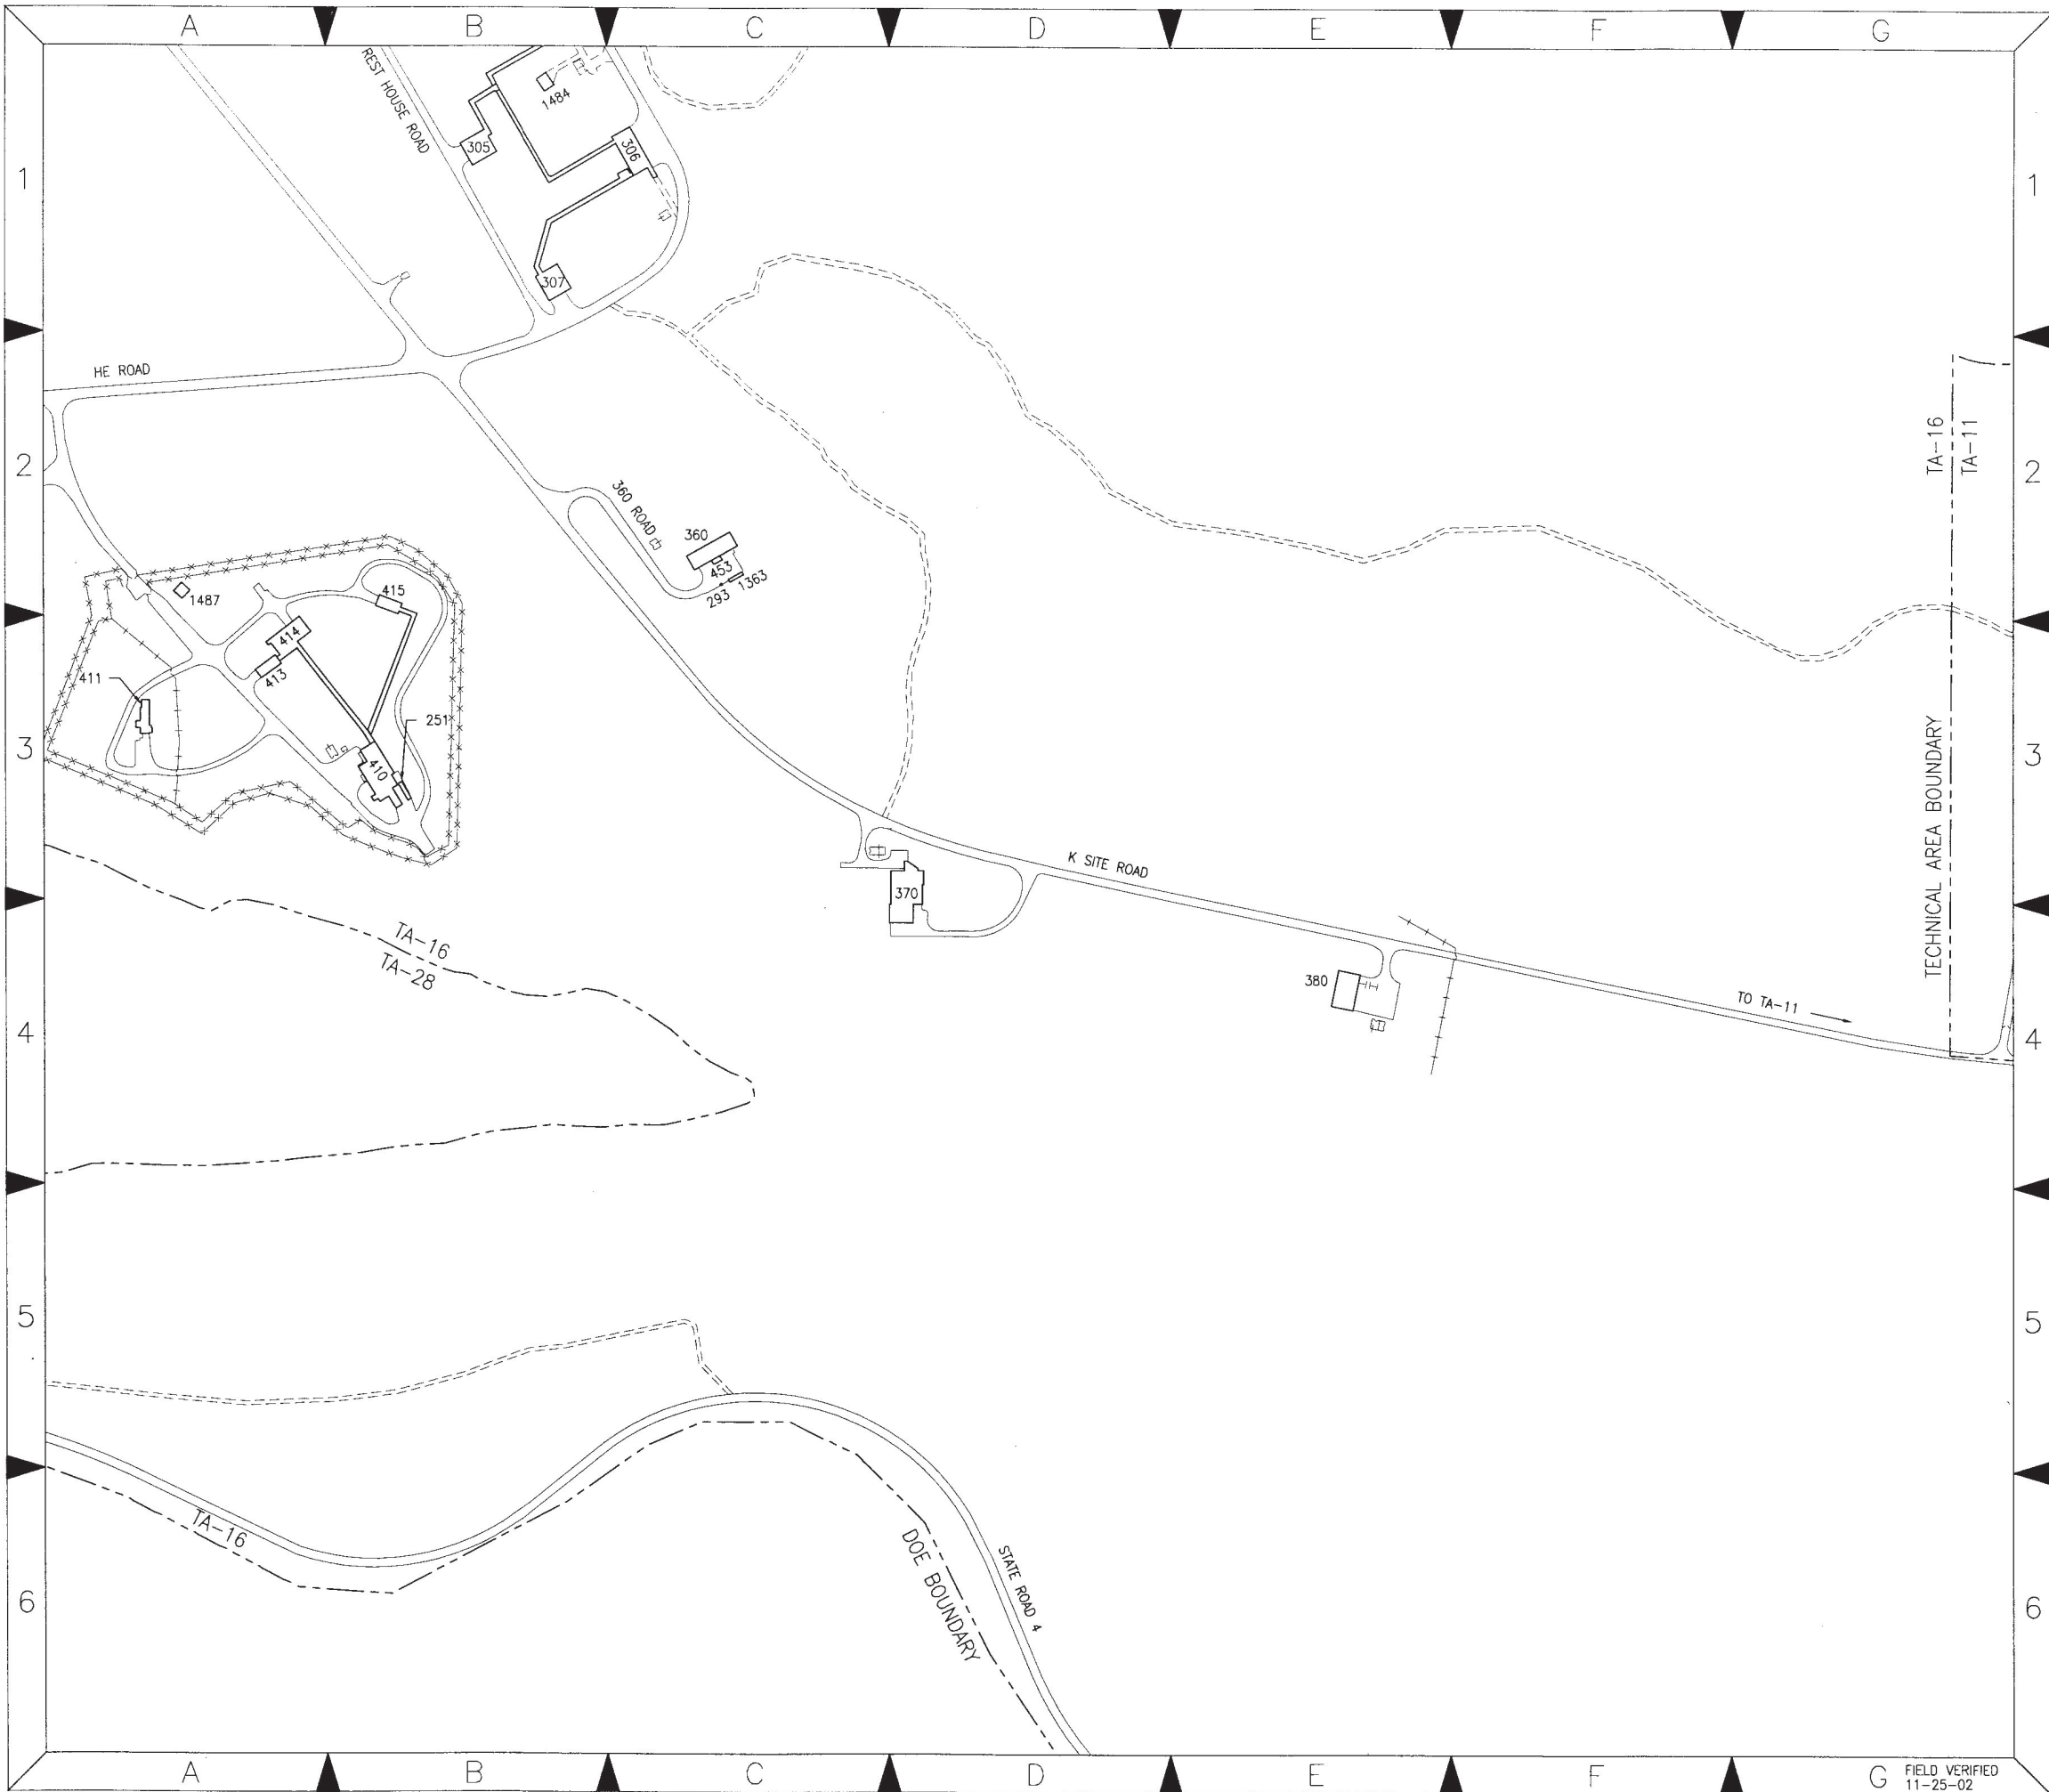

KEY MAP

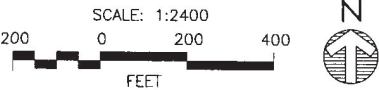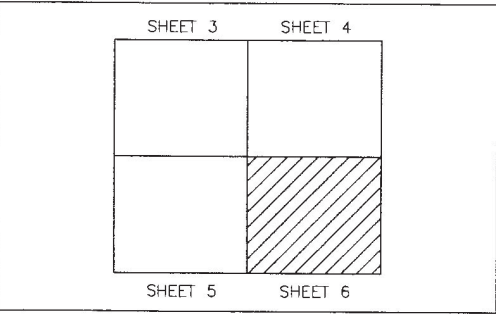


8	11-25-02	KS	REVISED TO STATUS OF 11-25-02	HPR	MEC	MEC	HMS	LAB
7	04-16-01		REVISED TO STATUS OF 04-16-01	HPR	SAD	CES	HMS	LAB
6	05-30-00		REVISED TO STATUS OF 05-30-00	MMM	SAD	CES	HMS	LAB
5	03-01-99		REVISED TO STATUS OF 03-01-99	SAD	MSV	HMS	HMS	LAB
NO	DATE	CLASS REV	DESCRIPTION	DWN	VER	CHKD	SUB	APP

Johnson Controls
Northern New Mexico


AS-BUILT STRUCTURE LOCATION MAPS				DRAWN	J. WORK
TA-16				VERIFIED	J. WORK
S-SITE				CHECKED	H. SALAZAR
				DATE	08-04-93

SUBMITTED HAROLD SALAZAR	APPROVED FOR RELEASE LARRY BAYS
-----------------------------	------------------------------------

Los Alamos		Los Alamos National Laboratory Los Alamos, New Mexico 87545		SHEET 6	6 OF 6
CLASSIFICATION PROJECT ID	11952	REVIEWER HAROLD SALAZAR	DATE 1-6-03	DRAWING NO AB21	REV 8
JCI NO 91-020					

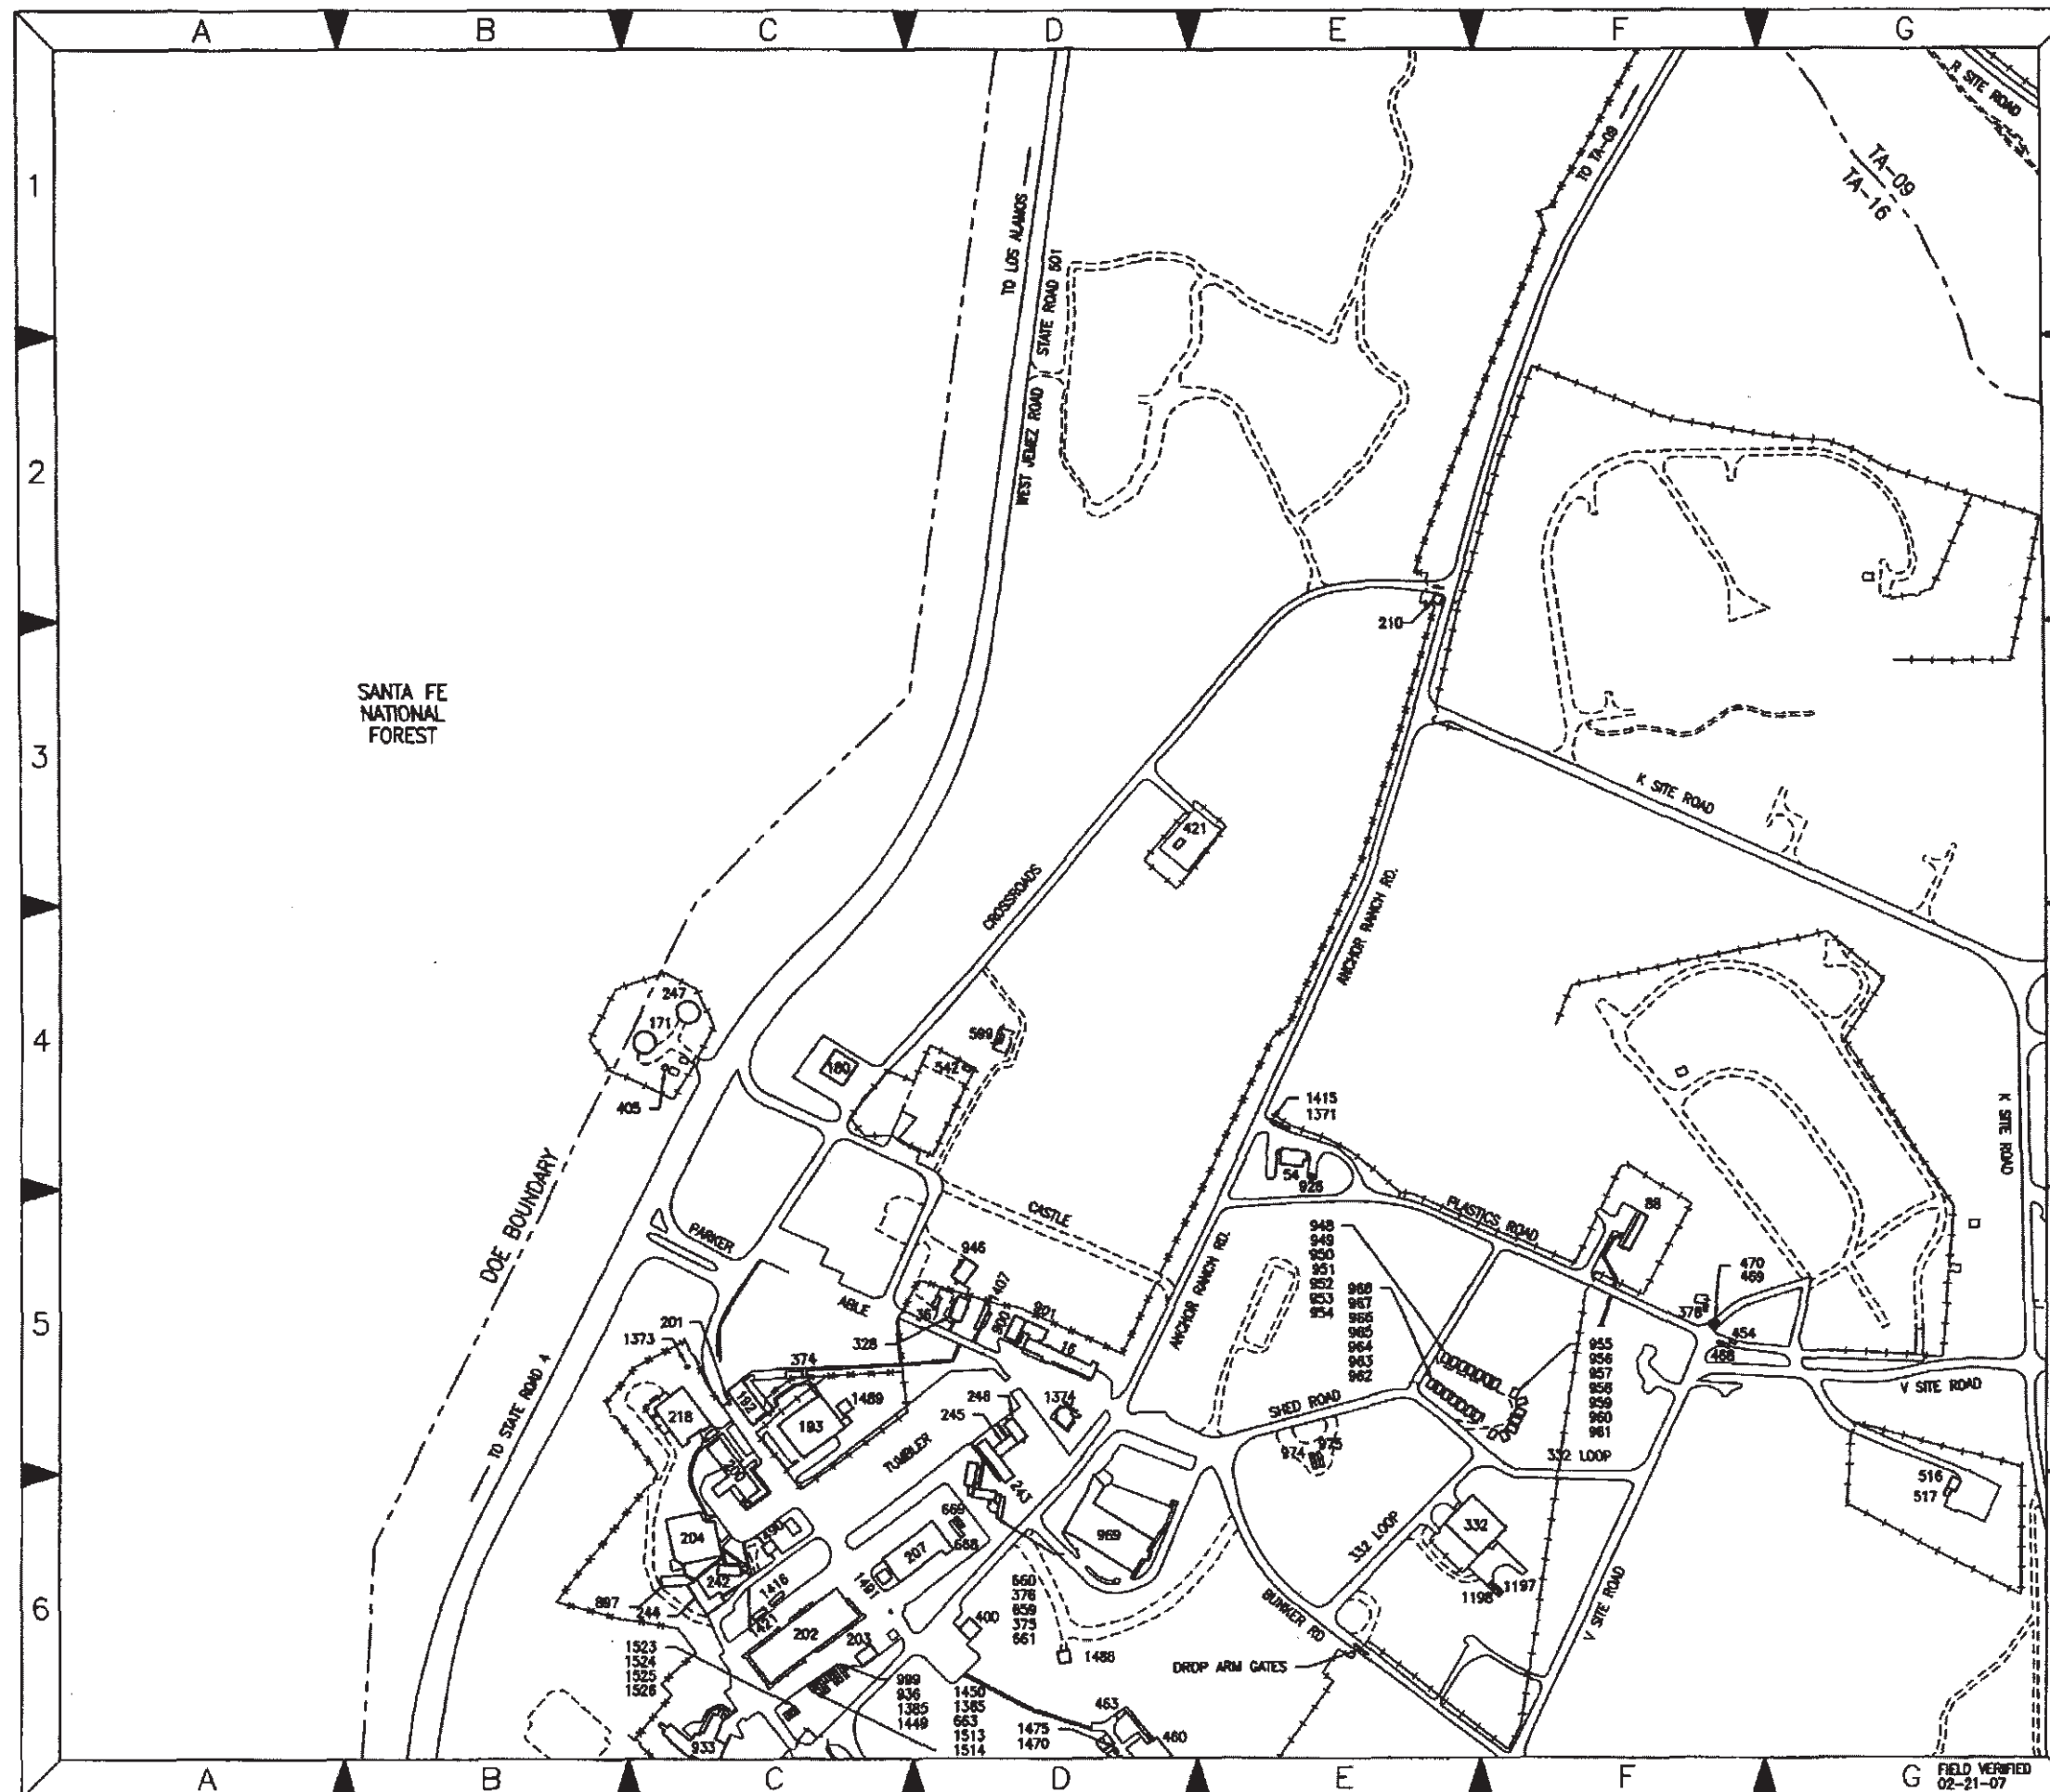

KEY MAP

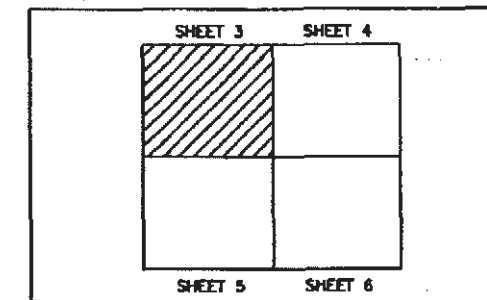


21	02-21-07	REMOVED TO STATUS OF 02-21-07	LN	HP	RG	MS	APP
20	06-07-06	REMOVED TO ADD TRANSPORTATION S.C. 202	HP	HP	RG	MS	APP
19	06-10-05	REMOVED TO STATUS OF 06-10-05	HP	HP	RG	MS	APP
18	07-08-04	REMOVED TO STATUS OF 07-08-04	HP	HP	RG	MS	APP
17	07-08-04	REMOVED TO STATUS OF 07-08-04	HP	HP	RG	MS	APP
KSL KBR • SHAW • LATA

AS-BUILT STRUCTURE LOCATION MAPS
S-SITE
TA-16

SUBMITTED	HAROLD SALAZAR	APPROVED FOR RELEASE BY	LARRY BOTS	SHEET	3
CLASSIFICATION	U	REVIEWER	H. SALAZAR	DATE	08-04-93
PROJECT ID	11952	DRAWING NO	AB21	REV	21
KSL NO. 91-020	11952	AB21	21		

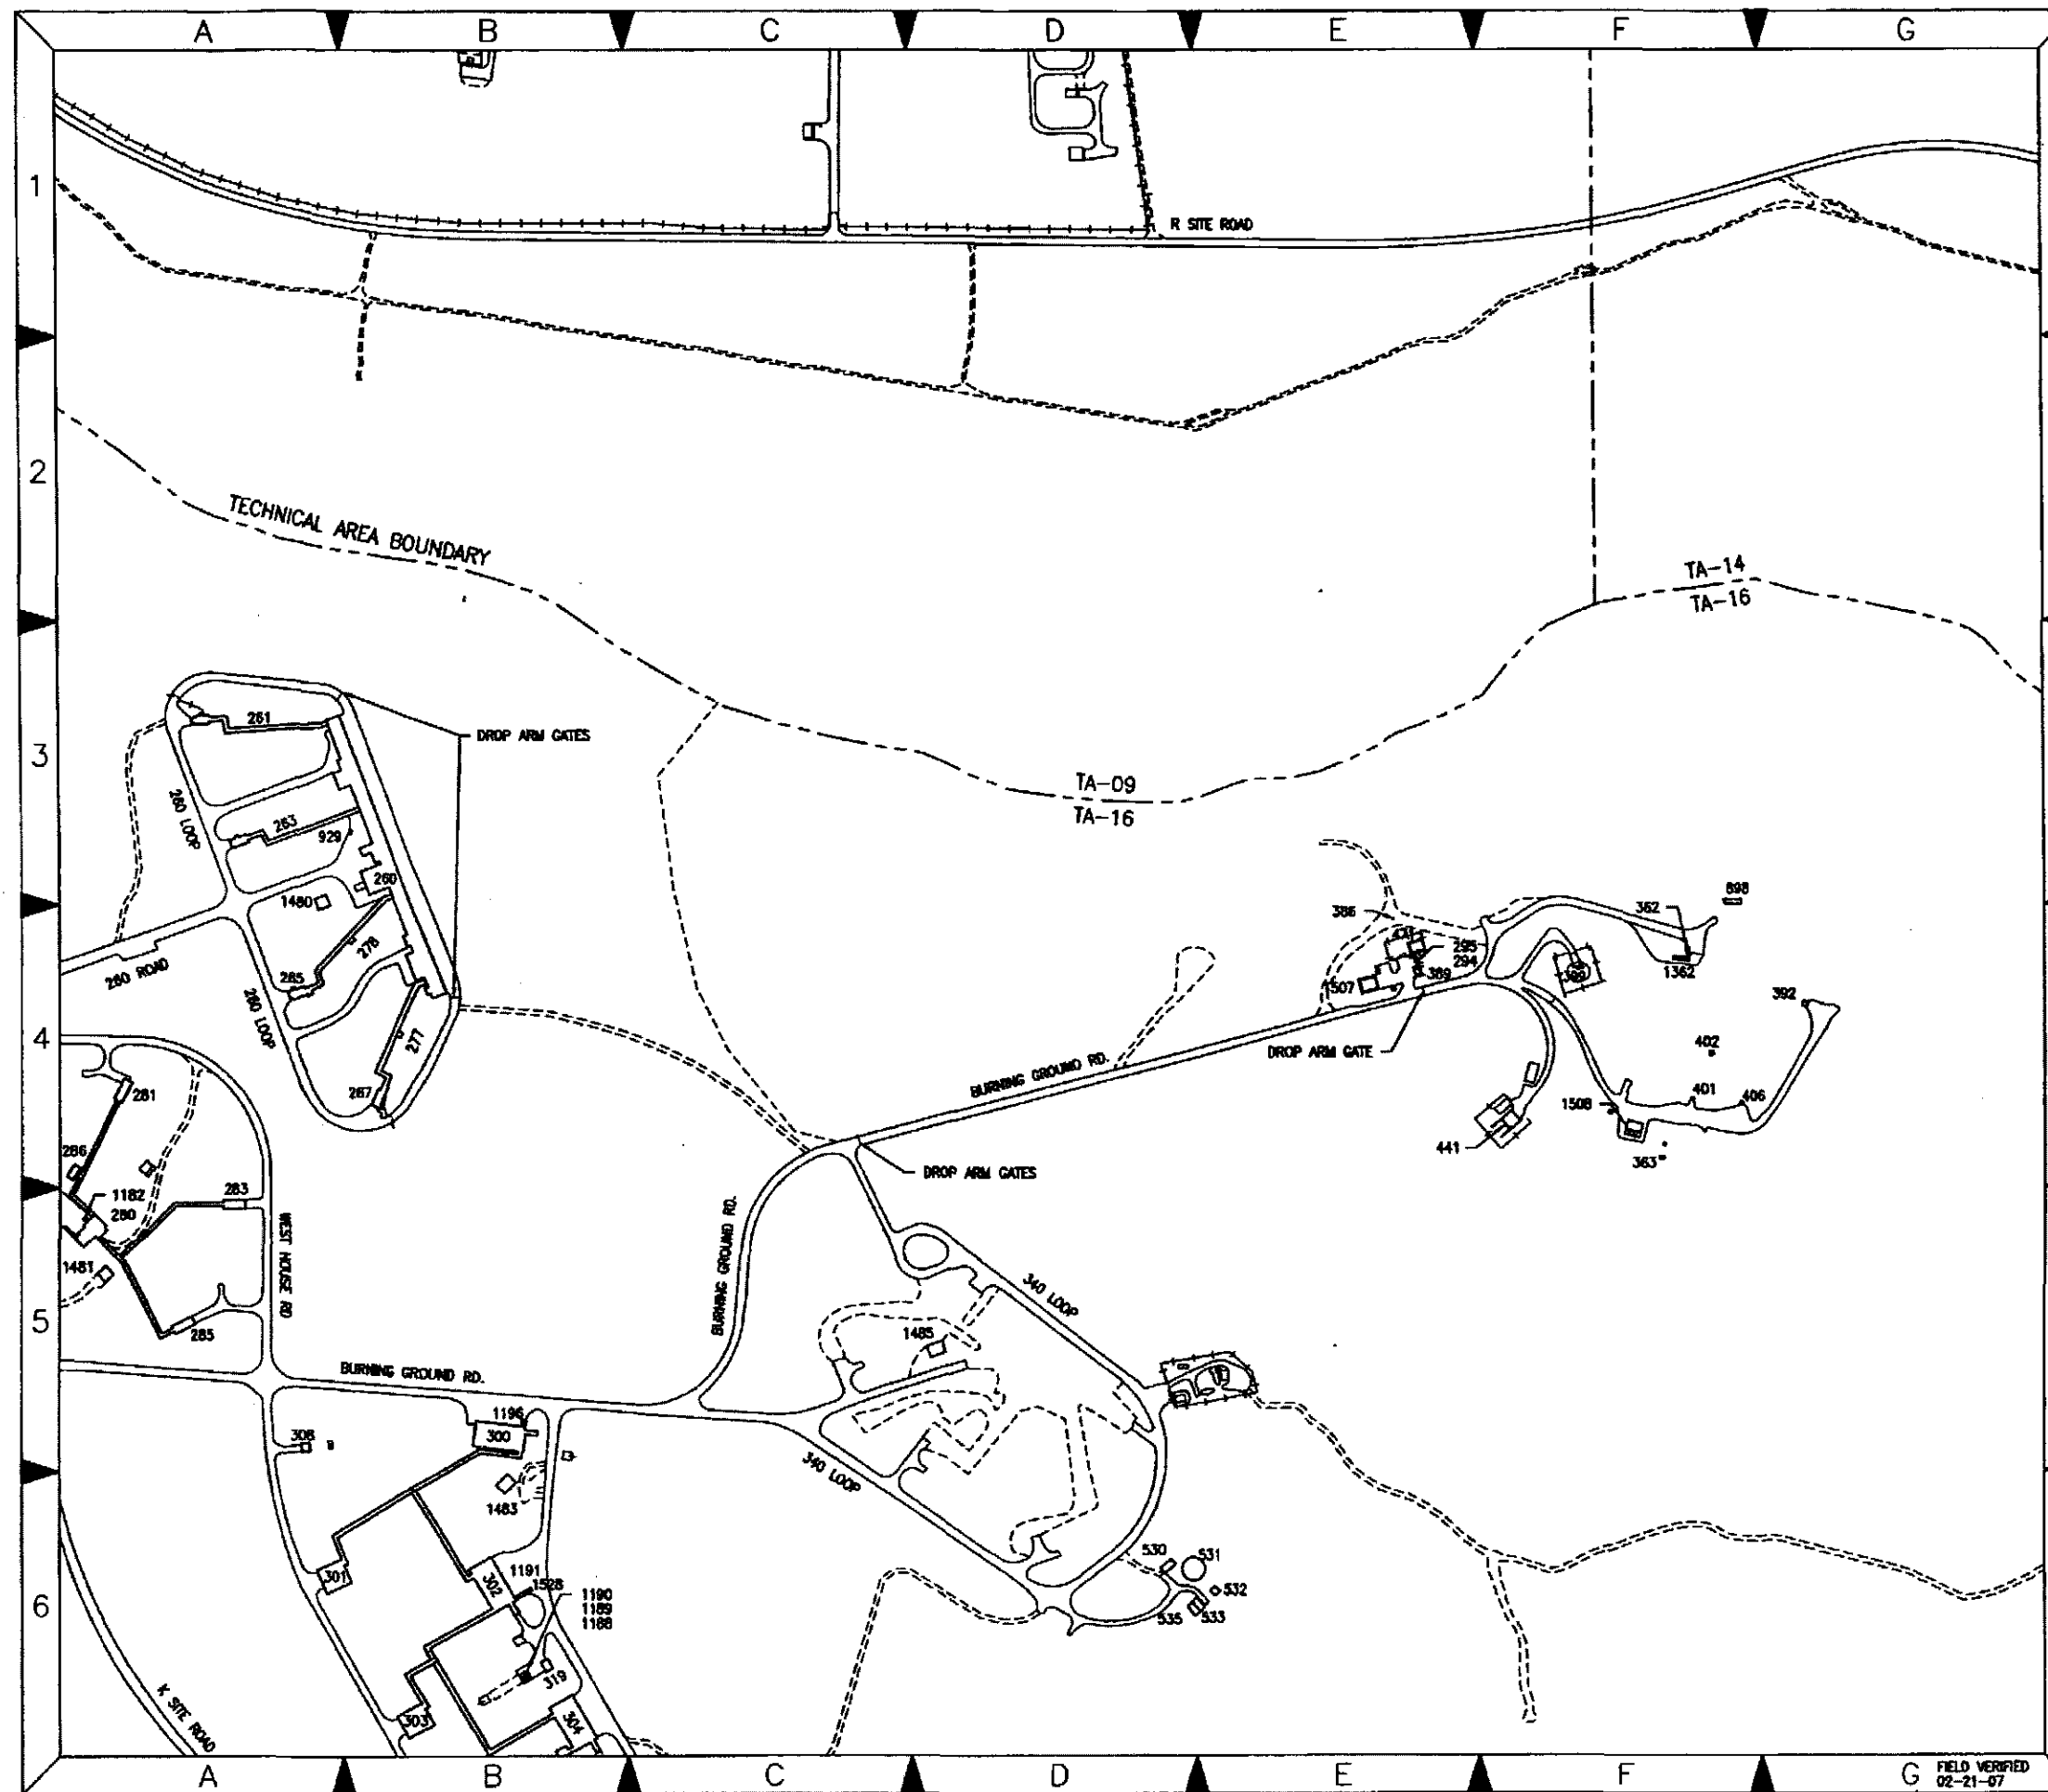

KEY MAP

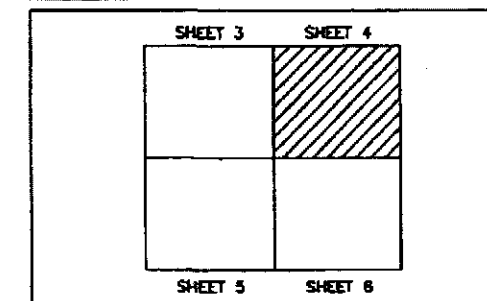


14	02-21-07	66 #45	REVISED TO STATUS OF 02-21-07	LSM	HP	MS	MS	MS
13	06-10-05		REVISED TO STATUS OF 06-10-05	HP	HP	MS	MS	MS
12	07-08-04		REVISED TO STATUS OF 07-08-04	EM	HP	MS	MS	MS
11	10-22-03		REVISED TO STATUS OF 10-22-03	EM	HP	MS	MS	MS
NO	DATE	CLAS	DESCRIPTION	DRN	DCS	CHD	SUB	APP


KSL KBR • SHAW • LATA

AS-BUILT STRUCTURE LOCATION MAPS				DRAWN	J. MORG
S-SITE				DESIGN	J. MORG
TA-16				CHECKED	H. SALAZAR
				DATE	06-04-03

SUBMITTED HAROLD SALAZAR	APPROVED FOR RELEASE BY LARRY BWS
CLASSIFICATION U	REVIEWER H. SALAZAR
PROJECT ID	DRAWING NO
11952	AB21
14	14

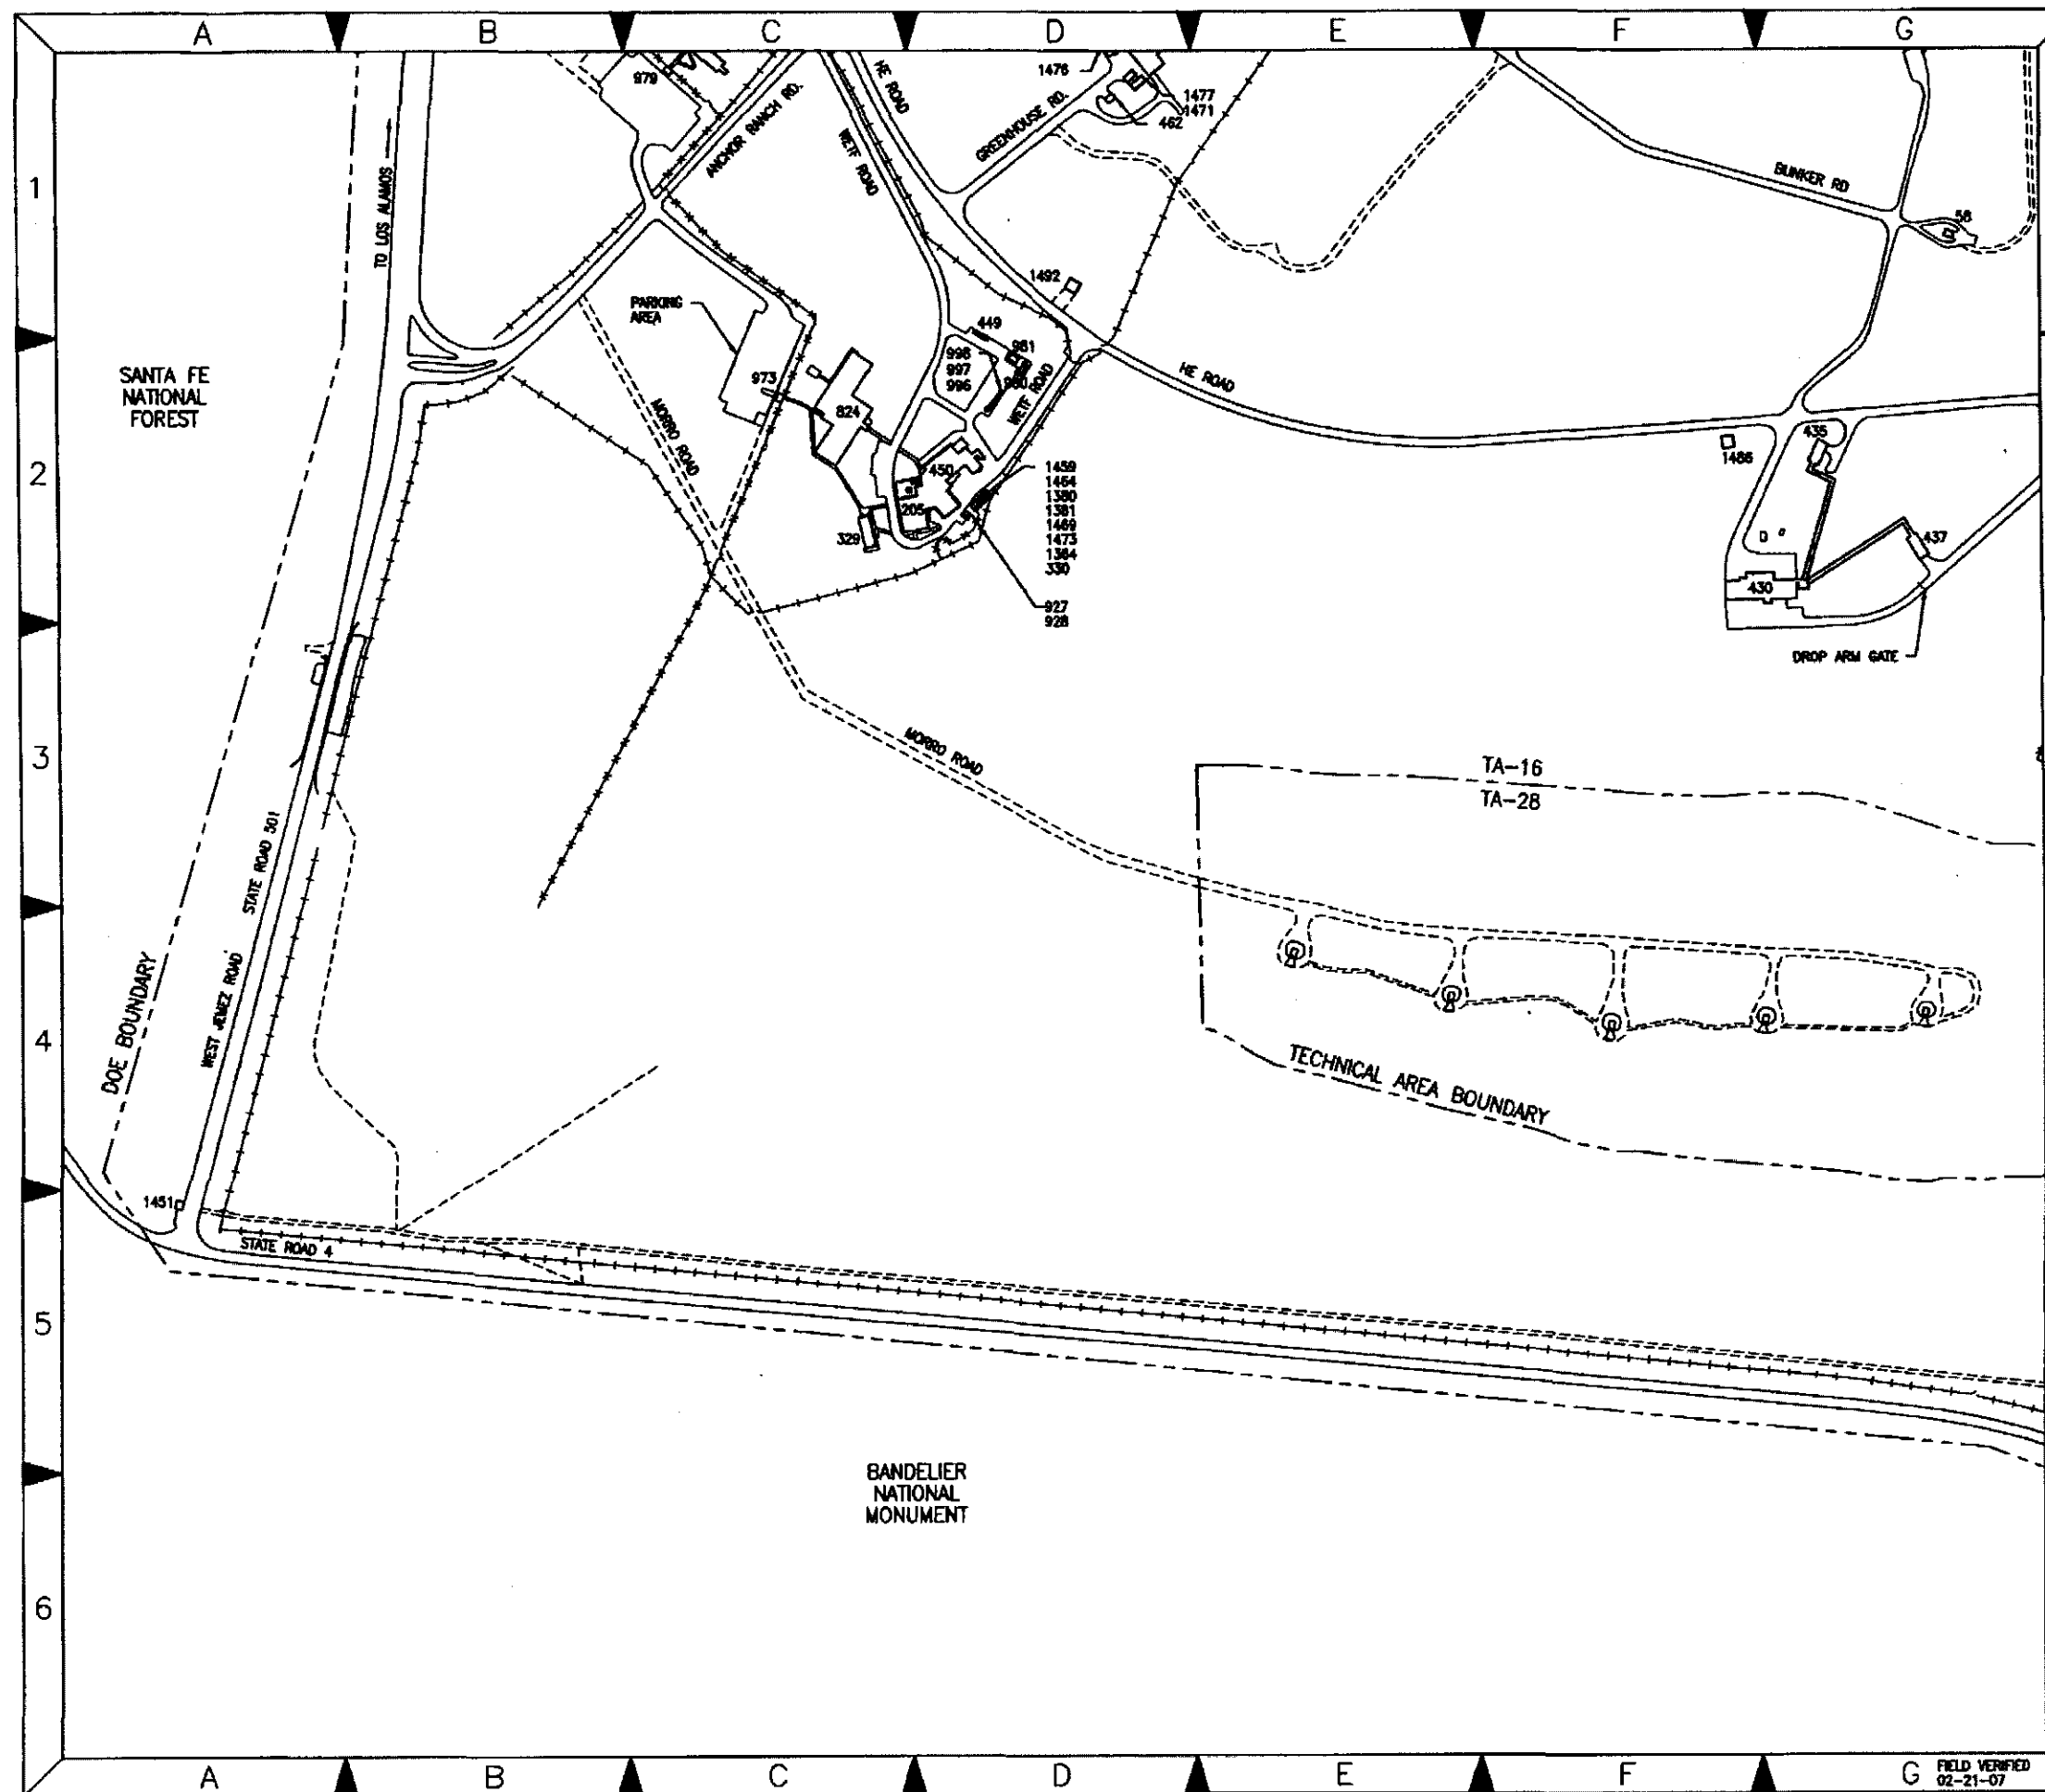

KEY MAP

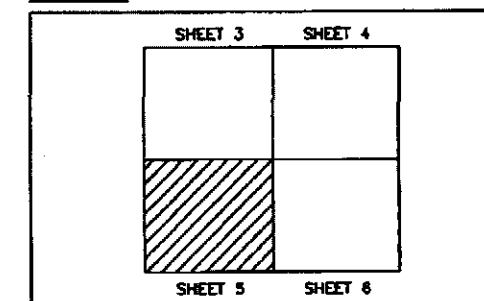

16	02-21-07	REVISED TO STATUS OF 02-21-07	LM	HP	RD	MS	LB		
15	07-08-04	REVISED TO STATUS OF 07-08-04	EM	HP	RD	MS	LB		
14	10-22-03	REVISED TO STATUS OF 10-22-03	EM	HP	RD	MS	LB		
13	03-24-03	REVISED TO STATUS OF 03-24-03	EM	HP	RD	MS	LB		
NO	DATE	CLASS	REV	DESCRIPTION	DRN	DES	CHKD	SUB	APP

KSL KBR • SHAW • LATA

AS-BUILT STRUCTURE LOCATION MAPS

S-SITE

TA-16


DESIGN	J. WORK
CHECKED	H. SALAZAR
DATE	08-04-03

SUBMITTED HAROLD SALAZAR APPROVED FOR RELEASE BY LARRY BAY

Los Alamos NATIONAL LABORATORY PO Box 1663 Los Alamos, New Mexico 87545

CLASSIFICATION U PROJECT ID KSL NO. 91-020 11952 DRAWING NO AB21 REV 16

FIELD VERIFIED 02-21-07

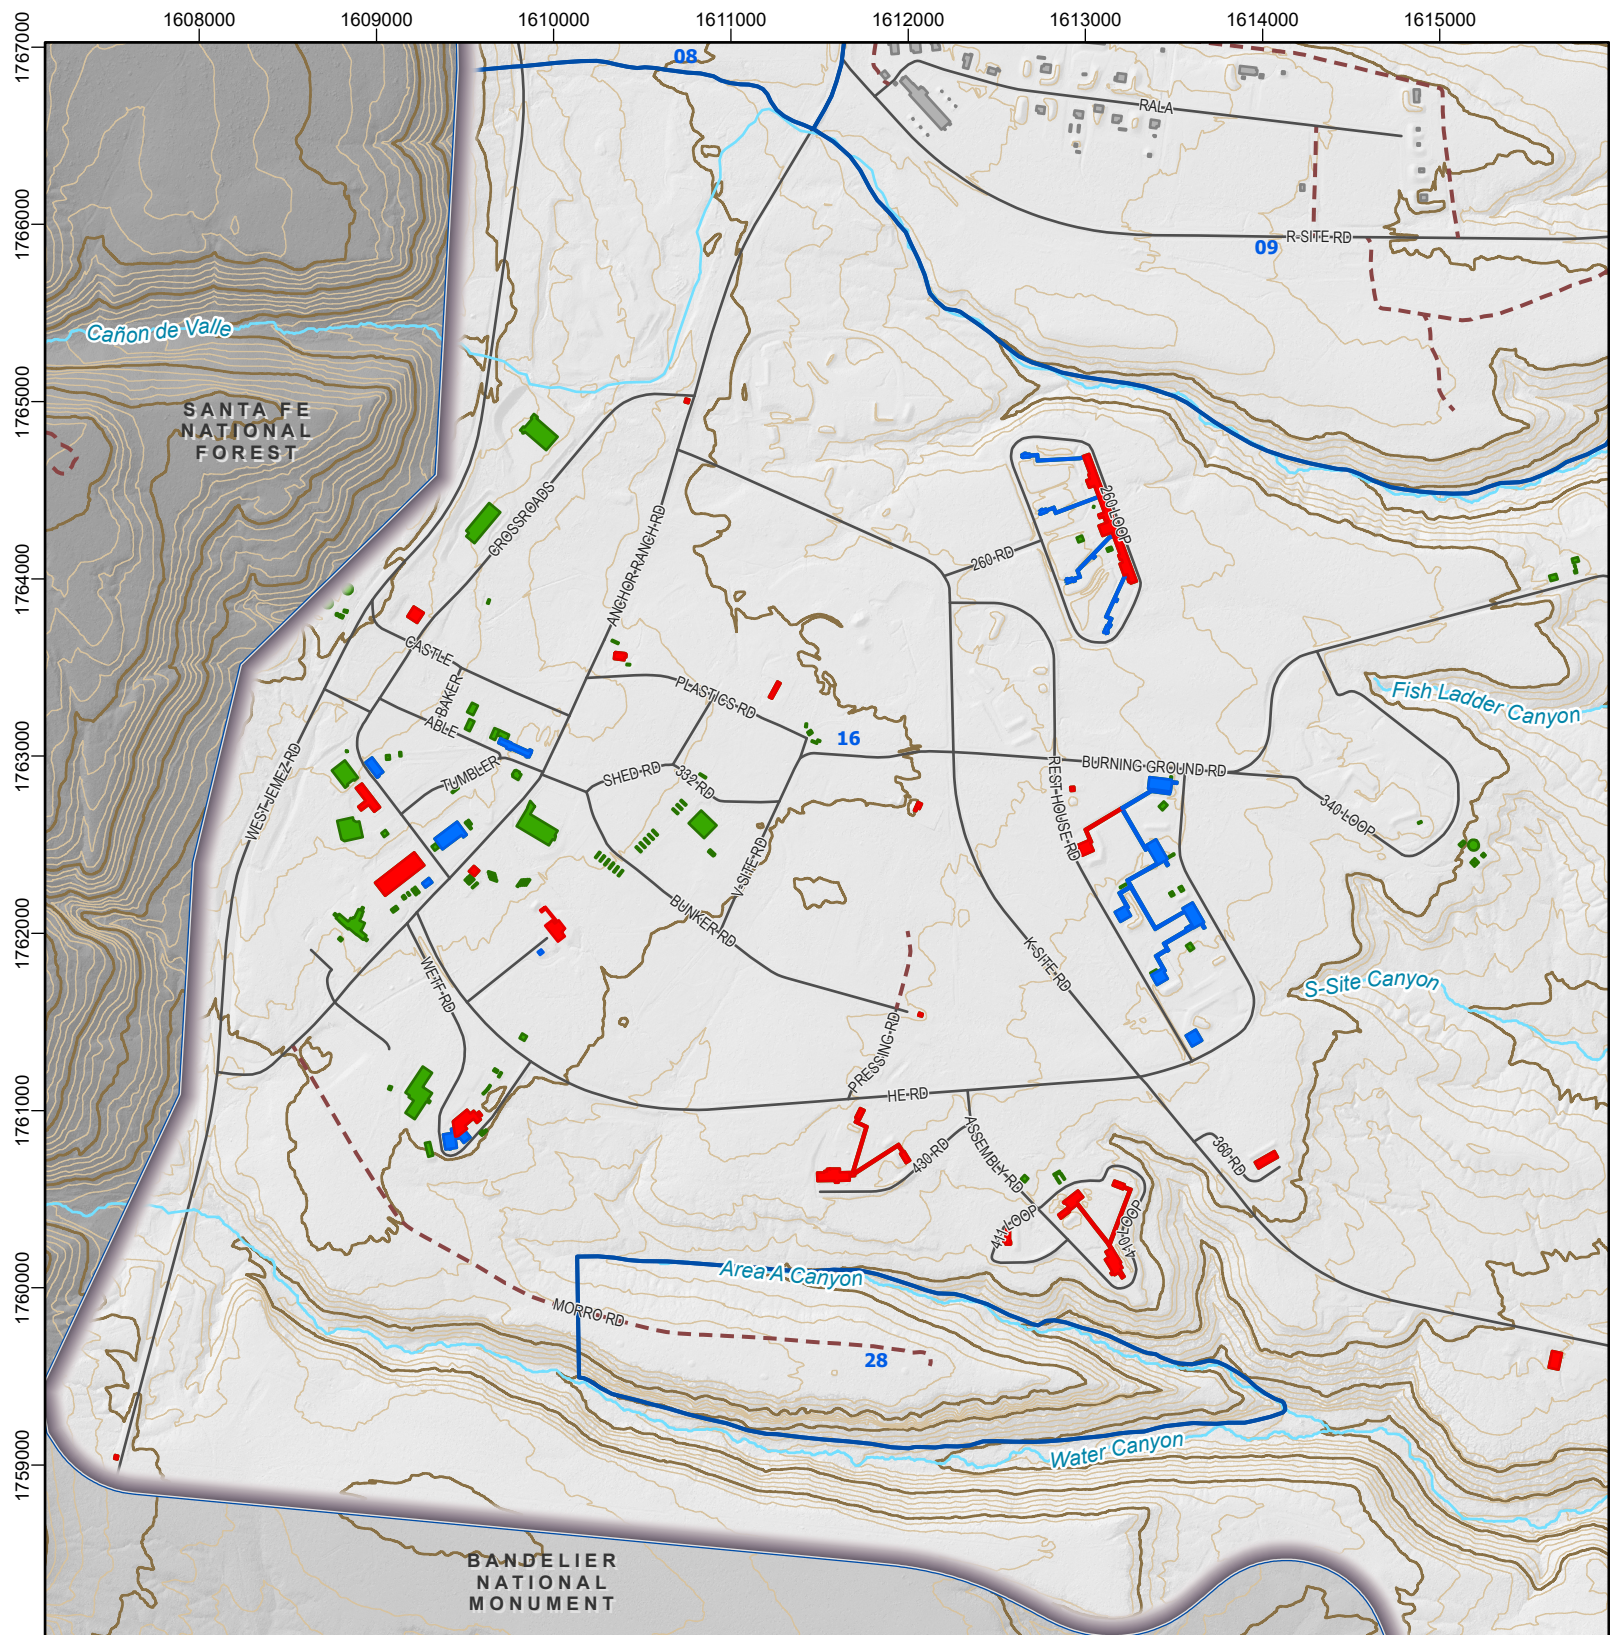

Legend

- Previously Declared Eligible
- Not Eligible
- TA-16 Buildings
- Other Buildings
- LANL Boundary
- Technical Areas
- Drainage
- Dirt Roads
- Paved Roads
- Contours, 20 ft
- Contours, 100 ft



Scale: 1:13,000 ft

New Mexico State Plane Coordinate System, Central Zone (3002)
North American Datum, 1983 (NAD83), US Survey Feet

TA-16 Evaluated Buildings

Map Number: 22-113-04 November 2022
Bethann McVicker, GIS Program



GIS Program



Los Alamos
NATIONAL LABORATORY



Appendix D: Construction History of TA-16 including Register Eligible and Ineligible Buildings

This page intentionally left blank

TA-16-460 DRAWING LIST

Date	Disc.	Drawing No.	Drawing Name
3/7/1951	STRUC.	C16288-00019	BASEMENT AND FOUNDATION PLAN AND DETAILS, PROJECT I
3/7/1951	STRUC.	C16289-00020	FIRST FLOOR FRAMING PLAN, PROJECT I
3/7/1951	STRUC.	C16289-00020	FIRST FLOOR FRAMING PLAN, PROJECT I
3/7/1951	STRUC.	C16290-00021	ROOF FRAMING PLAN AND DETAILS, PROJECT I
3/7/1951	STRUC.	C16292-00023	ROOF SLEEVE AND INSERT LAYOUT AND DETAILS, PROJECT I
3/7/1951	STRUC.	C16293-00024	LONGITUDINAL SECTIONS, PLAN AND DETAILS, PROJECT I
3/7/1951	STRUC.	C16294-00025	TRANSVERSE SECTIONS, PROJECT I
3/7/1951	STRUC.	C16295-00026	MISCELLANEOUS DETAILS, PROJECT I
3/7/1951	MECH.	C16314-00045	EQUIPMENT PIPING DETAILS, PROJECT I
3/7/1951	MECH.	C16315-00046	PIPING SECTIONS, PROJECT I
3/7/1951	MECH.	C16318-00049	SERVICE PIPING ROOM 102, PROJECT I
3/7/1951	MECH.	C16320-00051	SERVICE PIPING ROOM 106, PROJECT I
3/8/1951	STRUC.	C16291-00022	FIRST FLOOR SLEEVE AND INSERT LAYOUT, PROJECT I
3/8/1951	MECH.	C16301-00032	FIRST FLOOR PLUMBING PLAN, PROJECT I
3/8/1951	MECH.	C16302-00033	BASEMENT PLUMBING PLAN, PROJECT I
3/8/1951	MECH.	C16303-00034	PRESSURIZED HOODS SUPPLY & EXHAUST SYSTEM, PROJECT I
3/8/1951	MECH.	C16304-00035	EXHAUST HOOD ASSEMBLY, PROJECT I
3/8/1951	MECH.	C16305-00036	EXHAUST HOOD ASSEMBLY DETAILS, PROJECT I
3/8/1951	MECH.	C16307-00038	TOILET ROOMS EXHAUST AND MISCELLANEOUS DETAILS, PROJECT I
3/8/1951	GEN.	C16308-00039	BASEMENT AIR CONDITIONING LAYOUT, PROJECT I
3/8/1951	GEN.	C16309-00040	FIRST FLOOR AIR CONDITIONING LAYOUT, PROJECT I
3/8/1951	MECH.	C16310-00041	UTILITY ROOM DETAILS, PROJECT I
3/8/1951	FIRE	C16311-00042	FIRST FLOOR SPRINKLER PLAN, PROJECT I
3/8/1951	FIRE	C16312-00043	BASEMENT SPRINKLER PLAN, PROJECT I
3/9/1951	MECH.	C16313-00044	BASEMENT PIPING PLAN, PROJECT I
3/9/1951	MECH.	C16319-00050	SERVICE PIPING ROOM 105, PROJECT I
3/12/1951	ARCH.	C16274-00005	BASEMENT FLOOR PLAN AND SCHEDULE, PROJECT I
3/12/1951	ARCH.	C16275-00006	FIRST FLOOR PLAN AND SCHEDULES, PROJECT I
3/12/1951	ARCH.	C16276-00007	CEILING PLAN AND DETAILS, PROJECT I
3/12/1951	ARCH.	C16277-00008	ROOF PLAN AND DETAILS, PROJECT I
3/12/1951	ARCH.	C16278-00009	EQUIPMENT LAYOUT, PROJECT I
3/12/1951	ARCH.	C16279-00010	ELEVATIONS, PROJECT I
3/12/1951	ARCH.	C16280-00011	SECTIONS, PROJECT I
3/12/1951	ARCH.	C16281-00012	MISCELLANEOUS DETAILS, PROJECT I
3/12/1951	ARCH.	C16282-00013	EQUIPMENT DETAILS ROOMS 3 AND 101, PROJECT I
3/12/1951	ARCH.	C16283-00014	EQUIPMENT DETAILS, RMS. 102, 105, 107, 108, PROJECT I
3/12/1951	ARCH.	C16284-00015	EQUIPMENT DETAILS RMS. 106 & 115, PROJECT I
3/12/1951	ARCH.	C16285-00016	EQUIPMENT DETAILS RMS. 109 & 110, PROJECT I
3/12/1951	ARCH.	C16286-00017	EQUIPMENT DETAILS, PROJECT I

TA-16-460 DRAWING LIST

Date	Disc.	Drawing No.	Drawing Name
3/12/1951	ARCH.	C16287-00018	EQUIPMENT DETAILS RMS. 113 & 114, PROJECT I
3/13/1951	MECH.	C16306-00037	PARTITION DETAILS, EXHAUST SYSTEM, PROJECT I
6/24/1953	STRUC.	SK1574-00001	CONCRETE BALANCE TABLES TABLE & FORM DETAILS
7/7/1953	GEN.	C3095-00007	MODIFICATION TO AIR CONDITIONING SYSTEM, BASEMENT PLAN & DETAILS
10/30/1953	GEN.	C3207-00008	ALTERATIONS TO AIR COND. SYSTEM, ROOM 110, MECH & ELECT. PLANS, SECTIONS AND DET
3/5/1959	FIRE	R1860-00001	FIRE ALARM EQUIPMENT, BLDG. 16-460, BASEMENT & FIRST FLOOR PLANS
4/2/1962	ARCH.	R2307-00001	FALLOUT SHELTER SURVEY, FLOOR PLAN
7/12/1963	ELEC.	C18310-00001	EXHAUST HOOD INSTALLATION, MECH; FLOOR PLAN, ELEVATION, EQUIPMENT LIST, DETAILS, SINGLE LIINE DIAGRAM, NAMEPLATE SCHEDULE
4/29/1966	MECH.	C34274-00001	FILTER SYSTEM REPLACEMENT, MECH; BASEMENT FLOOR PLAN, ELEVATION, FILTER ASSEMBLY
8/11/1966	CIVIL	C34244-00005	H.E. SUMP MODIFICATIONS, CIVIL, TANK INSTALLATION PLANS AND DETAILS
9/1/1967	ARCH.	R4143-00001	AUDIO SYSTEM EQUIP. LOCATION, BSMT. & FIRST FLOOR PLAN
9/1/1967	ELEC.	R4144-00001	AUDIO SYSTEM BLOCK DIAGRAM
6/1/1971	N/A	ENG 16-14-00001	TA-16 WALKWAY; TOPO BETWEEN BLDGS. 16-400 & 16-460
2/6/1981	GEN.	C43858-00001	CROSS CONNECTION CONTROL, GEN; SUBMITTALS, LOCATION PLAN, INDEX TO DRAWING
2/6/1981	CIVIL	C43858-00002	CROSS CONNECTION CONTROL, CIVIL; NOTES & LEGEND
2/6/1981	MECH.	C43858-00003	CROSS CONNECTION CONTROL, MECH; FIRST FLOOR PIPING PLAN LEGEND
2/6/1981	MECH.	C43858-00004	CROSS CONNECTION CONTROL, MECH; BASEMENT PIPING PLAN, SECTIONS AND DETAIL
2/6/1981	MECH.	C43858-00005	CROSS CONNECTION CONTROL, MECH; PIPING ISOMETRIC, SECTION & PARTIAL BASEMENT FLOOR PLAN
2/6/1981	MECH.	C43858-00006	CROSS CONNECTION CONTROL, MECH; NOTES & EQUIPMENT LIST
2/6/1981	ELEC.	C43858-00007	CROSS CONNECTION CONTROL, ELEC; NOTES, BILL OF MATERIAL, SCOPE OF WORK & NAMEPLATE SCHEDULE
2/6/1981	ELEC.	C43858-00008	CROSS CONNECTION CONTROL, ELEC; PARTIAL BASEMENT POWER LAYOUT AND POWER PANEL LP-9
9/6/1983	ARCH.	R2880-00001	BASEMENT & FIRST FLOOR PLAN, LABORATORY BLDG.
6/2/1986	MECH.	C44456-00001	DRAIN & AIR PIPING REPLACEMENT, MECH; DRAIN PIPING FLOOR PLAN, LOCATION PLAN & LEGEND
6/2/1986	MECH.	C44456-00002	DRAIN & AIR PIPING REPLACEMENT, MECH; AIR PIPING FLOOR PLAN DETAIL AND NOTES
11/8/1996	GEN.	C49876-00001	WASTE STREAM CORRECTIONS, FMU#70, TITLE SHEET AND INDEX TO DRAWINGS
11/8/1996	GEN.	C49876-00002	WASTE STREAM CORRECTIONS, FMU#70, GEN., LEGEND & NOTES
11/8/1996	GEN.	C49876-00003	WASTE STREAM CORRECTIONS, FMU#70, GEN., NOTES
11/8/1996	GEN.	C49876-00004	WASTE STREAM CORRECTIONS, FMU#70, GEN., NOTES AND SCOPE OF WORK
11/8/1996	GEN.	C49876-00005	WASTE STREAM CORRECTIONS, FMU#70, GEN., SUBMITTAL SCHEDULE
11/8/1996	CIVIL	C49876-00009	WASTE STREAM CORRECTIONS, FMU#70, CIVIL, SANITARY SEWER TIE IN & NOTES
11/8/1996	CIVIL	C49876-00010	WASTE STREAM CORRECTIONS, FMU#70, CIVIL, SANITARY SEWER TIE IN DETAILS
11/8/1996	GEN.	C49876-00016	WASTE STREAM CORRECTIONS, FMU#70, MECH., PLUMBING DETAILS, FLOOR DRAIN PLUG
11/8/1996	ELEC.	C49876-00017	WASTE STREAM CORRECTIONS, FMU#70, ELEC., SYMBOL LEGEND & NOTES

TA-16-460 DRAWING LIST

Date	Disc.	Drawing No.	Drawing Name
11/8/1996	MECH.	M49876-00020	WASTE STREAM CORRECTIONS, FMU#70, MECH., CORRECTIVE ACTION SUMMARY
1/3/2005	GEN.	C53336-00001	PARTIAL SITE WIDE FIRE ALARM SYSTEM REPLACEMENT PROJECT, FIRE PROTECTION, TITLE SHEET & INDEX TO DRAWINGS
1/3/2005	FIRE	C53336-00002	PARTIAL SITE WIDE FIRE ALARM SYSTEM REPLACEMENT PROJECT, FP; SYMBOLS LEGEND & NOTES
1/3/2005	FIRE	C53336-00003	PARTIAL SITE WIDE FIRE ALARM SYSTEM REPLACEMENT PROJECT, FP; BASEMENT FLOOR PLAN
1/3/2005	FIRE	C53336-00004	PARTIAL SITE WIDE FIRE ALARM SYSTEM REPLACEMENT PROJECT, FP; SECTION
1/3/2005	FIRE	C53336-00005	PARTIAL SITE WIDE FIRE ALARM SYSTEM REPLACEMENT PROJECT, FP; DETAILS
1/3/2005	FIRE	C53336-00006	PARTIAL SITE WIDE FIRE ALARM SYSTEM REPLACEMENT PROJECT, FP; FUNCTIONAL MATRIX
1/3/2005	FIRE	C53336-00007	PARTIAL SITE WIDE FIRE ALARM SYSTEM REPLACEMENT PROJECT, FP; WIRING DIAGRAM
1/3/2005	FIRE	C53336-00008	PARTIAL SITE WIDE FIRE ALARM SYSTEM REPLACEMENT PROJECT, FP; WIRING DIAGRAM
1/3/2005	FIRE	C53336-00009	PARTIAL SITE WIDE FIRE ALARM SYSTEM REPLACEMENT PROJECT, FP; BILL OF MATERIALS
1/3/2005	FIRE	C53336-00010	PARTIAL SITE WIDE FIRE ALARM SYSTEM REPLACEMENT PROJECT, FP; BATTERY & VOLTAGE DROP CALCULATIONS
1/3/2005	FIRE	C53336-00011	PARTIAL SITE WIDE FIRE ALARM SYSTEM REPLACEMENT PROJECT, FP; CONDUIT FILL CALCULATIONS
1/3/2005	ELEC.	C53336-00012	PARTIAL SITE WIDE FIRE ALARM SYSTEM REPLACEMENT PROJECT, ELEC; SYMBOLS LEGEND & NOTES
10/1/2013	MECH.	C16321-00052	MECHANICAL, SERVICE PIPING ROOMS 107 & 108, BLDG. 16-460
10/1/2013	MECH.	C16322-00053	MECHANICAL, SERVICE PIPING ROOM 109, BLDG. 16-460
10/1/2013	MECH.	C16323-00054	MECHANICAL, SERVICE PIPING ROOM 110, BLDG. 16-460
10/1/2013	MECH.	C16324-00055	MECHANICAL, SERVICE PIPING ROOM 113, BLDG. 16-460
10/1/2013	MECH.	C16325-00056	MECHANICAL, SERVICE PIPING ROOM 114, BLDG. 16-460
10/1/2013	MECH.	C16326-00057	MECHANICAL, SERVICE PIPING ROOM 115, BLDG. 16-460
10/1/2013	ELEC.	C16331-00062	ELECTRICAL, FIRST FLOOR LIGHTING AND POWER, ALYOUT I, BLDG. 16-460
10/1/2013	ELEC.	C16332-00063	ELECTRICAL, FIRST FLOOR LIGHTING AND POWER, LAYOUT II & DETAILS, BLDG. 16-460
10/1/2013	ELEC.	C16333-00064	ELECTRICAL, BASEMENT LIGHTING AND POWER LAYOUT, BLDG. 16-460
10/1/2013	ELEC.	C16334-00065	ELECTRICAL, LIGHTING AND POWER DETAILS - I BLDG. 16-460
10/1/2013	ELEC.	C16335-00066	ELECTRICAL, LIGHTING AND POWER DETAILS - II BLDG. 16-460
10/1/2013	ELEC.	C16336-00067	ELECTRICAL, EMERGENCY LIGHITN & DETAILS BLDG. 16-460
10/1/2013	ELEC.	C16337-00068	ELECTRICAL, CONTROL CENTER & WIRING DIAGRAM, BLDG. 16-460
10/1/2013	ELEC.	C16338-00069	ELECTRICAL, LIGHTNING PROTECTION AND GROUNDING DETAILS, BLDG. 16-460
10/1/2013	ELEC.	C16339-00070	ELECTRICAL, BASEMENT GROUNDING PLAN AND DETAILS, BLDG. 16-460
10/1/2013	GEN.	C21317-00001	MODIFICATIONS, BLDG. 16-460 - SUPPLY & EXHAUST SYSTEM, PLAN & DETAILS
10/1/2013	GEN.	C22897-00001	BLDG. 460, GROUP 141 LOS ALAMOS, NM - MINNEAPOLIS-HONEYWELL REG. CO. AIR COND. C

TA-16-460 DRAWING LIST

Date	Disc.	Drawing No.	Drawing Name
10/1/2013	GEN.	C22898-00001	MINNEAPOLIS - HONEYWELL REG. CO. AIR COND. CONTROL OPERATONS
10/1/2013	GEN.	C22899-00001	BLDG. 460, GROUP-141 - MINNEAPOLIS - HONEYWELL REG. CO. AIR COND. CONTROL OPERAT
10/1/2013	GEN.	C27564-00001	HOOD REPLACEMENT, ROOM 101, BLDG. 16-460, PLAN AND DETAILS
10/1/2013	ELEC.	C27565-00002	HOOD REPLACEMENT, ROOM 101, BLDG. 16-460, ELECTRICAL - PLAN
10/1/2013	GEN.	C27855-00001	AIR CONDITIONING, ROOM 102, BLDG. 16-460, PLAN
10/1/2013	GEN.	C27856-00002	AIR CONDITIONING, ROOM 102, BLDG. 16-460, MECHANICAL PLAN, SECTIONS & DETAILS
10/1/2013	GEN.	C27857-00003	AIR CONDITIONING, ROOM 102, BLDG. 16-460, MECHANICAL - NOTES & EQUIPMENT LIST
10/1/2013	GEN.	C27858-00004	AIR CONDITIONING, ROOM 102, BLDG. 16-460, ELECTRICAL
10/1/2013	GEN.	C2982-00001	ALTS. TO AIR COND., SYS. BLDG. 16-460, EXIST, AIR COND. PLAN
10/1/2013	GEN.	C2983-00002	ALTS TO AIR COND. SYS., BLDG. 16-460, MOD. AIR COND. PLAN
10/1/2013	GEN.	C2984-00003	ALTS. TO AIR COND. SYS., BLDG. 16-460, MECH. SECTIONS AND DETAILS
10/1/2013	GEN.	C2985-00004	ALTS. TO AIR COND. SYS., BLDG. 16-460, BSMT. PLAN, SECTION AND DETAILS
10/1/2013	GEN.	C2986-00005	ALTS. TO AIR COND. SYS. BLDG., 16-460, PNEU. CONTROL DIAGRAM EQUIP. SCHEDULE
10/1/2013	GEN.	C2987-00006	ALTS. TO AIR COND. SYS., BLDG. 16-460, PNEU. CONTROL DIAGRAM EQUIP. SCHEDULE
10/1/2013	ARCH.	C43405-00001	STORAGE CUBICLE, BLDG. 16-430, TA-16 ARCH; LOCATION, PLOT, FOUNDATION, AND FLO
10/1/2013	ARCH.	C43405-00002	ARCH; ELEVATIONS, SECTIONS AND DETAILS
10/1/2013	ARCH.	C43405-00003	ARCH; SECTIONS AND DETAILS
10/1/2013	FIRE	C43405-00004	MECH; FIRE PROT. PLAN, DETAILS AND NOTES
10/1/2013	ELEC.	C43405-00005	ELEC; PLOT PLAN, LIGHTNING PROTECTION, NOTES, BILL OF MATERIAL AND NAMEPLATES
10/1/2013	ARCH.	C48520-00004	LOT-2-TA-16-460, ROOF PLAN-EXISTING FEATURES SITE PLAN, SECTIONS

TA-16-463 DRAWING LIST

Date	Disc.	Drawing No.	Drawing Name
11/14/1961	ELEC.	ENG.5450	NEW MAGAZINE ELECTRICAL- PLAN
11/14/1961	ELEC.	ENG.5451	NEW MAGAZINE GROUNDING SYSTEM AND ONE-LINE DIAGRAM
06/10/1966	ARCH.	ENG.R-575	FLOOR PLAN

LA-UR-23-20661
February 2023

Historical Documentation of Buildings 0460 and 0463 at Technical Area 16

Volume 2

Los Alamos National Laboratory

LANL Fiscal Year 2022 Footprint Reduction

Historic Building Report No. 405

Survey No. 1242

NMCRIS Activity No. 151891

Los Alamos National Laboratory Historic Building Survey
Index to Photographs

Technical Area 16 Analytical Chemistry Buildings
Technical Area 16, Buildings (460 and 463)
Los Alamos National Laboratory (LANL)
Los Alamos
Los Alamos County
New Mexico

Notes: The Laboratory is divided into different geographic areas called Technical Areas (TAs). These TAs are designated by numbers. The properties at TA-16 Analytical Chemistry Complex are identified using the current LANL system of placing the “TA” prefix and TA number before each building and structure number, creating a unique property identifier (ie. TA-16-460).

The Analytical Chemistry Complex consisted of one main laboratory building TA-16-460, a chemical storage building TA-16-462, and a rest house TA-16-463, used for temporary storage of explosives that were being analyzed/tested/studied.

Two of the building (TA-16-460 and -463) were previously declared eligible for the National Register of Historic Places (Register) in correspondence from the State Historic Preservation Office (SHPO) to the Department of Energy (DOE) dated August 18, 1995. Building TA-16-462 was previously evaluated as not eligible in correspondence from the SHPO to the DOE dated June 22, 2003.

These buildings were excess LANL properties and were scheduled for clean up and eventual demolition. This action is in accordance with LANL’s commitment to clean up inactive sites and facilities “so that no unacceptable risk to the public or environment remains” (U.S. Department of Energy 1994). The removal of these two properties was carried out by LANL’s Decontamination and Decommissioning (D&D) Program. **(For additional eligibility information see related project documentation: 1) *TA-16 Heating System Replacement*, LA-CP-95-180, Cultural Resource Survey Report No. 114, Los Alamos National Laboratory and 2) *Historical Documentation of the Buildings 0460 and 0463 at Technical Area 16*, LA-UR-23-20661, Historic Building Survey report No. 405, Los Alamos National Laboratory.)**

Note: After funding was received in 2019 for the D&D of these properties and prior to being able to conduct the interior photography of the buildings a portion of the roofing system failed, hence the deteriorated state of some of the rooms.

Los Alamos National Laboratory Historic Building Survey
Index to Photographs

References

U.S. Department of Energy

1994 Environmental Restoration and Waste Management Five-Year Plan Fiscal Years
1994-1998. DOE/S-00097P, U.S. Department of Energy, Washington, D.C.

Los Alamos National Laboratory Historic Building Survey
Index to Photographs

Technical Area 16 Analytical Chemistry Buildings
Technical Area 16, Building 460
Los Alamos National Laboratory (LANL)
Los Alamos
Los Alamos County
New Mexico

Sandra Valdez, Photographer, Photographer, LANL
di190210001 through di190210018 June 10, 2019
di190453001 through di190453012 November 12 & 13, 2019
UI-202000708-123-001 through UI-202000708-123-067 June 24, 2020

<u>Photograph Number</u>	<u>Description</u>
di190453005	TA-16-460, southwest side (front), facing northeast.
di190453006	TA-16-460, northwest side, facing southeast.
di190453007	TA-16-460, northeast (back) and northwest sides, facing south.
di190453009	TA-16-460, northeast (back) and northwest sides, facing south.
di190453008	TA-16-460, northeast side (back), facing southwest.
di190453010	TA-16-460, southeast and northeast (back) sides, facing west.
di190453011	TA-16-460, southeast side, facing northwest.
UI-20200708-123-002	TA-16-460, from entrance hallway 100, looking into hallway 100B, hallway 100A runs perpendicular across lower front of photo, facing northeast.
UI-20200708-123-048	TA-16-460, hallway 100A, facing southeast.
UI-20200708-123-047	TA-16-460, hallway 100A, facing northwest.
UI-20200708-123-053	TA-16-460, room 101, workbenches and fume hoods, facing north.
UI-20200708-123-054	TA-16-460, room 101, workbenches and fume hoods, facing west.
UI-20200708-123-055	TA-16-460, room 101, workbenches and fume hoods, facing south.

Los Alamos National Laboratory Historic Building Survey
Index to Photographs

Technical Area 16 Analytical Chemistry Buildings
Technical Area 16, Buildings 460 continued
Los Alamos National Laboratory (LANL)
Los Alamos
Los Alamos County
New Mexico

Photograph

<u>Number</u>	<u>Description</u>
UI-20200708-123-057	TA-16-460, room 101, workbenches and fume hoods, facing east.
UI-20200708-123-058	TA-16-460, room 101, workbench, facing northeast.
UI-20200708-123-019	TA-16-460, room 102, workbenches, level table, facing northeast.
UI-20200708-123-020	TA-16-460, room 103, work tables, facing east.
UI-20200708-123-021	TA-16-460, room 103, work tables, facing north, northeast.
UI-20200708-123-004	TA-16-460, room 104, facing north.
UI-20200708-123-027	TA-16-460, room 105, workbenches, oven, facing northeast. Steam Oven (No. 4T-135) Precision Scientific Co. Made in U.S.A. Chicago, Illinois, 1962 Model 962 AEC Property No. 137193
UI-20200708-123-049	TA-16-460, room 105, workbenches, facing south.
UI-20200708-123-032	TA-16-460, room 106, workbenches, facing northeast.
UI-20200708-123-033	TA-16-460, room 106, workbenches, facing north.
UI-20200708-123-038	TA-16-460, hallway between room 107 and 108, facing northeast. Control switches on wall outside of room 107 (left side of photo) and electrical control panels on wall outside of room 108 (right side of photo).
UI-20200708-123-039	TA-16-460, room 107, fume hood and workbench, facing west.

Los Alamos National Laboratory Historic Building Survey
Index to Photographs

Technical Area 16 Analytical Chemistry Buildings
Technical Area 16, Building 460 continued
Los Alamos National Laboratory (LANL)
Los Alamos
Los Alamos County
New Mexico

Photograph

<u>Number</u>	<u>Description</u>
UI-20200708-123-042	TA-16-460, room 107, fume hood and work bench, facing southwest.
UI-20200708-123-041	TA-16-460, room 107, fume hood, facing south.
UI-20200708-123-044	TA-16-460, room 108, fume hood, facing southwest.
UI-20200708-123-045	TA-16-460, room 108, fume hood, facing south.
UI-20200708-123-015	TA-16-460, room 109, workbenches, facing southwest.
UI-20200708-123-013	TA-16-460, room 110, workbenches, fume hood, safety shower (yellow marking on floor), facing southwest.
UI-20200708-123-017	TA-16-460, room 110, workbenches, fume hood, safety shower (yellow marking on floor), facing south.
UI-20200708-123-005	TA-16-460, room 111, shelving along southeast wall, facing southwest.
UI-20200708-123-024	TA-16-460, room 112, facing southwest.
UI-20200708-123-025	TA-16-460, room 112, work tables and dumb waiter, facing southwest.
UI-20200708-123-030	TA-16-460, room 113, workbench and oven, facing southwest.
UI-20200708-123-035	TA-16-460, room 114, workbenches, safety shower (yellow marking on floor), facing southwest.
UI-20200708-123-037	TA-16-460, room 115, workbenches and fume hoods, facing southwest.
UI-20200708-123-059	TA-16-460, stairwell 1, looking down to basement, facing southwest.

Los Alamos National Laboratory Historic Building Survey
Index to Photographs

Technical Area 16 Analytical Chemistry Buildings
Technical Area 16, Building 460 continued
Los Alamos National Laboratory (LANL)
Los Alamos
Los Alamos County
New Mexico

Photograph

<u>Number</u>	<u>Description</u>
UI-20200708-123-062	TA-16-460, basement room 1, facing northwest.
UI-20200708-123-063	TA-16-460, basement room 1, looking down hallway 10, facing northwest.
UI-20200708-123-060	TA-16-460, basement room 2, dumb waiter at right side of photo, facing south.
UI-20200708-123-061	TA-16-460, basement room 2, dumb water at center of photo, facing west.
UI-20200708-123-066	TA-16-460, basement room 6, equipment room, facing north.
UI-20200708-123-067	TA-16-460, basement room 6, equipment room, facing east.
UI-20200708-123-065	TA-16-460, basement hallway 10, facing southeast.

Los Alamos National Laboratory Historic Building Survey
Index to Photographs

Technical Area 16 Analytical Chemistry Buildings
Technical Area 16, Building 463
Los Alamos National Laboratory (LANL)
Los Alamos
Los Alamos County
New Mexico

<u>Photograph Number</u>	<u>Description</u>
di190210001	TA-16-463, southwest side, facing northeast. Steel, earthen filled barricade.
di190210002	TA-16-463, southwest side, facing east. Steel, earthen filled barricade.
di190210010	TA-16-463, southeast side, facing northwest. Steel, earthen filled barricade.
di190210005	TA-16-463, northwest side, facing, southeast.
di190210004	TA-16-463, northeast side, facing southwest.
di190210017	TA-16-463, room 100, facing northeast.



di190453005



di190453006



di190453007



di190453009



DANGER
HAZARDOUS AREA
DURING OPERATING
HOURS NOTIFY LEAD
OPERATOR BEFORE
ENTERING THIS AREA

di190453008



di190453010



di190453011




**SAFETY
FIRST**
EYE PROTECTION
REQUIRED IN THIS AREA

This office is approved for
UNCLASSIFIED computing only
No classified computer media are allowed in this office

No Food or Drinks

Lab Safety Procedures List

**SAFETY
FIRST**
EYE PROTECTION
REQUIRED IN THIS AREA

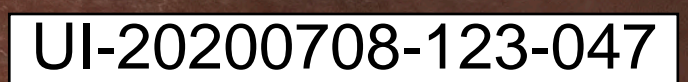





FOR SAFE EXHAUST
OPEN ONLY THREE
SLITS AT ONE TIME









UI-20200708-123-019





UI-20200708-123-021



UI-202007080123-004







UI-20200708-123-032







RM 107 →

#6
4.8
859

#7

A.S

817

DO NOT USE

#30
4.8/103

#19
4.6/1039

#20
4.5/818











NOTICE
THIS DRAIN IS FOR
SANITARY WASTEWATER
ONLY
NO CHEMICALS OR SOLIDS SHOULD
BE DOWN THIS DRAIN







135

112

#25
4.8
/ 6.75



1



UI-20200708-123-025









111

11-20

#11 46/735

















di190210001



di190210002



di190210010



di190210005



di190210004



di190210013



di190210017