


LATA-Sharp Remediation Services, Inc.		AS-BUILT WELL CONSTRUCTION DIAGRAM LANL Well R-37 TA-54 Los Alamos, New Mexico	FIGURE
Drawn By: J. Marin	Date: July, 2009		4.2-1
Project No.: 22851-009-08	Filename: R-37_Figure 4.2-1		
Scale: not-to-scale	Revision: 1		

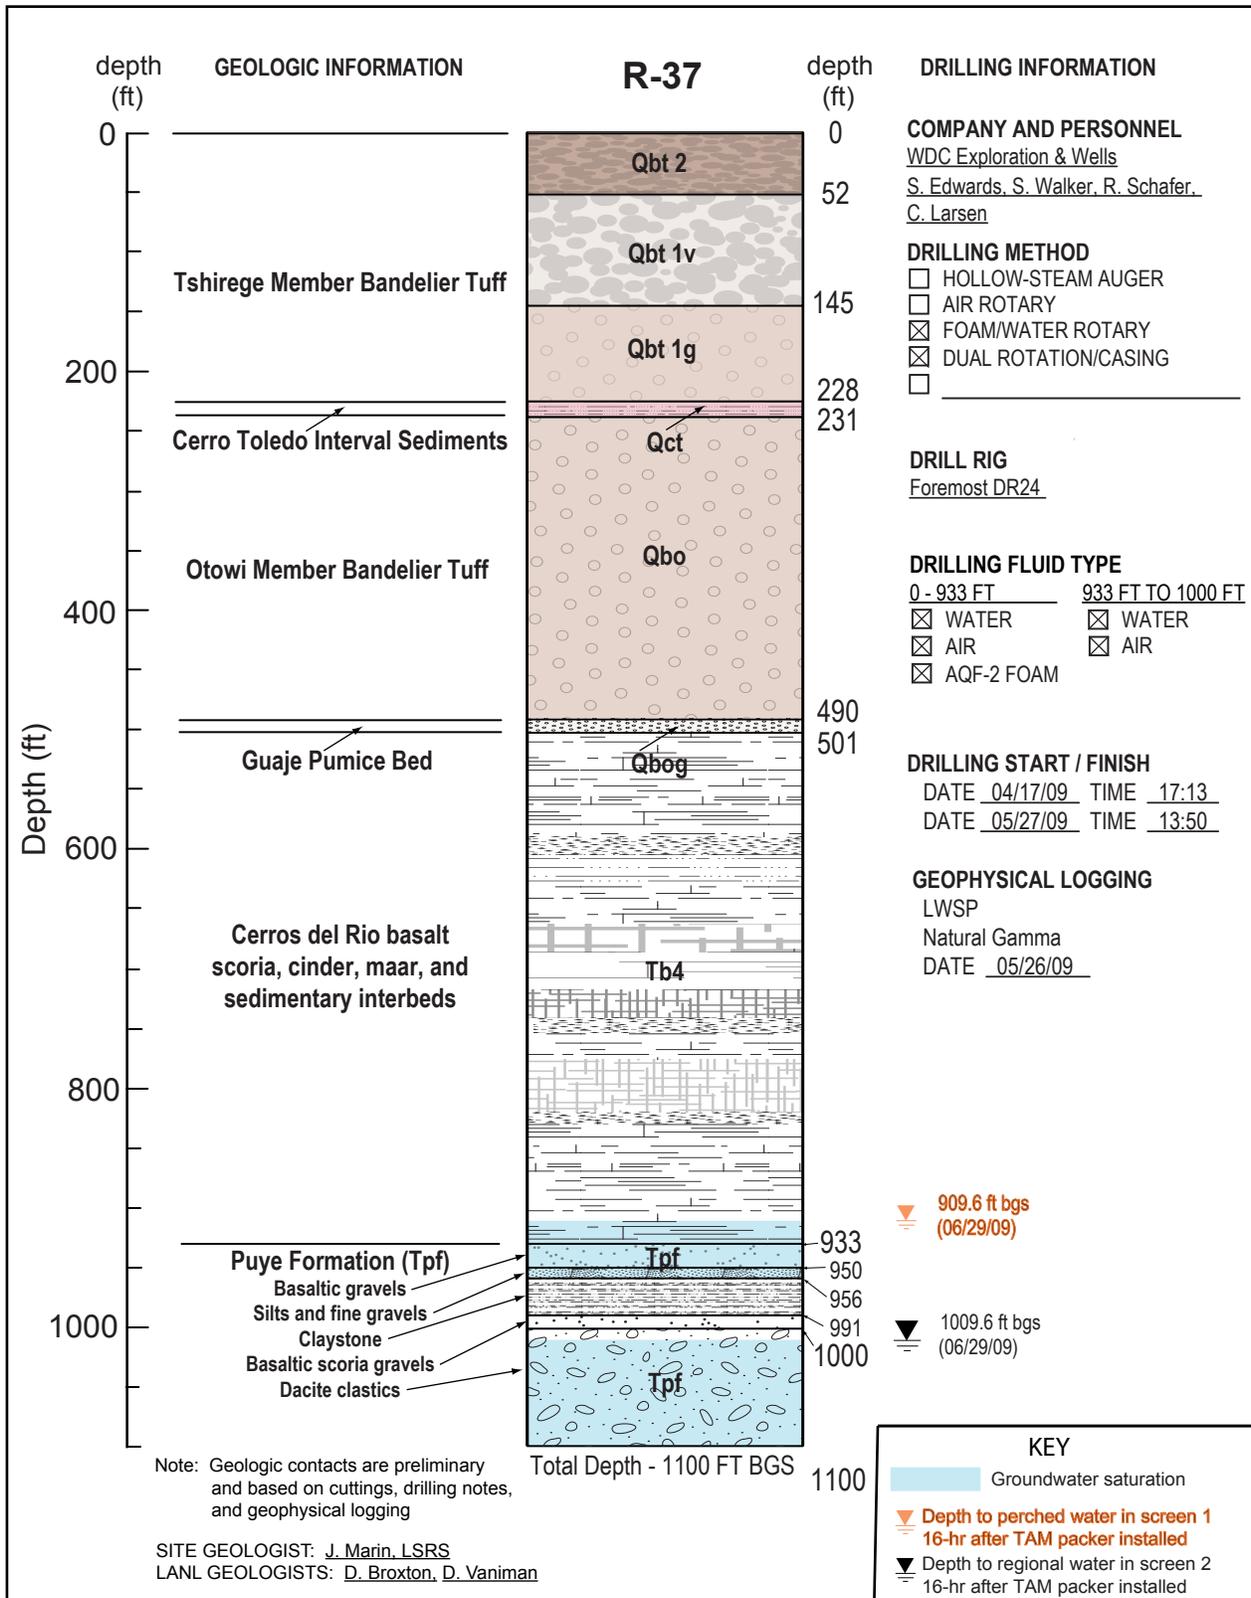

LATA-Sharp Remediation Services, Inc.		BOREHOLE SUMMARY DATA SHEET Borehole Stratigraphy LANL Well R-37 TA-54 Los Alamos, New Mexico		FIGURE 3.1-1
Drawn By: J. Marin	Date: July, 2009			
Project No.: 22851-009-08	Filename: R-37_Figure 3.1-1			
Scale: not-to-scale	Revision: 1			