
ERID-204335

Los Alamos
NATIONAL LABORATORY
EST. 1943

Environmental Programs
P.O. Box 1663, MS M991
Los Alamos, New Mexico 87545
(505) 606-2337/FAX (505) 665-1812

National Nuclear Security Administration
Los Alamos Site Office, MS A316
Environmental Restoration Program
Los Alamos, New Mexico 87544
(505) 667-4255/FAX (505) 606-2132

Date: JUN 0 9 2011
Refer To: EP2011-0213

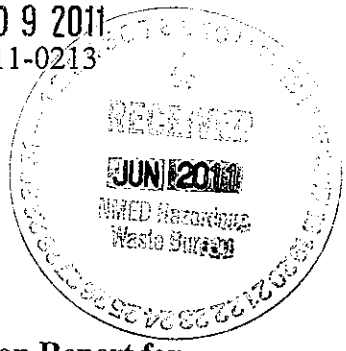

John Kieling, Acting Bureau Chief
Hazardous Waste Bureau
New Mexico Environment Department
2905 Rodeo Park Drive East, Building 1
Santa Fe, NM 87505-6303

Subject: Submittal of the Replacement Figures and Plates for the Investigation Report for the Upper Los Alamos Canyon Aggregate Area, Revision 1

Dear Mr. Kieling:

Enclosed please find two hard copies with electronic files of the replacement figures and plates for the Investigation Report for the Upper Los Alamos Canyon Aggregate Area, Revision 1. Los Alamos National Laboratory (the Laboratory) recently discovered that sampling locations presented on some of the figures and plates in the report reflected the "as planned" locations rather than the "as collected" locations. In the case of solid waste management units (SWMUs) that impact drainages, it is common to determine sampling locations geomorphically in the field during sampling activities to ensure sediment or other environmental media that have the highest chance of being impacted by runoff from the site are collected. In the case of SWMUs 01-001(f) and 01-003(a), samples were collected in sediment deposits within the drainage and resurveyed following collection. However, in both cases, some of the figures presented in the investigation report still reflected the sampling locations as they were presented in the Investigation Work Plan for Upper Los Alamos Canyon Aggregate Area rather than the surveyed actual locations.

The conclusions presented in the investigation report for SWMUs 01-001(f) and 01-003(a) are not impacted by the incorrect locations presented on the figures and plates. Both sites were proposed for additional sampling because the lateral and vertical extent of all contaminants of potential concern had not been defined following initial investigation sampling. Proposed Phase II sampling activities include collecting samples from deeper depths at selected existing locations and from new locations farther downgradient of existing locations. In addition, removal actions are ongoing at SWMU 01-001(f) and are proposed at SWMU 01-003(a). These locations are identified in the field using the coordinates in the Environmental Restoration Database, which are correct, and not the figures in the investigation report or the Phase II Investigation Work Plan for Upper Los Alamos Canyon Aggregate Area. The Phase II investigation work plan also presents incorrect sampling location information in figures for SWMUs 01-001(f) and 01-003(a), and the Laboratory will provide replacement pages in a separate submittal.

The Laboratory regrets this error. If you have any questions, please contact Becky Coel-Roback at (505) 665-5011 (becky_cr@lanl.gov) or Cheryl Rodriguez at (505) 665-5330 (crodriguez2@doeal.gov).

Sincerely,

Michael J. Graham, Associate Director
Environmental Programs
Los Alamos National Laboratory

Sincerely,

George J. Rael, Assistant Manager
Environmental Projects Office
Los Alamos Site Office

MG/GR/DM/BCR:sm

Enclosures: Two hard copies with electronic files – Replacement Figures and Plates for the Investigation Report for the Upper Los Alamos Canyon Aggregate Area, Revision 1 (LA-UR-10-0422)

Cy: (w/enc.)
Neil Weber, San Ildefonso Pueblo
Cheryl Rodriguez, DOE-LASO, MS A316
Becky Coel-Roback, EP-CAP, MS M992
RPF, MS M707 (electronic)
Public Reading Room, MS M992 (hard copy)

Cy: (Letter and CD and/or DVD)
Laurie King, EPA Region 6, Dallas, TX
Steve Yanicak, NMED-DOE-OB, MS M894
Dave Davenport, LATA, Los Alamos, NM (MS Word files on CD)
William Alexander, EP-BPS, MS M992

Cy: (w/o enc.)
Tom Skibitski, NMED-OB, Santa Fe, NM (date-stamped letter emailed)
Annette Russell, DOE-LASO (date-stamped letter emailed)
Dave McInroy, EP-CAP, MS M992 (date-stamped letter emailed)
Michael J. Graham, ADEP, MS M991 (date-stamped letter emailed)


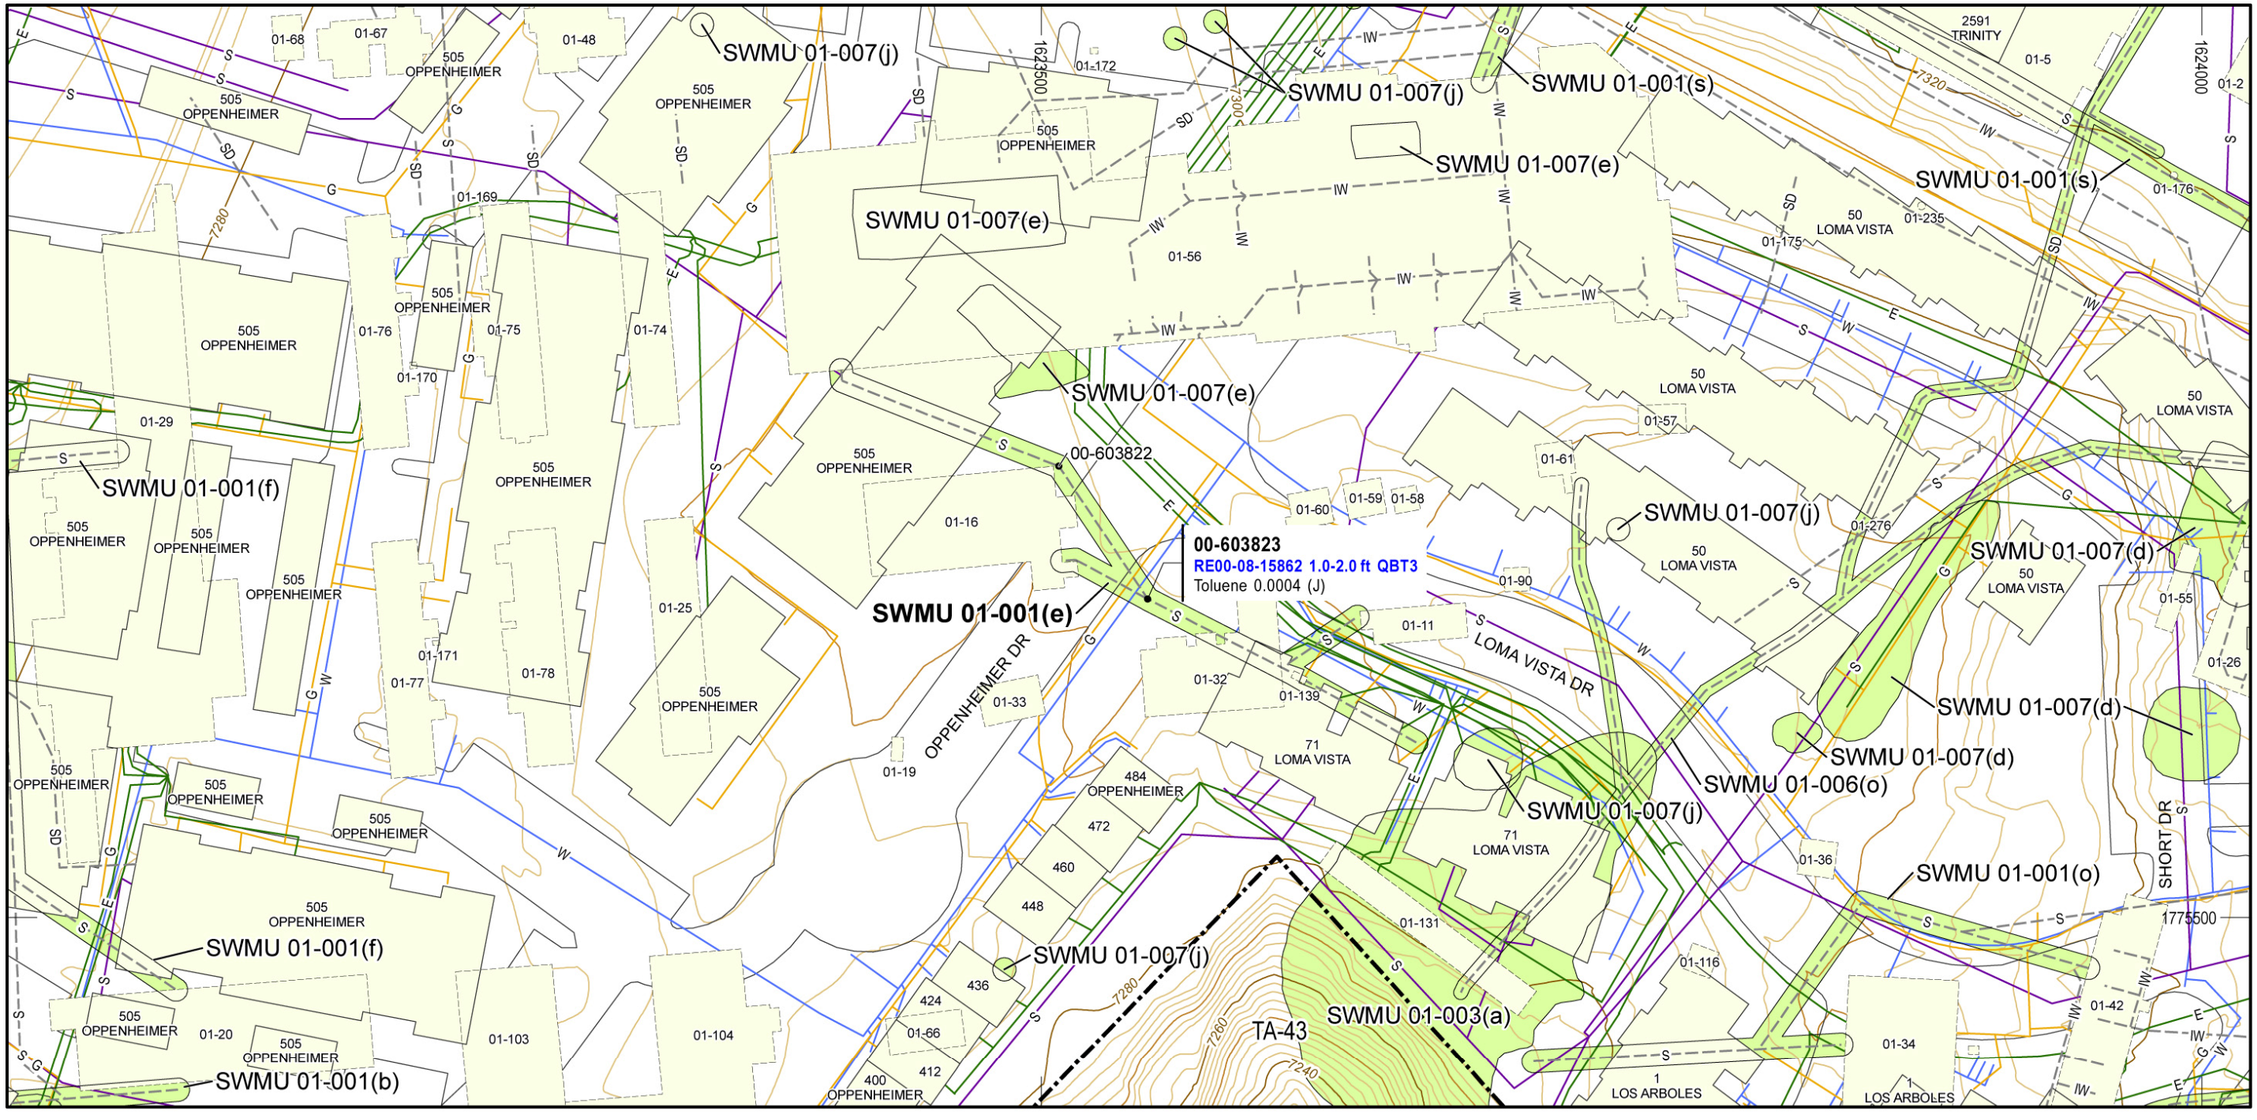


Figure 6.7-3 Organic COPCs detected at SWMU 01-001(e)

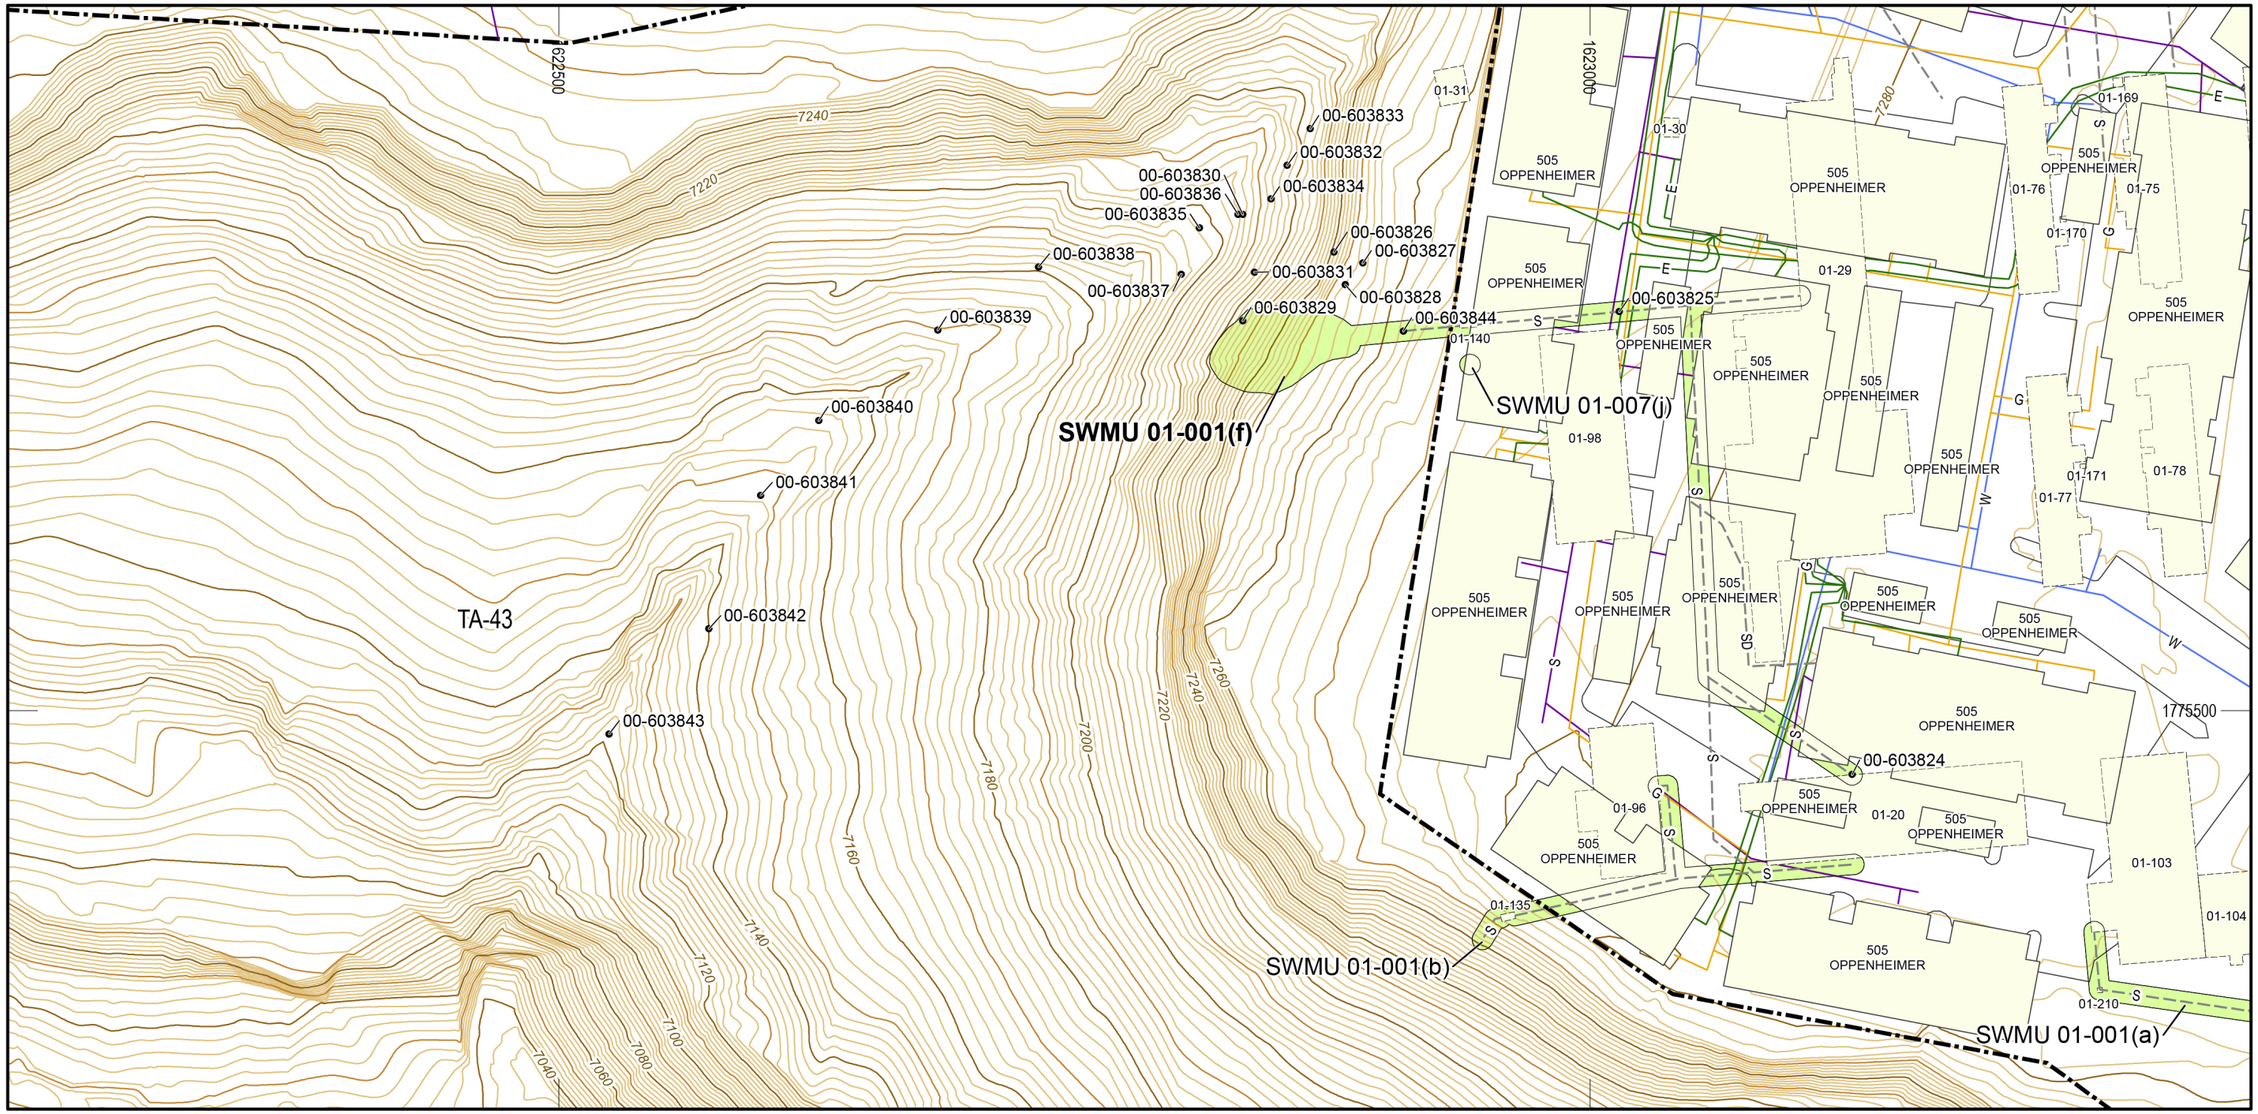

Sampled location
SWMU or AOC
Structure or building
Former structure
Former drain line
Former industrial waste
Former sewer
Former storm drain
Technical Area (TA) boundary
Fence
Paved road
Dirt road
Elevation contours
100- and 20-ft contour
10-ft contour
2-ft contour
Electric
Gas
Sewer
Water

50 0 50
FEET
State Plane Coordinate System
New Mexico, Central Zone, US Survey Feet
North American Datum 1983
National Geodetic Vertical Datum 1929

Los Alamos Technical Associates (LATA-LAO)
MAP ULA09-IR-11R2 20 August 2009 PLANNERER

Figure 6.8-1 SWMU 01-001(f) site map and sampling locations

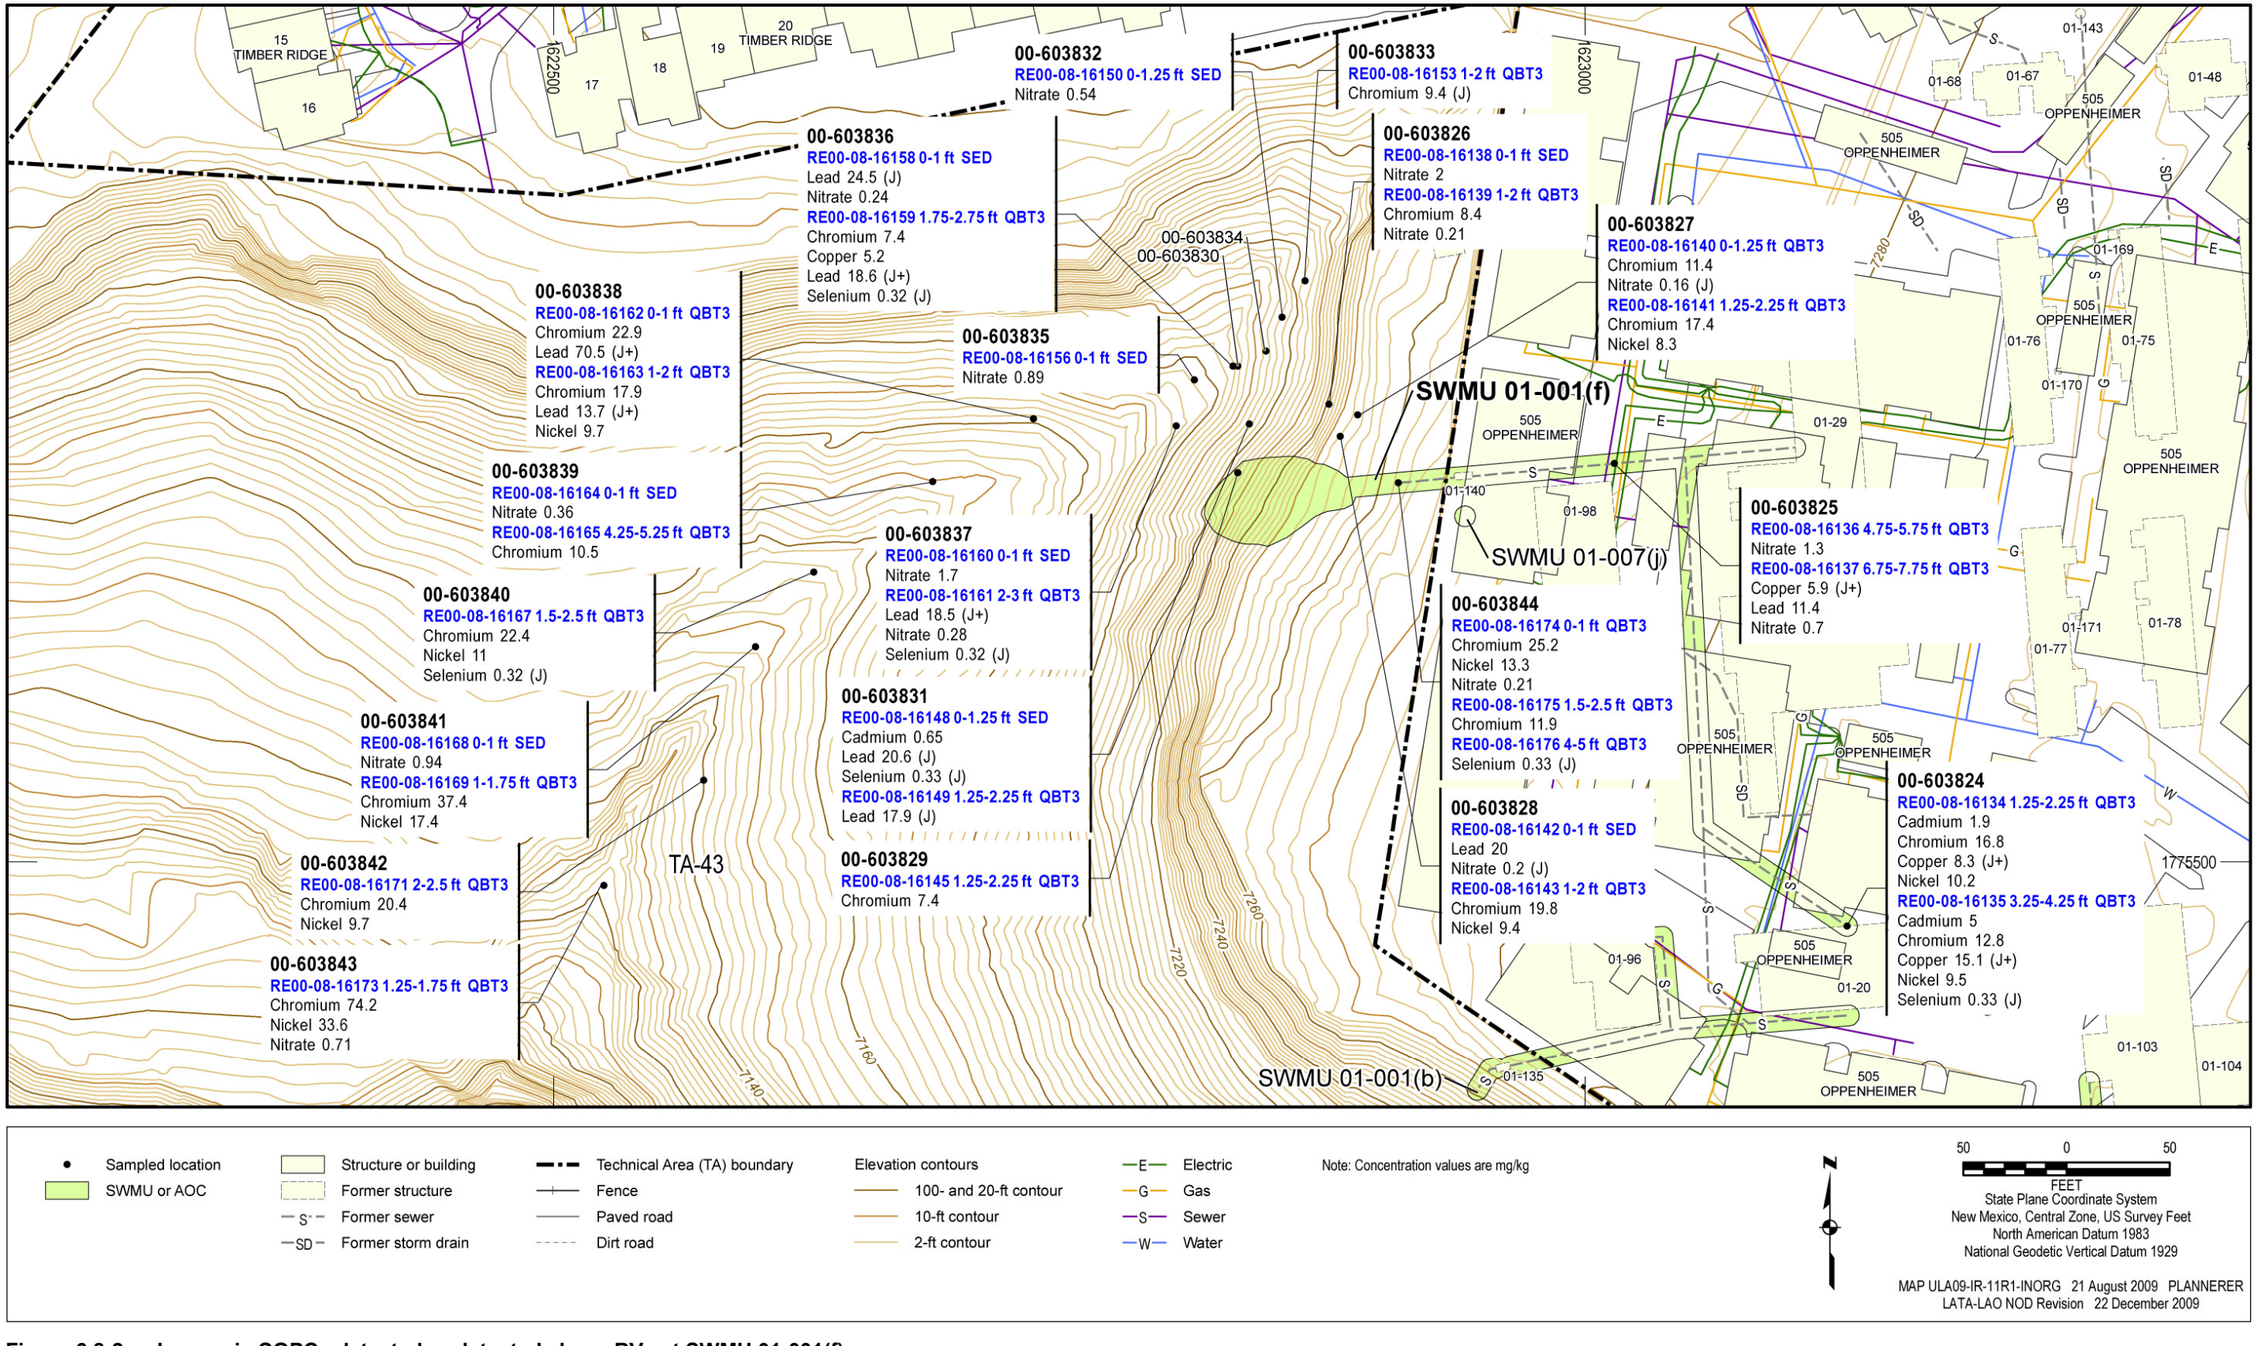


Figure 6.8-2 Inorganic COPCs detected or detected above BVs at SWMU 01-001(f)


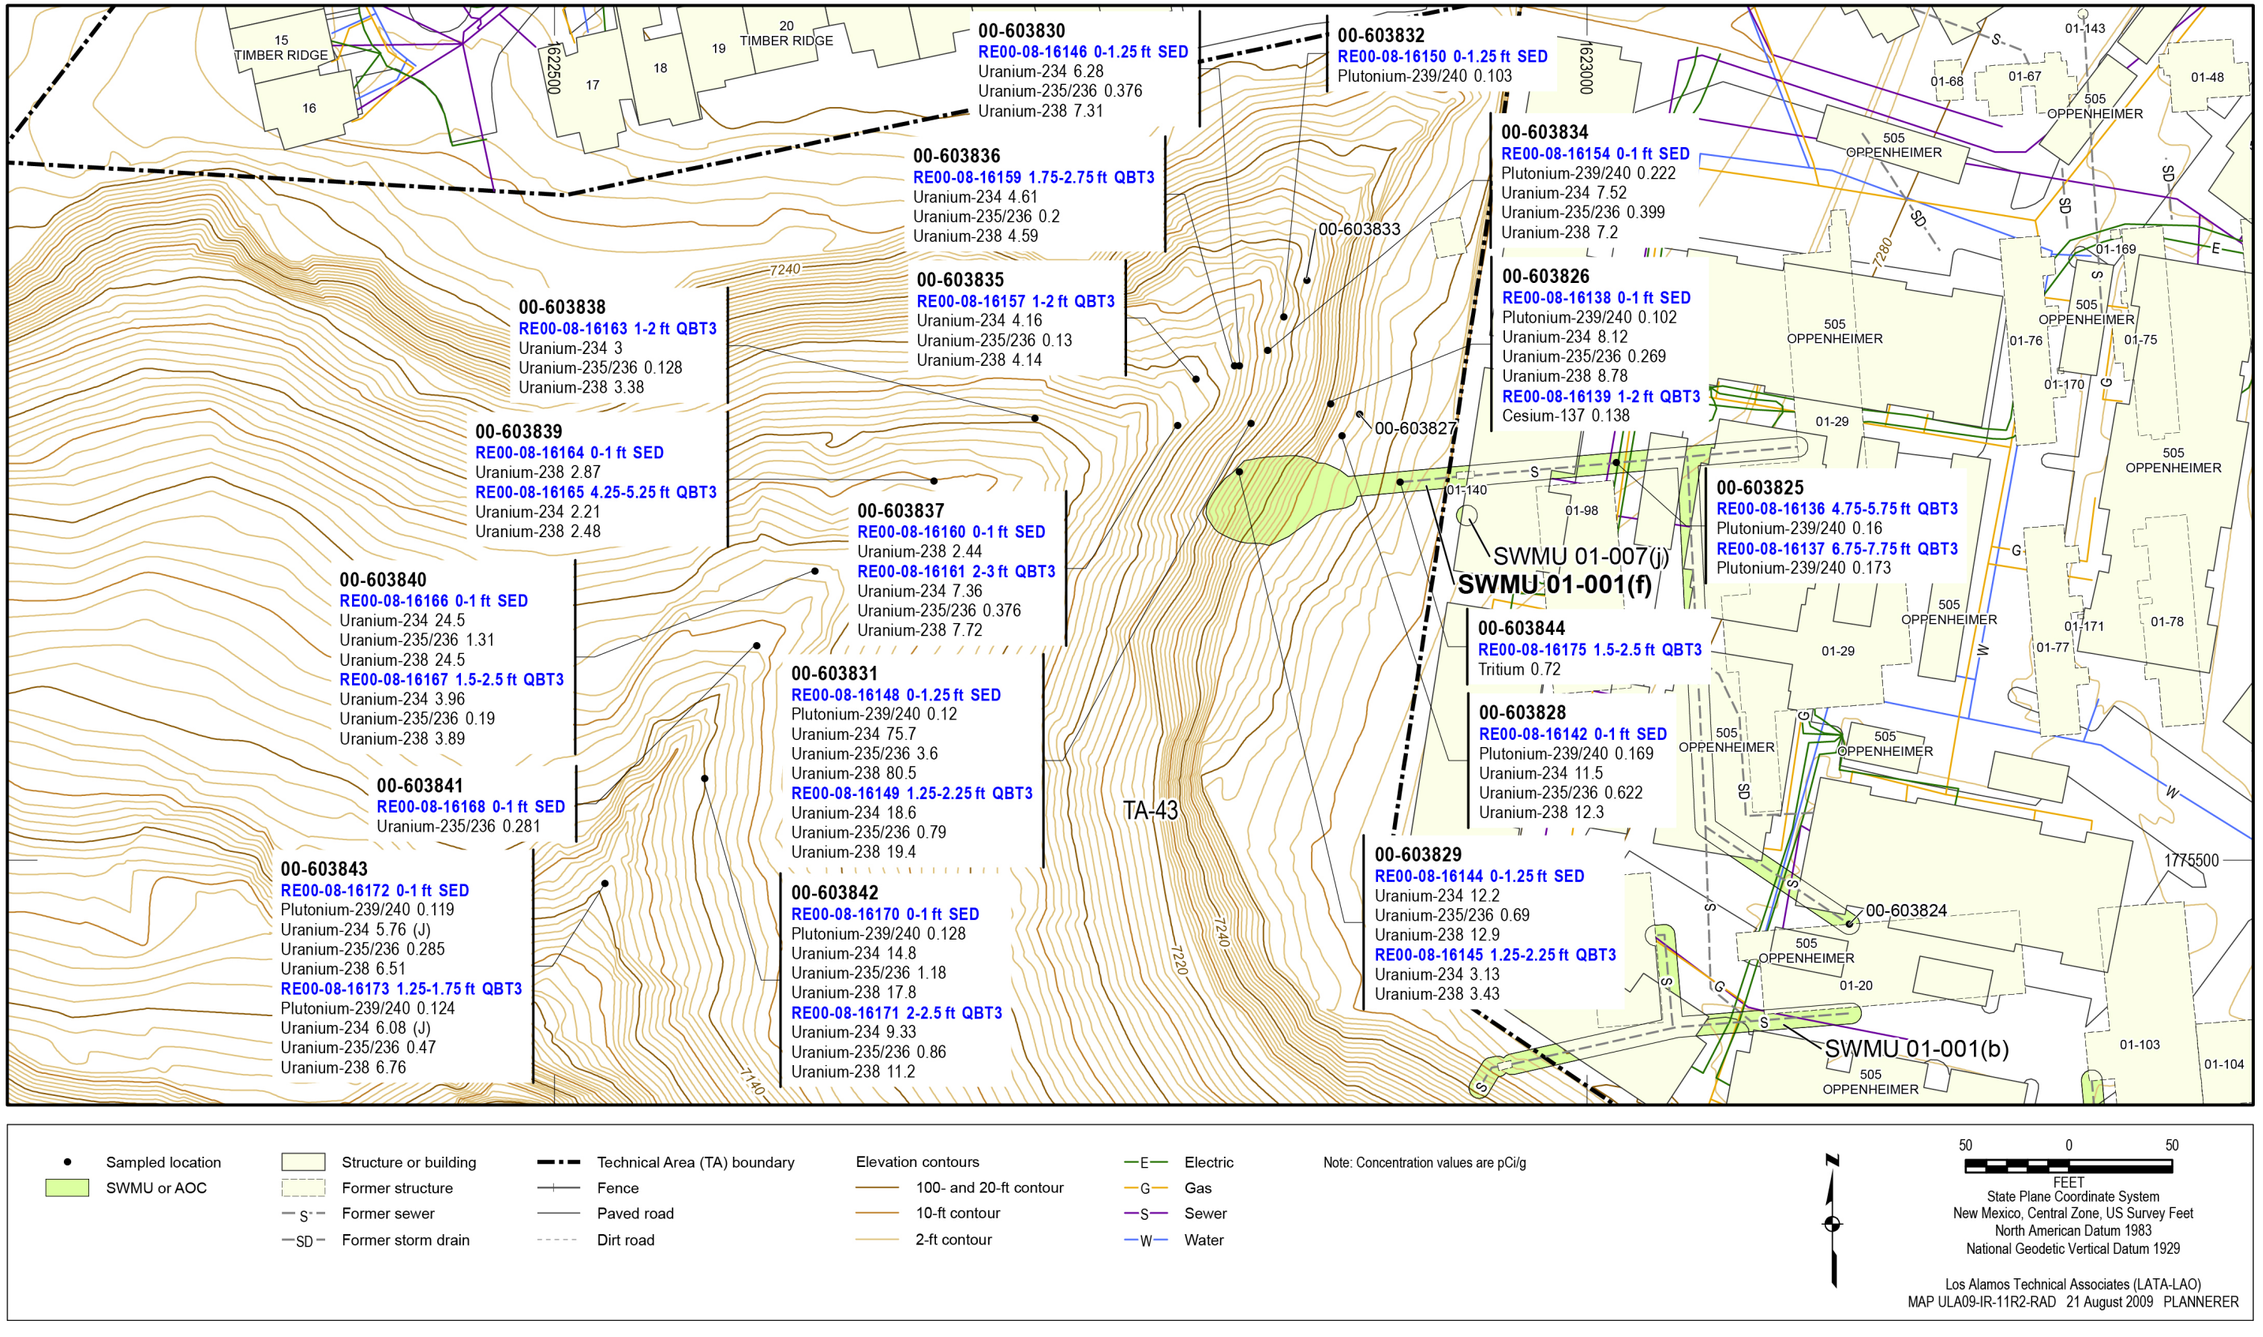


Figure 6.8-3 Radionuclide COPCs detected or detected above BVs/FVs at SWMU 01-001(f)

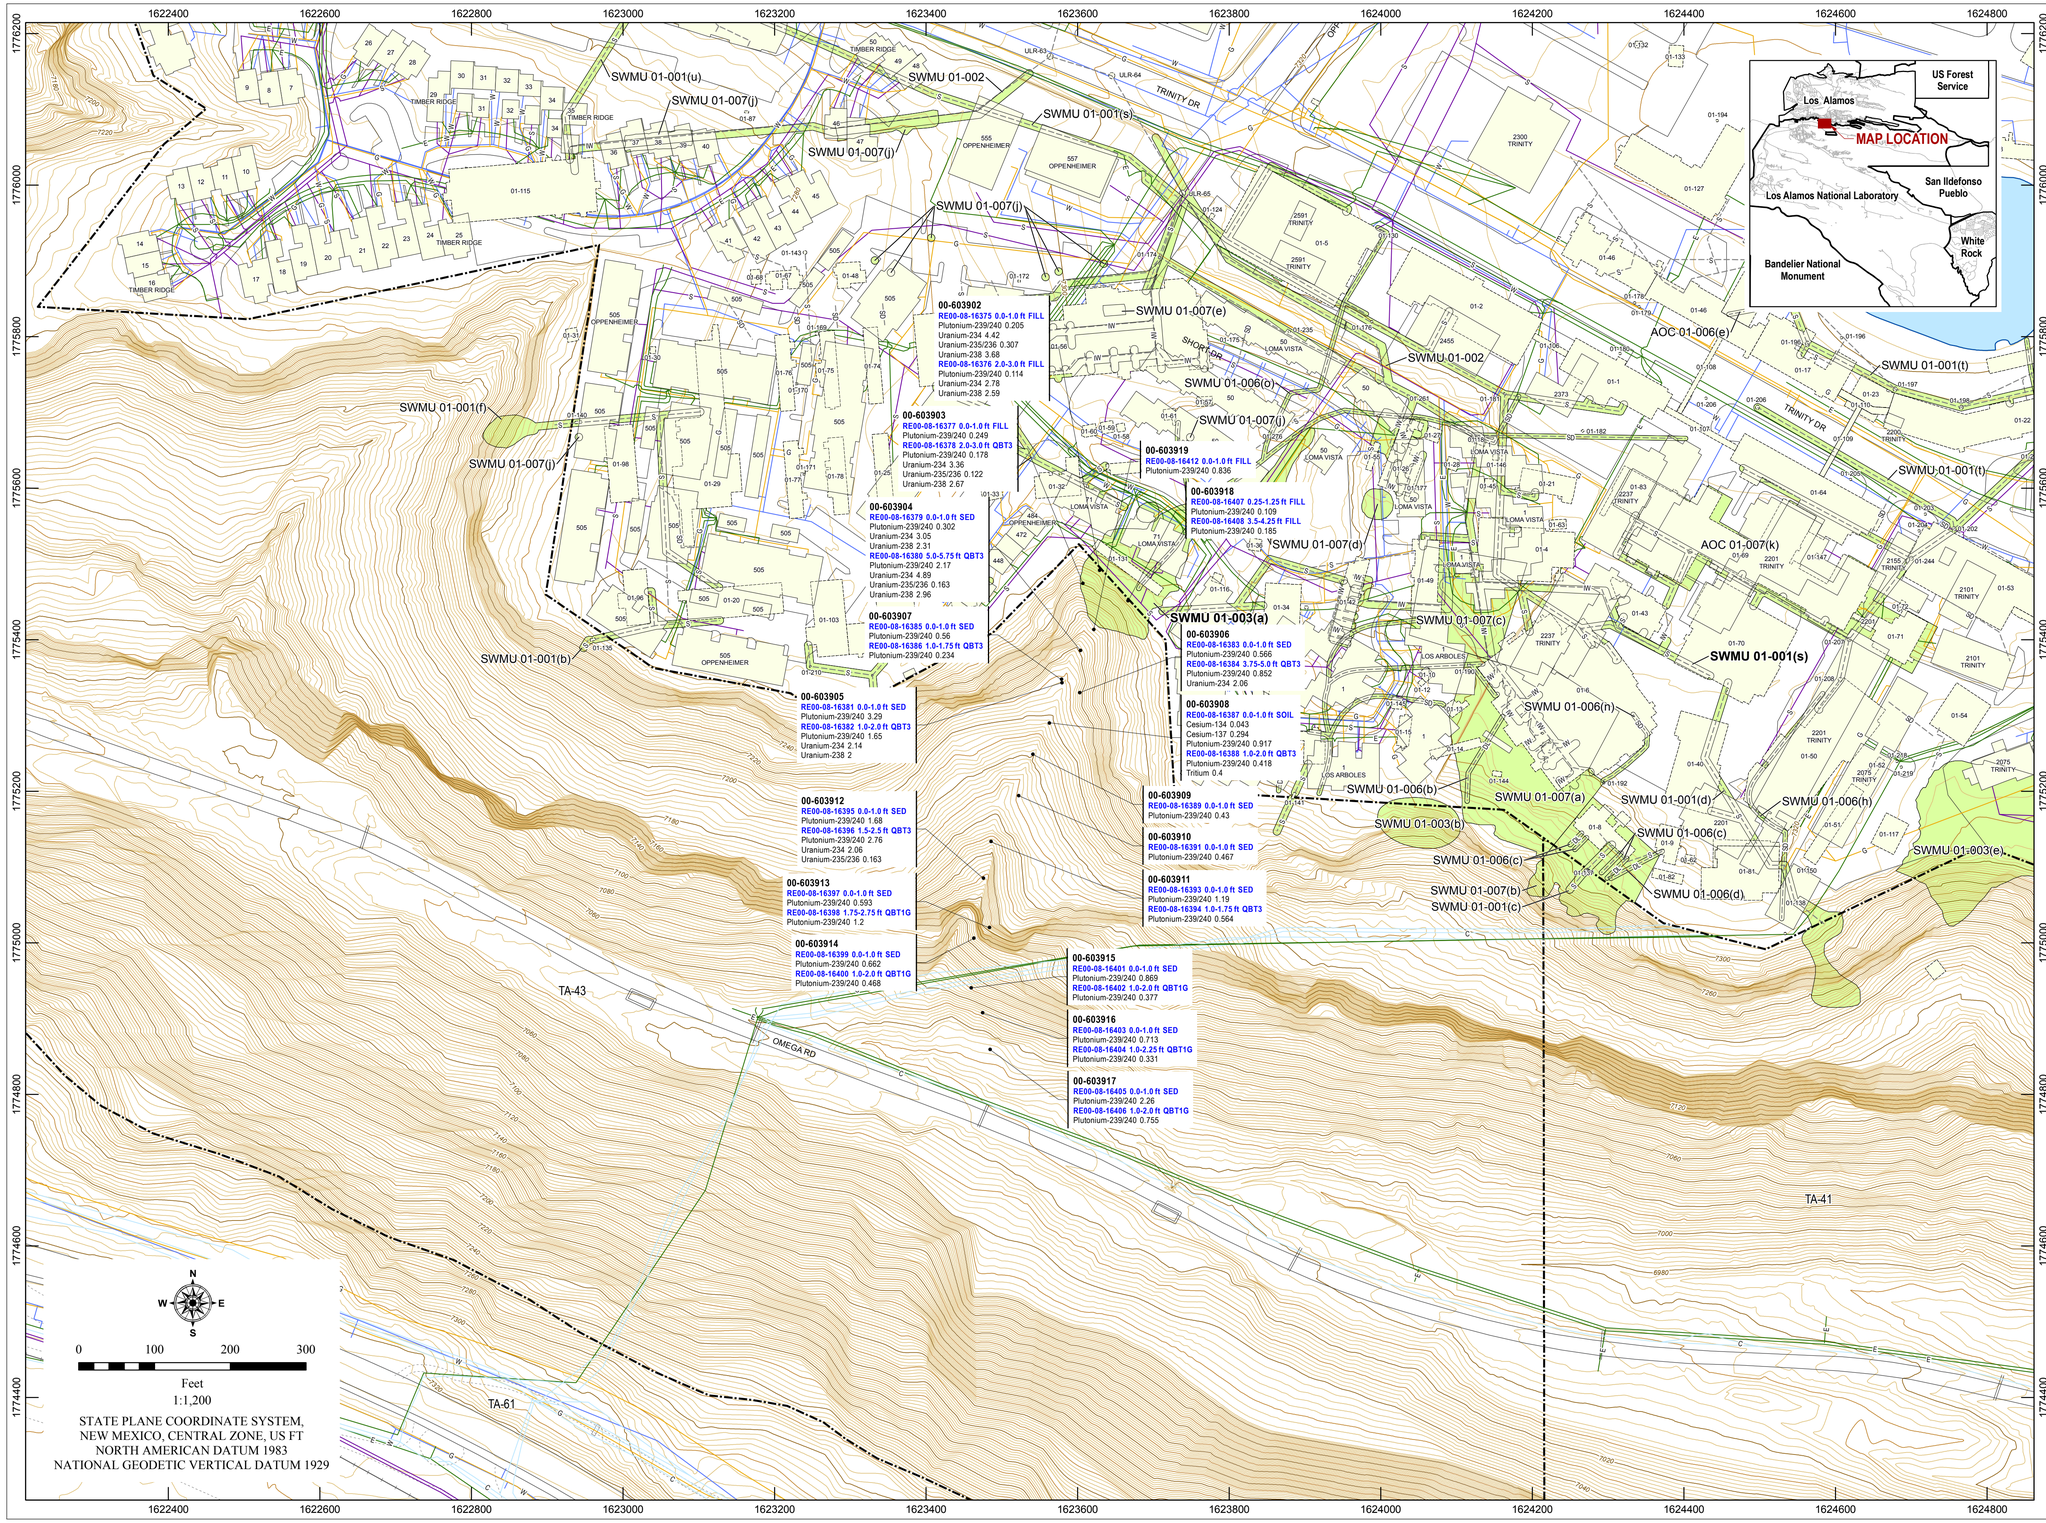

- Sampled location
- SWMU or AOC

- Structure or building
- Former structure
- Former drain line
- Former industrial waste
- Former sewer
- Former storm drain
- Pond

- Technical Area (TA) boundary
- Fence
- Paved road
- Dirt road

Elevation contours
- 100- and 20-ft contour
- 10-ft contour
- 2-ft contour

Utilities
- Communication
- Electric
- Gas
- Sewer
- Water

Note: Concentration values are pCi/g

FEATURE DATA REFERENCES

Hypsography5; Los Alamos National Laboratory, ENV Environmental Remediation and Surveillance Program; 1991.
Point Feature Locations; Environmental Restoration Project Database Table View dbo_vGIS_LOCIDS, DATASRVI; Los Alamos National Laboratory, Waste and Environmental Services Division, 20 August 2009.
Ponds; County of Los Alamos, Information Services; as published 16 May 2006.
Potential Release Site Affected Areas; Los Alamos National Laboratory, ENV Environmental Remediation and Surveillance Program; Unknown publication date.
Roads - Streets; County of Los Alamos, Information Services; as published 16 May 2006. Road Centerlines for the County of Los Alamos; County of Los Alamos, Information Services; as published 04 March 2009. Paved Road Arcs; Los Alamos National Laboratory, KSL Site Support Services, Planning, Locating and Mapping Section; 06 January 2004; as published 15 January 2009. Paved Parking; Los Alamos National Laboratory, KSL Site Support Services, Planning, Locating and Mapping Section; 12 August 2002; as published 15 January 2009. Dirt Road Arcs; Los Alamos National Laboratory, KSL Site Support Services, Planning, Locating and Mapping Section; 06 January 2004; as published 15 January 2009.
Security and Industrial Fences and Gates; Los Alamos National Laboratory, KSL Site Support Services, Planning, Locating and Mapping Section; 06 January 2004; as published 15 January 2009.
Storm Drain Line Distribution System; Los Alamos National Laboratory, KSL Site Support Services, Planning, Locating and Mapping Section; 06 January 2004; as published 15 January 2009.
Structures and Buildings - Structures; Los Alamos National Laboratory, KSL Site Support Services, Planning, Locating and Mapping Section; 06 January 2004; as published 15 January 2009.
Structures; County of Los Alamos, Information Services; as published 29 October 2007. Primary Landscape Features; Los Alamos National Laboratory, KSL Site Support Services, Planning, Locating and Mapping Section; 06 January 2004; as published 15 January 2009. Former Structures of the Los Alamos Site; Los Alamos National Laboratory, Waste and Environmental Services Division, EP2008-0441; 1:2,500 Scale Data; 08 August 2008. Former Structures of the Los Alamos Site, Line Feature Representation; Los Alamos National Laboratory, Environment and Remediation Support Services Division, EP2007-0566; 1:2,500 Scale Data; 16 April 2008.
Technical Area Boundaries; Los Alamos National Laboratory, Site Planning & Project Initiation Group, Infrastructure Planning Office; September 2007; as published 04 December 2008.
Utilities - Communication Lines; Los Alamos National Laboratory, KSL Site Support Services, Planning, Locating and Mapping Section; 08 August 2002; as published 15 January 2009. Primary Electric Grid; Los Alamos National Laboratory, KSL Site Support Services, Planning, Locating and Mapping Section; 06 January 2004; as published 15 January 2009. Electric Utility Grid; County of Los Alamos, Information Services; as published 04 March 2009. Primary Gas Distribution Lines; Los Alamos National Laboratory, KSL Site Support Services, Planning, Locating and Mapping Section; 06 January 2004; as published 15 January 2009. Natural Gas Supply Distribution; County of Los Alamos, Information Services; as published 04 March 2009. Point Features of the Sewer Line System; Los Alamos National Laboratory, KSL Site Support Services, Planning, Locating and Mapping Section; 06 January 2004; as published 15 January 2009. Sewer Line System Maintained by the County of Los Alamos; County of Los Alamos, Information Services; as published 04 March 2009. Steam Line Distribution System; Los Alamos National Laboratory, KSL Site Support Services, Planning, Locating and Mapping Section; 06 January 2004; as published 15 January 2009. Water Lines; Los Alamos National Laboratory, KSL Site Support Services, Planning, Locating and Mapping Section; 06 January 2004; as published 15 January 2009. Water Utility Distribution System Maintained by the County of Los Alamos; County of Los Alamos, Information Services; as published 04 March 2009.


PLATE 6.15-4

RADIONUCLIDE COPCs DETECTED OR DETECTED ABOVE BVs/FVs AT SWMU 01-003(a)

LOS ALAMOS NATIONAL LABORATORY
ENVIRONMENTAL PROGRAMS DIRECTORATE
CORRECTIVE ACTIONS PROJECTS
Los Alamos, New Mexico 87545

Map ULA09-IR-18R2-RAD 20 August 2009 PLANNERER
Los Alamos Technical Associates (LATA-LAO)

This map was created for work processes associated with the Corrective Actions Projects (CAP) of the Los Alamos National Laboratory (LANL) Environmental Programs (EP) Directorate. All other uses for this map should be confirmed with LANL EP-CAP staff.

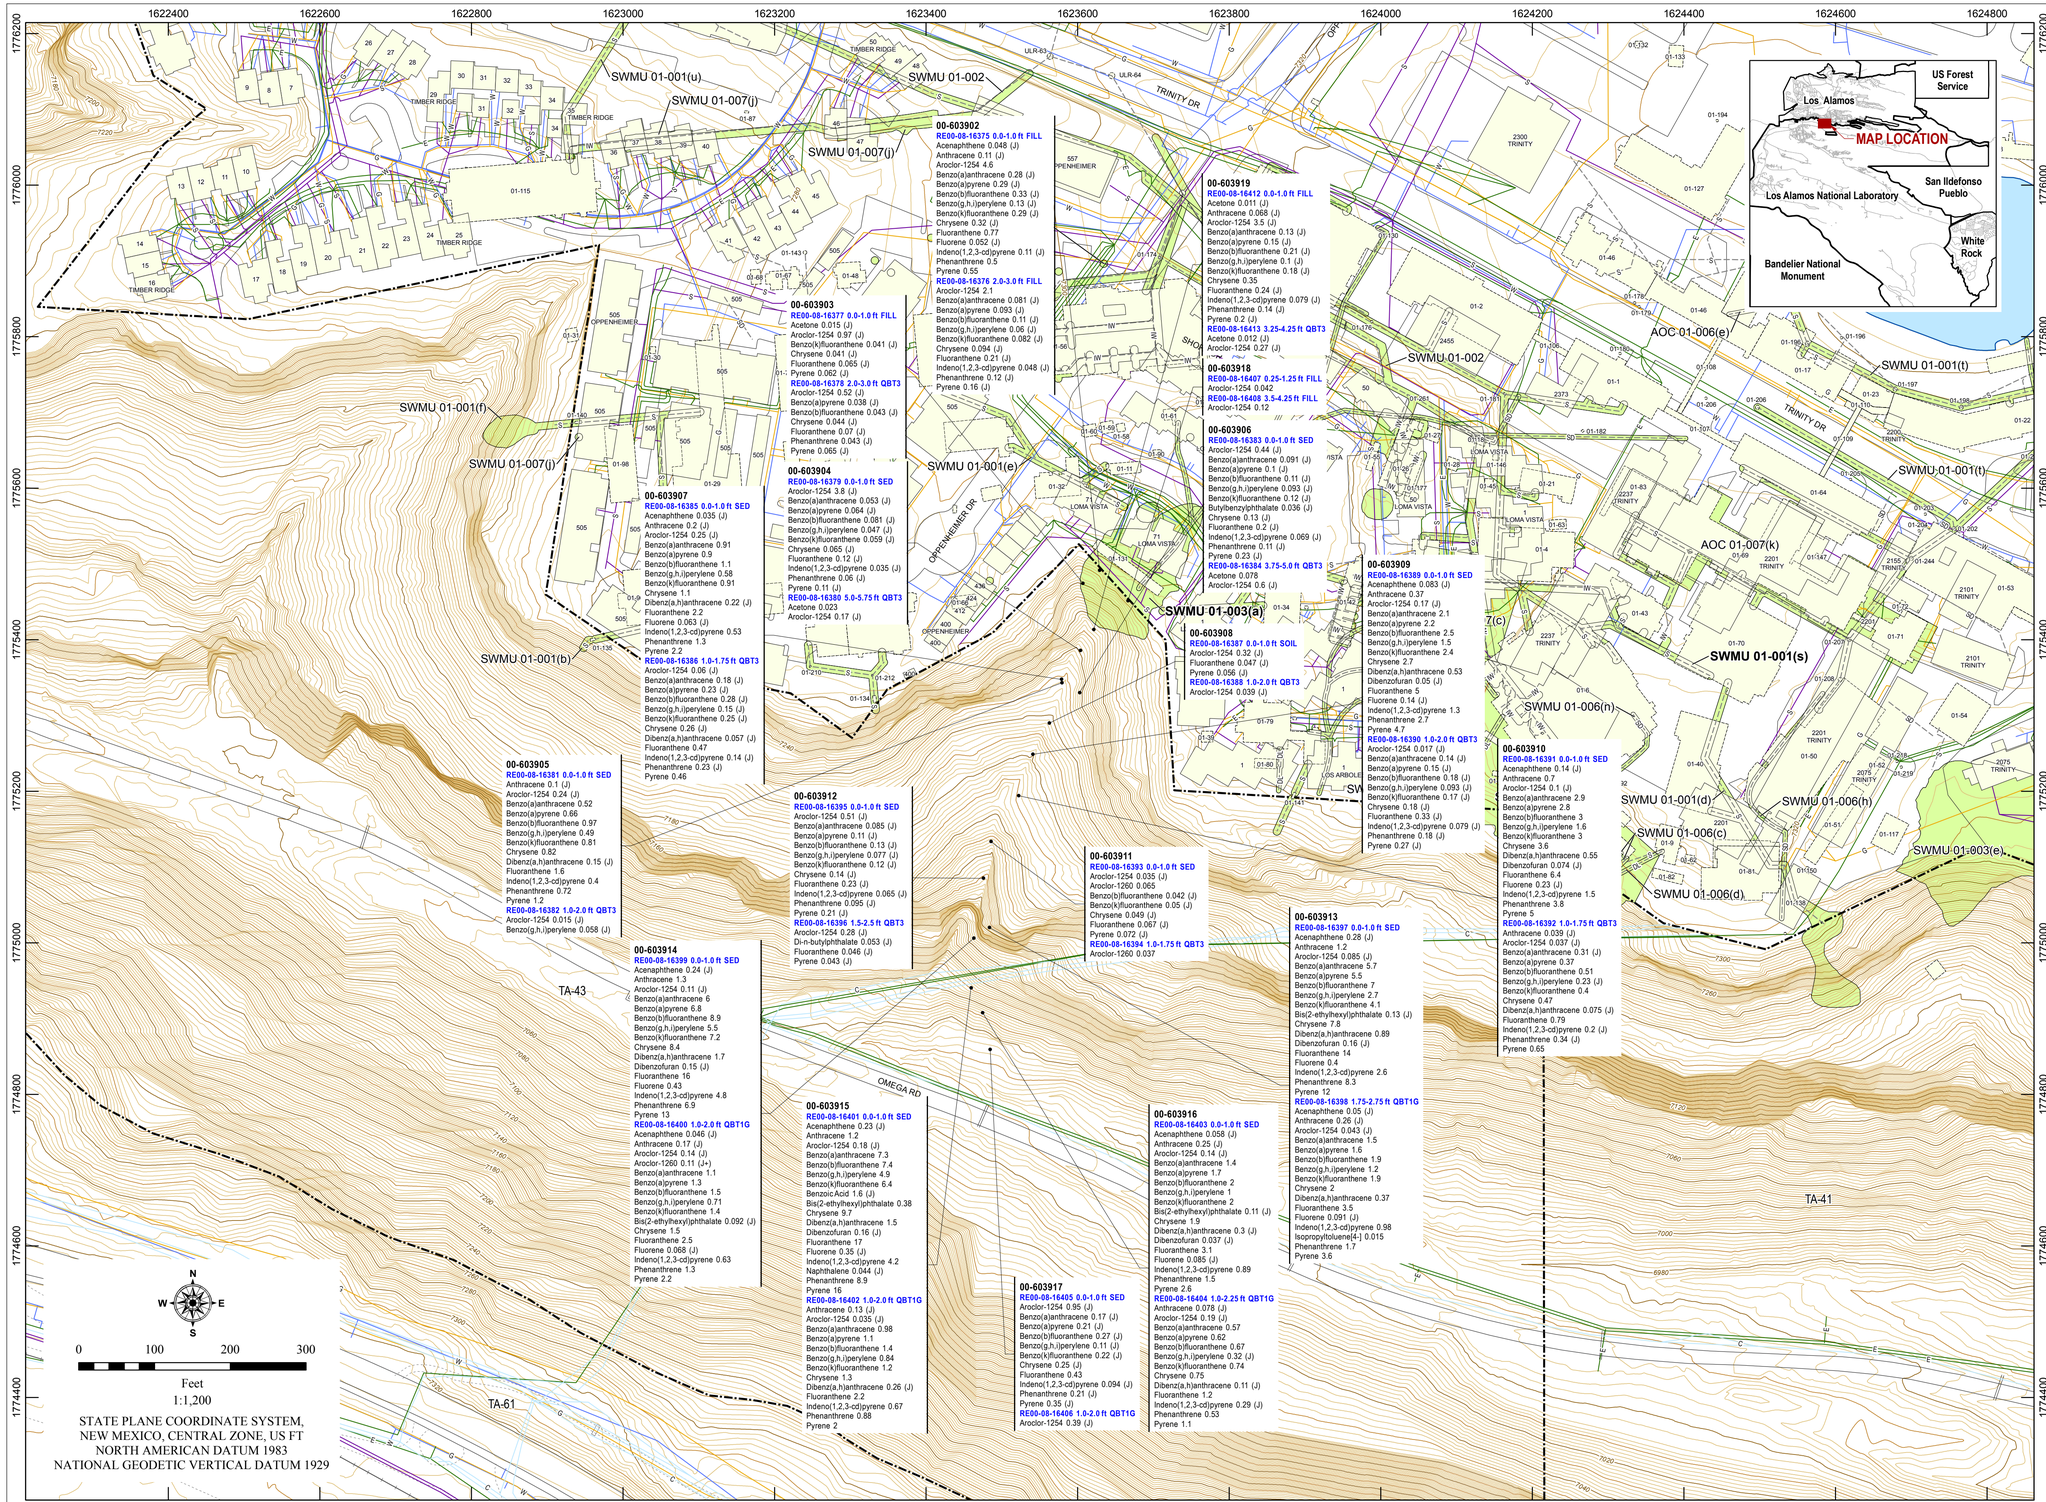

- Sampled location
- SWMU or AOC

- Structure or building
- Former structure
- Former drain line
- Former industrial waste
- Former sewer
- Former storm drain
- Pond

- Technical Area (TA) boundary
- Fence
- Paved road
- Dirt road

Elevation contours
- 100- and 20-ft contour
- 10-ft contour
- 2-ft contour

Utilities
- Communication
- Electric
- Gas
- Sewer
- Water

Note: Concentration values are mg/kg

FEATURE DATA REFERENCES

Hypsography5; Los Alamos National Laboratory, ENV Environmental Remediation and Surveillance Program; 1991.
Point Feature Locations; Environmental Restoration Project Database Table View dbo_vGIS_LOCIDS_DATASRVI; Los Alamos National Laboratory, Waste and Environmental Services Division, 20 August 2009.
Ponds; County of Los Alamos, Information Services; as published 16 May 2006.
Potential Release Site Affected Areas; Los Alamos National Laboratory, ENV Environmental Remediation and Surveillance Program; Unknown publication date.
Roads - Streets; County of Los Alamos, Information Services; as published 16 May 2006. Road Centerlines for the County of Los Alamos; County of Los Alamos, Information Services; as published 04 March 2009. Paved Road Arcs; Los Alamos National Laboratory, KSL Site Support Services, Planning, Locating and Mapping Section; 06 January 2004; as published 15 January 2009. Paved Parking; Los Alamos National Laboratory, KSL Site Support Services, Planning, Locating and Mapping Section; 12 August 2002; as published 15 January 2009. Dirt Road Arcs; Los Alamos National Laboratory, KSL Site Support Services, Planning, Locating and Mapping Section; 06 January 2004; as published 15 January 2009
Security and Industrial Fences and Gates; Los Alamos National Laboratory, KSL Site Support Services, Planning, Locating and Mapping Section; 06 January 2004; as published 15 January 2009.
Storm Drain Line Distribution System; Los Alamos National Laboratory, KSL Site Support Services, Planning, Locating and Mapping Section; 06 January 2004; as published 15 January 2009.
Structures and Buildings - Structures; Los Alamos National Laboratory, KSL Site Support Services, Planning, Locating and Mapping Section; 06 January 2004; as published 15 January 2009.
Structures; County of Los Alamos, Information Services; as published 29 October 2007. Primary Landscape Features; Los Alamos National Laboratory, KSL Site Support Services, Planning, Locating and Mapping Section; 06 January 2004; as published 15 January 2009. Former Structures of the Los Alamos Site; Los Alamos National Laboratory, Waste and Environmental Services Division, EP2008-0441; 1:2,500 Scale Data; 08 August 2008. Former Structures of the Los Alamos Site, Line Feature Representation; Los Alamos National Laboratory, Environment and Remediation Support Services Division, EP2007-0566; 1:2,500 Scale Data; 16 April 2008.
Technical Area Boundaries; Los Alamos National Laboratory, Site Planning & Project Initiation Group, Infrastructure Planning Office; September 2007; as published 04 December 2008.
Utilities - Communication Lines; Los Alamos National Laboratory, KSL Site Support Services, Planning, Locating and Mapping Section; 08 August 2002; as published 15 January 2009. Primary Electric Grid; Los Alamos National Laboratory, KSL Site Support Services, Planning, Locating and Mapping Section; 06 January 2004; as published 15 January 2009. Electric Utility Grid; County of Los Alamos, Information Services; as published 04 March 2009. Primary Gas Distribution Lines; Los Alamos National Laboratory, KSL Site Support Services, Planning, Locating and Mapping Section; 06 January 2004; as published 15 January 2009. Natural Gas Supply Distribution; County of Los Alamos, Information Services; as published 04 March 2009. Point Features of the Sewer Line System; Los Alamos National Laboratory, KSL Site Support Services, Planning, Locating and Mapping Section; 06 January 2004; as published 15 January 2009. Sewer Line System Maintained by the County of Los Alamos; County of Los Alamos, Information Services; as published 04 March 2009. Steam Line Distribution System; Los Alamos National Laboratory, KSL Site Support Services, Planning, Locating and Mapping Section; 06 January 2004; as published 15 January 2009. Water Lines; Los Alamos National Laboratory, KSL Site Support Services, Planning, Locating and Mapping Section; 06 January 2004; as published 15 January 2009. Water Utility Distribution System Maintained by the County of Los Alamos; County of Los Alamos, Information Services; as published 04 March 2009.


PLATE 6.15-3

ORGANIC CHEMICALS DETECTED AT SWMU 01-003(a)

LOS ALAMOS NATIONAL LABORATORY
ENVIRONMENTAL PROGRAMS DIRECTORATE
CORRECTIVE ACTIONS PROJECTS
Los Alamos, New Mexico 87545

Map ULA09-IR-18R2-ORG 20 August 2009 PLANNERER
Los Alamos Technical Associates (LATA-LAO)

This map was created for work processes associated with the Corrective Actions Projects (CAP) of the Los Alamos National Laboratory (LANL) Environmental Programs (EP) Directorate. All other uses for this map should be confirmed with LANL EP-CAP staff.

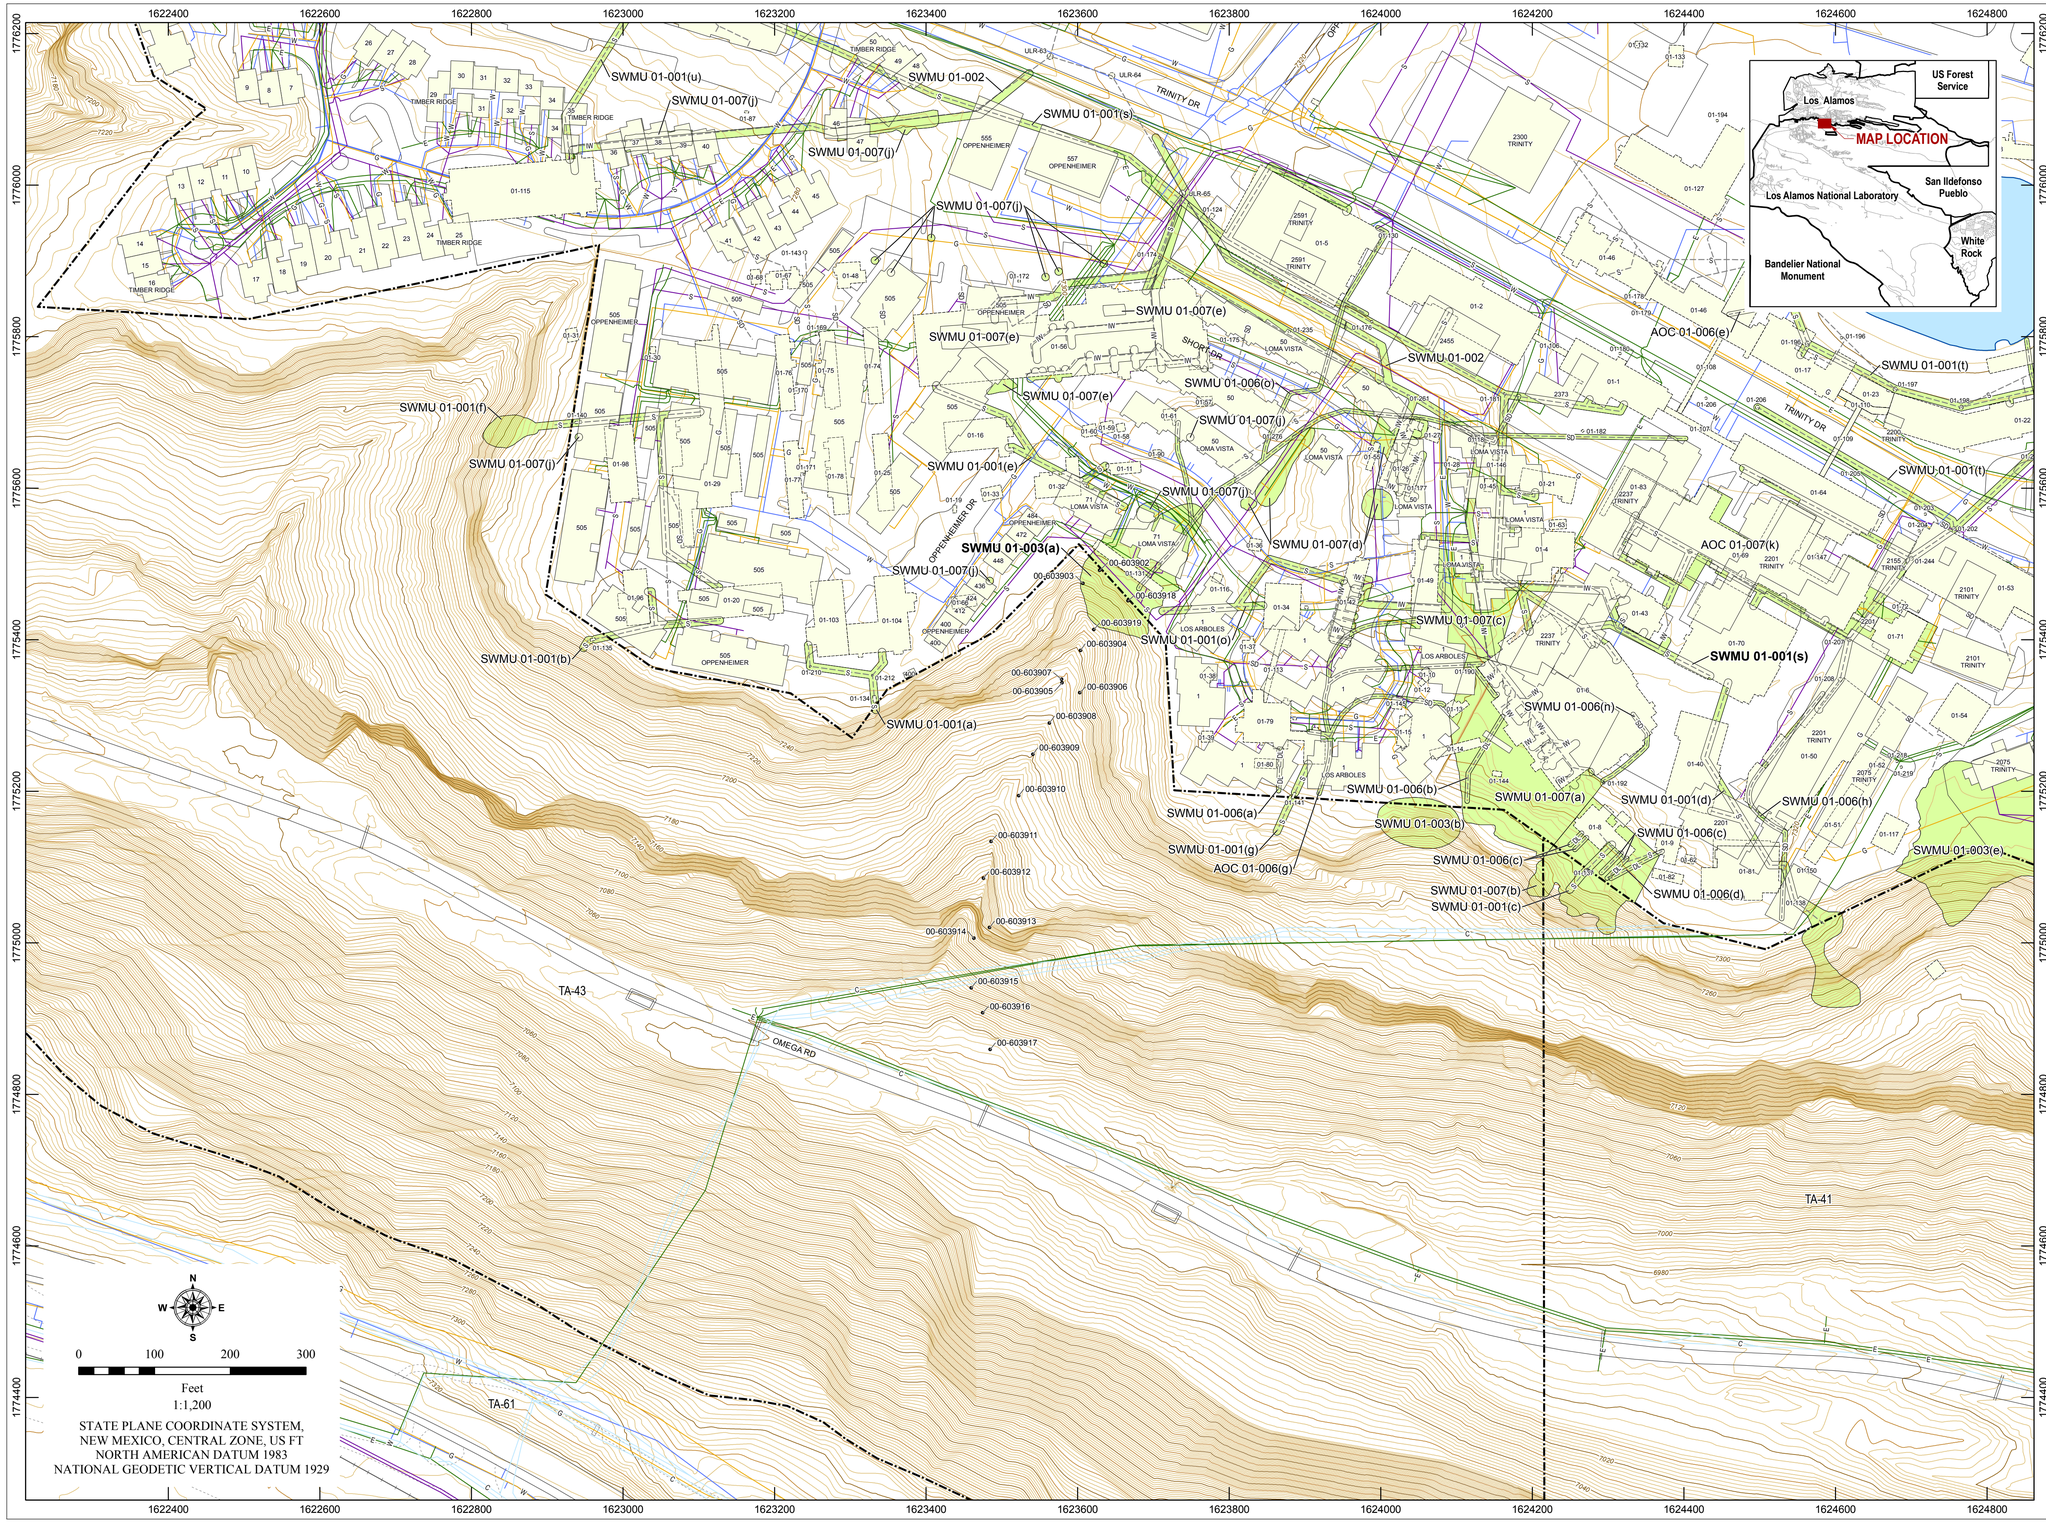

- Sampled location
- SWMU or AOC

- Structure or building
- Former structure
- Former drain line (DL)
- Former industrial waste (IW)
- Former sewer (S)
- Former storm drain (SD)
- Pond

- Technical Area (TA) boundary
- Fence
- Paved road
- Dirt road

Elevation contours
- 100- and 20-ft contour
- 10-ft contour
- 2-ft contour

Utilities
- Communication (C)
- Electric (E)
- Gas (G)
- Sewer (S)
- Water (W)

FEATURE DATA REFERENCES

Hypsography; Los Alamos National Laboratory, ENV Environmental Remediation and Surveillance Program; 1991.
Point Feature Locations; Environmental Restoration Project Database Table View dbo_vGIS_LOCIDS, DATASRVI; Los Alamos National Laboratory, Waste and Environmental Services Division, 20 August 2009.
Ponds; County of Los Alamos, Information Services; as published 16 May 2006.
Potential Release Site Affected Areas; Los Alamos National Laboratory, ENV Environmental Remediation and Surveillance Program; Unknown publication date.
Roads - Streets; County of Los Alamos, Information Services; as published 16 May 2006. Road Centerlines for the County of Los Alamos; County of Los Alamos, Information Services; as published 04 March 2009. Paved Road Arcs; Los Alamos National Laboratory, KSL Site Support Services, Planning, Locating and Mapping Section; 06 January 2004; as published 15 January 2009. Paved Parking; Los Alamos National Laboratory, KSL Site Support Services, Planning, Locating and Mapping Section; 12 August 2002; as published 15 January 2009. Dirt Road Arcs; Los Alamos National Laboratory, KSL Site Support Services, Planning, Locating and Mapping Section; 06 January 2004; as published 15 January 2009.
Security and Industrial Fences and Gates; Los Alamos National Laboratory, KSL Site Support Services, Planning, Locating and Mapping Section; 06 January 2004; as published 15 January 2009.
Storm Drain Line Distribution System; Los Alamos National Laboratory, KSL Site Support Services, Planning, Locating and Mapping Section; 06 January 2004; as published 15 January 2009.
Structures and Buildings - Structures; Los Alamos National Laboratory, KSL Site Support Services, Planning, Locating and Mapping Section; 06 January 2004; as published 15 January 2009.
Structures; County of Los Alamos, Information Services; as published 29 October 2007. Primary Landscape Features; Los Alamos National Laboratory, KSL Site Support Services, Planning, Locating and Mapping Section; 06 January 2004; as published 15 January 2009. Former Structures of the Los Alamos Site; Los Alamos National Laboratory, Waste and Environmental Services Division, EP2008-0441; 1:2,500 Scale Data; 08 August 2008. Former Structures of the Los Alamos Site, Line Feature Representation; Los Alamos National Laboratory, Environment and Remediation Support Services Division, EP2007-0566; 1:2,500 Scale Data; 16 April 2008.
Technical Area Boundaries; Los Alamos National Laboratory, Site Planning & Project Initiation Group, Infrastructure Planning Office; September 2007; as published 04 December 2008.
Utilities - Communication Lines; Los Alamos National Laboratory, KSL Site Support Services, Planning, Locating and Mapping Section; 08 August 2002; as published 15 January 2009. Primary Electric Grid; Los Alamos National Laboratory, KSL Site Support Services, Planning, Locating and Mapping Section; 06 January 2004; as published 15 January 2009. Electric Utility Grid; County of Los Alamos, Information Services; as published 04 March 2009. Primary Gas Distribution Lines; Los Alamos National Laboratory, KSL Site Support Services, Planning, Locating and Mapping Section; 06 January 2004; as published 15 January 2009. Natural Gas Supply Distribution; County of Los Alamos, Information Services; as published 04 March 2009. Point Features of the Sewer Line System; Los Alamos National Laboratory, KSL Site Support Services, Planning, Locating and Mapping Section; 06 January 2004; as published 15 January 2009. Sewer Line System Maintained by the County of Los Alamos; County of Los Alamos, Information Services; as published 04 March 2009. Steam Line Distribution System; Los Alamos National Laboratory, KSL Site Support Services, Planning, Locating and Mapping Section; 06 January 2004; as published 15 January 2009. Water Lines; Los Alamos National Laboratory, KSL Site Support Services, Planning, Locating and Mapping Section; 06 January 2004; as published 15 January 2009. Water Utility Distribution System Maintained by the County of Los Alamos; County of Los Alamos, Information Services; as published 04 March 2009.


PLATE 6.15-1

SWMU 01-003(a) SITE MAP AND SAMPLING LOCATIONS

LOS ALAMOS NATIONAL LABORATORY
ENVIRONMENTAL PROGRAMS DIRECTORATE
CORRECTIVE ACTIONS PROJECTS
Los Alamos, New Mexico 87545

Map ULA09-IR-18R2 20 August 2009 PLANNERER
Los Alamos Technical Associates (LATA-LAO)

This map was created for work processes associated with the Corrective Actions Projects (CAP) of the Los Alamos National Laboratory (LANL) Environmental Programs (EP) Directorate. All other uses for this map should be confirmed with LANL EP-CAP staff.

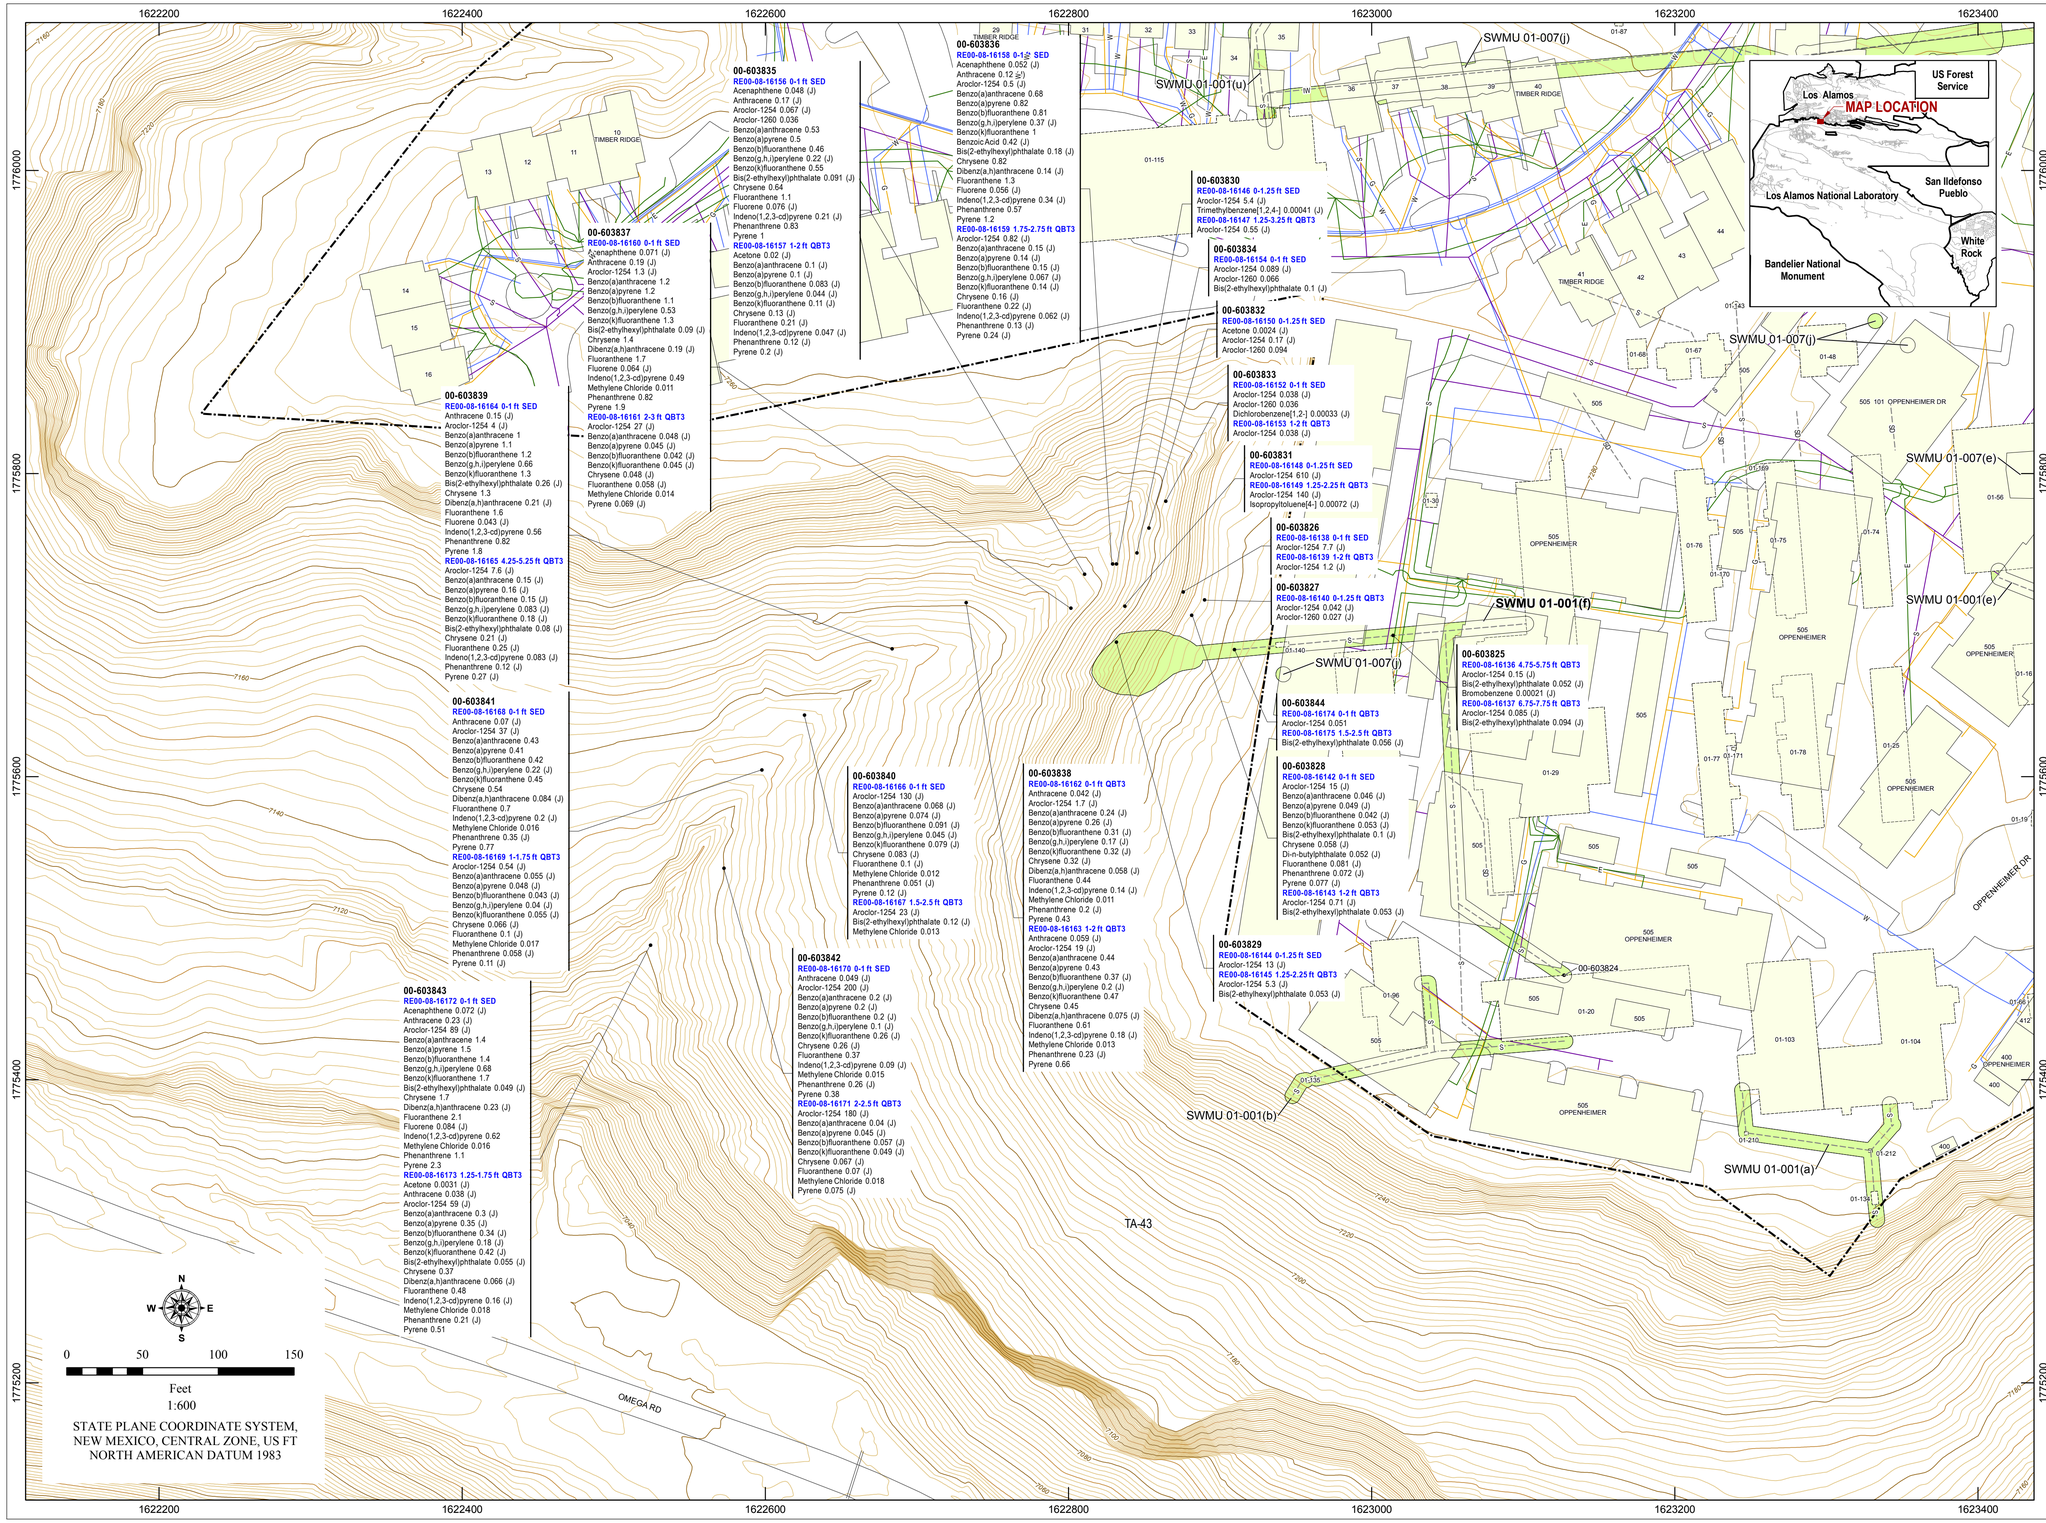

- Sampled location
- SWMU or AOC

- Structure or building
- Former structure
- Former drain line
- Former industrial waste
- Former sewer
- Former storm drain

- Technical Area (TA) boundary
- Fence
- Paved road
- Dirt road

Elevation contours
- 100- and 20-ft contour
- 10-ft contour
- 2-ft contour

Utilities
- Communication
- Electric
- Gas
- Sewer
- Water

Note: Concentration values are mg/kg

FEATURE DATA REFERENCES

Hypsography; Los Alamos National Laboratory, ENV Environmental Remediation and Surveillance Program; 1991

Point Feature Locations; Environmental Restoration Project Database Table View dbo_vGIS_LOCIDS, DATASRV1; Los Alamos National Laboratory, Waste and Environmental Services Division, 20 August 2009.

Ponds; County of Los Alamos, Information Services; as published 16 May 2006.

Potential Release Site Affected Areas; Los Alamos National Laboratory, ENV Environmental Remediation and Surveillance Program; Unknown publication date.

Roads - Streets; County of Los Alamos, Information Services; as published 16 May 2006. Road Centerlines for the County of Los Alamos; County of Los Alamos, Information Services; as published 04 March 2009. Paved Road Arcs; Los Alamos National Laboratory, KSL Site Support Services, Planning, Locating and Mapping Section; 06 January 2004; as published 15 January 2009. Paved Parking; Los Alamos National Laboratory, KSL Site Support Services, Planning, Locating and Mapping Section; 12 August 2002; as published 15 January 2009. Dirt Road Arcs; Los Alamos National Laboratory, KSL Site Support Services, Planning, Locating and Mapping Section; 06 January 2004; as published 15 January 2009.

Security and Industrial Fences and Gates; Los Alamos National Laboratory, KSL Site Support Services, Planning, Locating and Mapping Section; 06 January 2004; as published 15 January 2009.

Storm Drain Line Distribution System; Los Alamos National Laboratory, KSL Site Support Services, Planning, Locating and Mapping Section; 06 January 2004; as published 15 January 2009.

Structures and Buildings - Structures; Los Alamos National Laboratory, KSL Site Support Services, Planning, Locating and Mapping Section; 06 January 2004; as published 15 January 2009. Structures; County of Los Alamos, Information Services; as published 29 October 2007. Primary Landscape Features; Los Alamos National Laboratory, KSL Site Support Services, Planning, Locating and Mapping Section; 06 January 2004; as published 15 January 2009. Former Structures of the Los Alamos Site; Los Alamos National Laboratory, Waste and Environmental Services Division, EP2008-0441; 1:2,500 Scale Data; 08 August 2008. Former Structures of the Los Alamos Site; Line Feature Representation; Los Alamos National Laboratory, Environment and Remediation Support Services Division, EP2007-0566; 1:2,500 Scale Data; 16 April 2008.

Technical Area Boundaries; Los Alamos National Laboratory, Site Planning & Project Initiation Group, Infrastructure Planning Office; September 2007; as published 04 December 2008.

Utilities - Communication Lines; Los Alamos National Laboratory, KSL Site Support Services, Planning, Locating and Mapping Section; 08 August 2002; as published 15 January 2009. Primary Electric Grid; Los Alamos National Laboratory, KSL Site Support Services, Planning, Locating and Mapping Section; 06 January 2004; as published 15 January 2009. Electric Utility Grid; County of Los Alamos, Information Services; as published 04 March 2009. Primary Gas Distribution Lines; Los Alamos National Laboratory, KSL Site Support Services, Planning, Locating and Mapping Section; 06 January 2004; as published 15 January 2009. Natural Gas Supply Distribution; County of Los Alamos, Information Services; as published 04 March 2009. Point Features of the Sewer Line System; Los Alamos National Laboratory, KSL Site Support Services, Planning, Locating and Mapping Section; 06 January 2004; as published 15 January 2009. Sewer Line System Maintained by the County of Los Alamos; County of Los Alamos, Information Services; as published 04 March 2009. Steam Line Distribution System; Los Alamos National Laboratory, KSL Site Support Services, Planning, Locating and Mapping Section; 06 January 2004; as published 15 January 2009. Water Lines; Los Alamos National Laboratory, KSL Site Support Services, Planning, Locating and Mapping Section; 06 January 2004; as published 15 January 2009. Water Utility Distribution System Maintained by the County of Los Alamos; County of Los Alamos, Information Services; as published 04 March 2009.

PLATE 6.8-1

ORGANIC CHEMICALS DETECTED AT SWMU 01-001(f)

LOS ALAMOS NATIONAL LABORATORY
ENVIRONMENTAL PROGRAMS DIRECTORATE
CORRECTIVE ACTIONS PROJECTS
Los Alamos, New Mexico 87545

Map ULA09-IR-11R2-ORG 21 August 2009 PLANNERER
Los Alamos Technical Associates (LATA-LAO)

This map was created for work processes associated with the Corrective Actions Projects (CAP) of the Los Alamos National Laboratory (LANL) Environmental Programs (EP) Directorate. All other uses for this map should be confirmed with LANL EP-CAP staff.